



FED. ROAD DIST. NO.	STATE	PROJ. NO.	FISCAL YEAR	SHEET NO.	TOTAL SHEETS
HAWAII	HAW.	LT-K-01-79M	1979	1	5

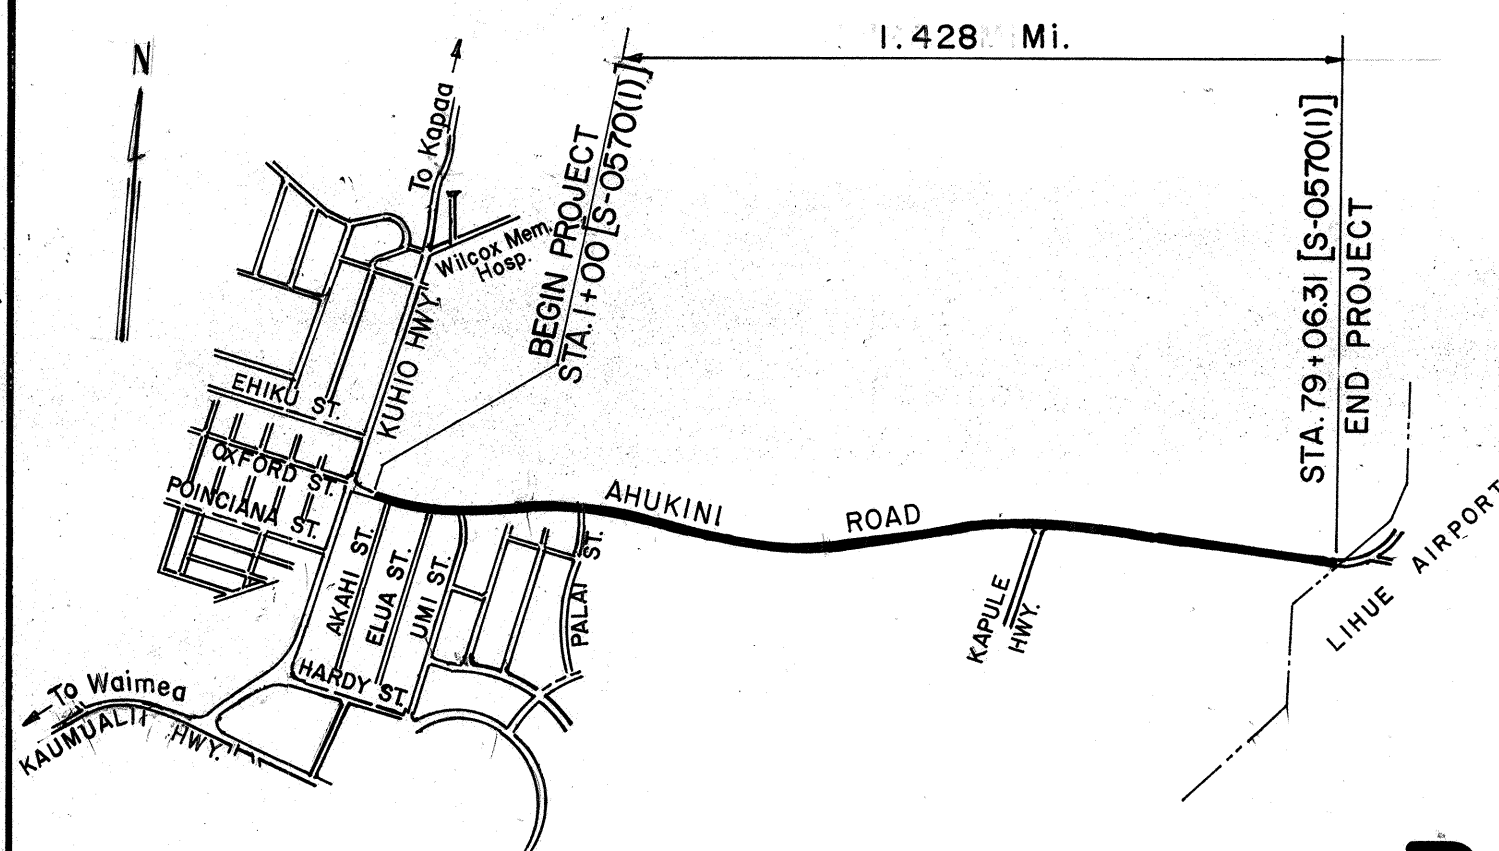

KUHIO HWY. TO LIHUE AIRPORT
NOT TO SCALE


STATE OF HAWAII
DEPARTMENT OF TRANSPORTATION
LAND TRANSPORTATION FACILITIES DIVISION
"AS BUILT"
PLANS FOR

**RESURFACING STATE HIGHWAYS,
VARIOUS LOCATIONS
PROJECT NO. LT-K-01-79M
DISTRICT OF WAIMEA, KOLOA, LIHUE AND KAWAIHAU
ISLAND OF KAUAI**

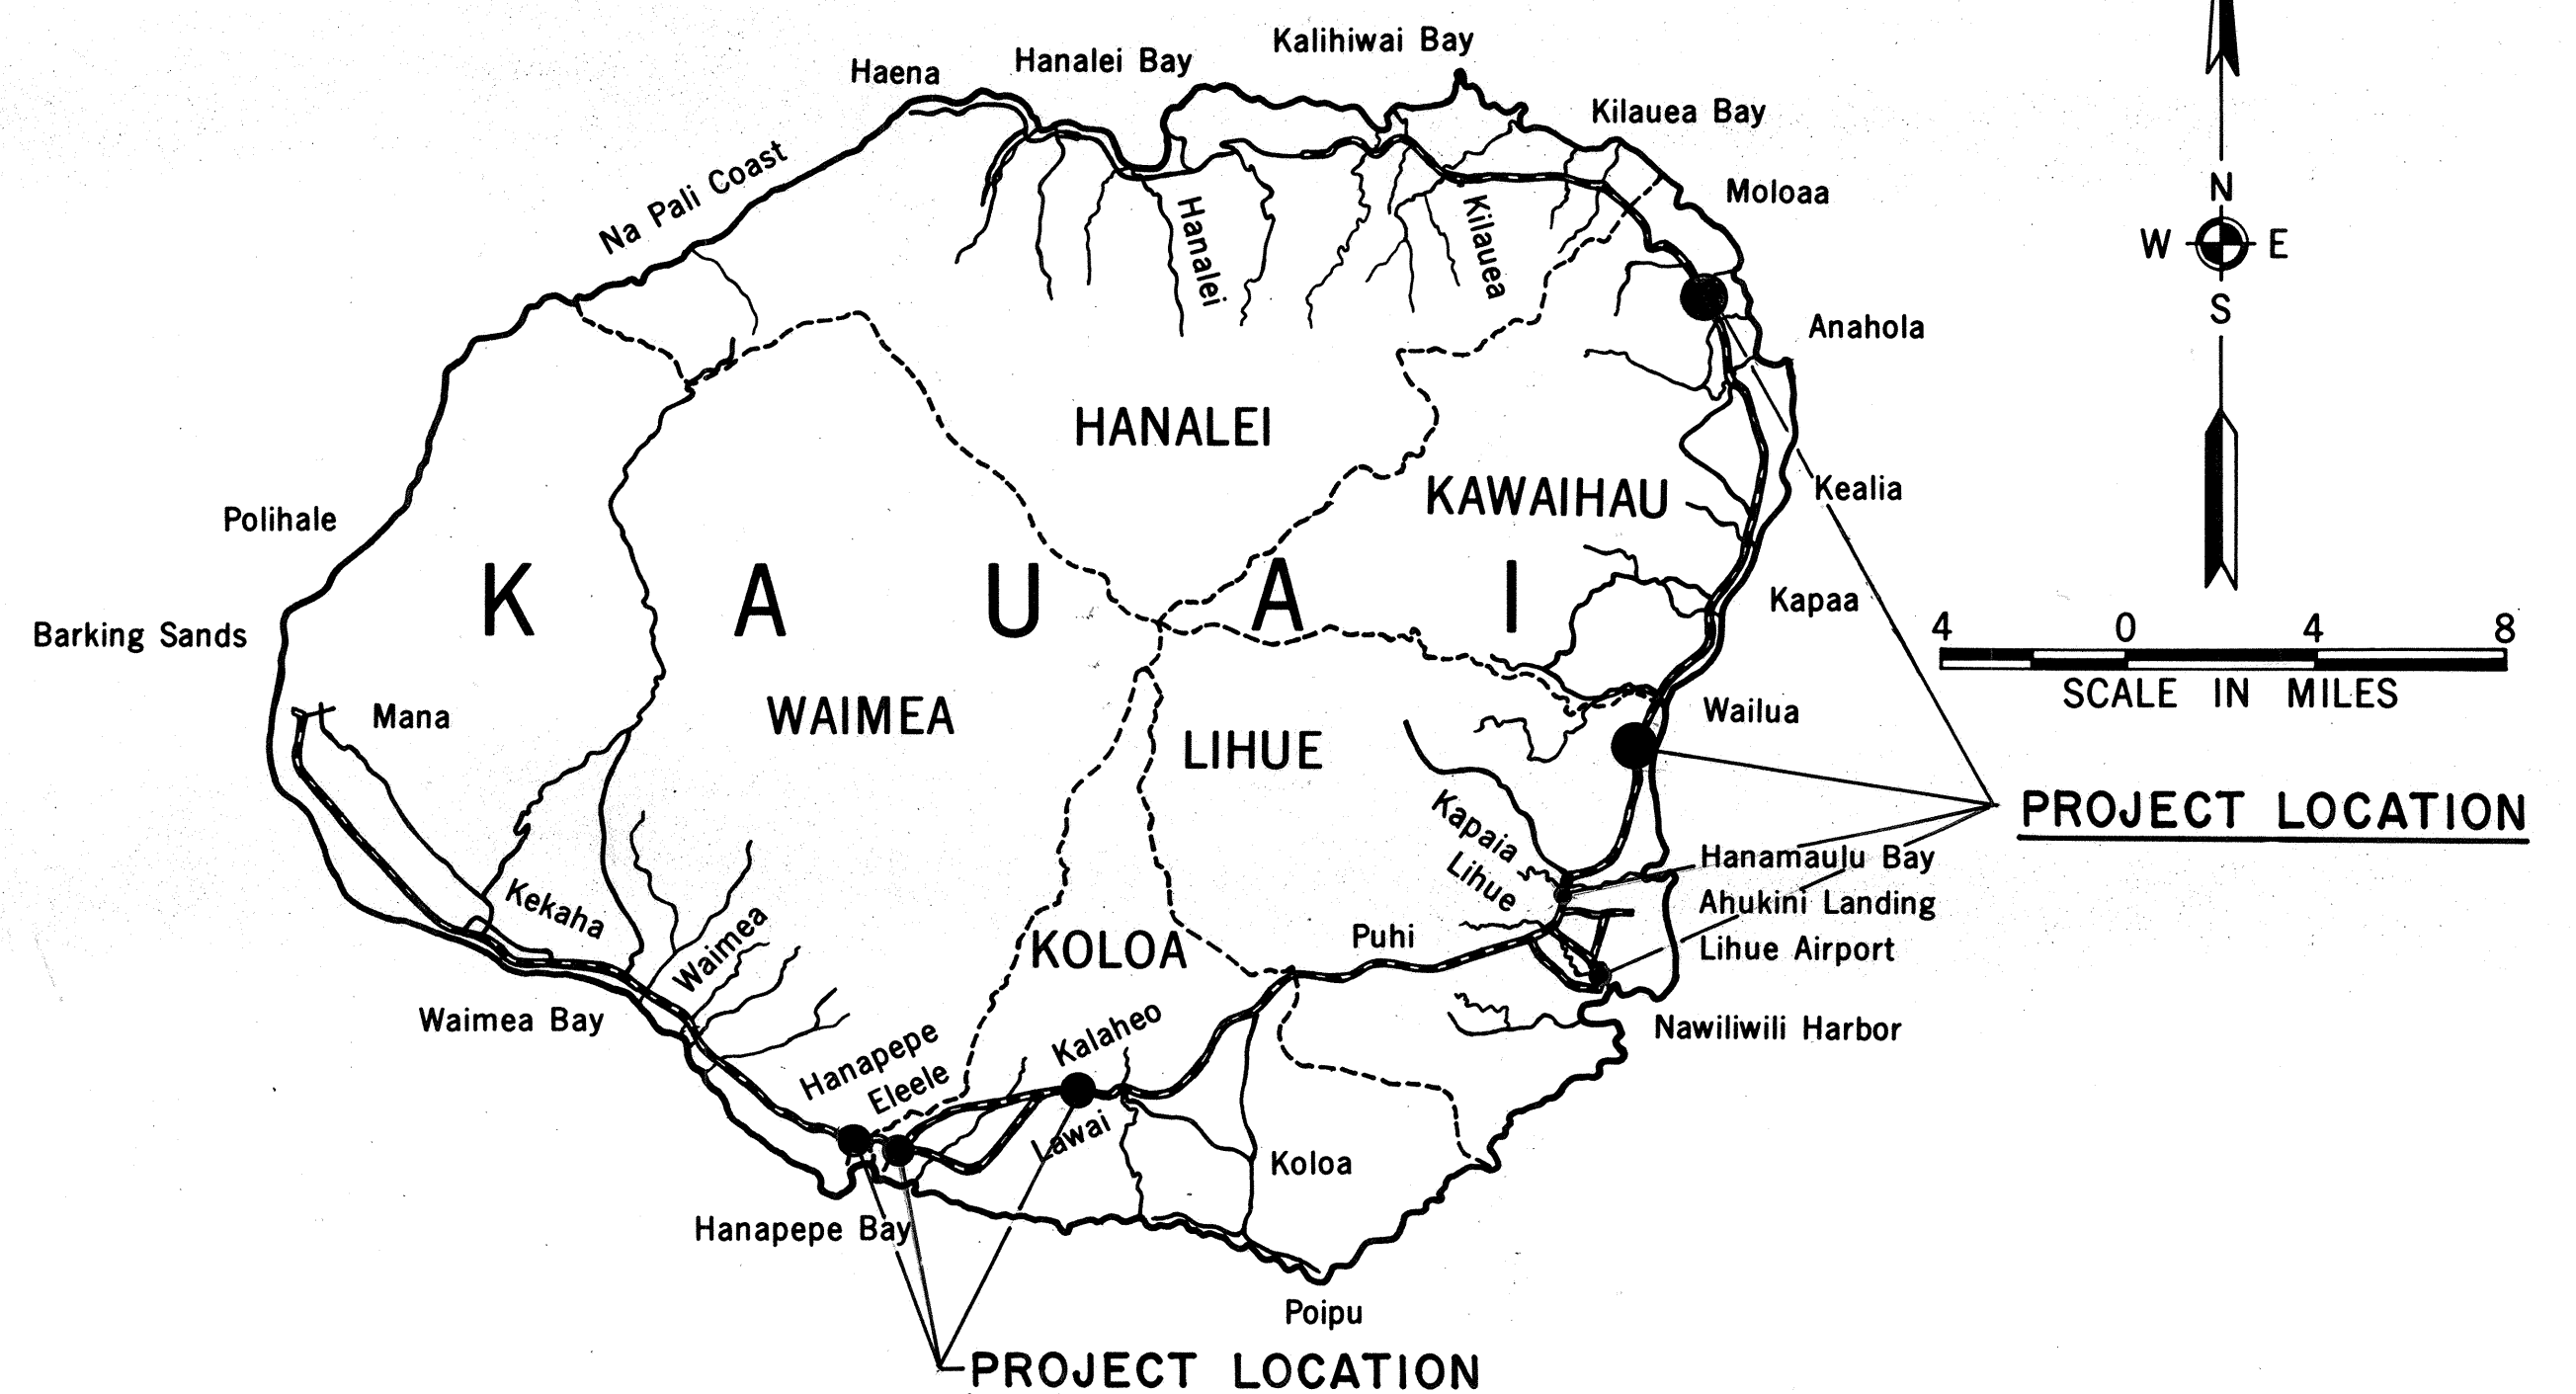


FEDERAL AID PROJECTS PREVIOUSLY CONSTRUCTED
OR UNDER CONSTRUCTION

INDEX TO DRAWINGS	
SHEET NO.	DESCRIPTION
1	TITLE SHEET
2	TYPICAL SECTIONS
3	PLANS & GENERAL NOTES
4	PLANS & ESTIMATED QUANTITIES
5	STANDARD DETAILS

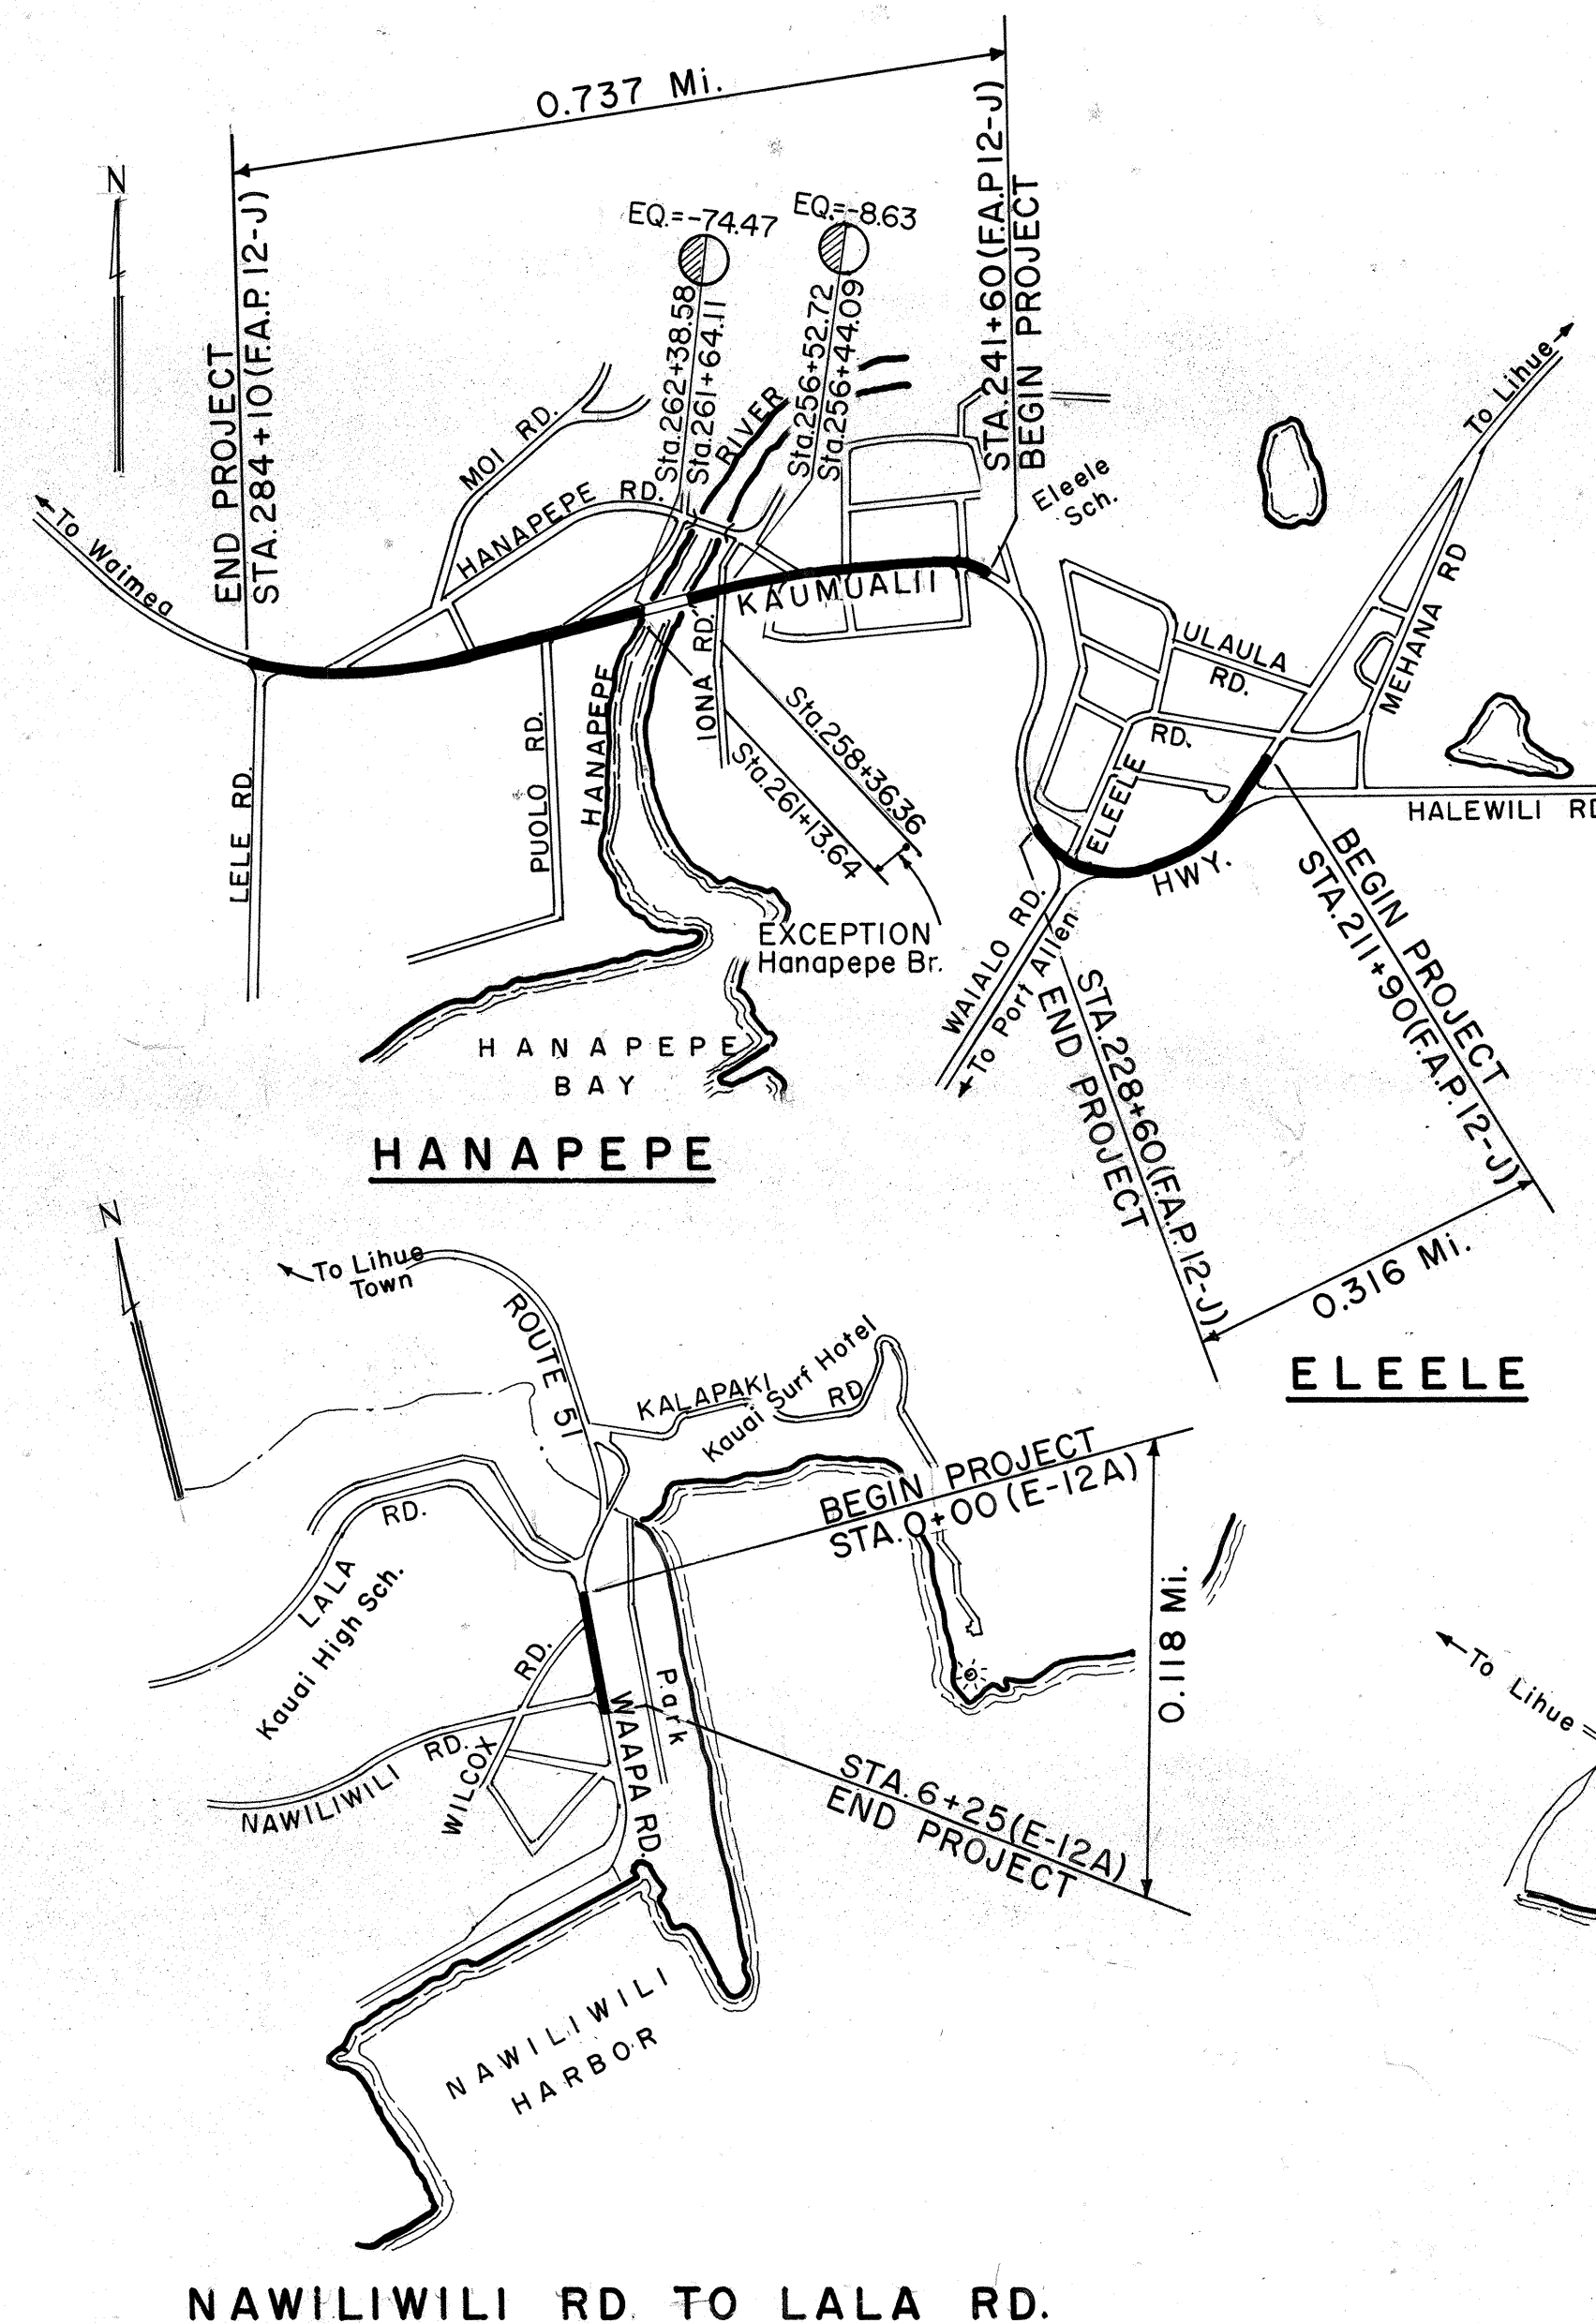[illegible]

ALL CHANGES MADE DURING CONSTRUCTION HAVE
BEEN INCORPORATED ON THESE PLANS EXCEPT
CHANGES IN THE ORIGINAL THEORETICAL QUANTITIES.

Calvin M. Johnson 10-10-79
PROJECT ENGINEER DATE

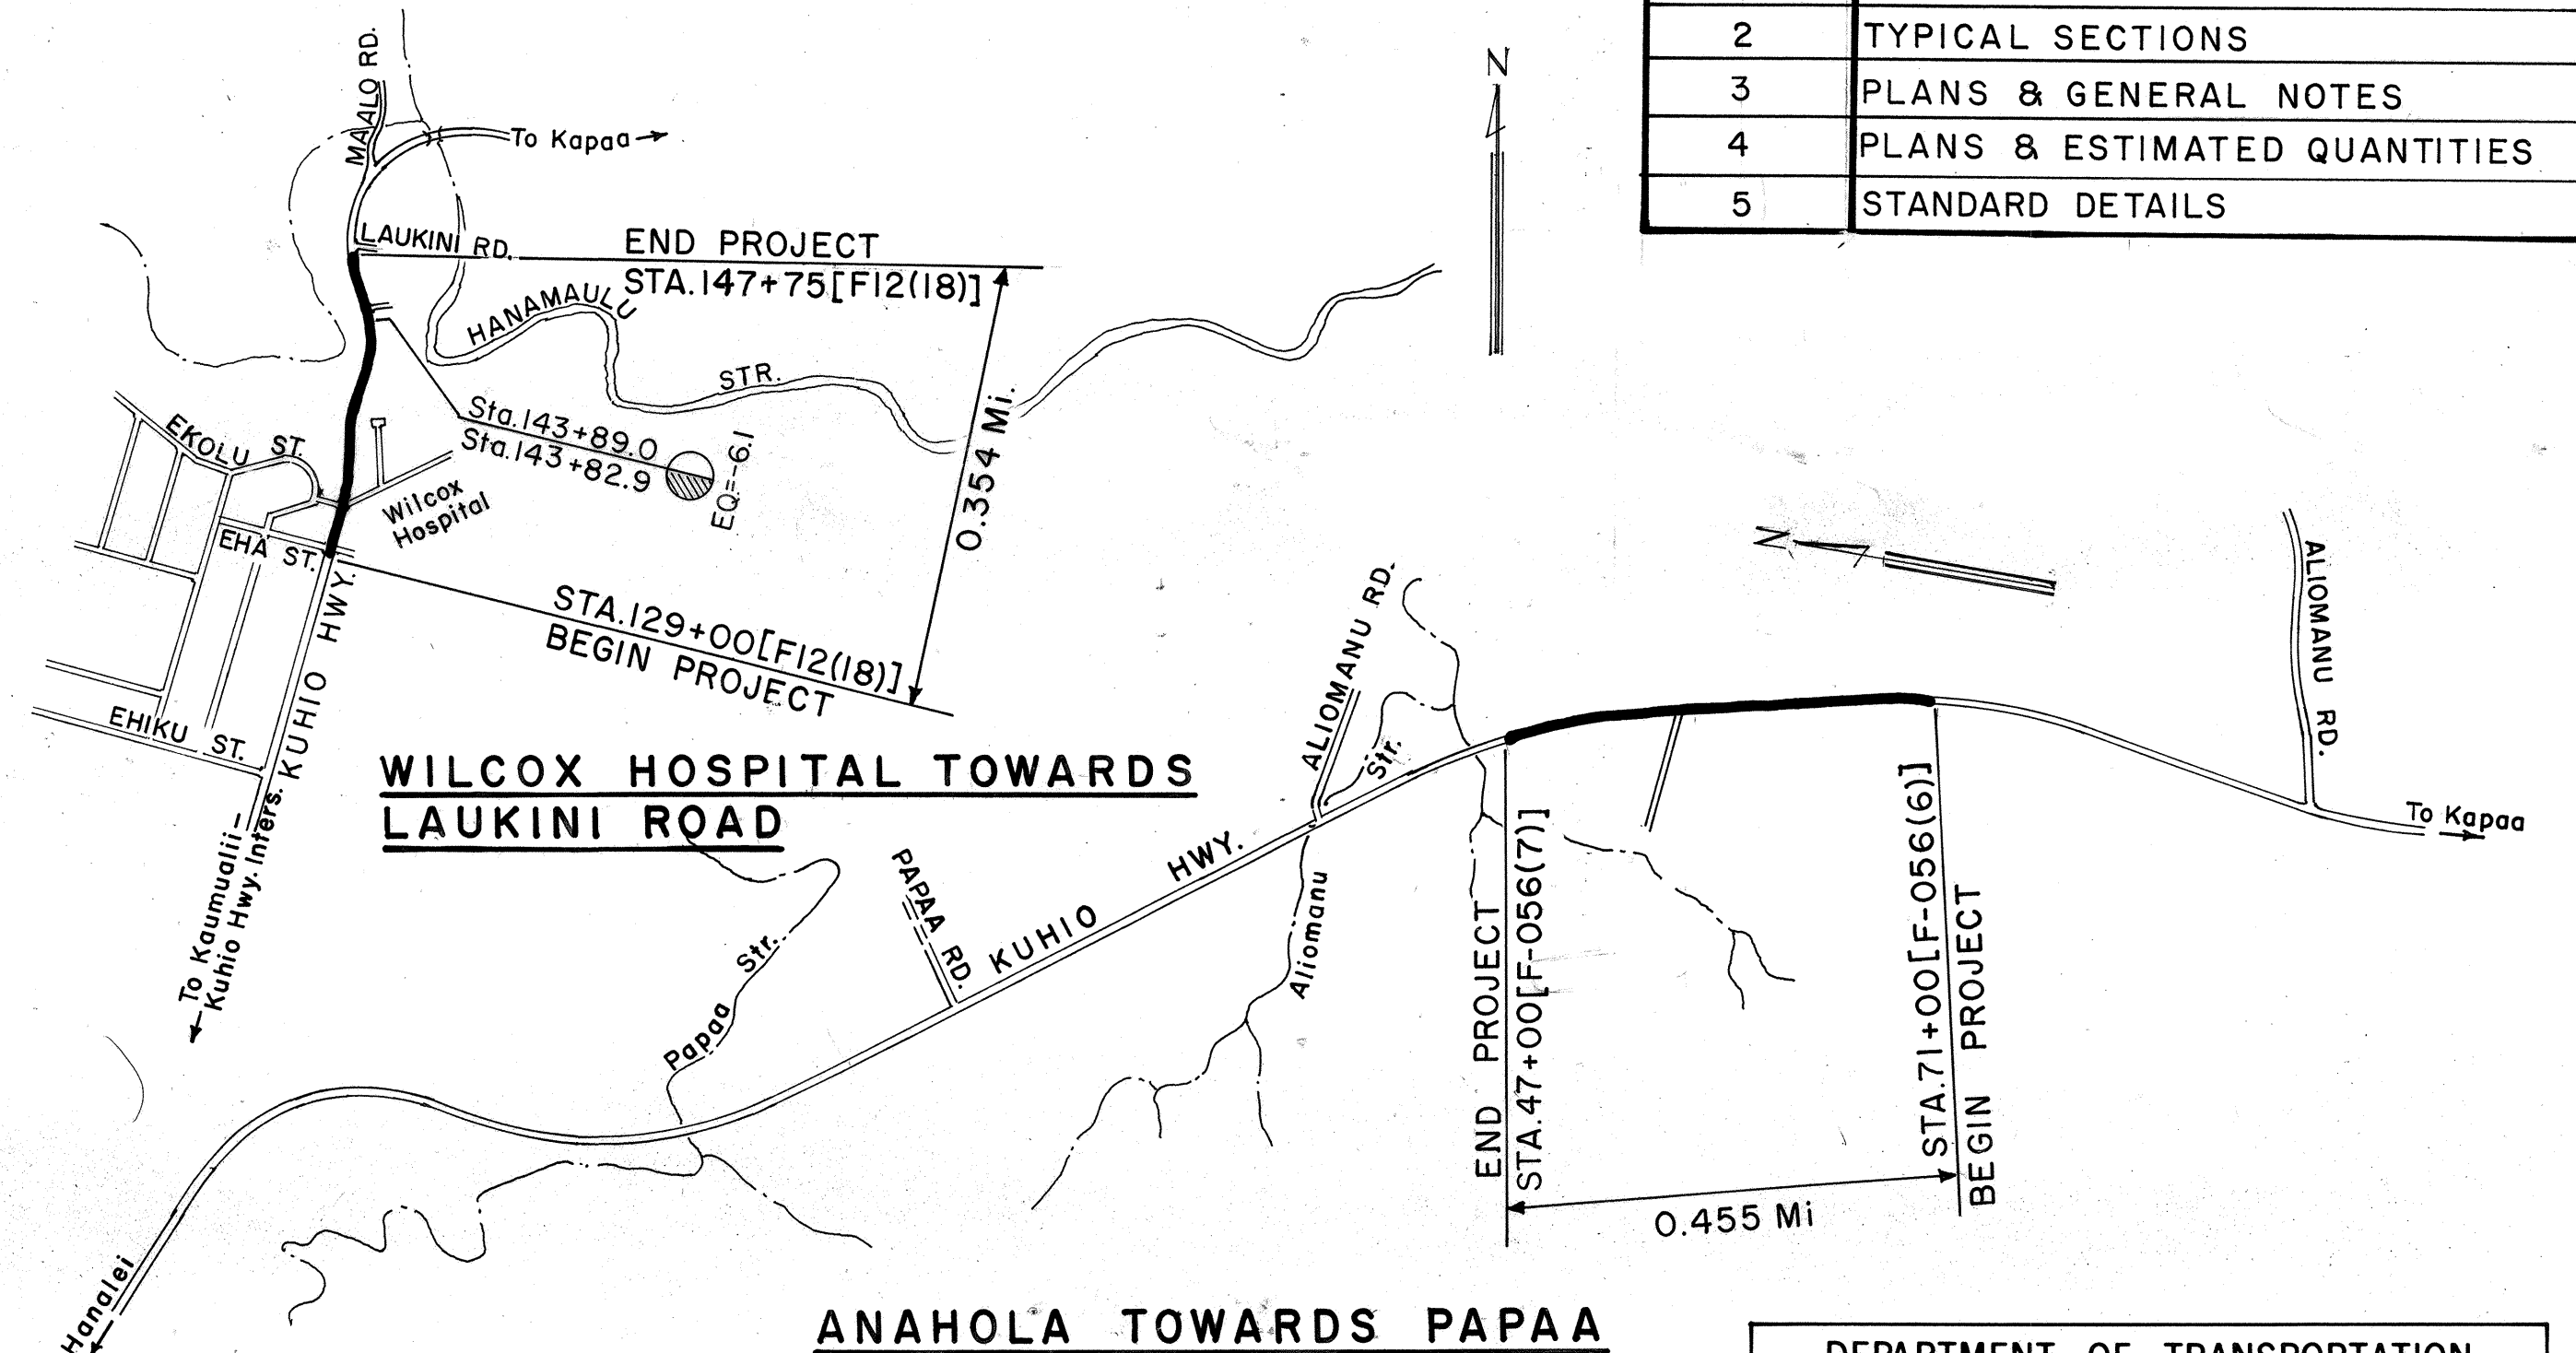

ANAHOLA TOWARDS PAPAA

WAIPOULI TO WAIKAEA CANAL

KEALIA TOWARDS ANAHOLA

STA. 21+00 TO STA. 36+30

STA. 61+00 TO STA. 69+00

LAYOUT OF PROJECT

SCALE. 1" = 1000'

KAUAI DISTRICT
DESIGNED BY D. Bevier 548-7537 6/8/78
P. S. & E. BY PHONE DATE

DEPARTMENT OF TRANSPORTATION
STATE OF HAWAII

APPROVED:
Yoshichi Higashionna *June 8, 78*

DIRECTOR OF TRANSPORTATION DATE