




FED. ROAD DIST. NO.	STATE	PROJ. NO.	FISCAL YEAR	SHEET NO.	TOTAL SHEETS
HAWAII	HAW.	LT-K-01-79M	1979	2	5

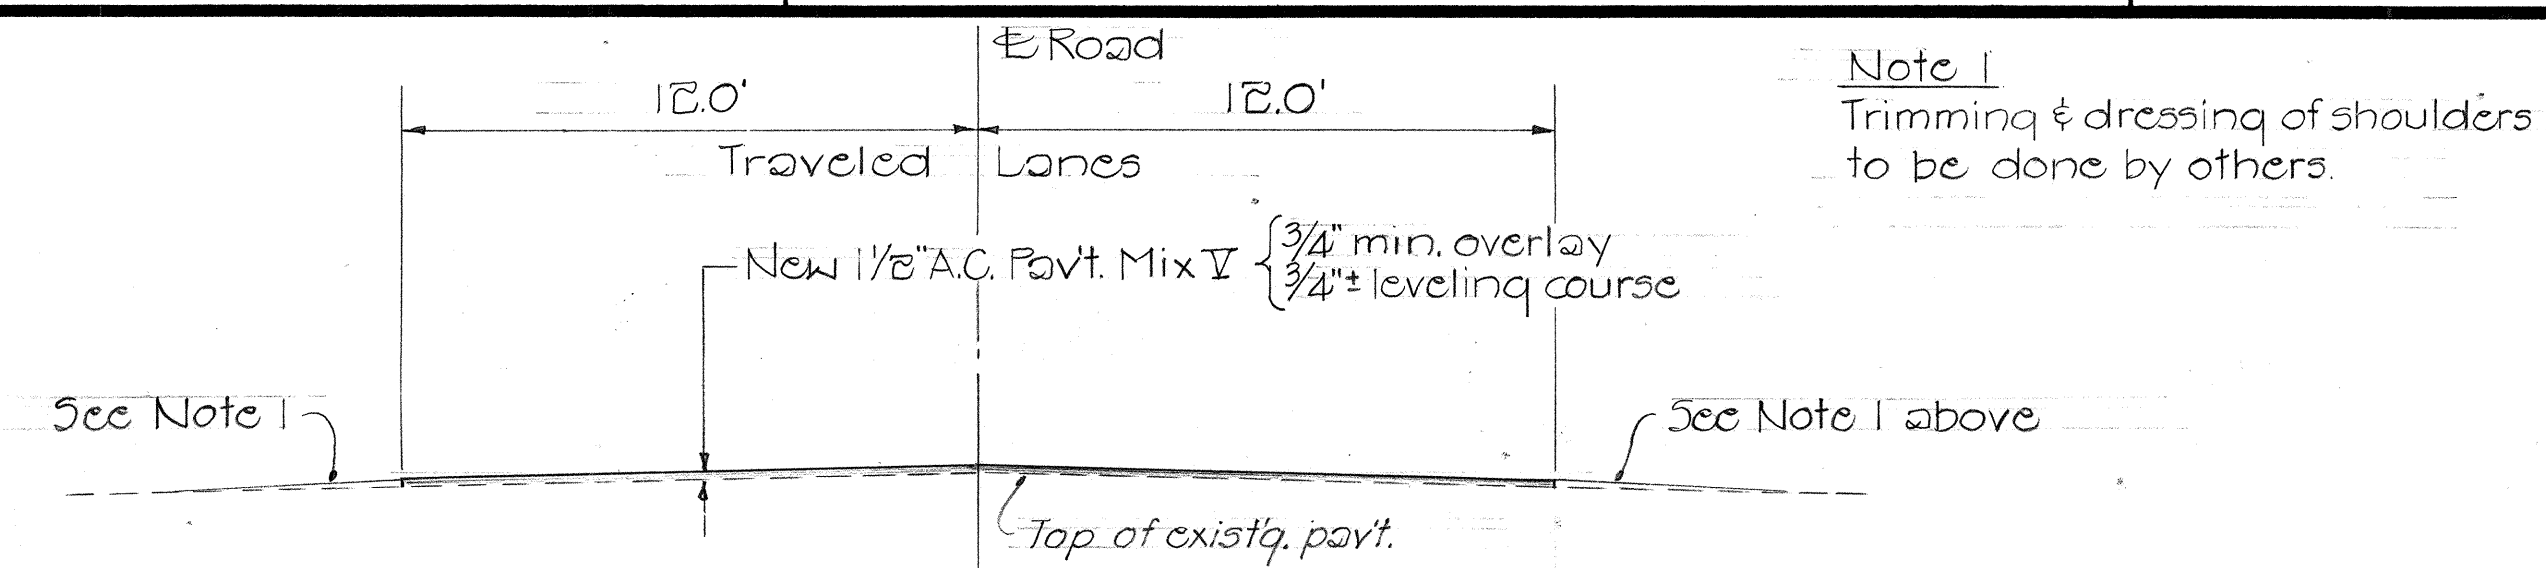


TYPICAL SECTION ①

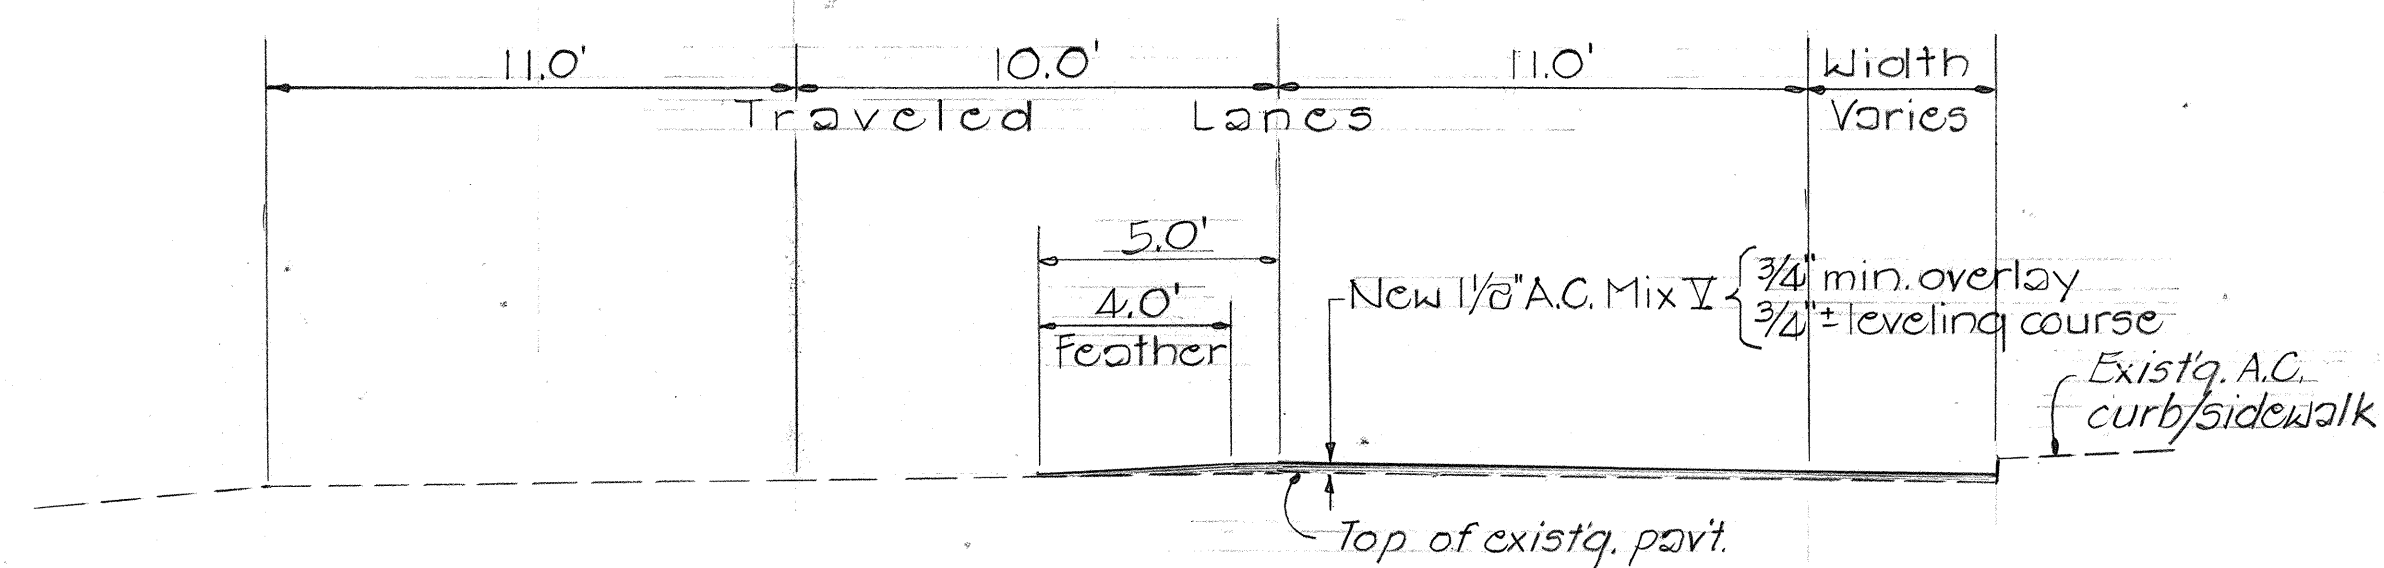


TYPICAL SECTION ②

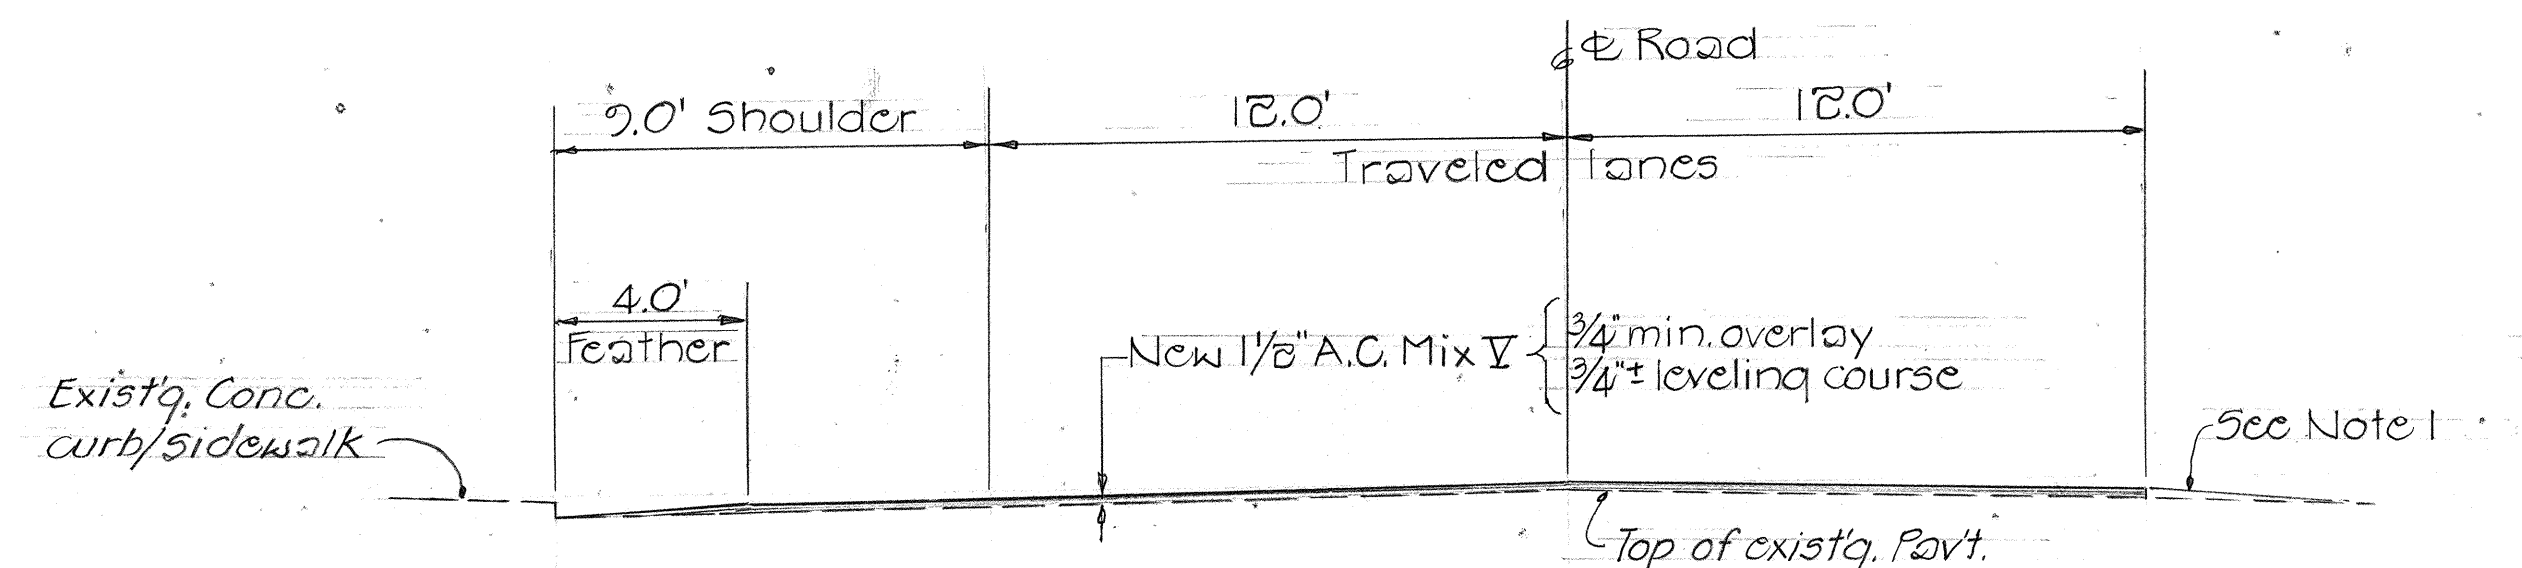


TYPICAL SECTION ③

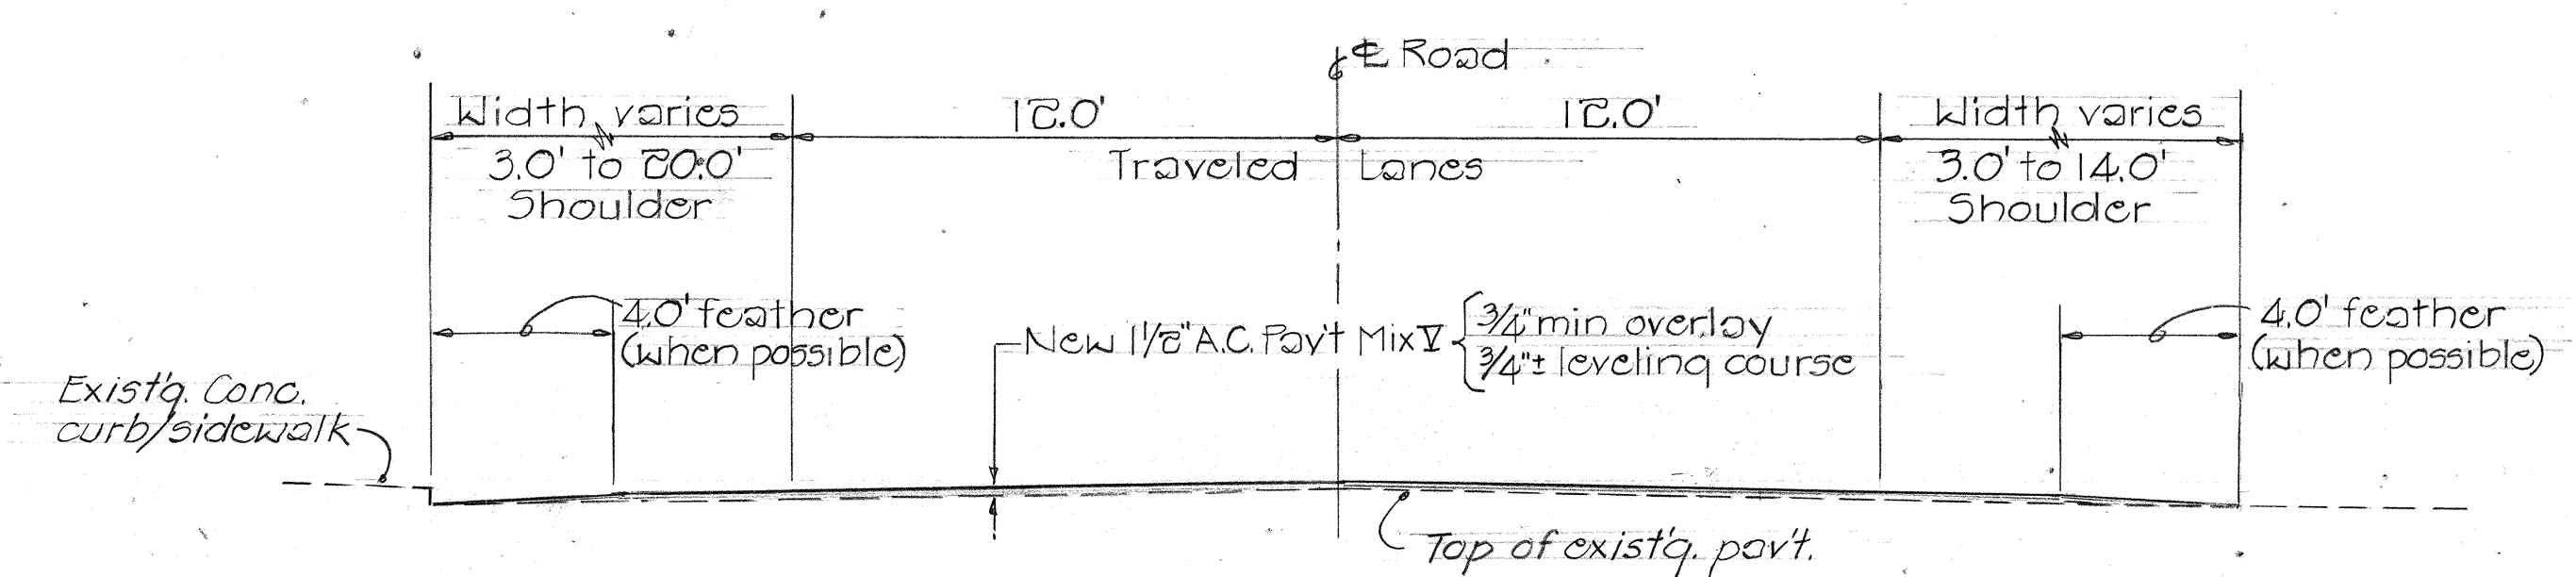


TYPICAL SECTION ④

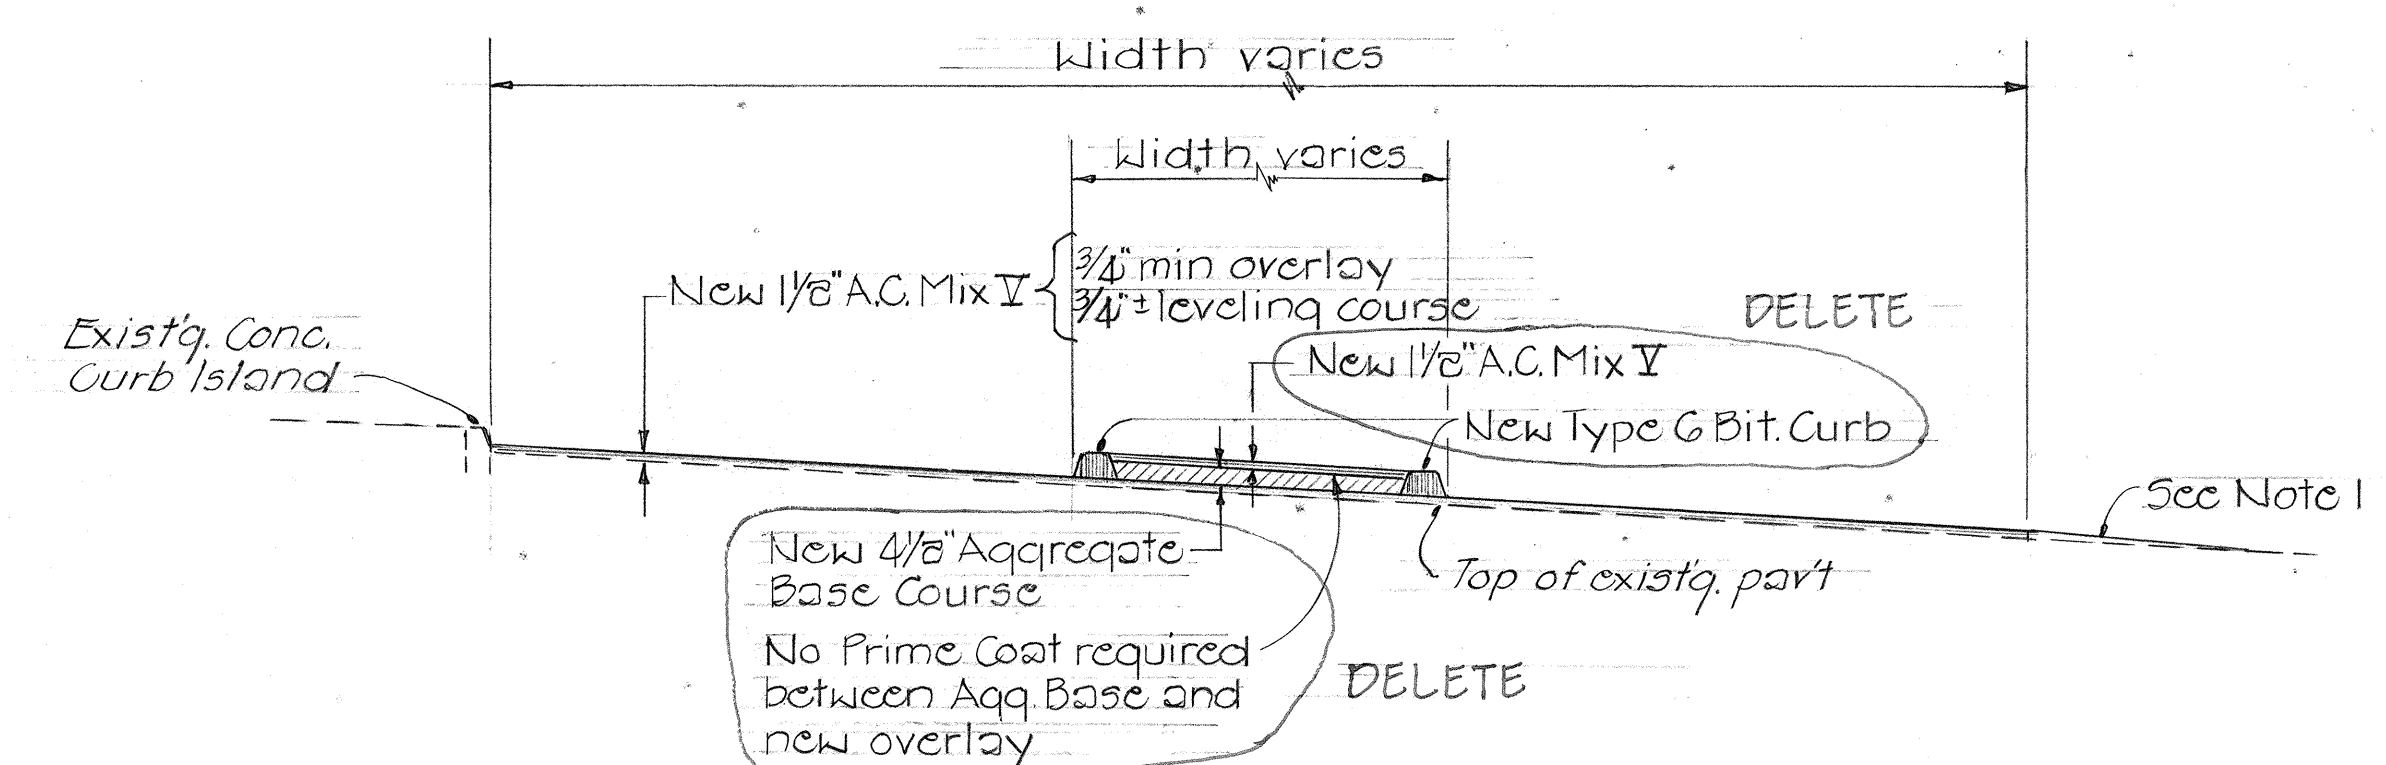


TYPICAL SECTION ⑤

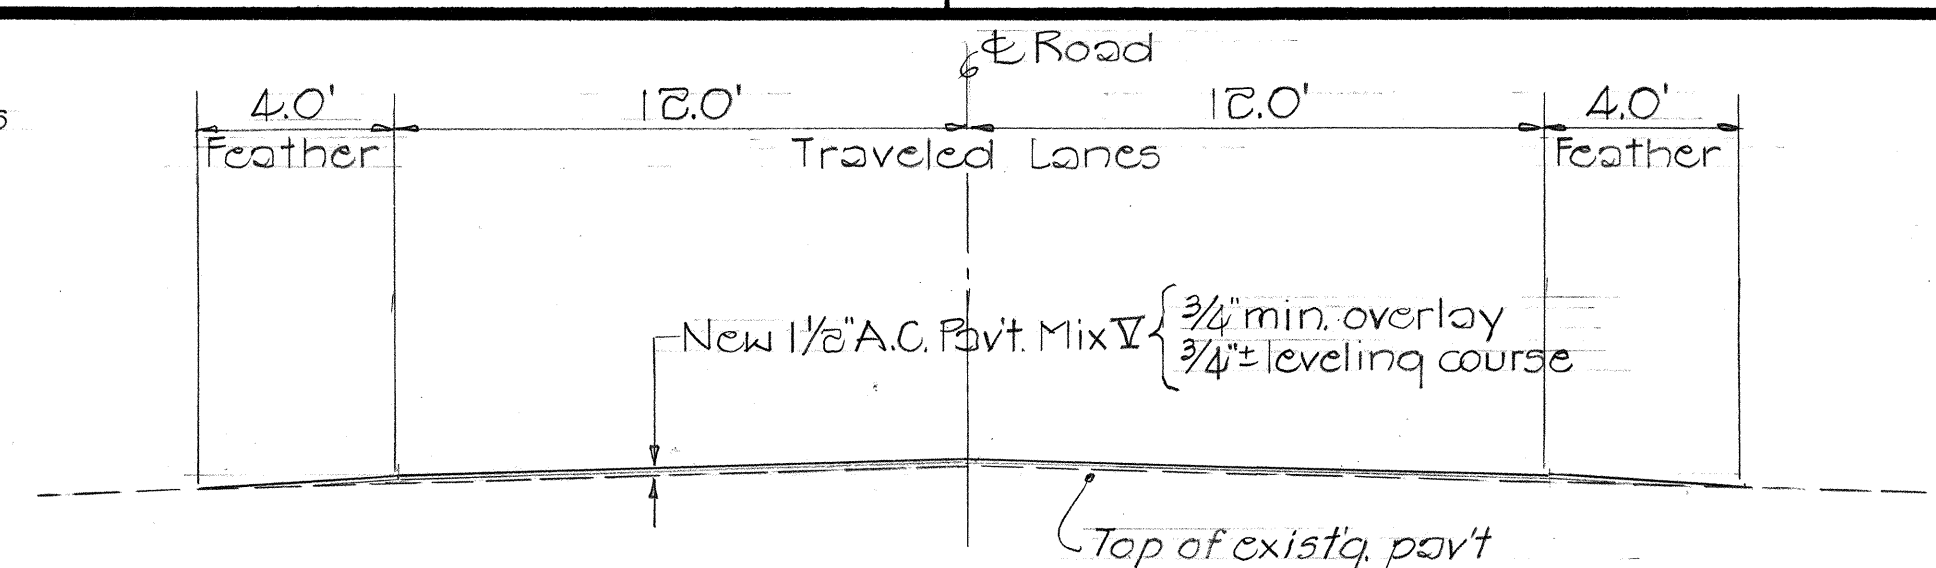

TYPICAL SECTION ⑥

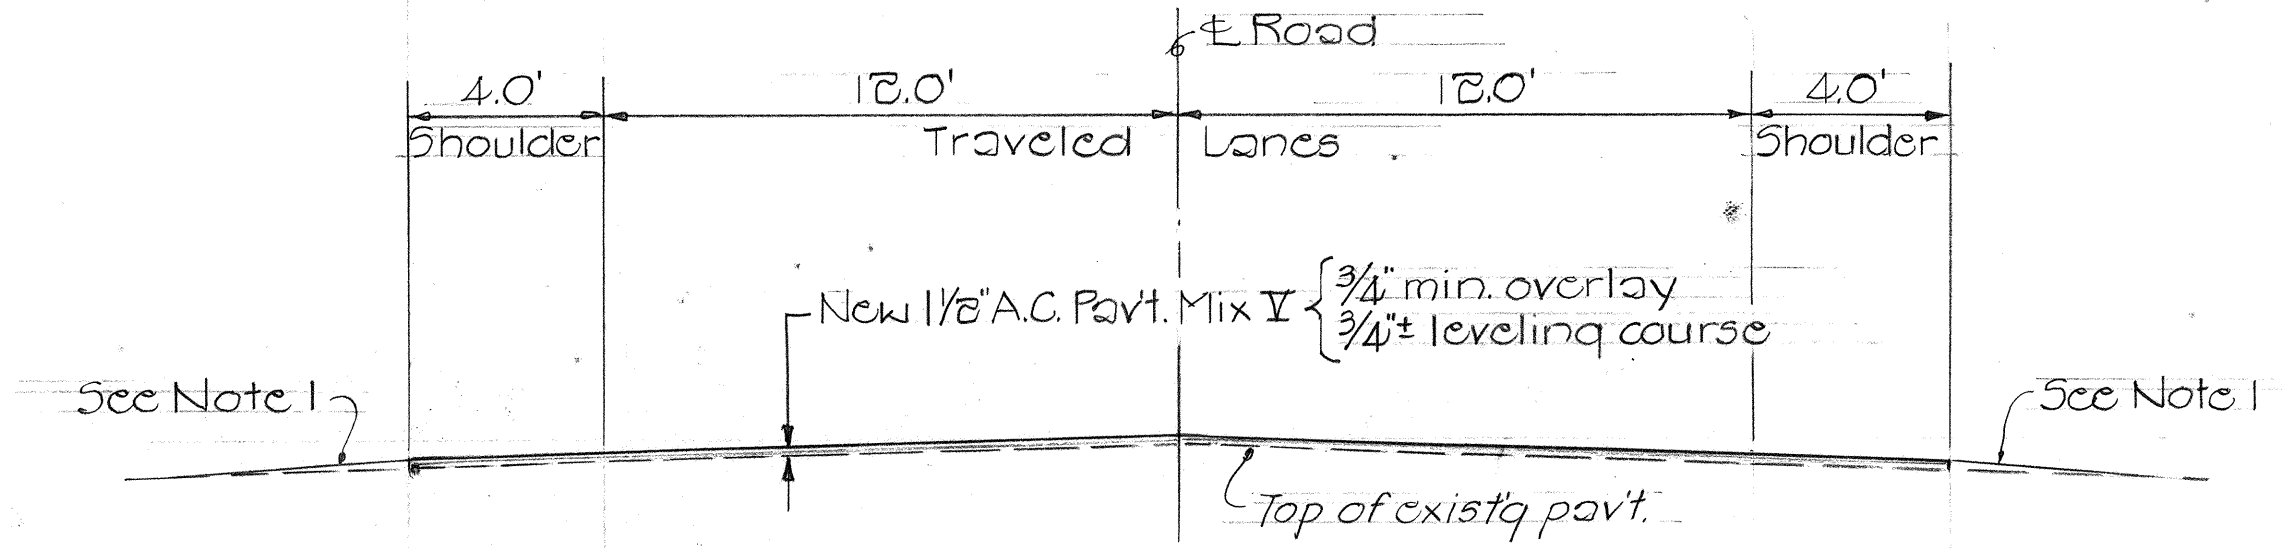

TYPICAL SECTION ⑦

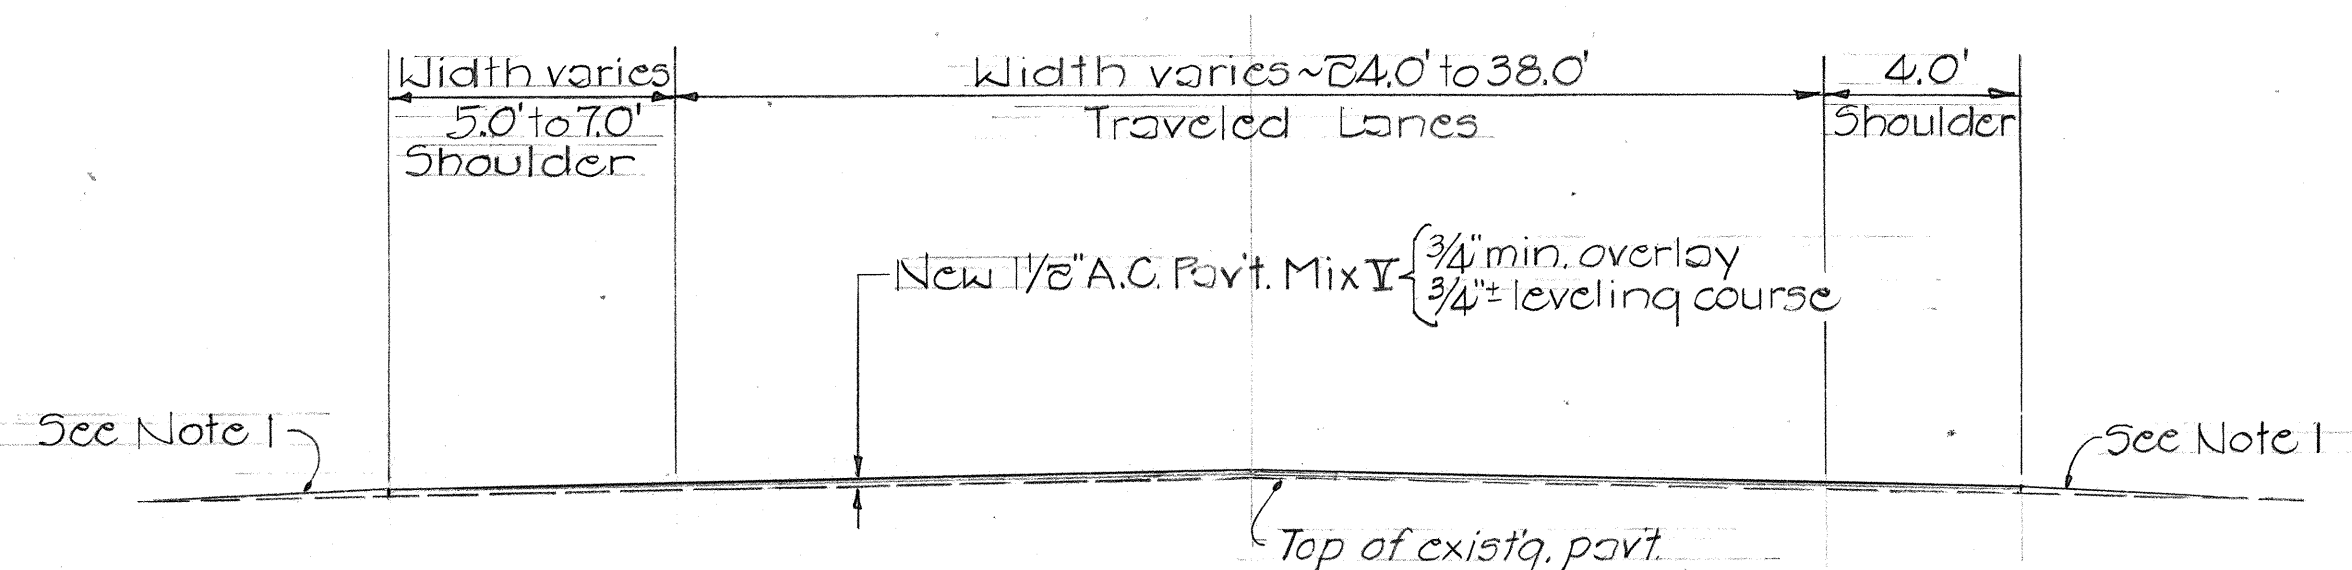

TYPICAL SECTION ⑧

CONSTRUCTION NOTES:

WILCOX HOSPITAL TOWARD LAUKINI RD.

- Sta. 129+00 to Sta. 132+25 See Plan, Sheet No. 4
- Sta. 132+25 to Sta. 147+75 See Typical Section ⑥ & Plan, Sheet No. 4

WAIPOULI TO WAIKAEA CANAL

- Sta. 500+00 to Sta. 514+00 See Typical Section ③ & Plan, Sheet No. 4
- Sta. 514+00 to Sta. 519+80 See Typical Section ④ & Plan, Sheet No. 4

HANAPEPE

- Sta. 241+60 to Sta. 284+10 See Typical Section ① & Plan,

ELEELE

- Sta. 211+90 to Sta. 220+00 See Typical Section ① & Plan, Sheet No. 3
- Sta. 220+00 to Sta. 228+60 See Typical Section ⑤ & Plan, Sheet No. 3

KEALIA TOWARDS ANAHOLA

- Sta. 21+00 to Sta. 36+30
- Sta. 61+00 to Sta. 69+00
- Sta. 93+50 to Sta. 114+50

WAIHAWA TO KALAHEO

- Sta. 0+00 to 1+70 See Typical Section ⑥
- Sta. 1+70 to 2+50 See Typical Section ⑥
- Sta. 2+50 to Sta. 4+80 See Typical Section ⑥
- Sta. 4+80 to Sta. 5+25 See Typical Section ⑥
- Sta. 5+25 to Sta. 8+40 See Typical Section ⑥
- Sta. 8+40 to Sta. 9+50 See Typical Section ⑥
- Sta. 9+50 to 35+00 See Typical Section ①

NAWILIWILI RD. TO LALA RD.

- Sta. 0+00 to Sta. 6+25 See Typical Section ①
- Pave traveled lanes 22' wide

AHUKINI RD.

- Sta. 1+00 to Sta. 8+80 See Typical Section ⑦
- Pave Lt. shoulder only
- Sta. 8+80 to Sta. 51+00 See Typical Section ⑦

- Sta. 51+00 to Sta. 60+80 See Typical Section ⑧
- Sta. 60+80 to Sta. 79+06.31 See Typical Section ⑦
- Sta. 2+40 Rt. } Pave 20' into approach
- Sta. 5+20 Rt. } with last 4' feathered
- Sta. 8+50 Rt. }
- Sta. 18+20 Rt. }
- Sta. 25+20 Rt. } Provide 4' feather
- Sta. 27+30 Rt. & Lt. }

ANAHOLA TOWARDS PAPAA

- Sta. 47+00 to Sta. 71+00 See Typical Section ①
- Sta. 50+00 Lt. - Pave Scenic Stop w/ 1 1/8" A.C. Pavt. Mix V

STATE OF HAWAII
DEPARTMENT OF TRANSPORTATION
LAND TRANSPORTATION FACILITIES DIVISION
RESURFACING STATE HIGHWAYS
VARIOUS LOCATIONS
PROJ. No. LT-K-01-79M
TYPICAL SECTIONS
Scale: 1/4" = 1'-0" May 1978
SHEET NO. 1 OF 1 SHEETS

SURVEY PLOTTED BY	DATE
DRAWN BY	
CHECKED BY	
NOTED BY	
QUANTITIES BY	
CHECKED BY	
ORIGINAL PLAN	
NOTE BOOK	
No.	