



FED. ROAD DIST. NO.	STATE	PROJ. NO.	FISCAL YEAR	SHEET NO.	TOTAL SHEETS
HAWAII	HAW.	HWY-K-02-75	1978	2	7

GENERAL NOTES:


- 1-Trimming and dressing of Shoulders shall include but not be limited to clearing, grubbing, grading and compacting the shoulder area as shown on the "Typical Sections." This item shall not be paid for directly but shall be considered incidental to the various contract items.
- 2-The contractor may import selected material approved by the Engineer to facilitate his work in dressing shoulder to the required grade. It shall be understood that the contractor shall receive no additional compensation for importing and placing this selected material.
- 3-Materials designated to be salvaged shall be stockpiled at the job site as directed by the Engineer. Payment for salvaging shall be considered incidental to the various items of work.
- 4-Use Series "C" G" Lettering for Signs DG-1 and DG-2.

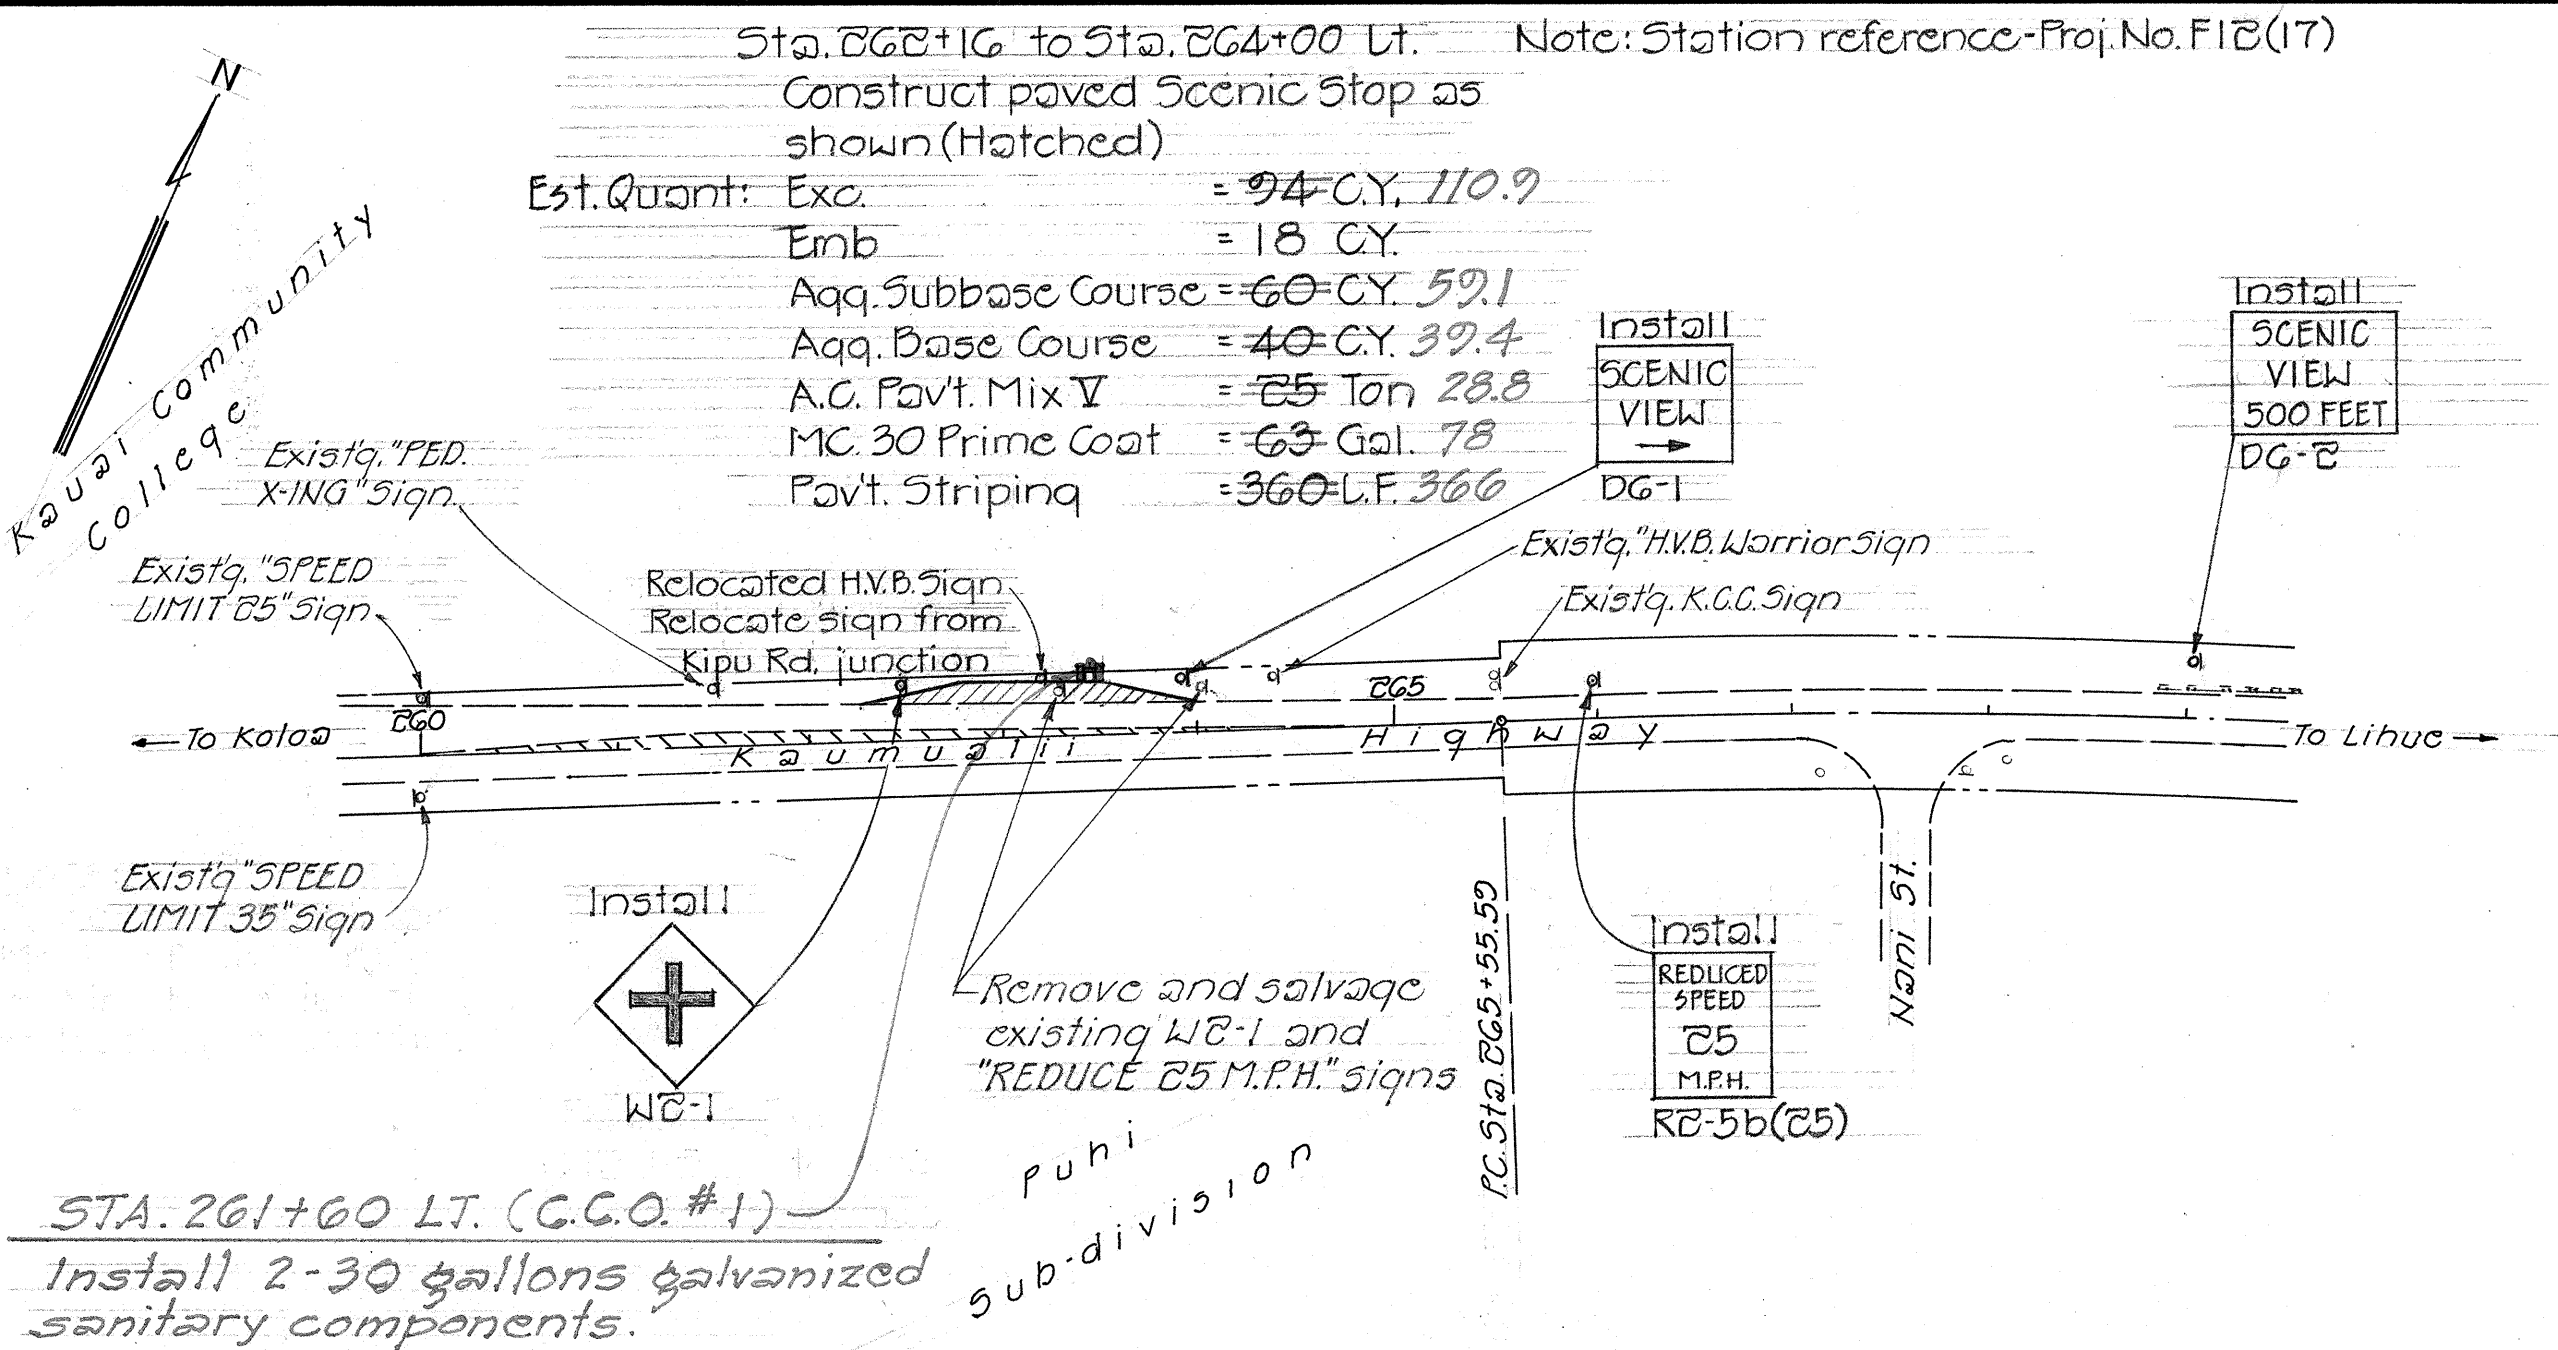



PLAN Scale: 1"=100'

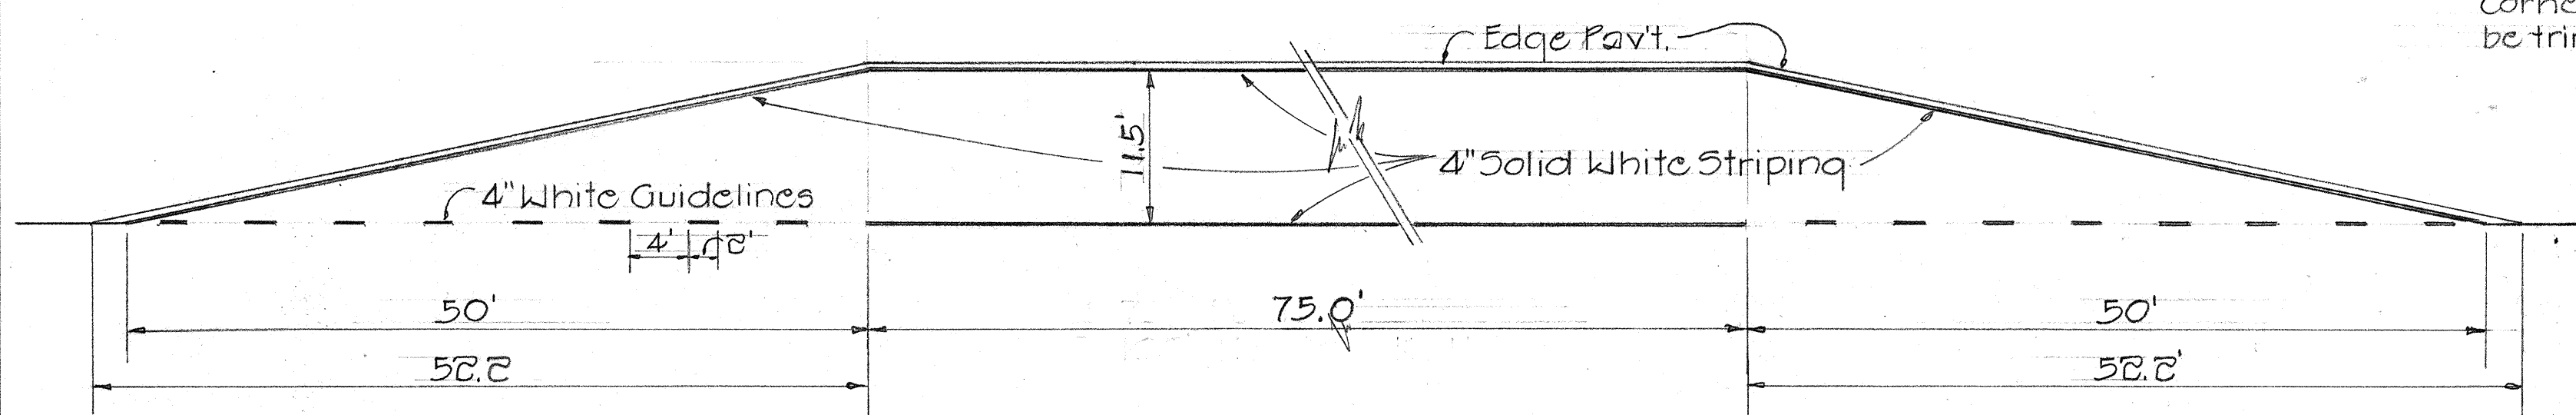



DETAILS ~ SCENIC STOP Scale: 1"=10'

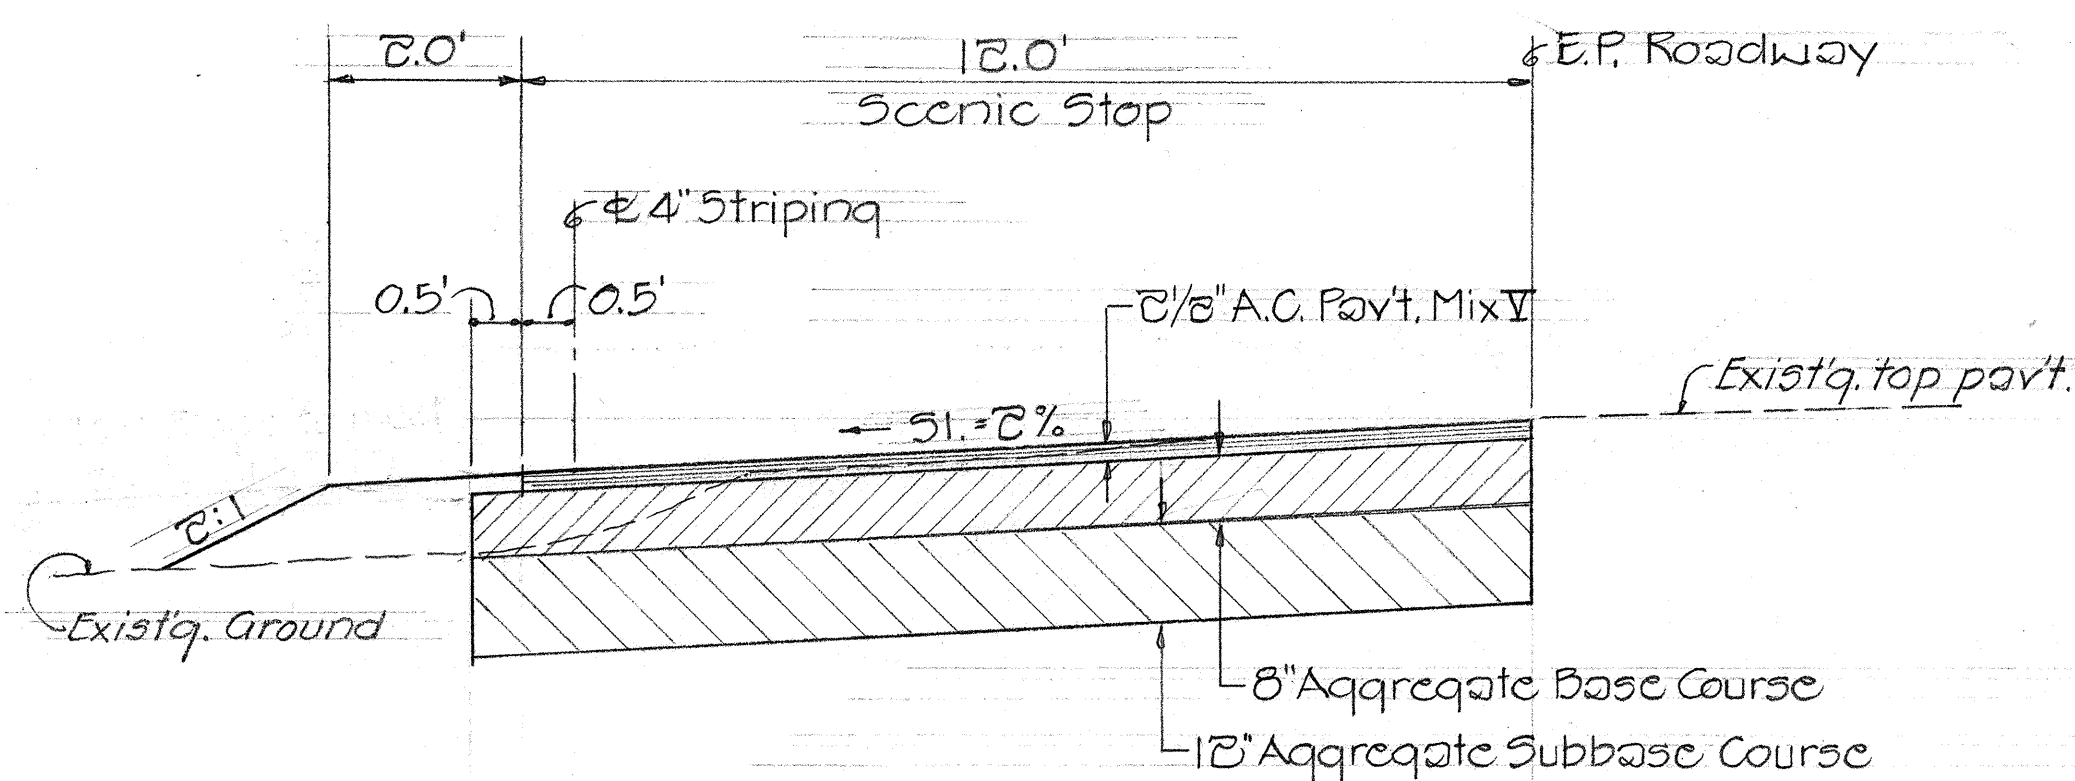

TYPICAL SECTION ~ SCENIC STOP Scale: 1/2"=1'-0"

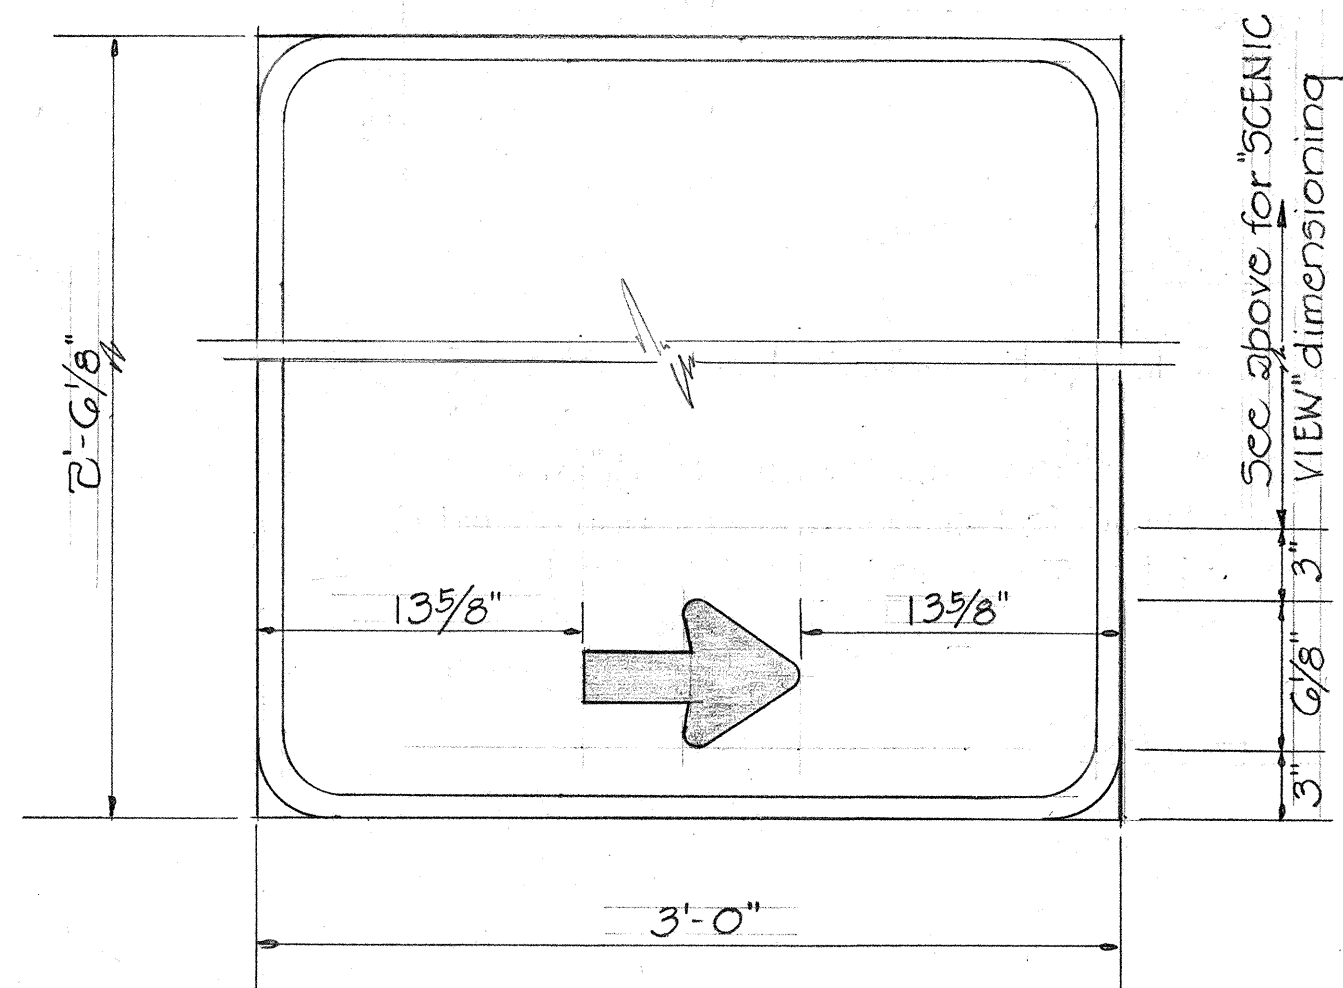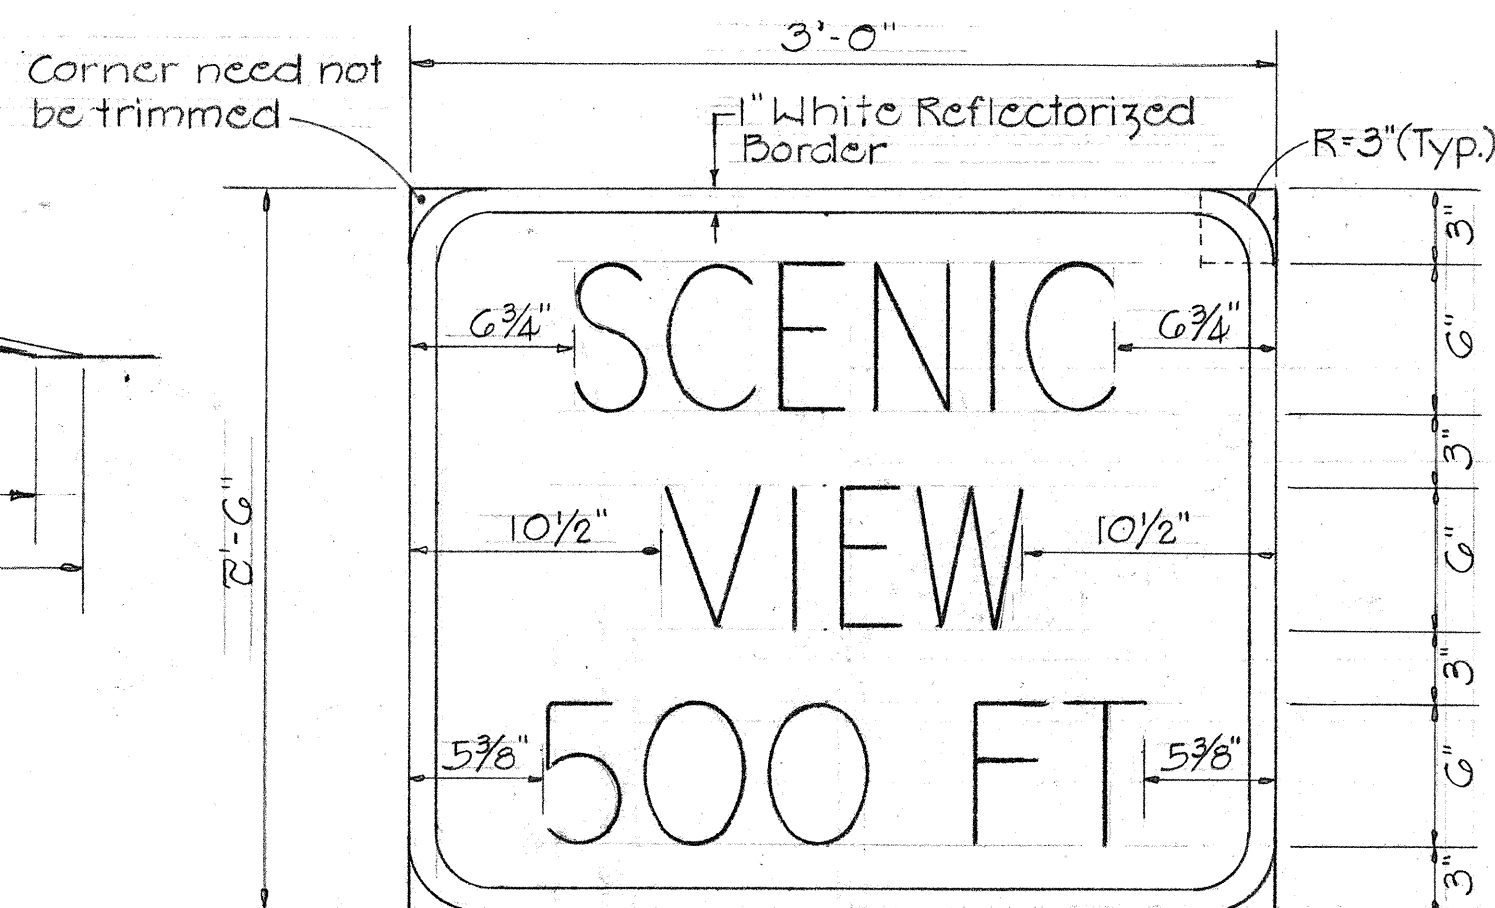

SIGN DETAILS

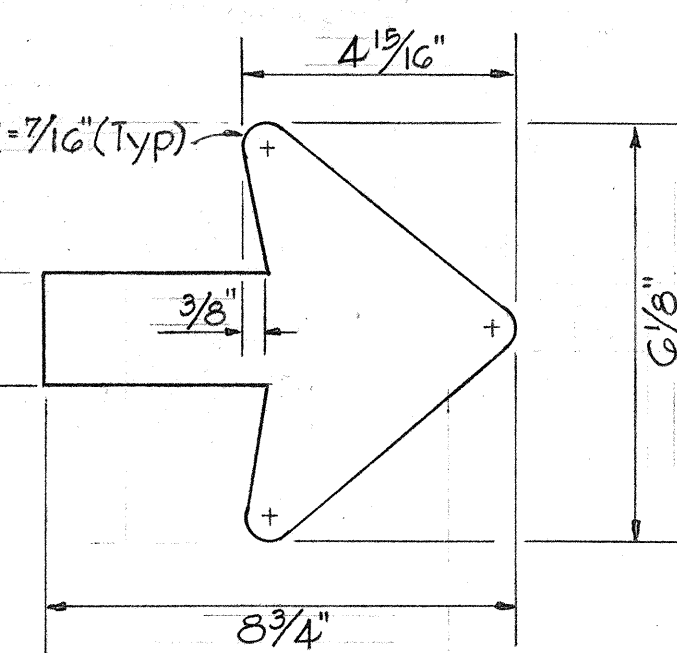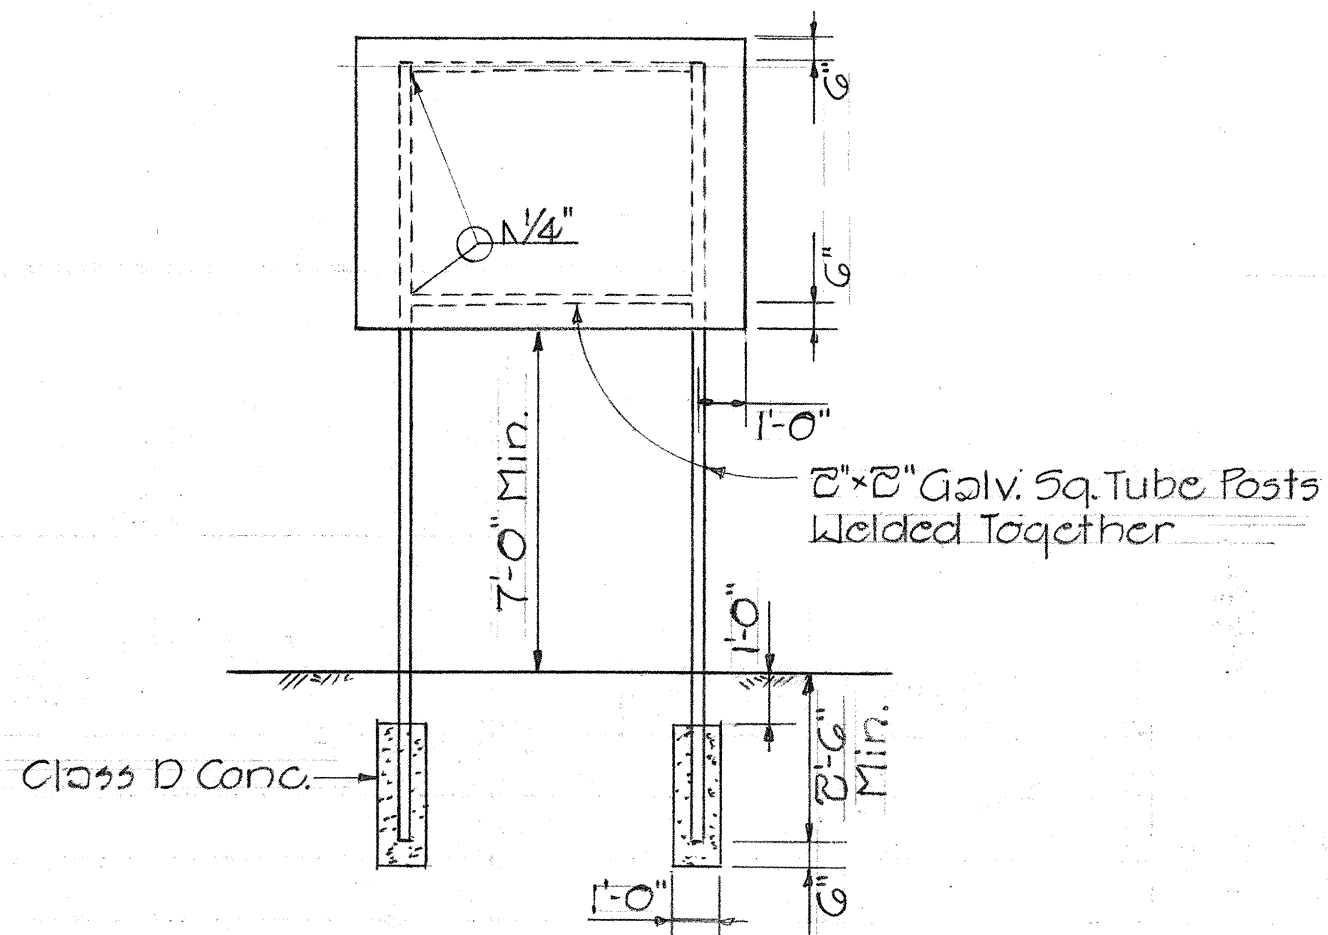

ARROW DETAIL N.T.S.

STATE OF HAWAII DEPARTMENT OF TRANSPORTATION LAND TRANSPORTATION FACILITIES DIVISION SAFETY AND MISCELLANEOUS IMPROVEMENTS AT VARIOUS LOCATION, KAUAI PROJ. No. HWY-K-02-75 PLAN-SCENIC STOP - PUHI-VICINITY OF KAUAI COMMUNITY COLLEGE & MISC. DETAILS Scale: As shown SHEET No. 1 OF 1 SHEETS	Sept 1977
--	-----------

