

INDEX TO DRAWINGS	
SHEET NO.	DESCRIPTION
1	TITLE SHEET
2	PLAN-SCENIC STOP-PUHI-VICINITY OF KAUAI COMMUNITY COLLEGE & MISC. DETAILS
3	PLAN-TURNAROUND & SCENIC STOP HOLO-HOLO-KU HEIAU
4-7	STANDARD DETAILS

12/21/78

Date

548-7534

Phone-Loc

R. MIKAMI

PS&E By

Kauai District

Designed By

STATE OF HAWAII

DEPARTMENT OF TRANSPORTATION

LAND TRANSPORTATION FACILITIES DIVISION

"AS BUILT"

PLANS FOR


SAFETY & MISCELLANEOUS IMPROVEMENTS

AT VARIOUS LOCATIONS, KAUAI

PROJECT NO. HWY-K-02-75

DISTRICT OF LIHUE AND KAWAIHAU

ISLAND OF KAUAI

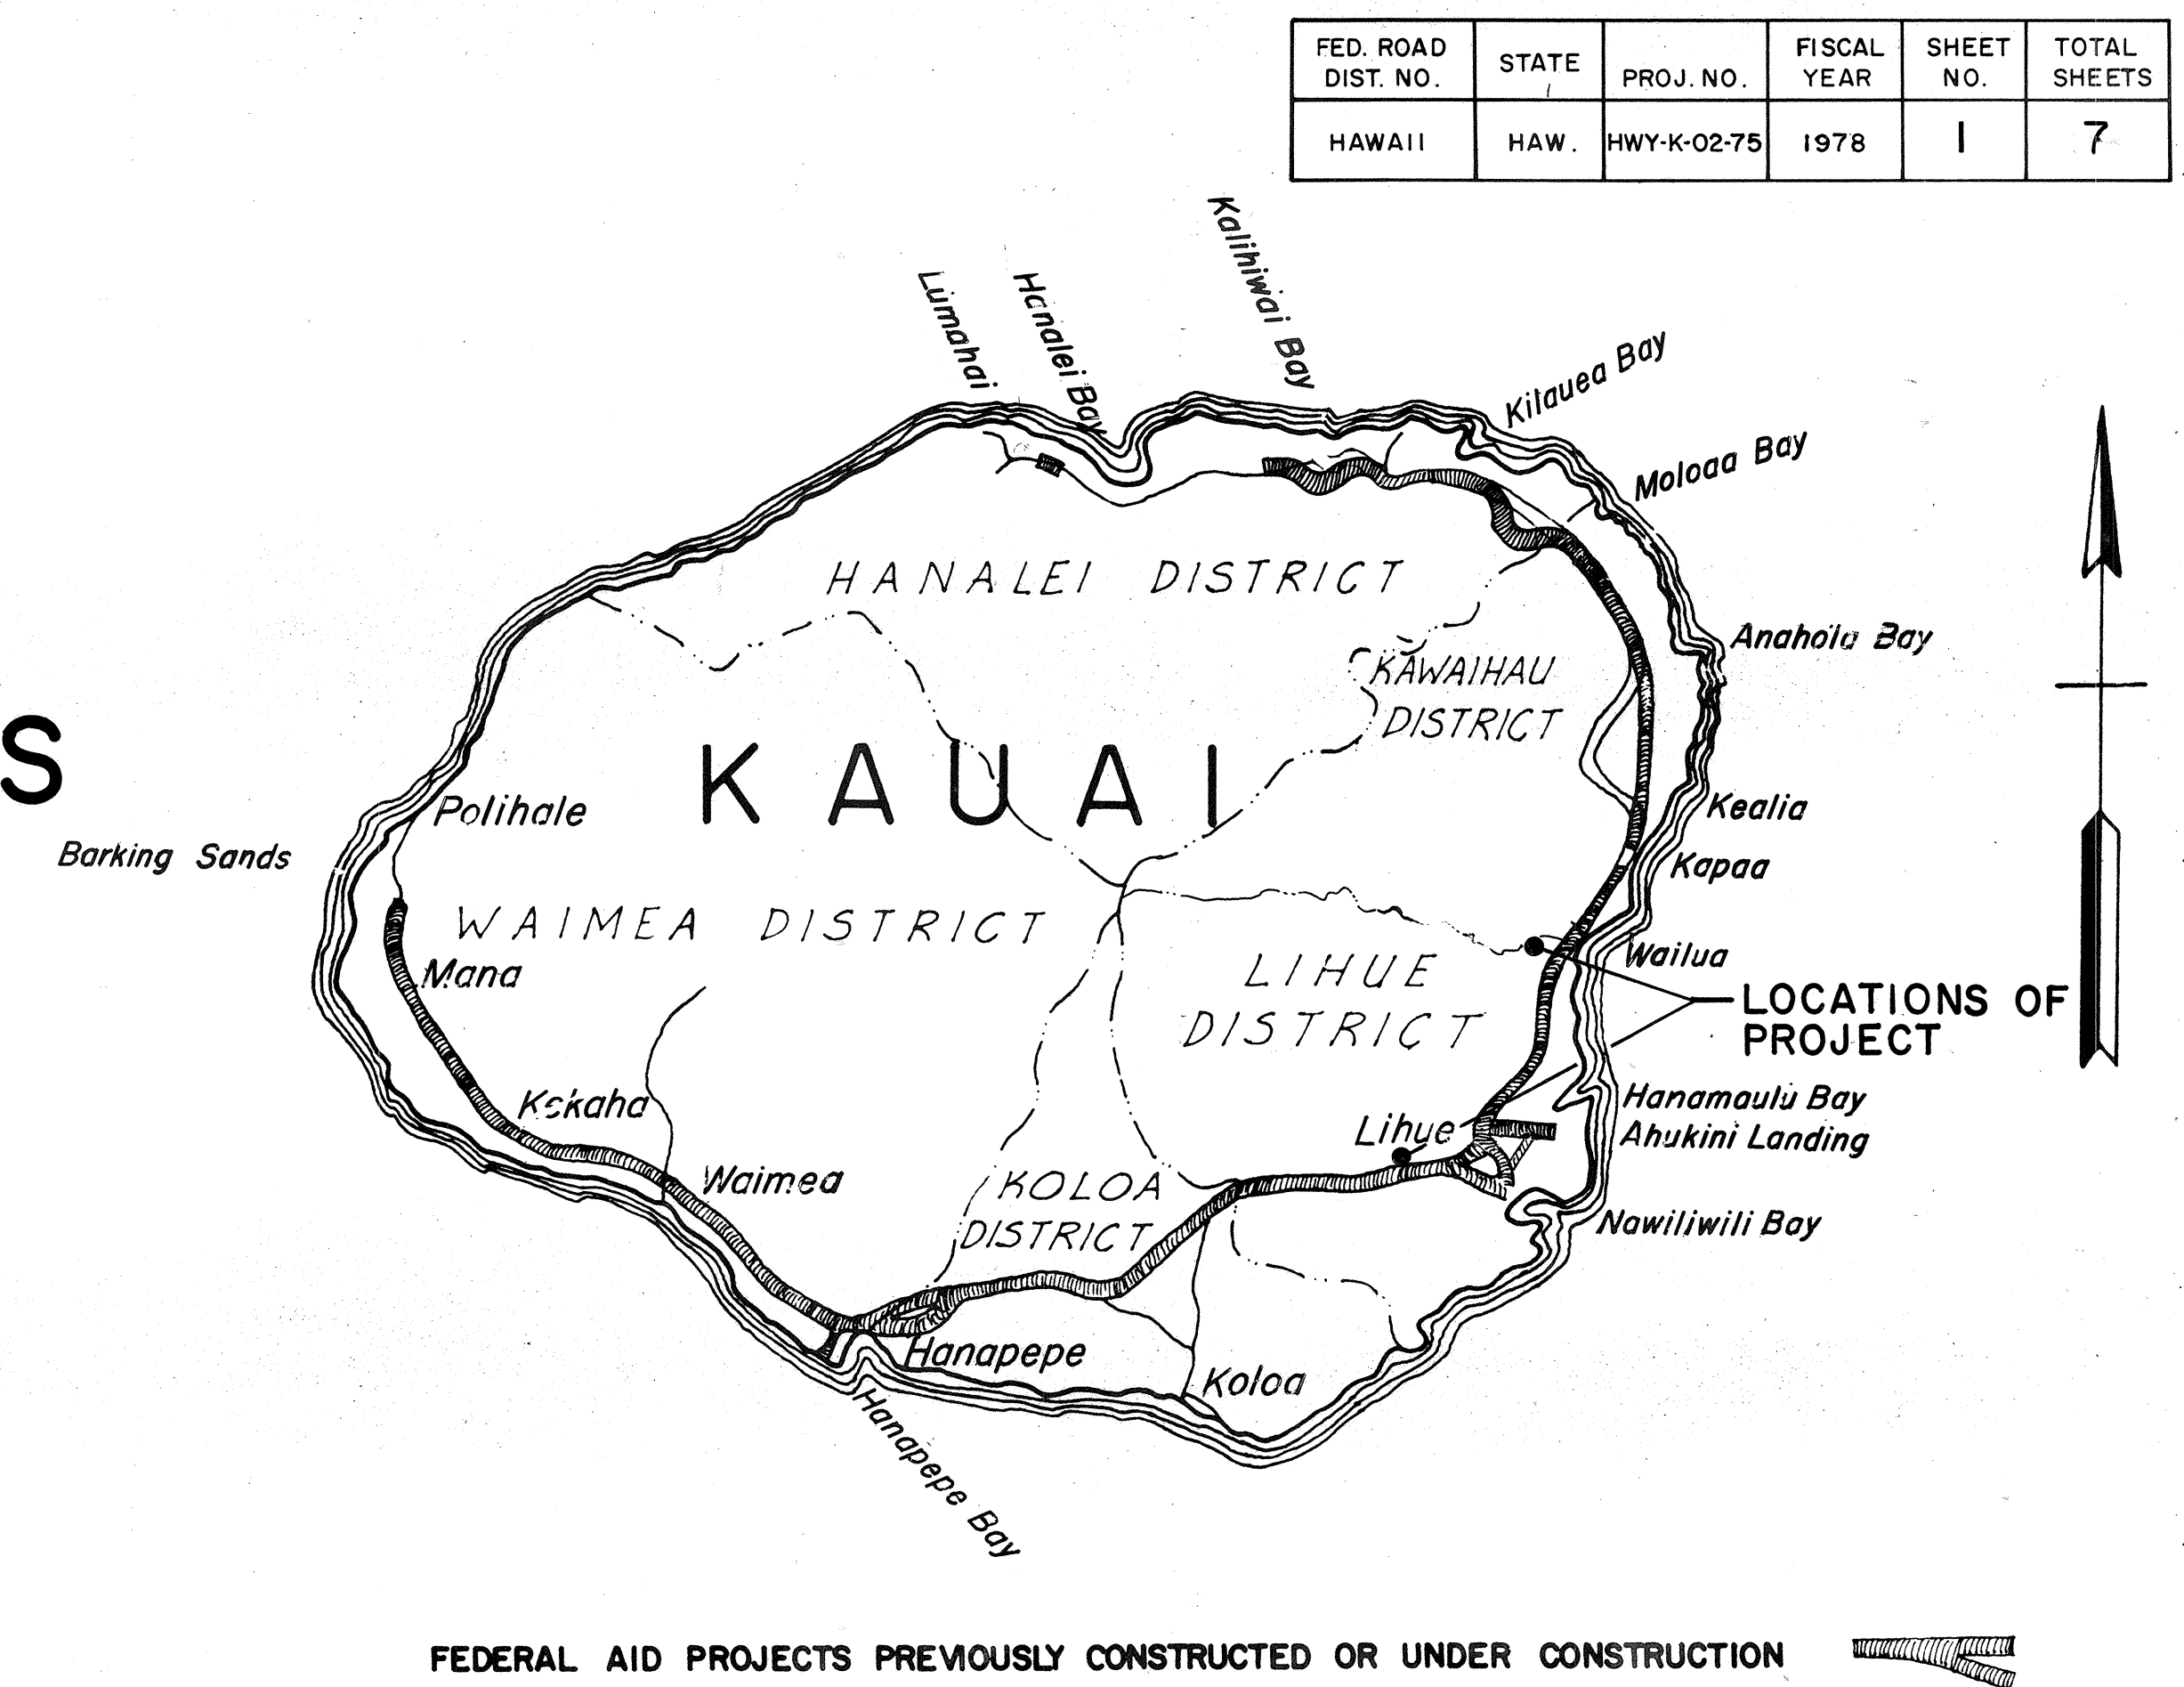

ALL CHANGES MADE DURING CONSTRUCTION

HAVE BEEN INCORPORATED ON THESE PLANS

EXCEPT CHANGES IN THE ORIGINAL THEORETICAL


QUANTITIES

hepmasap

PROJECT ENGINEER

7-21-80

DATE

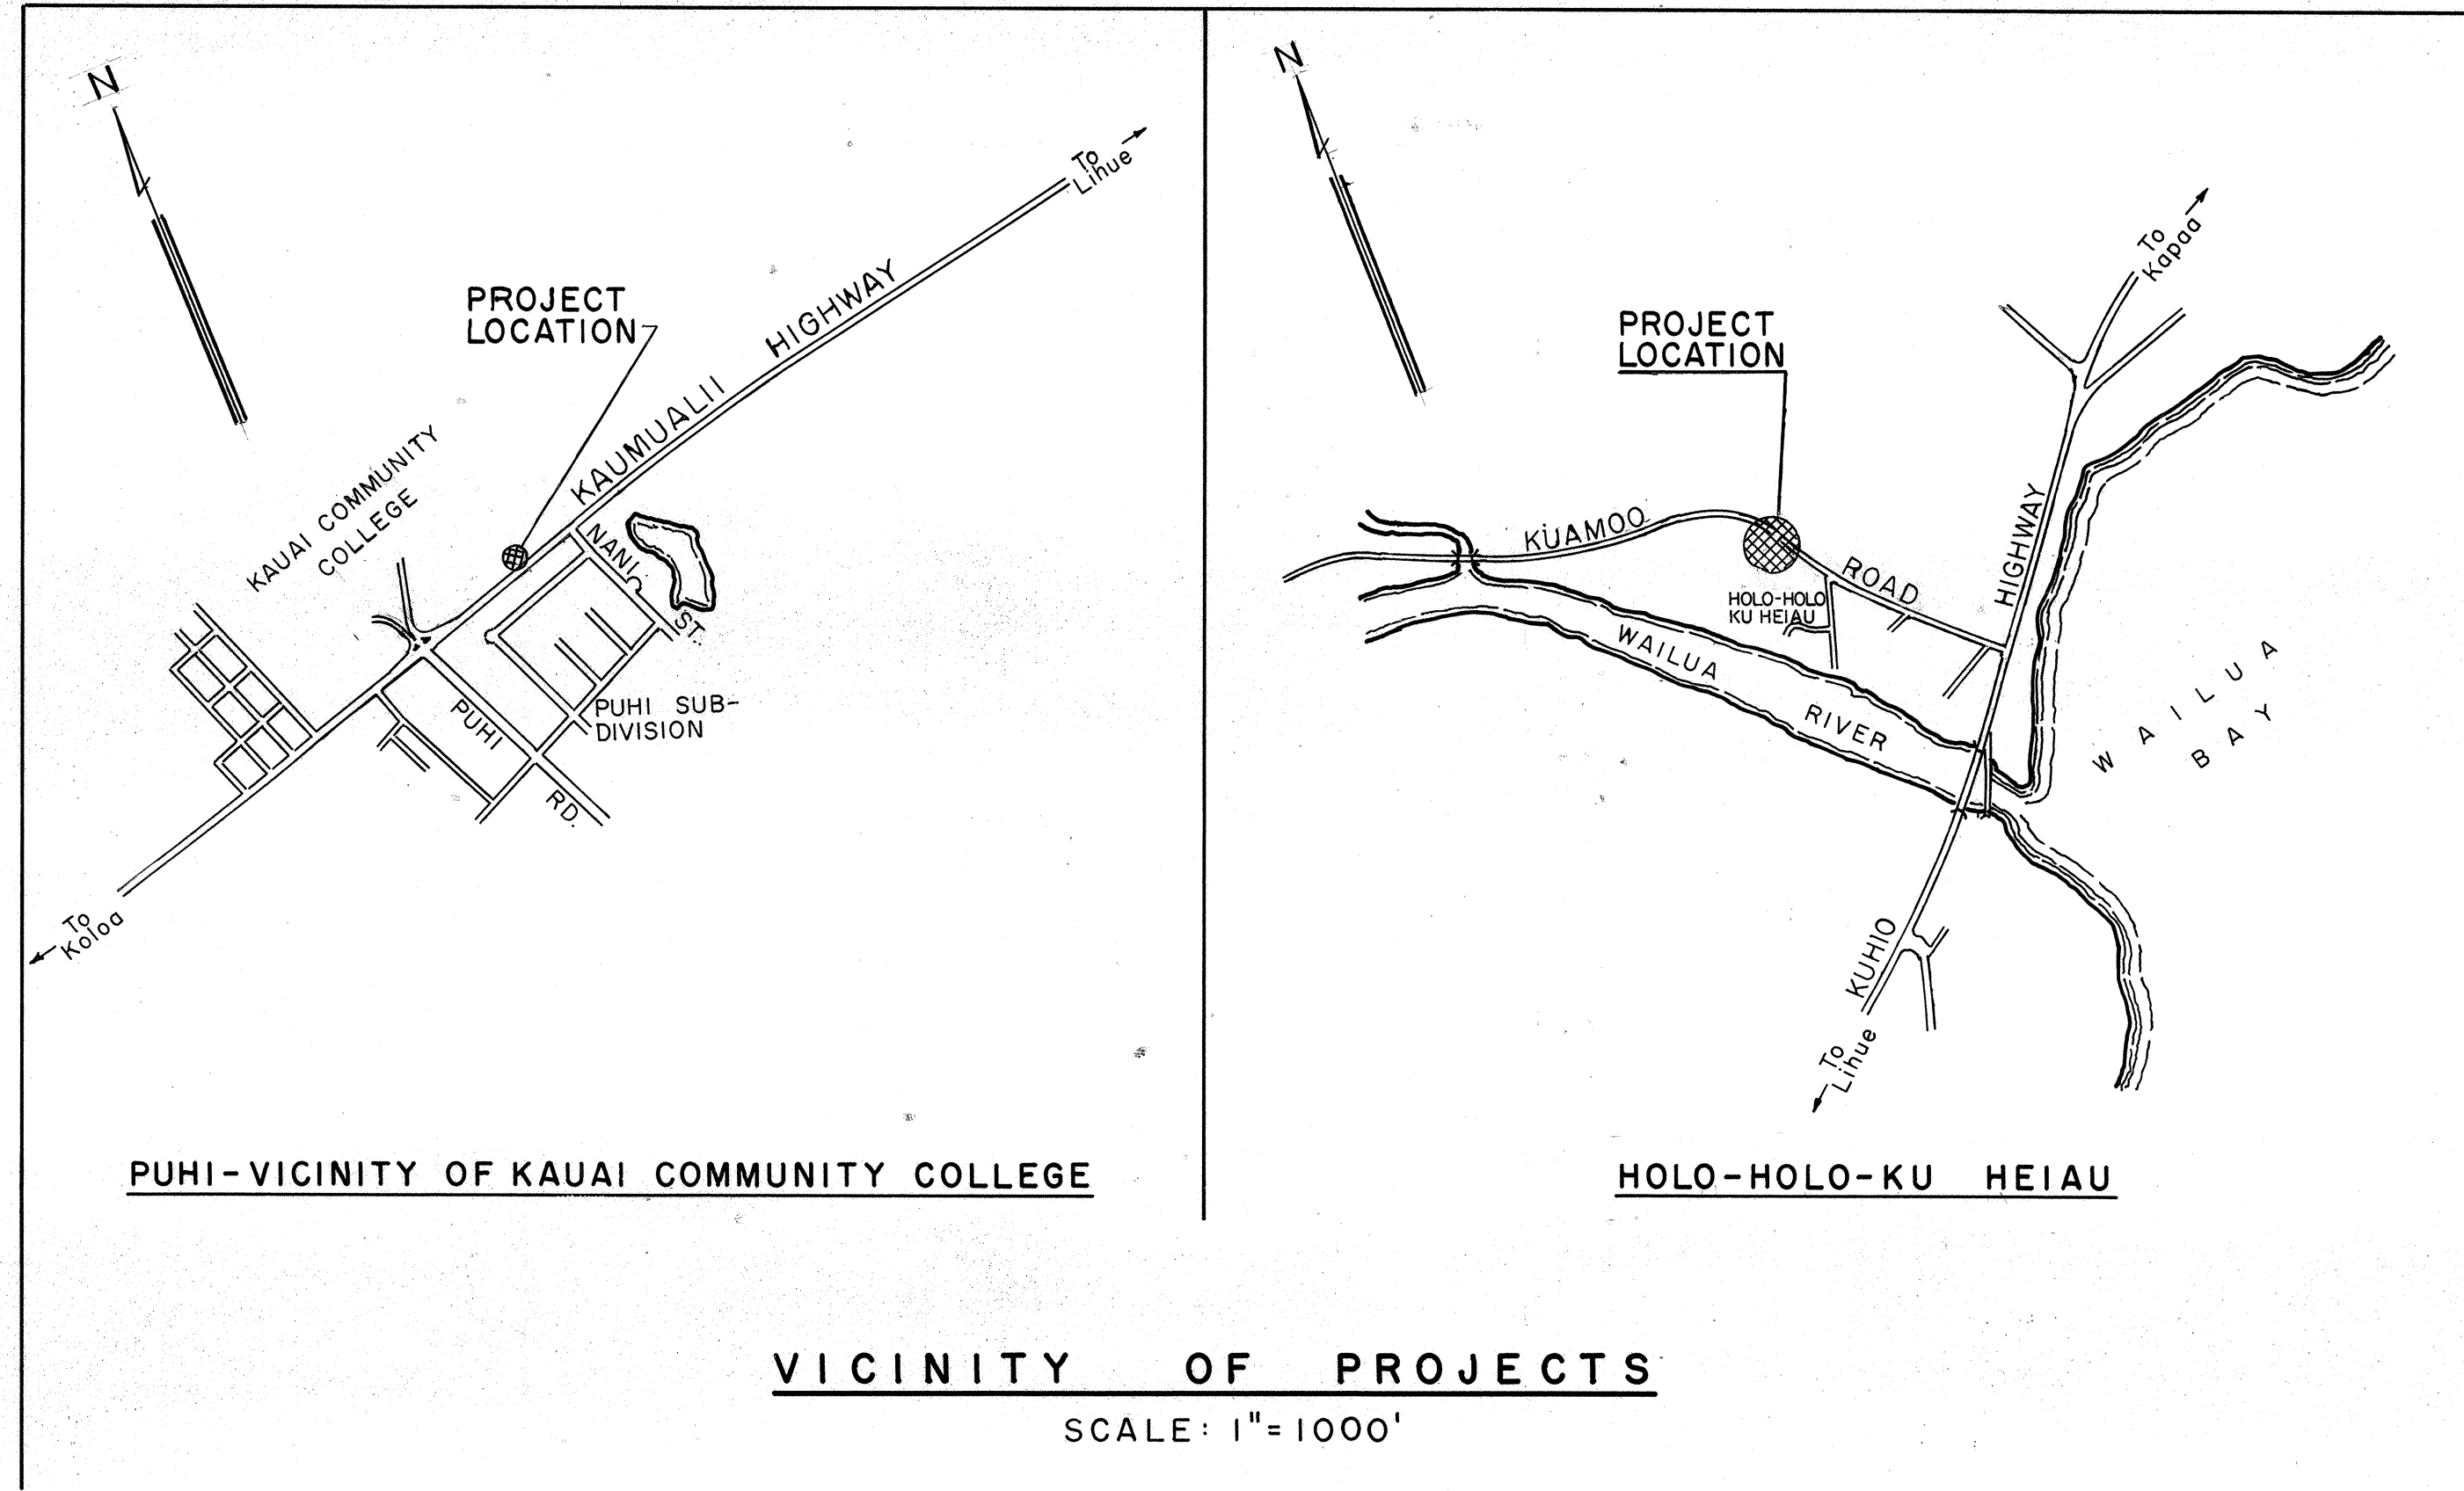

DEPARTMENT OF TRANSPORTATION

STATE OF HAWAII

APPROVED:

Ryohichi Higashimura

DIR. OF TRANSPORTATION

12-21-78

DATE

DATE

DESIGNED BY

DRAWN BY

TRACED BY

QUANTITIES CHECKED BY

CHECKED BY

ORIGINAL

PLAN

NOTE BOOK

NO.

3812-2122

00-D-9-5