



FED. ROAD DIST. NO.	STATE	PROJ. NO.	FISCAL YEAR	SHEET NO.	TOTAL SHEETS
HAWAII	HAW.	LT-K-03-80M	1980	3	6

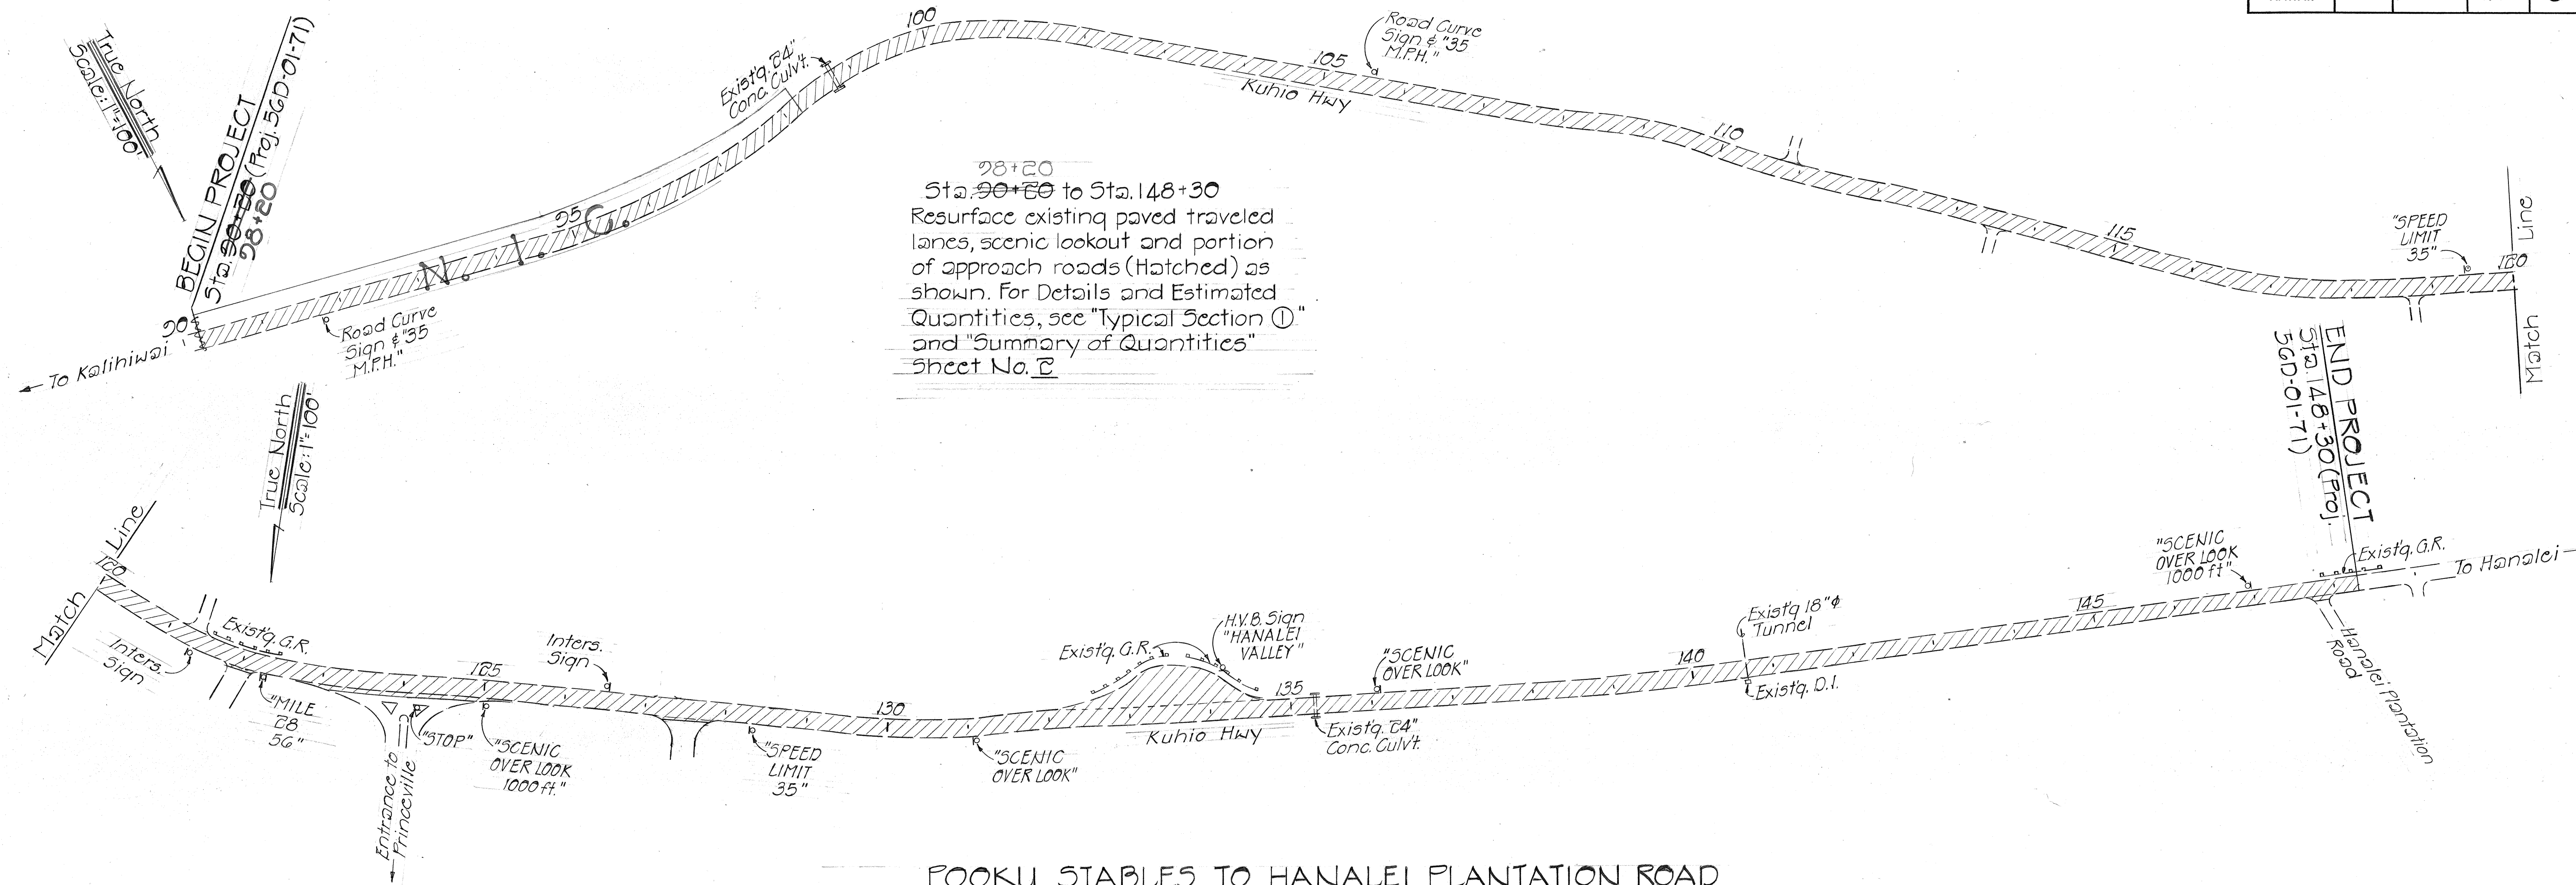

POOKU STABLES TO HANAIEI PLANTATION ROAD

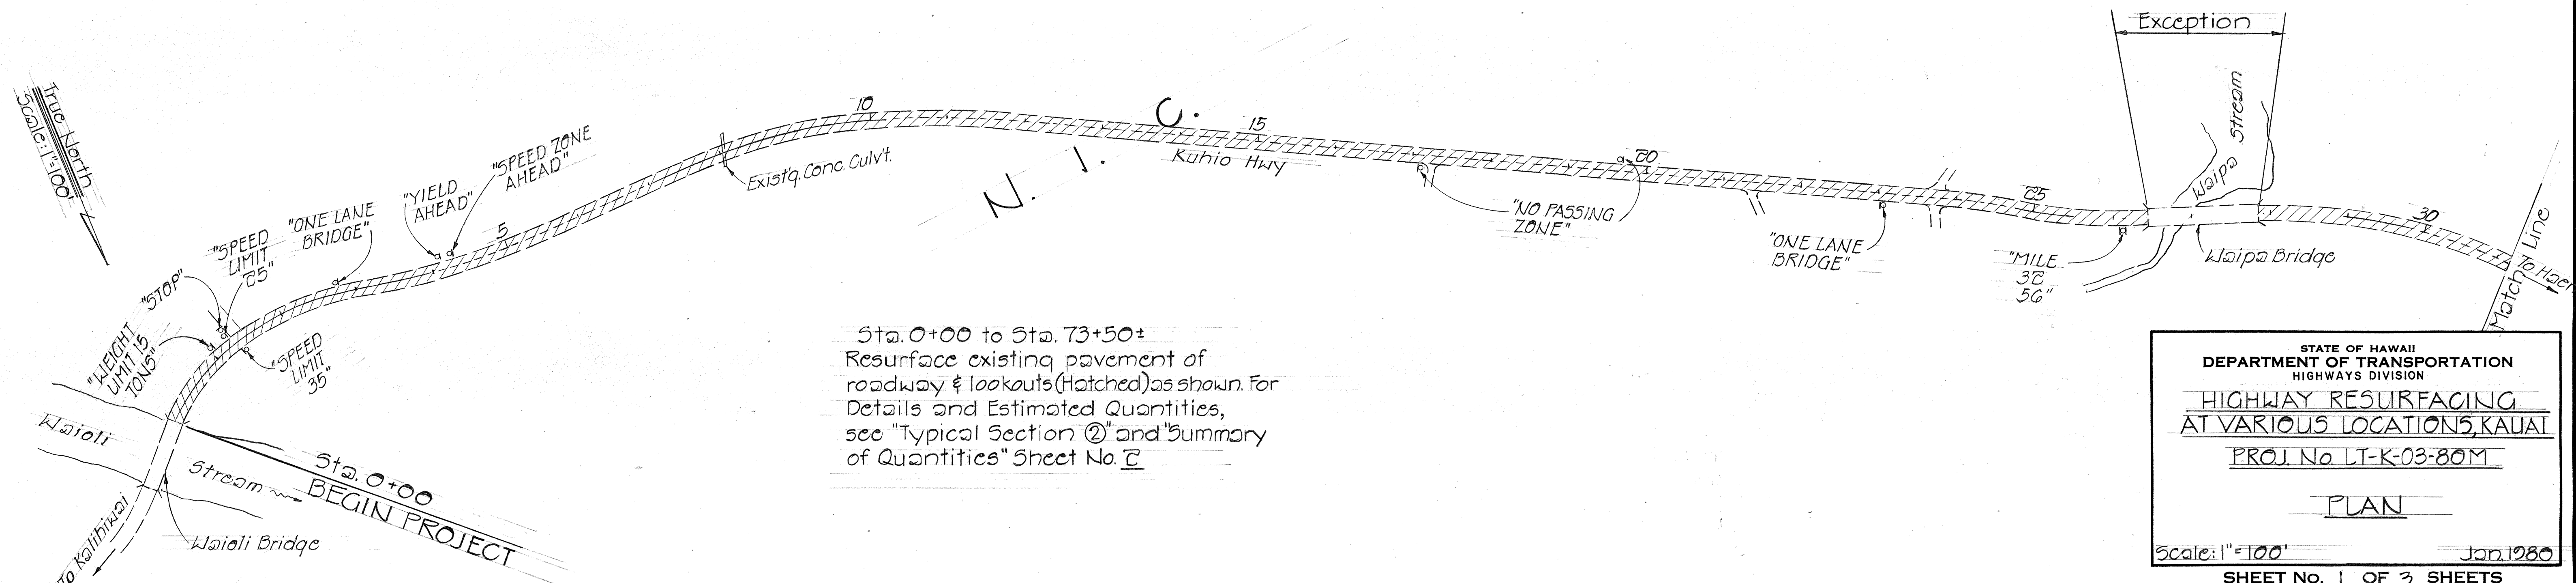

Sta. 0+00 to Sta. 73+50±
Resurface existing pavement of roadway & lookouts (Hatched) as shown. For Details and Estimated Quantities, see "Typical Section ②" and "Summary of Quantities" Sheet No. 2

STATE OF HAWAII
DEPARTMENT OF TRANSPORTATION
HIGHWAYS DIVISION
HIGHWAY RESURFACING
AT VARIOUS LOCATIONS, KAUAI
PROJ. No. LT-K-03-80M
PLAN
Scale: 1"=100' Jan. 1980
SHEET No. 1 OF 3 SHEETS

ORIGINAL PLAN	SURVEY PLOTTED BY	DATE
DESIGNED BY		
NOTED BY		
CHECKED BY		
No.		

FED. ROAD DIST. NO.	STATE	PROJ. NO.	FISCAL YEAR	SHEET NO.	TOTAL SHEETS
HAWAII	HAW.	LT-K-03-80M	1980	4	6

Sta. 133+50 to Sta. 143+50
Resurface existing paved traveled lanes and shoulders (Hatched) as shown. For Details and Estimated Quantities, see "Typical Section ③" and "Summary of Quantities" Sheet No. ②

NORTH OF MOLOAA PAPAYA FARM

Sta. 309+88 to Sta. 387+73
Sta. 401+00 to Sta. 450+00
NOTE:
Resurface existing pavement and shoulders (Hatched) as shown. For Details, see "Typical Section ⑤" Sheet No. ②
"Mama Bridge No. 3 to Waimea Canyon Drive" see "Summary of Quantities" Sheet No. ②

Sta. 450+00 to Sta. 455+00
Install reinforcing fabric prior to resurfacing existing pavement and shoulders (Hatched) as shown. For Details, see "Typical Section ⑥" Sheet No. ②

Sta. 455+00 to Sta. 457+50
Resurface existing pavement and widen shoulders (Hatched) with Plant Mix Asphalt Treated Base & A.C. Pavt. Mix V. For Details, see "Typical Section ⑦" Sheet No. ②

STATE OF HAWAII
DEPARTMENT OF TRANSPORTATION
HIGHWAYS DIVISION

**HIGHWAY RESURFACING
AT VARIOUS LOCATIONS, KAUAI**


PROJ. NO. LT-K-03-80M

PLAN



Scale: 1"=100' Jan 1980

SHEET No. 2 OF 3 SHEETS


ORIGINAL PLAN	DATE
DESIGNED BY	
NOTED BY	
CHECKED BY	
NO.	

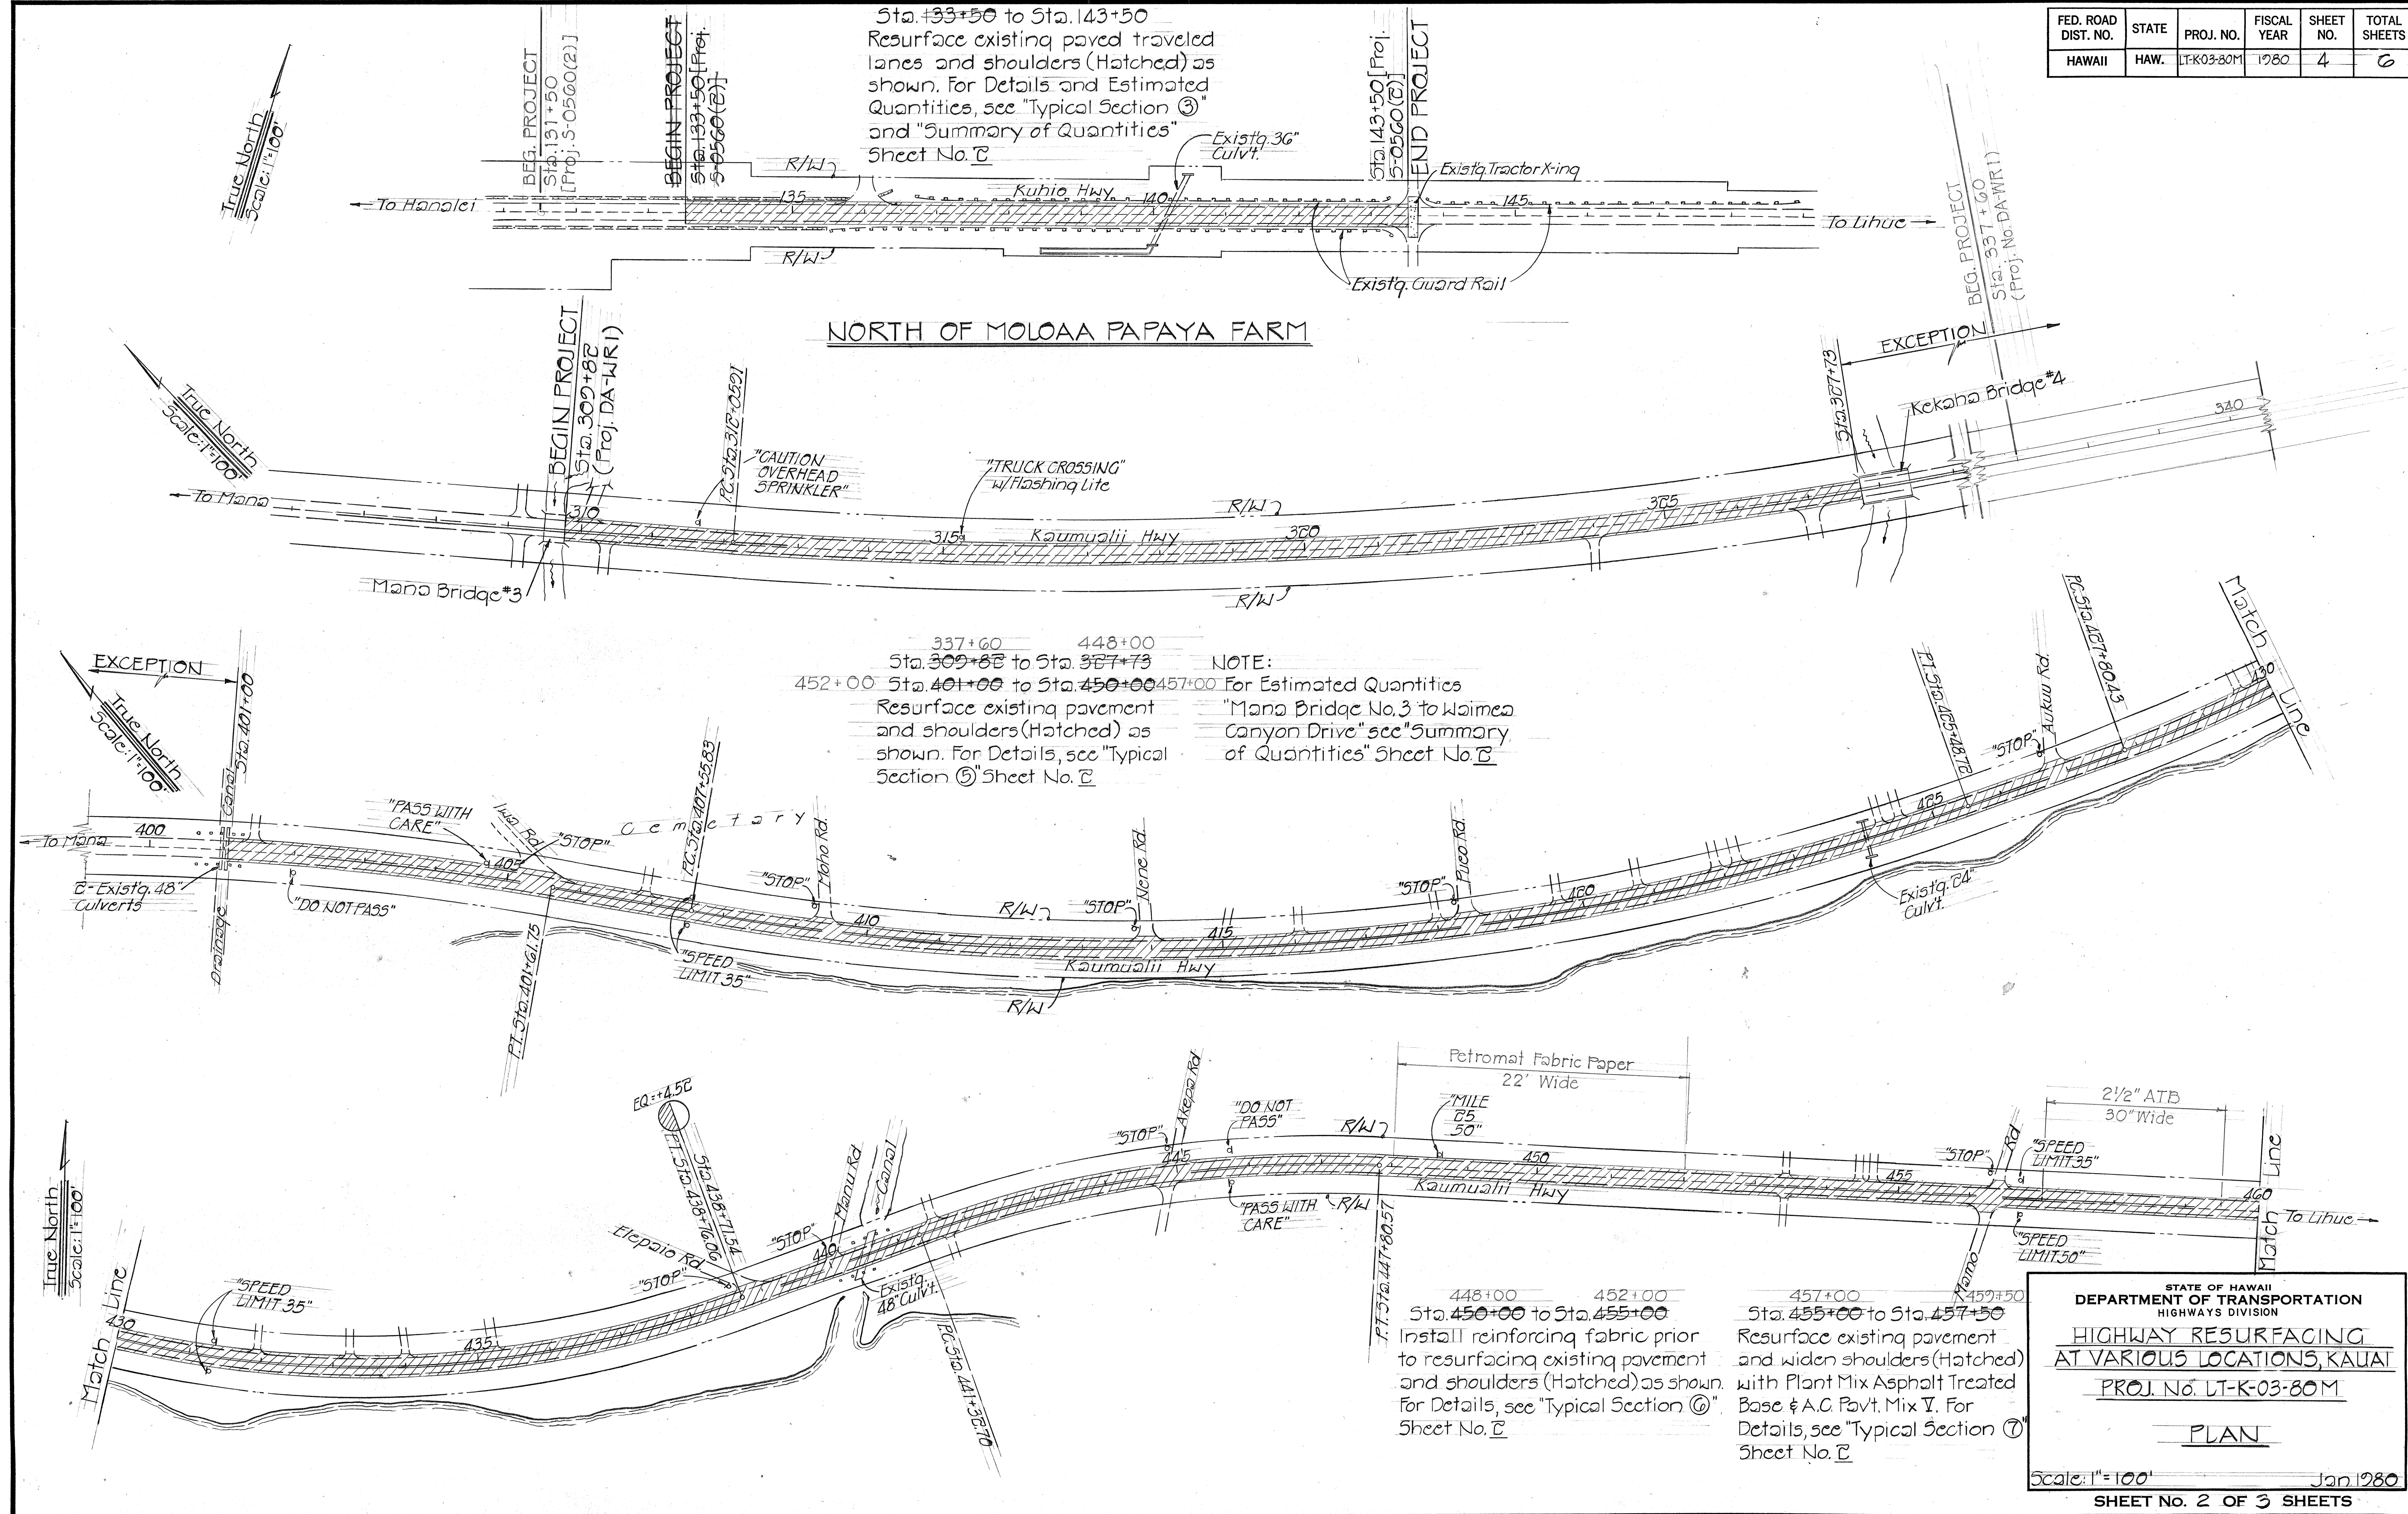

FED. ROAD DIST. NO.	STATE	PROJ. NO.	FISCAL YEAR	SHEET NO.	TOTAL SHEETS
HAWAII	HAW.	LT-K-03-80M	1980	5	6

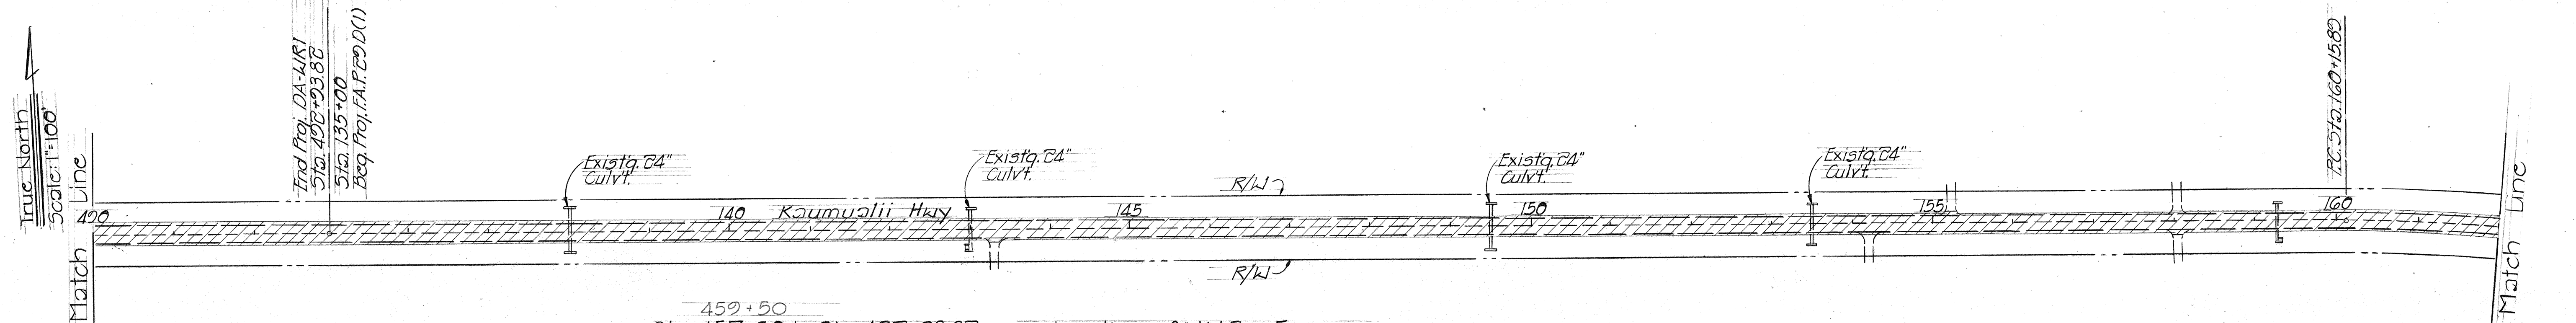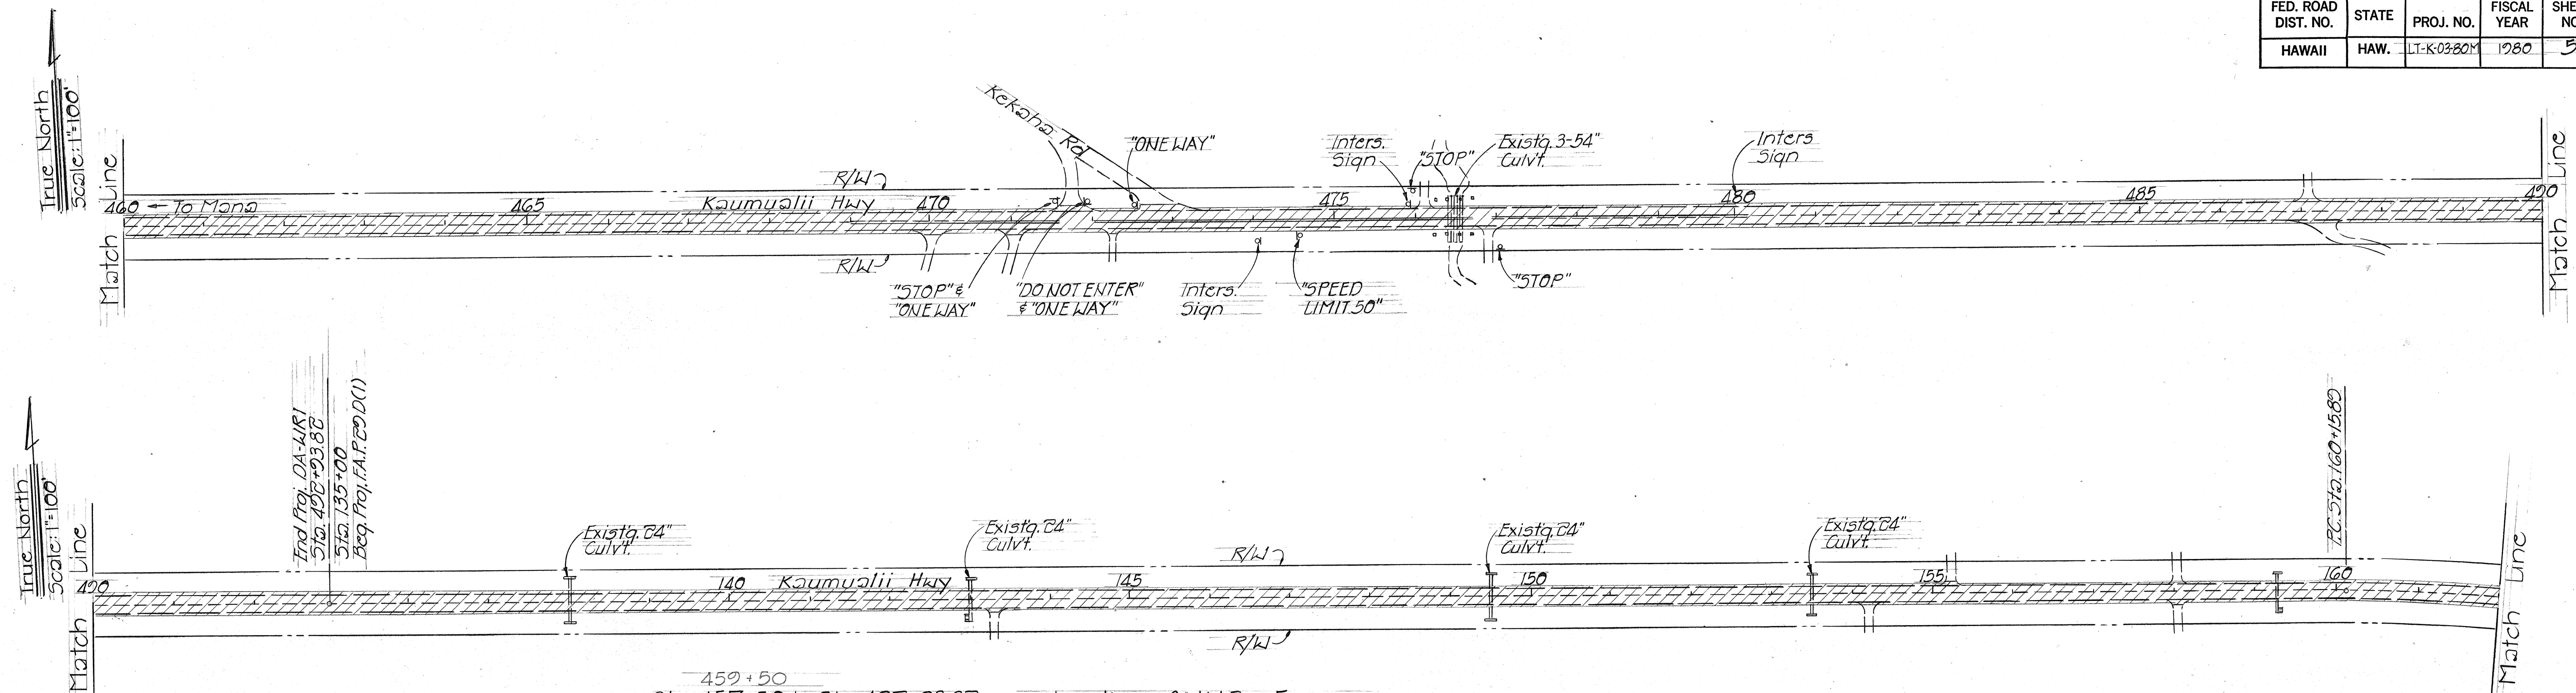

- | | |
|---|----------------------------|
| Sta. 457+50 to Sta. 490+33.82 | Location of W.V. Box Frame |
| Sta. 135+00 to Sta. 170+30.50 | & Cover to be adjusted. |
| Resurface existing pavement and shoulders (Hatched) | Sta. 178+20 Rt. 1 ea. |
| For Details, see "Typical Section ⑤" Sheet No. 2 | Sta. 179+70 Rt. 2 ea. |
| Adjust Water Valve Box | Sta. 182+10 Rt. 1 ea. |
| Frame & Cover to New Grade | Sta. 185+30 Rt. 1 ea. |
| | Sta. 188+50 Lt. 3 ea. |
| | Sta. 188+50 Rt. 1 ea. |

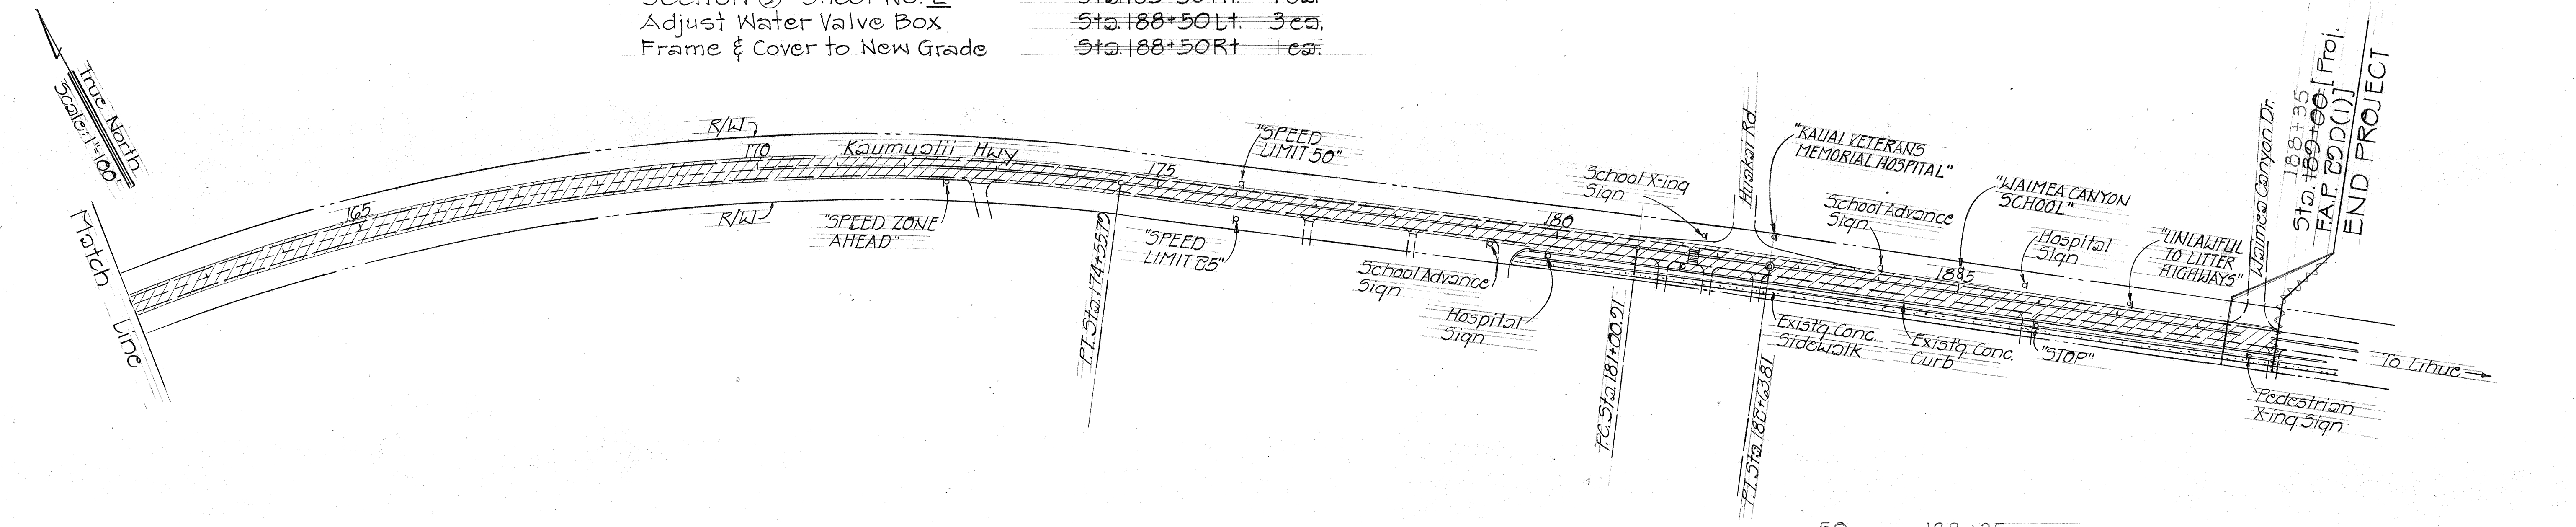

MANA BRIDGE NO. 3 TO WAIIMEA CANYON DRIVE

Sta. 179+30 to Sta. 189+00
Resurface existing pavement and shoulders (Hatched) as shown. For Details, see "Typical Section ④" Sheet No. 2

STATE OF HAWAII
DEPARTMENT OF TRANSPORTATION
HIGHWAYS DIVISION

HIGHWAY RESURFACING
AT VARIOUS LOCATIONS, KAUAI

PROJ. No. LT-K-03-80M

PLAN

Scale: 1"=100' Jan. 1980

SHEET No. 3 OF 3 SHEETS

ORIGINAL PLAN	DATE
SURVEY PLOTTED BY	
DRAWN BY	
DESIGNED BY	
NOTED BY	
CHECKED BY	
NO.	