

INDEX TO DRAWINGS	
SHEET NO.	DESCRIPTION
1	TITLE SHEET
2	TYPICAL SECTIONS & GENERAL NOTES
3-5	PLANS
6	STANDARD DETAILS





STATE OF HAWAII
DEPARTMENT OF TRANSPORTATION
HIGHWAYS DIVISION

"AS BUILT"
PLANS FOR
HIGHWAY RESURFACING AT VARIOUS
LOCATIONS, KAUAI

PROJECT NO. LT-K-03-80M

DISTRICTS OF WAIMEA, KAWAIHAU & HANAIEI
ISLAND OF KAUAI

FED. ROAD DIST. NO.	STATE	PROJ. NO.	FISCAL YEAR	SHEET NO.	TOTAL SHEETS
HAWAII	HAW.	LT-K-03-80M	1980	1	6

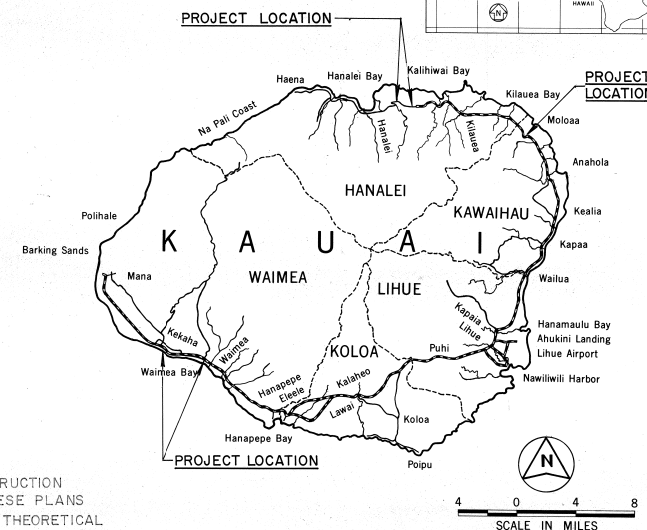
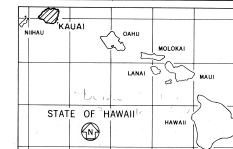


ALL CHANGES MADE DURING CONSTRUCTION
HAVE BEEN INCORPORATED ON THESE PLANS
EXCEPT CHANGES IN THE ORIGINAL THEORETICAL
QUANTITIES

depmas
PROJECT ENGINEER

1-22-81
DATE

FEDERAL AID PROJECTS PREVIOUSLY CONSTRUCTED
OR UNDER CONSTRUCTION

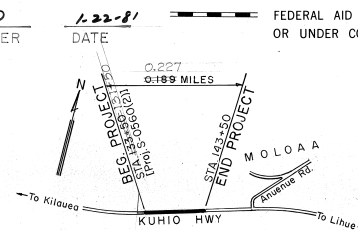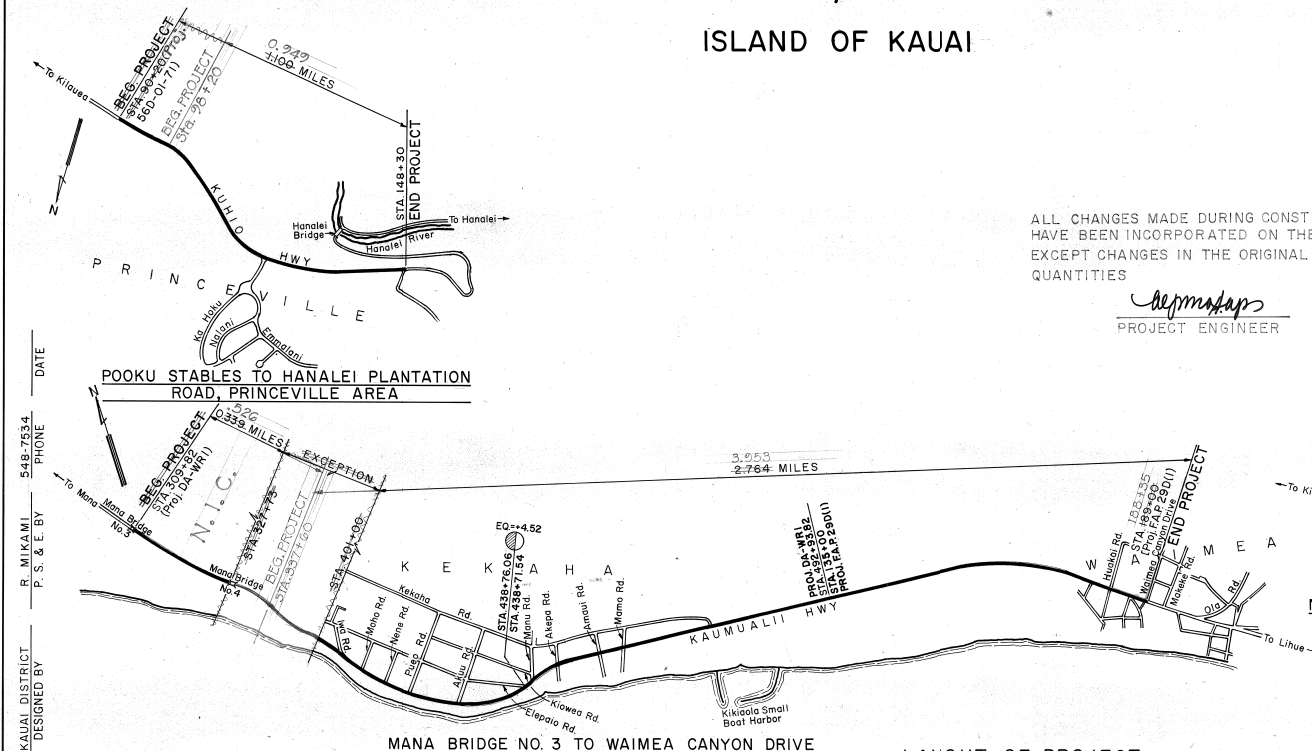

NORTH OF MO'LOAA PAPAYA FARM

MANA BRIDGE NO. 3 TO WAIMEA CANYON DRIVE

LAYOUT OF PROJECT
SCALE: 1" = 1000'

DEPARTMENT OF TRANSPORTATION
STATE OF HAWAII
APPROVED:
James R. Carras 4/1/80
DIR. OF TRANSPORTATION DATE

KAUAI DISTRICT
DESIGNED BY
R. MIKAMI
P. S. & E. BY
548-7534
PHONE
DATE