


STATE OF HAWAII
DEPARTMENT OF TRANSPORTATION
LAND TRANSPORTATION FACILITIES DIVISION

KAUAI BELT ROAD, SHOULDER
AND GUARD RAIL IMPROVEMENTS
AT HULEIA BRIDGE AND WAILUA
PROJ. NO. LT-K-02-79

GUARD RAIL CONNECTION AT
UHELEKAWAWA AND WAILUA BRIDGES


Scale: As Shown. Date: Nov, 1979

SHEET No. 1 OF 1 SHEETS

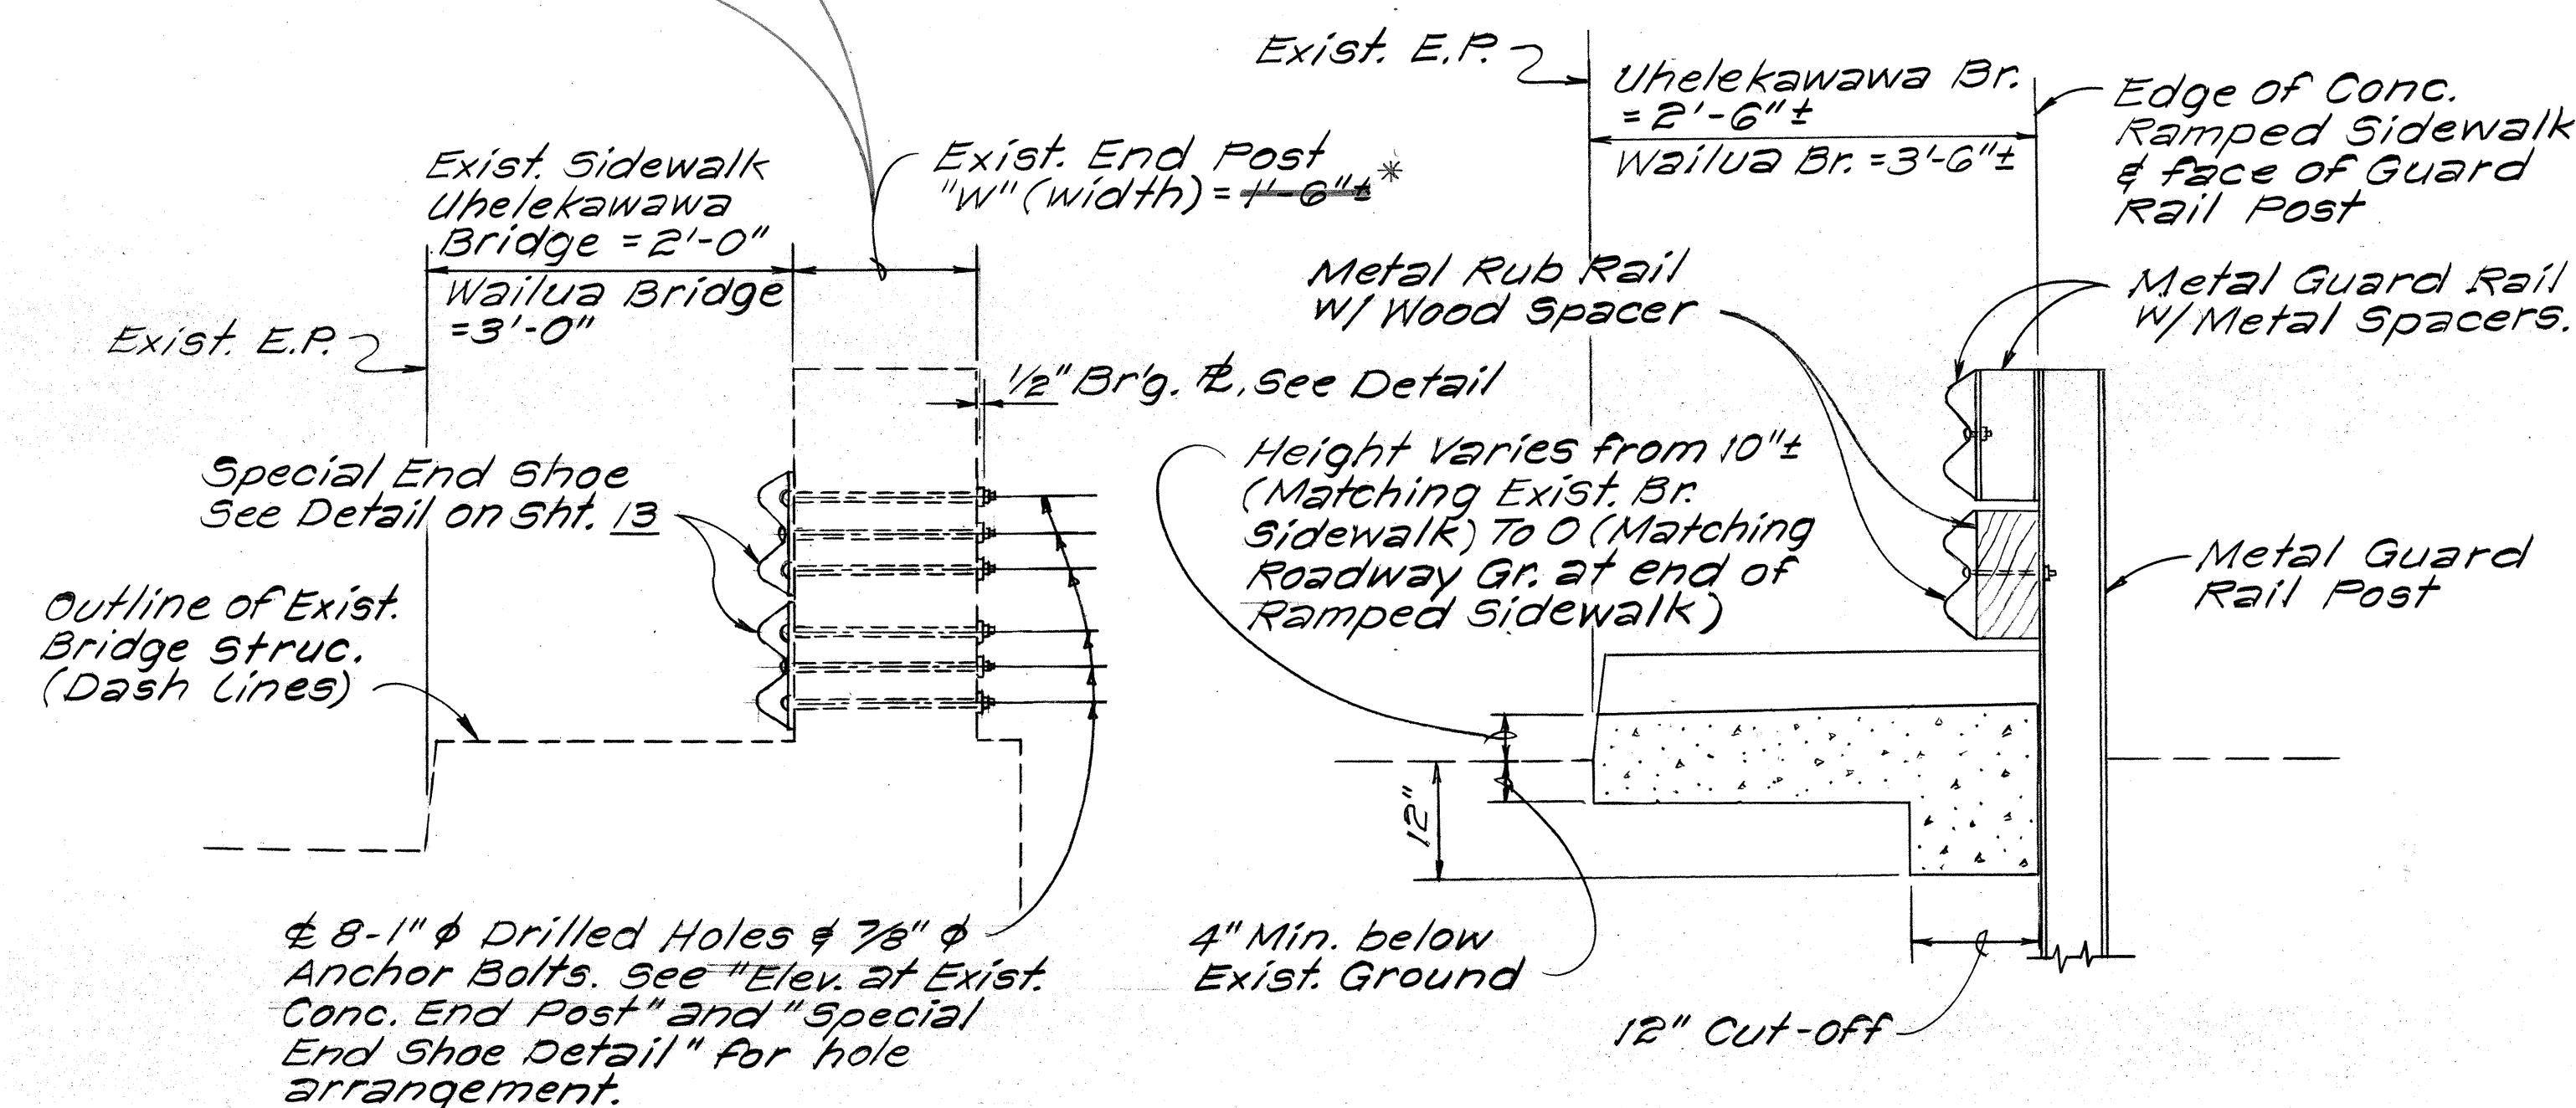


SECTION (A)
Scale: $\frac{3}{4}" = 1'-0"$

SECTION (E)
Scale: $\frac{3}{4}" = 1'-0"$

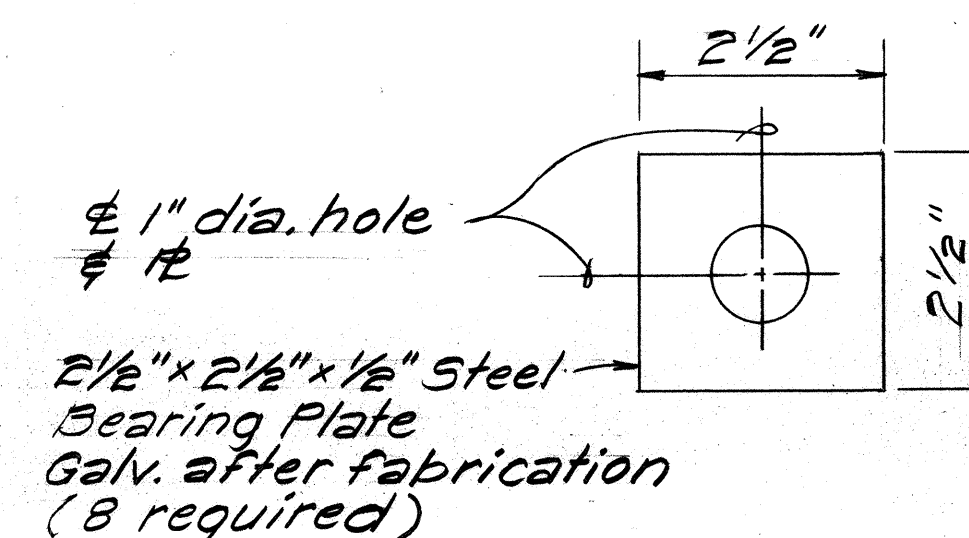

BEARING PLATE DETAIL
Scale $\frac{1}{2}" = 0'-1"$

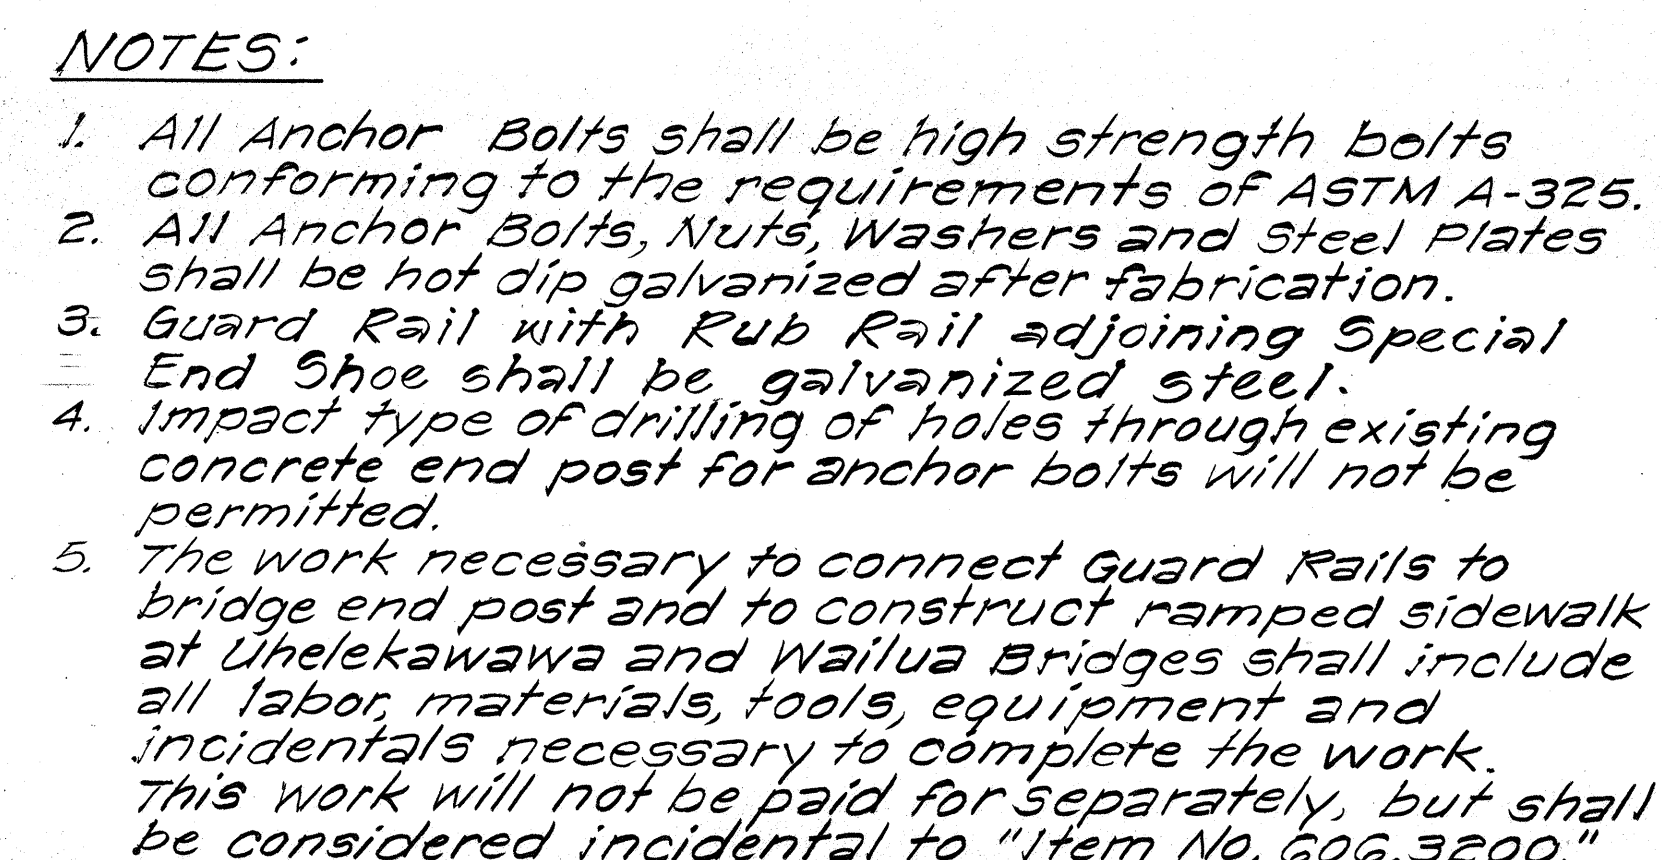

GUARD RAIL CONNECTION TO UHELEKAWAWA & WAILUA BRIDGES
Scale: 1/4" = 1'-0"