	INDEX TO DRAWINGS				
SHEET NO.	DESCRIPTION				
l l	TITLE SHEET				
2	TYPICAL SECTIONS				
3 – 5	PLANS & GENERAL NOTES				
	GUARD RAIL CONNECTION AT				
6	UHELEKAWAWA & WAILUA				
	BRIDGES				
7	TYPICAL DETAILS				
8-17	STANDARD DETAILS				

KAUAI DISTRICT DESIGNED BY



STATE



TRANSPORTATION DEPARTMENT OF HIGHWAYS DIVISION


"AS-BUILT"

KAUAI BELT ROAD-SHOULDER AND GUARD RAIL IMPROVEMENTS AT HULEIA BRIDGE AND WAILUA


PROJECT NO. LT-K-02-79


DISTRICTS OF LIHUE AND KAWAIHAU ISLAND OF KAUAI



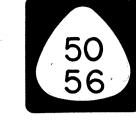

		UAI		,		
. 1	IIIHAU	<u> </u>	OAHU	MOLOKAI		
		· · · · · · · · · · · · · · · · · · ·	LANAI	50~		_
			ZANAI	الماله ا	MAUI	
	STAT	E OF H	AWAII	(,
				HAWAII		

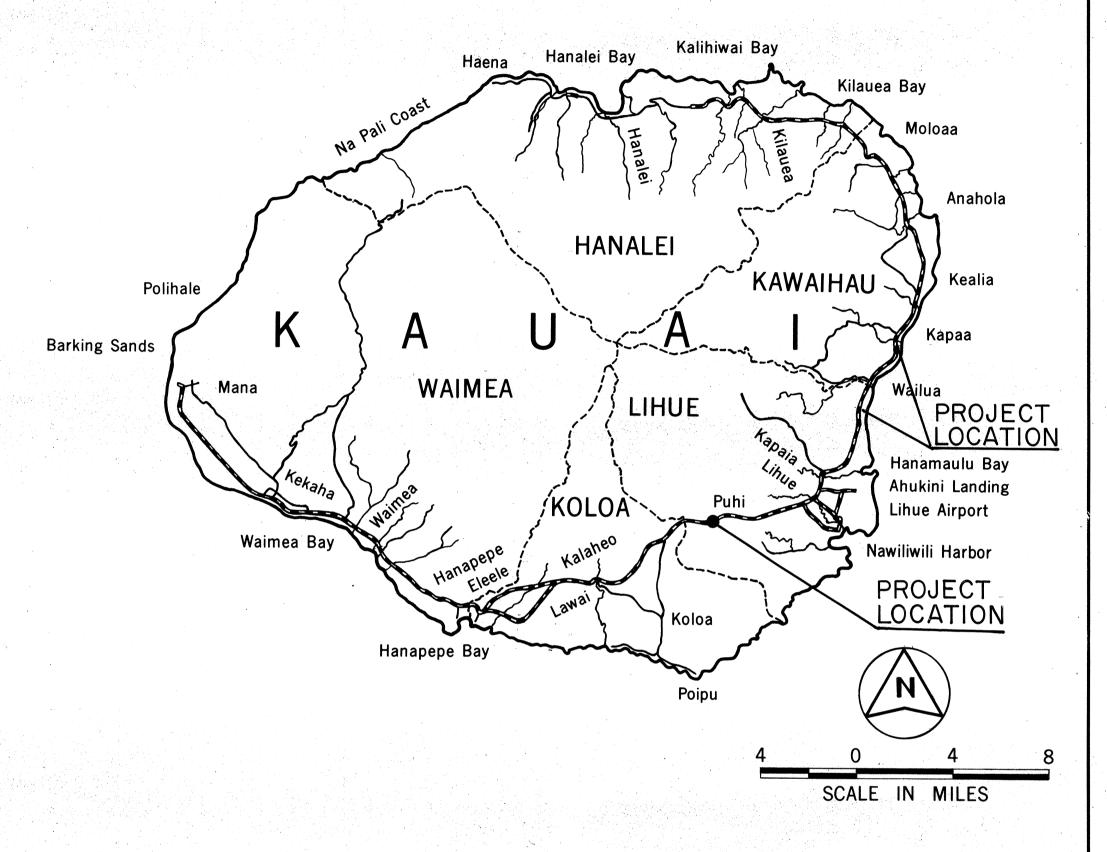

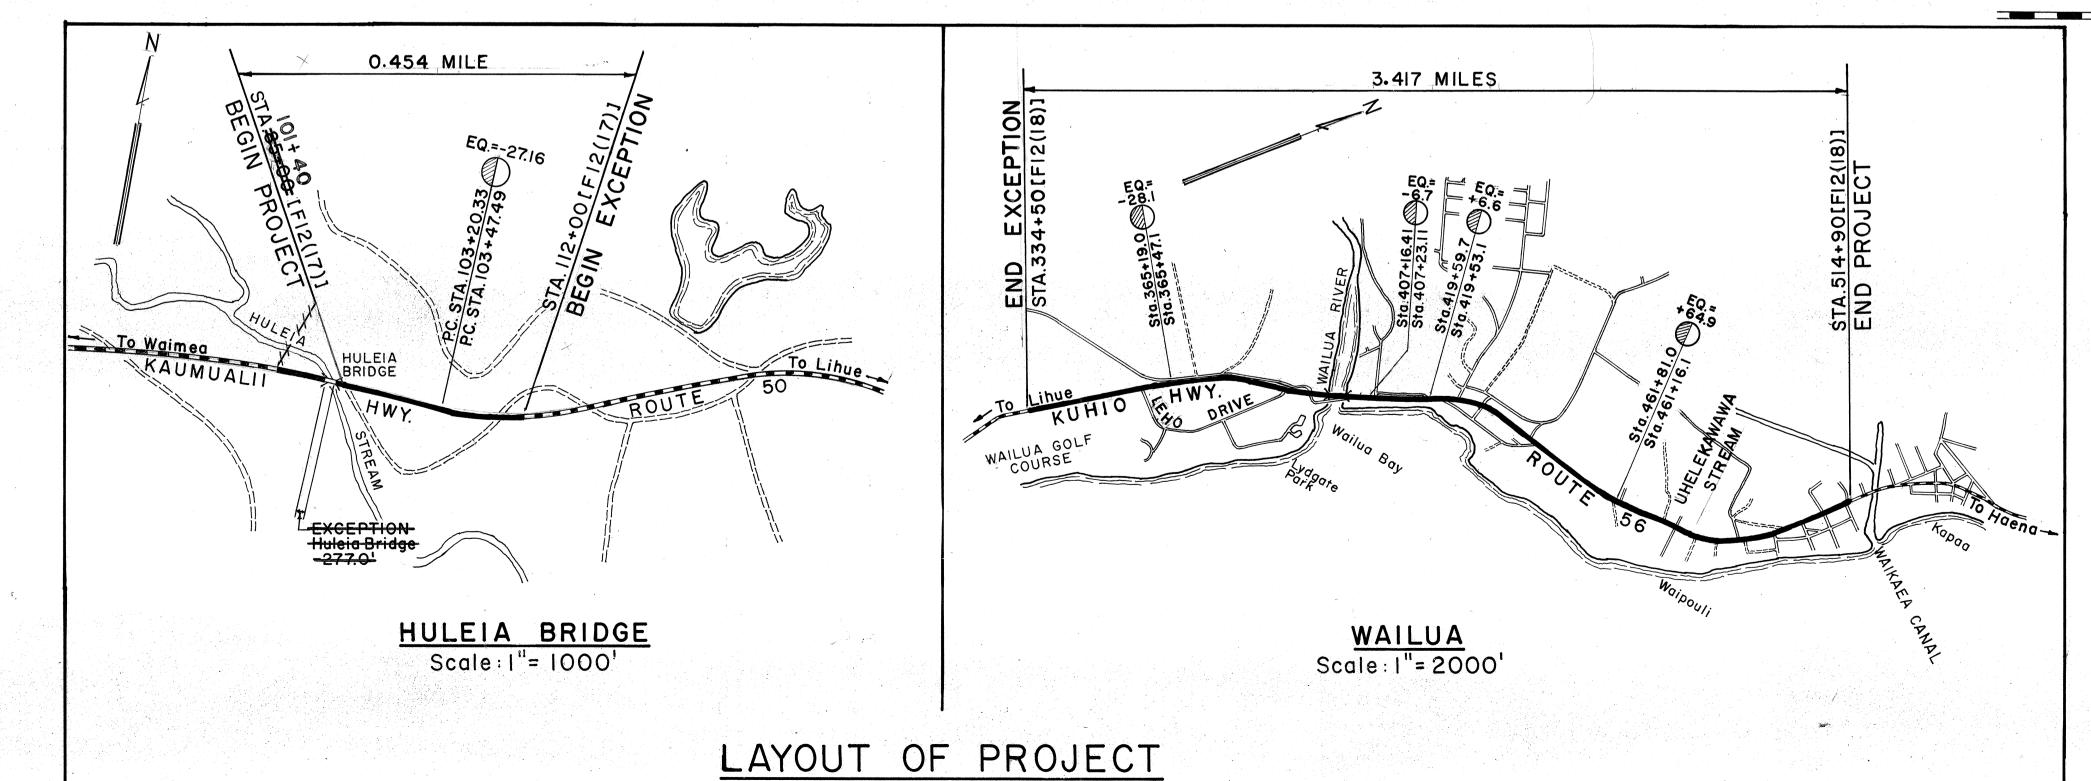

FEDERAL AID PROJECTS PREVIOUSLY CONSTRUCTED OR UNDER CONSTRUCTION

ALL CHANGES MADE DURING CONSTRUCTION HAVE BEEN INCORPORATED ON THESE PLANS IN RED EXCEPT CHANGES IN THE ORIGINAL THEORETICAL QUANTITIES. FOR ACTUAL QUANTITIES, REFER TO PROJECT LEDGER AND/OR COMPUTATION BOOK.

4-12-82

DEPARTMENT OF TRANSPORTATION STATE OF HAWAII APPROVED: