




FED. ROAD DIST. NO.	STATE	PROJ. NO.	FISCAL YEAR	SHEET NO.	TOTAL SHEETS
HAWAII	HAW.	LT-K-02-79	1980	2	17

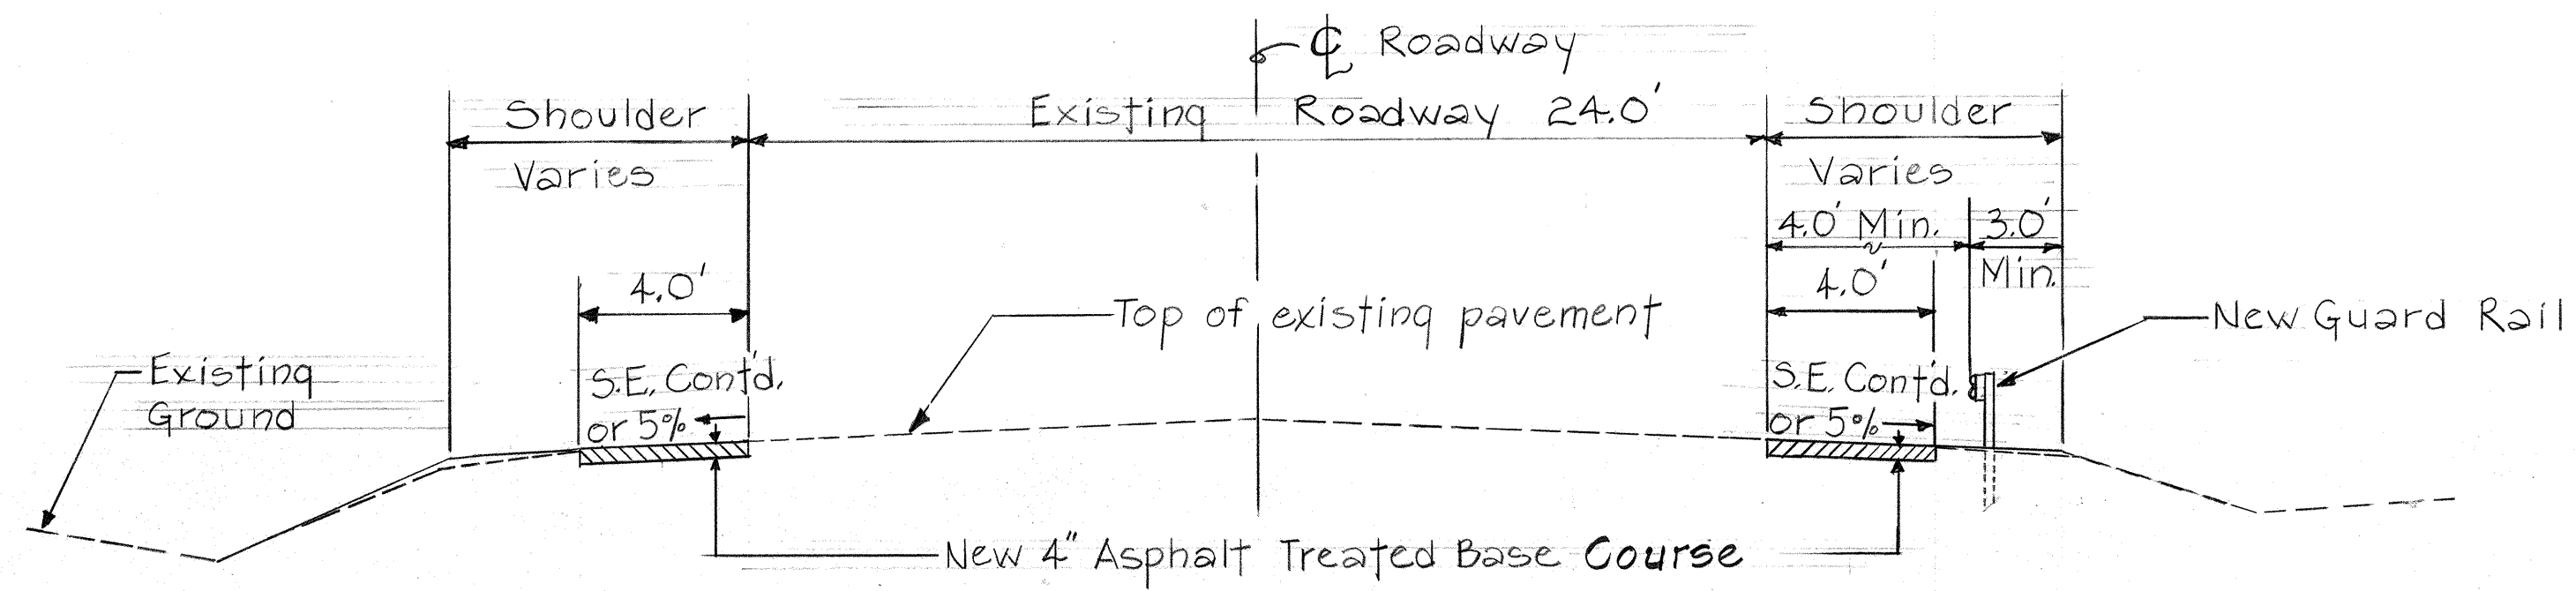

TYPICAL SECTION
Scale: 1/4" = 1'-0"
(WAILUA TO WAIKAEA BRIDGE)

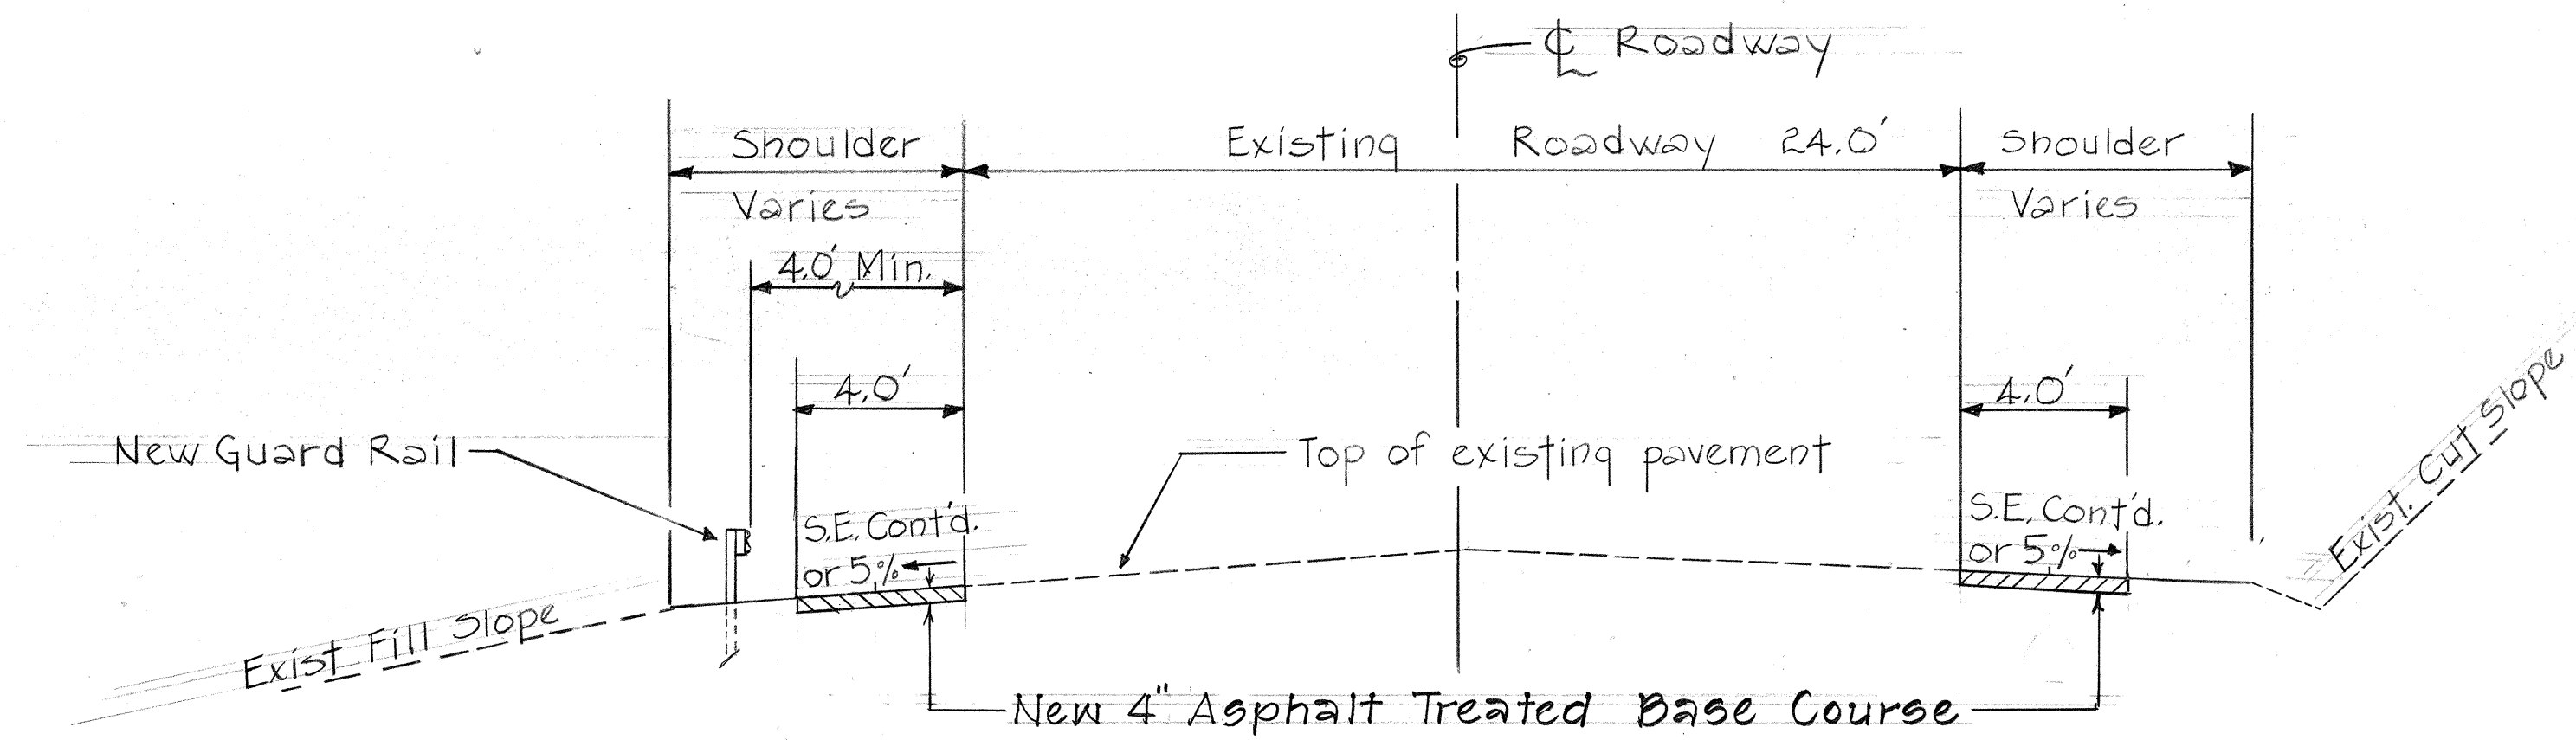

TYPICAL SECTION
Scale: 1/4" = 1'-0"
(HULEIA BRIDGE SECTION)

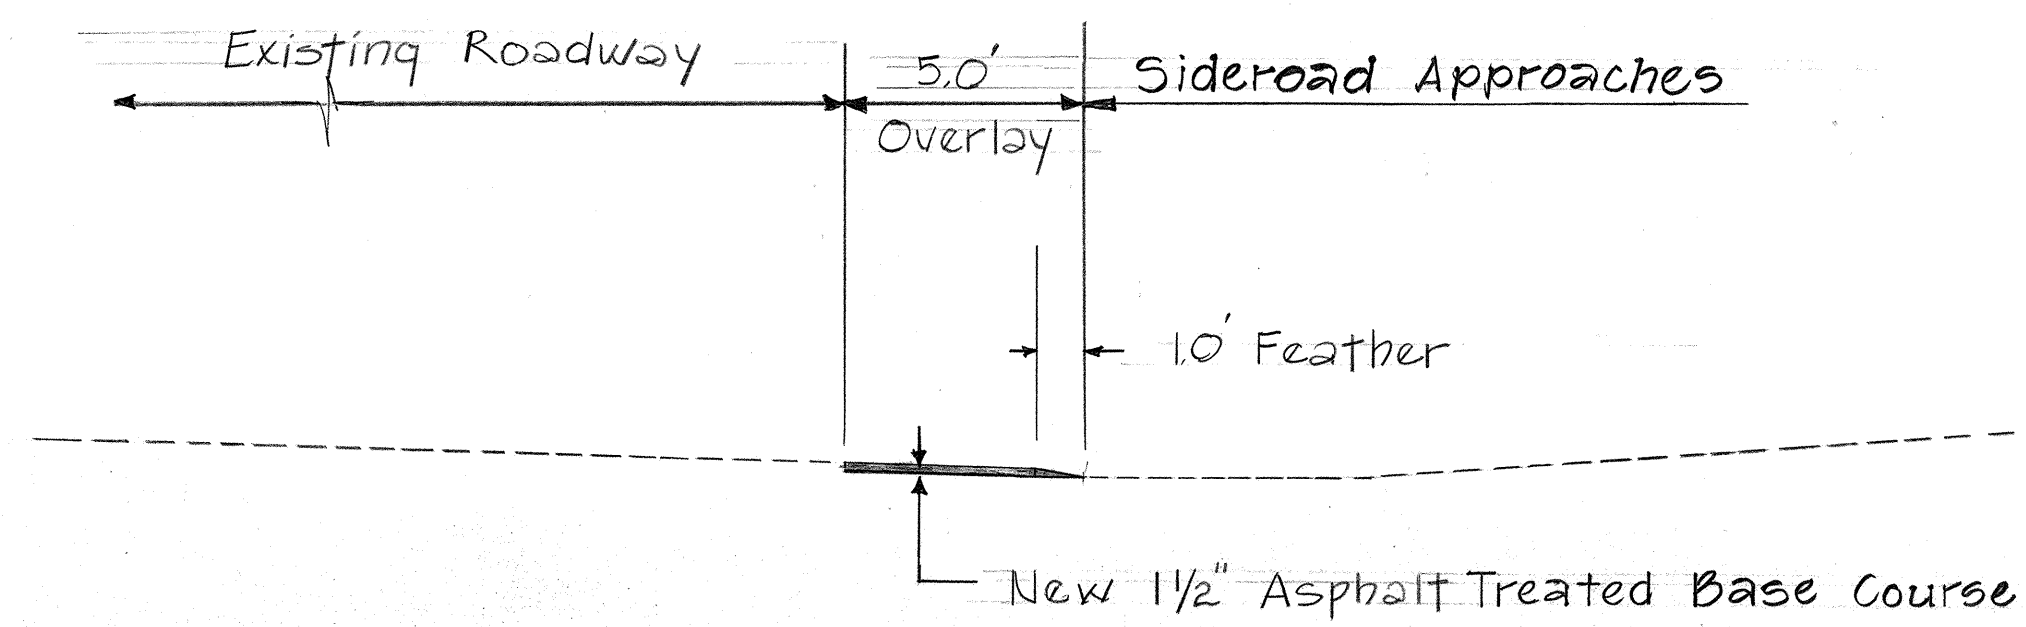

TYPICAL SECTION @ RESURFACING
Scale: 1/4" = 1'-0"

STATE OF HAWAII
DEPARTMENT OF TRANSPORTATION
LAND TRANSPORTATION FACILITIES DIVISION

KAUAL BELT ROAD, SHOULDER AND
GUARD RAIL IMPROVEMENTS AT HULEIA
BRIDGE AND WAILUA.

PROJ. NO. LT-K-02-79

TYPICAL SECTIONS

Scale: As shown August 1979

SHEET No. / OF / SHEET