


NOTES:







	EXIST. RIGHT OF WAY
	REMOVE EXIST. STRIPING OR CURB
	NEW A.C. PAVEMENT
	NEW TRAFFIC SIGNAL STANDARD

SCALE: AS SHOWN DATE: 4-30-80
SHEET No. | OF | SHEETS

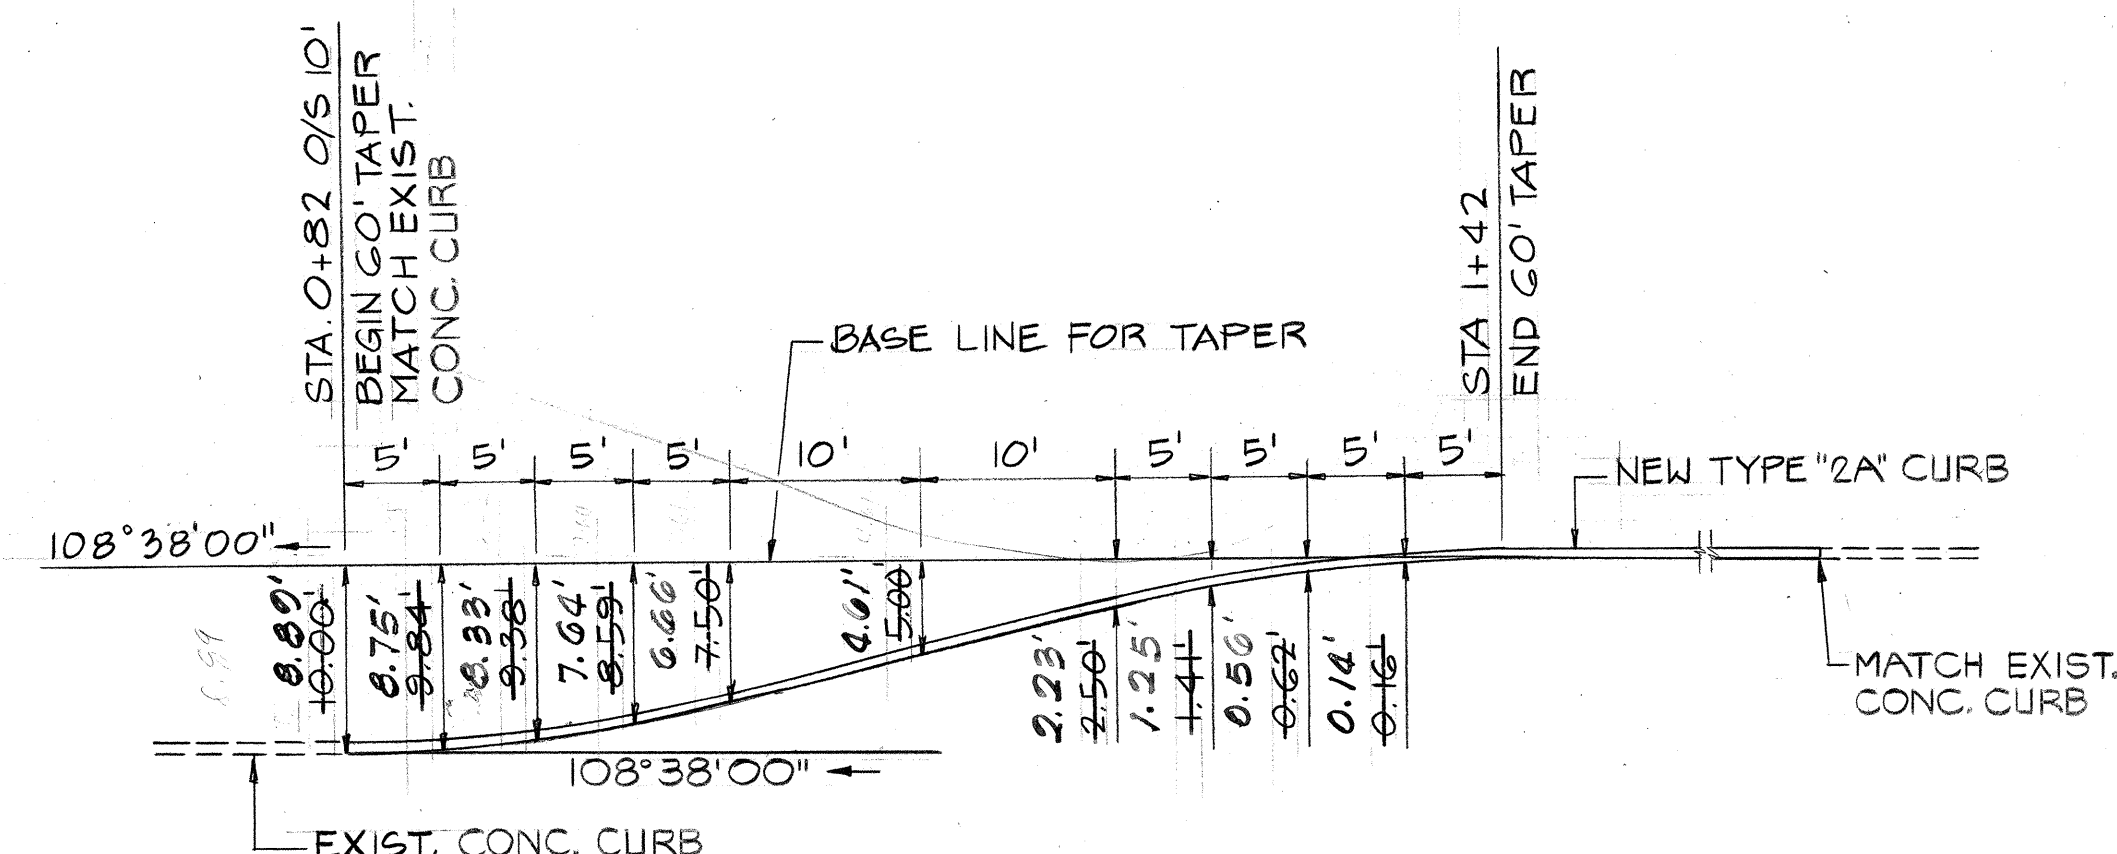

TYPICAL SECTION
NOT TO SCALE
STA. 1+42 TO STA. 2+95

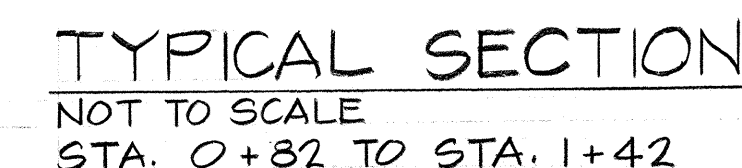

THIS WORK WAS PREPARED BY M
OR UNDER MY SUPERVISION
Therodore A. Kawahigao
Signature

□