	INDEX TO DRAWINGS
SHEET NO.	DESCRIPTION
	TITLE SHEET
2	PLANS, TYPICAL SECTIONS AND
	GENERAL NOTES
3	PLANS
4	PLANS AND GUARD RAIL &
	DELINEATOR SCHEDULE
5	DETAILS - RUB RAILS
6	DETAILS - GUARD RAILS, C.D.I.,
	FRAME & GRATING
7, 1	DETAILS - UNDERDRAIN
8-14	STANDARD DETAILS

548-7490 PHONE

NISHIMURA P. S. & E. BY

HWY-K DESIGNED BY



STATE OF HAWAII

DEPARTMENT OF TRANSPORTATION HIGHWAYS DIVISION

"AS - BUILT"
PLANS FOR

GUARD RAIL AND SHOULDER IMPROVEMENTS AT OMAO BRIDGE TO HULEIA BRIDGE AND HANAMAULU


PROJECT NO. HWY-K-03-82


DISTRICTS OF LIHUE & KOLOA
ISLAND OF KAUAI



FED. ROAD DIST. NO. STATE PROJ. NO. FISCAL SHEET TOTAL SHEETS

HAWAII HAW. HWY-K-03-82 1982 1 14

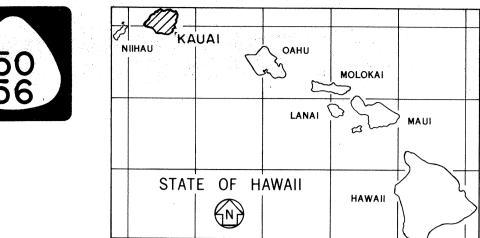

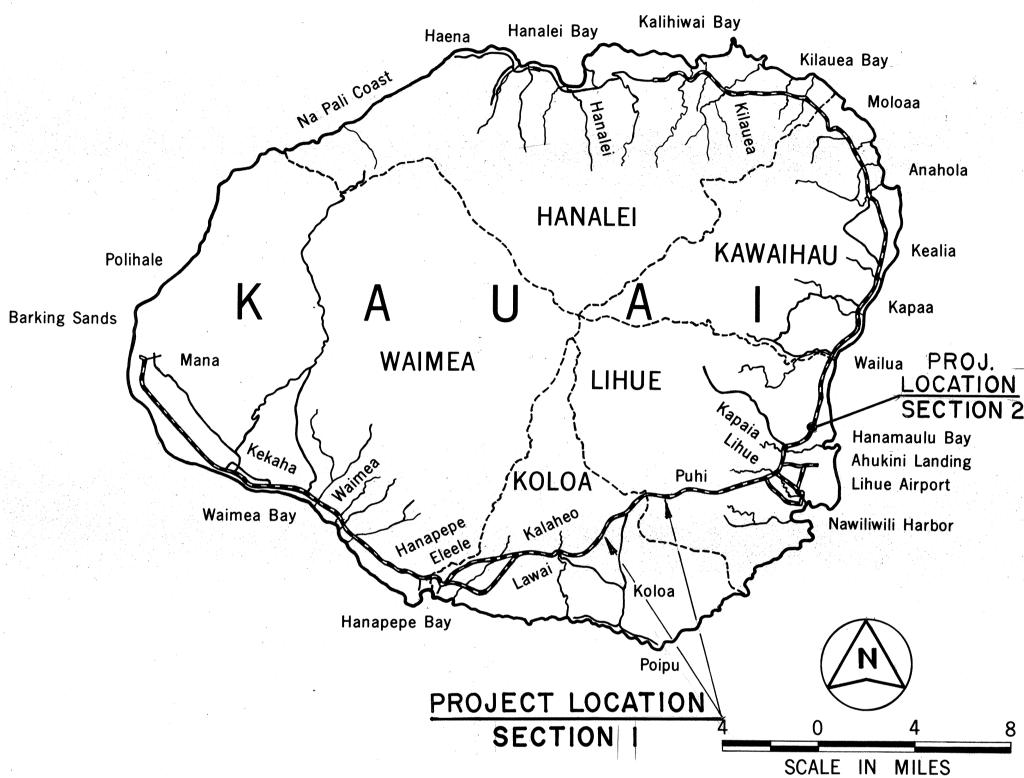

FEDERAL AID PROJECTS PREVIOUSLY CONSTRUCTED OR UNDER CONSTRUCTION

SCOPE OF WORK

Roadway Excavation, Salvaging Existing Guide Posts and Guard Rail and Posts, Installing New Guard Rail and Posts, Adjustments to Existing Drainage System, Stabilize Shoulders, and Pavement Striping.

ALL CHANGES MADE DURING CONSTRUCTION HAVE BEEN INCORPORATED ON THESE PLANS IN RED EXCEPT CHANGES IN THE ORIGINAL THEORETICAL QUANTITIES. FOR ACTUAL QUANTITIES, REFER TO PROJECT LEDGER AND/OR COMPUTATION BOOK.

RESIDENT ENGINEER

5-23-83 DATE

DEPARTMENT OF TRANSPORTATION

STATE OF HAWAII

APPROVED:

Compared Representation APPROVED

APPROVED:

APPR

