t :	INDEX TO DRAWINGS
SHEET NO.	DESCRIPTION
~ 1 · ·	TITLE SHEET
2	TYPICAL BRIDGE APPROACH
•	DELINEATION CRITERIA
3	SUMMARY OF DELINEATION
	& PAVEMENT MARKING
4-6	STANDARD DETAILS
ŧ	
·	




STATE OF HAWAII

TRANSPORTATION OF DEPARTMENT HIGHWAYS DIVISION "AS-BUILT" PLANS FOR

PAVEMENT MARKINGS AT VARIOUS BRIDGES, KAUAI

PROJECT NO. HWY-K-03-81 ISLAND OF KAUAI

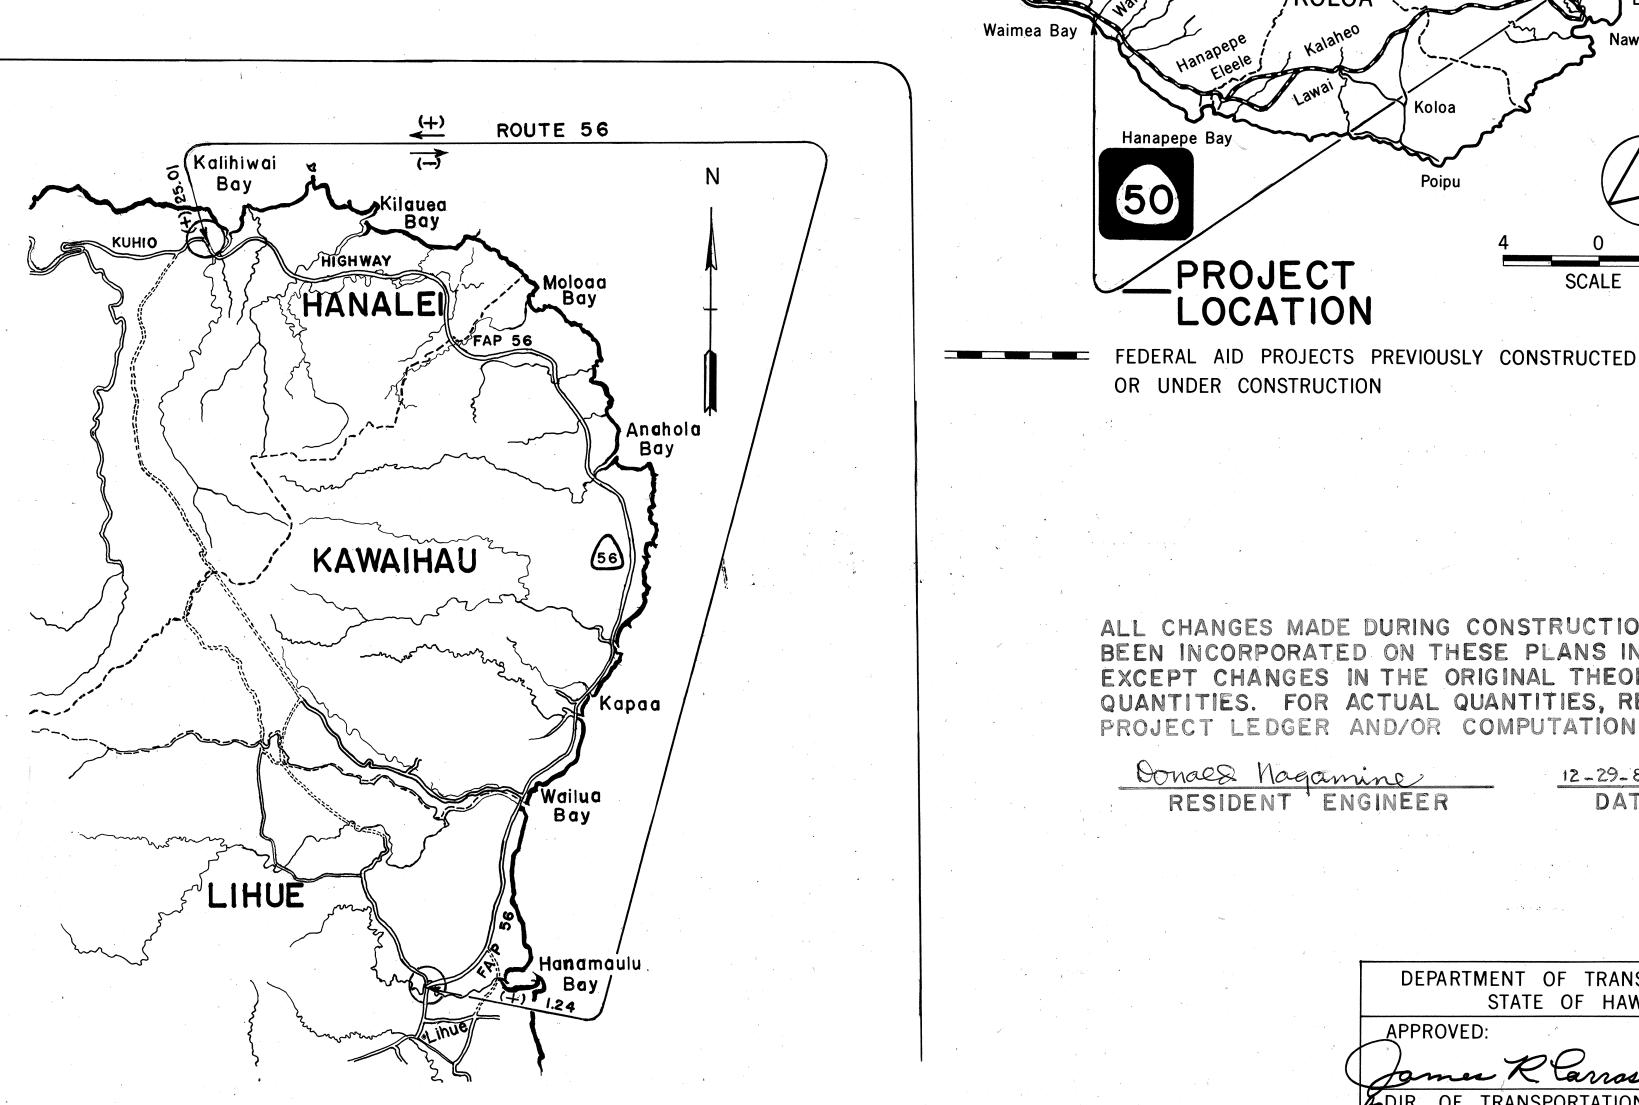

FED. ROAD DIST. NO. FISCAL SHEET YEAR NO. PROJ. NO. HWY.-K-03-81 1982

STATE OF HAWAII **PROJECT**

LOCATION HANALEI KAWAIHAU 📈 WAIMEA LIHUE PROJECT SCALE IN MILES LOCATION

> ALL CHANGES MADE DURING CONSTRUCTION HAVE BEEN INCORPORATED ON THESE PLANS IN RED EXCEPT CHANGES IN THE ORIGINAL THEORETICAL QUANTITIES. FOR ACTUAL QUANTITIES, REFER TO PROJECT LEDGER AND/OR COMPUTATION BOOK.

Oonaed Magamine RESIDENT ENGINEER


OR UNDER CONSTRUCTION

12-29-82 DATE

12-4-5-3

DEPARTMENT OF TRANSPORTATION STATE OF HAWAII APPROVED:

OF TRANSPORTATION

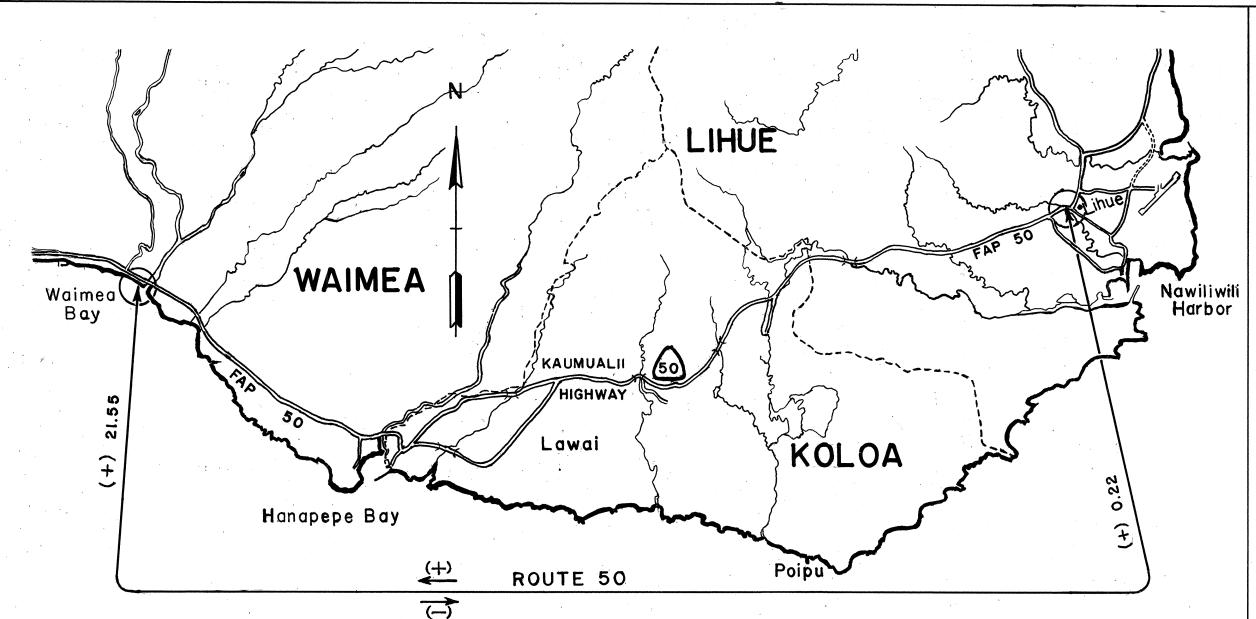

LAYOUT PLANS LENGTH OF PROJECT -----45 MILES

NOTE: (+) INCREASING LOG MILES (-) DECREASING LOG MILES

May, 1982 DATE 548-2456 PHONE TSUZUKI P. S. & E. BY K AUAI DISTRICT DESIGNED BY