	INDEX TO DRAWINGS		
SHEET NO.	TITLE SHEET STANDARD PLAN SUMMARY GENERAL NOTES, TYPICAL SECTIONS AND PROFILE		
1			
2			
3			
4-6	PLAN		
1			


STATE OF HAWAII

DEPARTMENT OF TRANSPORTATION HIGHWAYS DIVISION "AS-BUILT" PLANS FOR

GUARDRAIL AND SHOULDER IMPROVEMENTS AT VARIOUS LOCATIONS, KAUAI PROJECT NO. HWY-K-01-87

DISTRICTS OF KOLOA AND LIHUE ISLAND OF KAUAI


SCALE : 1"= 1000.0"

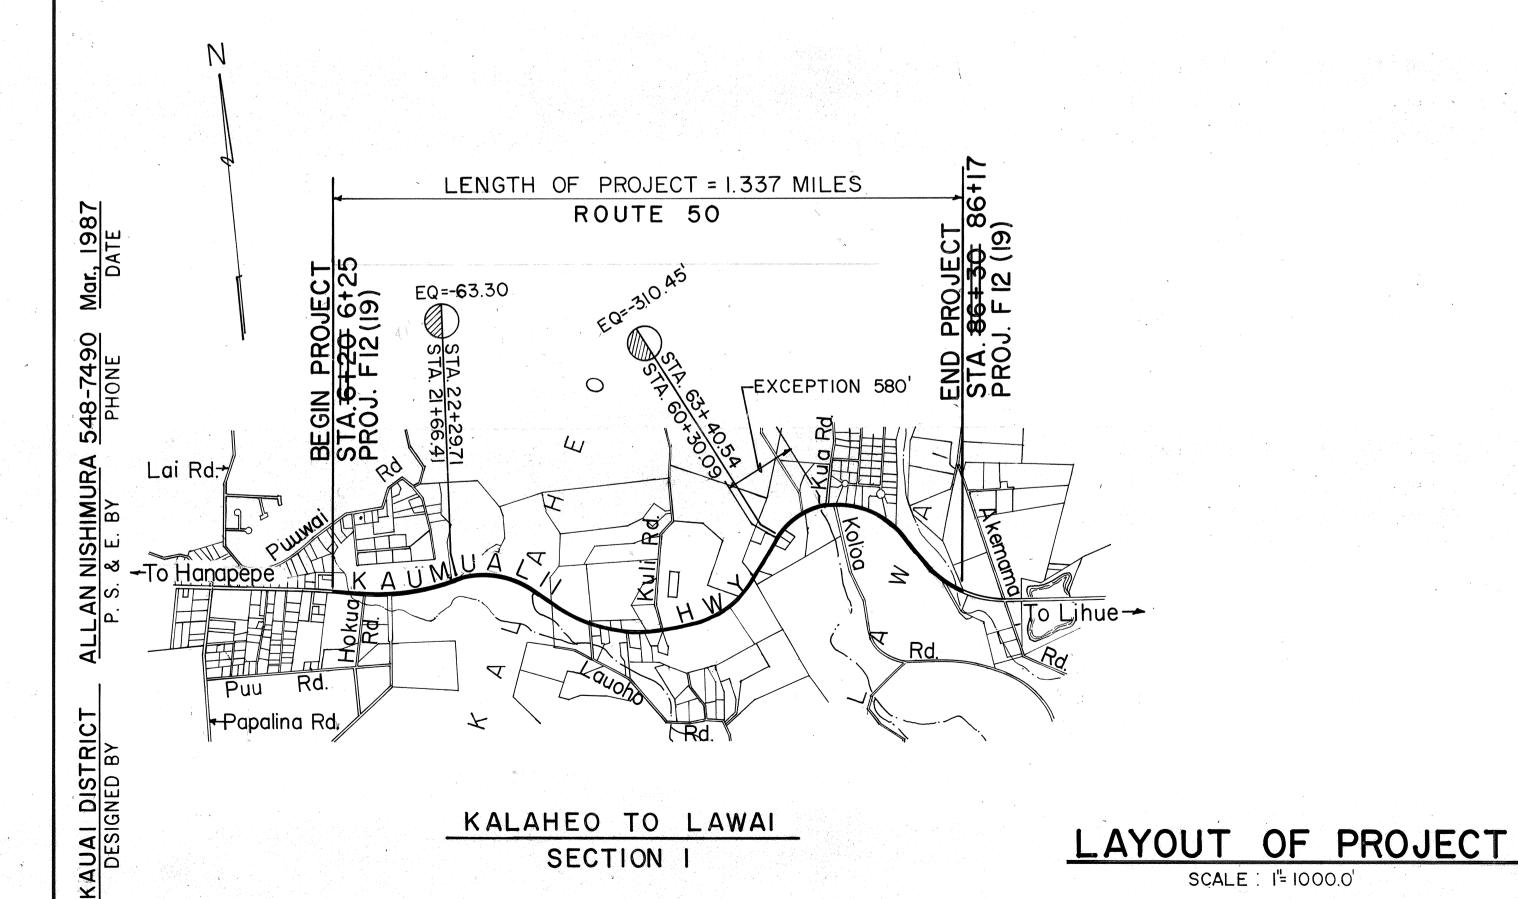



IGTH OF PROJECT= 0.574 MILE ROUTE 58

> NAWILIWILI ROAD SECTION 2

FISCAL SHEET YEAR NO. SHEETS PROJ. NO. HWY-K-01-87

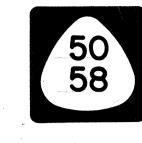

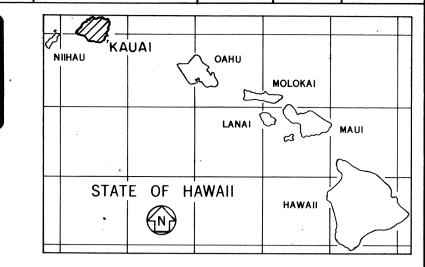

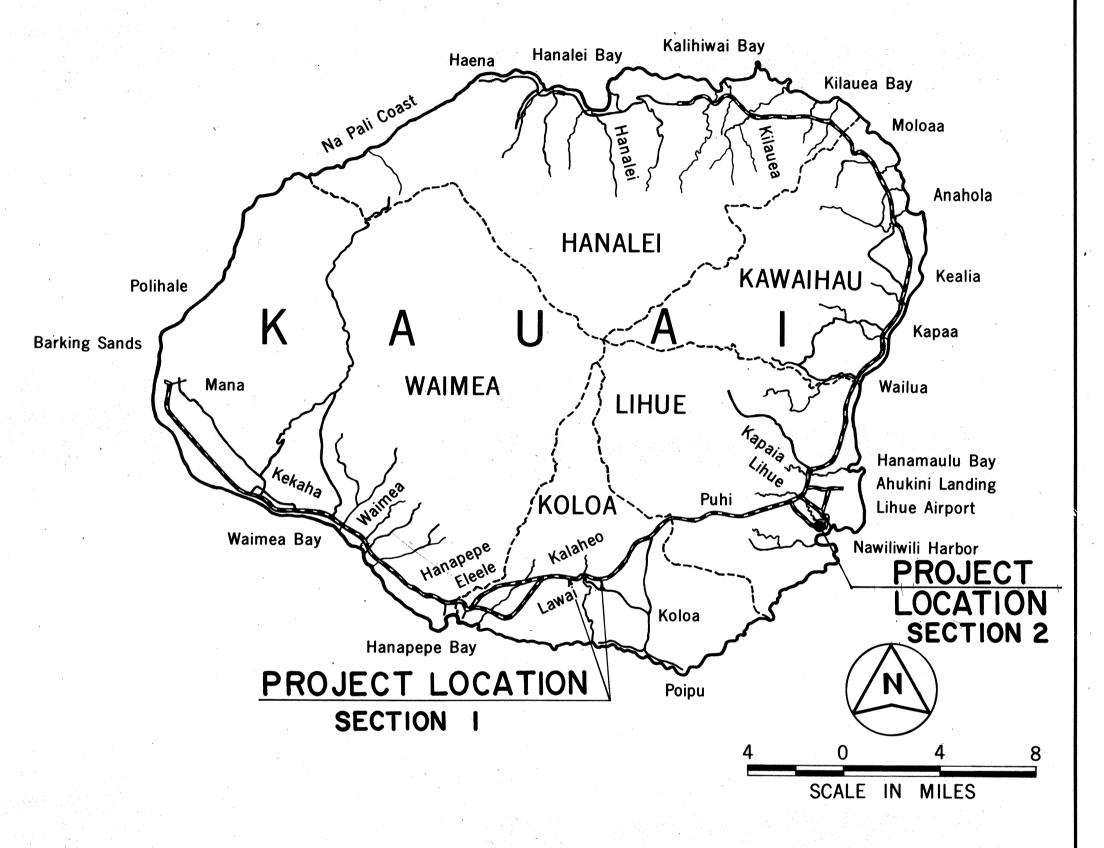

CHANGES MADE DURING CONSTRUCTION HAVE BEEN INCORPORATED ON THESE PLANS EXCEPT CHANGES IN THE ORIGINAL THEORETICAL QUANTITIES. FOR ACTUAL QUANTITIES, REFER TO PROJECT LEDGER AND/OR COMPUTATION BOOK.

FEDERAL AID PROJECTS PREVIOUSLY CONSTRUCTED

DATE

OR UNDER CONSTRUCTION

	DEPARTMENT OF TRANSPORTATION STATE OF HAWAII		
	APPROVED:	c in the second second	
	Attaran	2/20/87	
to	CDIR. OF TRANSPORTA	TION DATE	