


FED. ROAD DIST. NO.	STATE	PROJ. NO.	FISCAL YEAR	SHEET NO.	TOTAL SHEETS
HAWAII	HAW.	541A-01-89M	1989	5	5


ESTIMATED QUANTITIES: STA. (-)3+50 TO 16+05

Reinforcing Fabric.	7,549 s.y.
SS-1 Tack Coat	1190.36 1,594 gal.
A.C. Pavement Marshall Mix.	1,272 tons
Striping (Paint):	Yellow, 19 # gal.
	White, 18 # gal.
Pavement Arrows (Tape).	7 ea.
Stop Bar (tape).	105.3 #
Warning Signs w/ Post.	3 ea.
Adjust sewer manhole frame & cover.	4 ea.
Pavement Markers:	Type A144 #2 ea.
	Type CL 72 # ea.
	Type DL 61 # ea.
	Type HL 84 ea.


Adjust Manhole Frames and Covers to new finish grade at the following locations:
sta. (-)3+40 (Lt.) SMH
sta. (-)3+00 (Lt.) SMH
sta. (-)1+70 (Lt. & Rt.) SMH

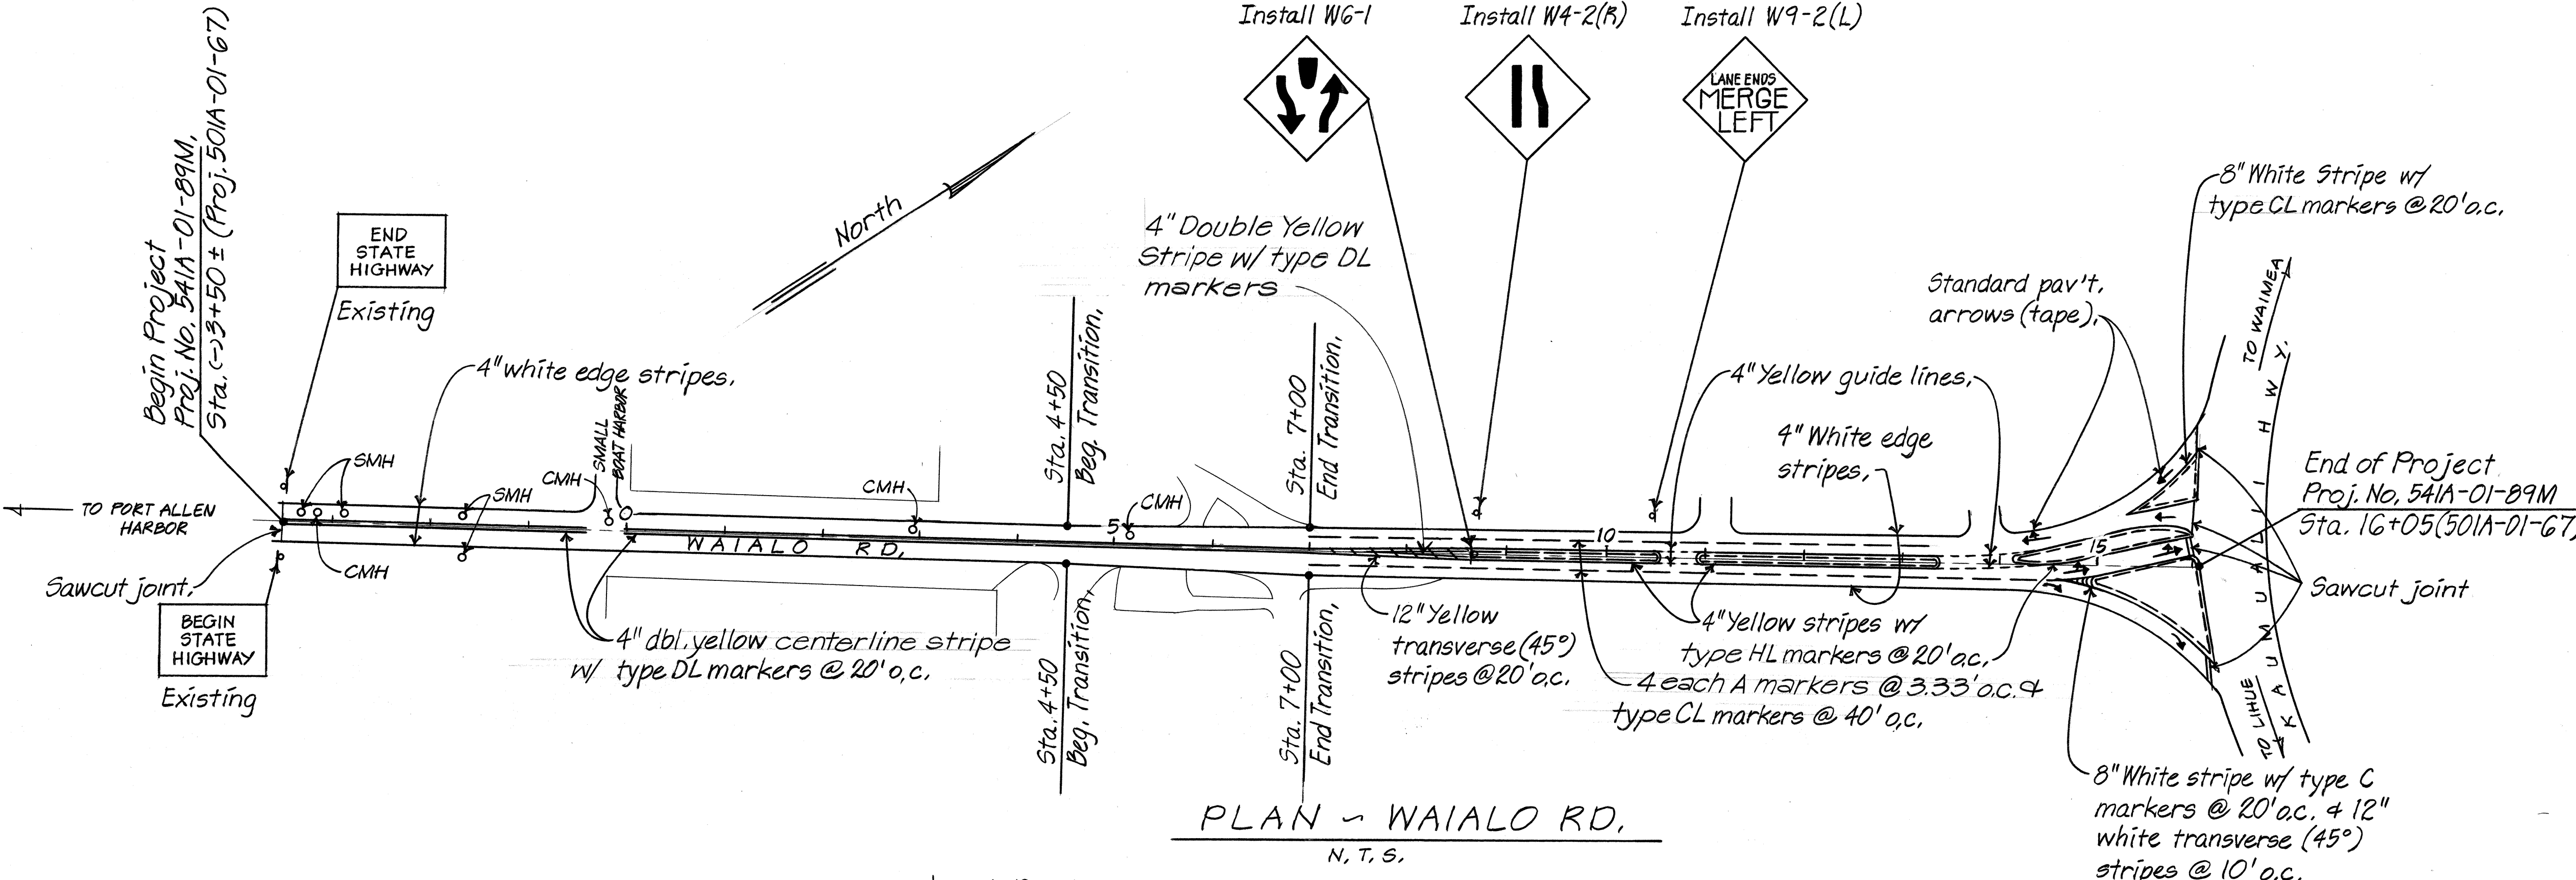


PLAN - WAIALO RD.

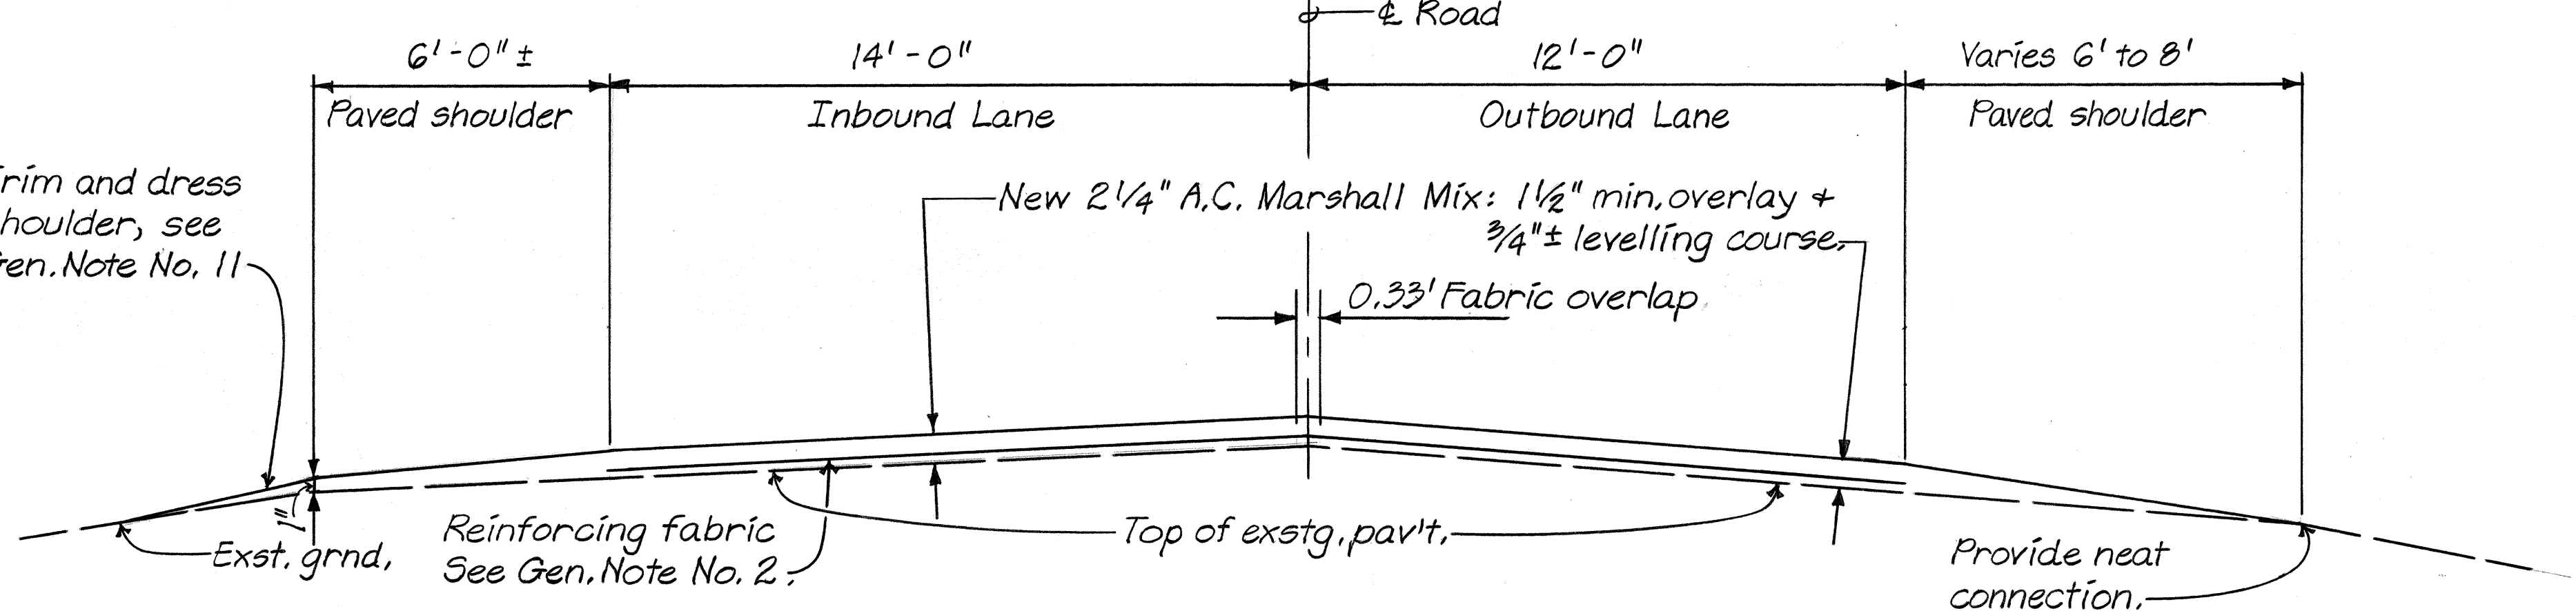

TYP. ROADWAY SECTION - STA. (-)3+50 TO STA. 4+50

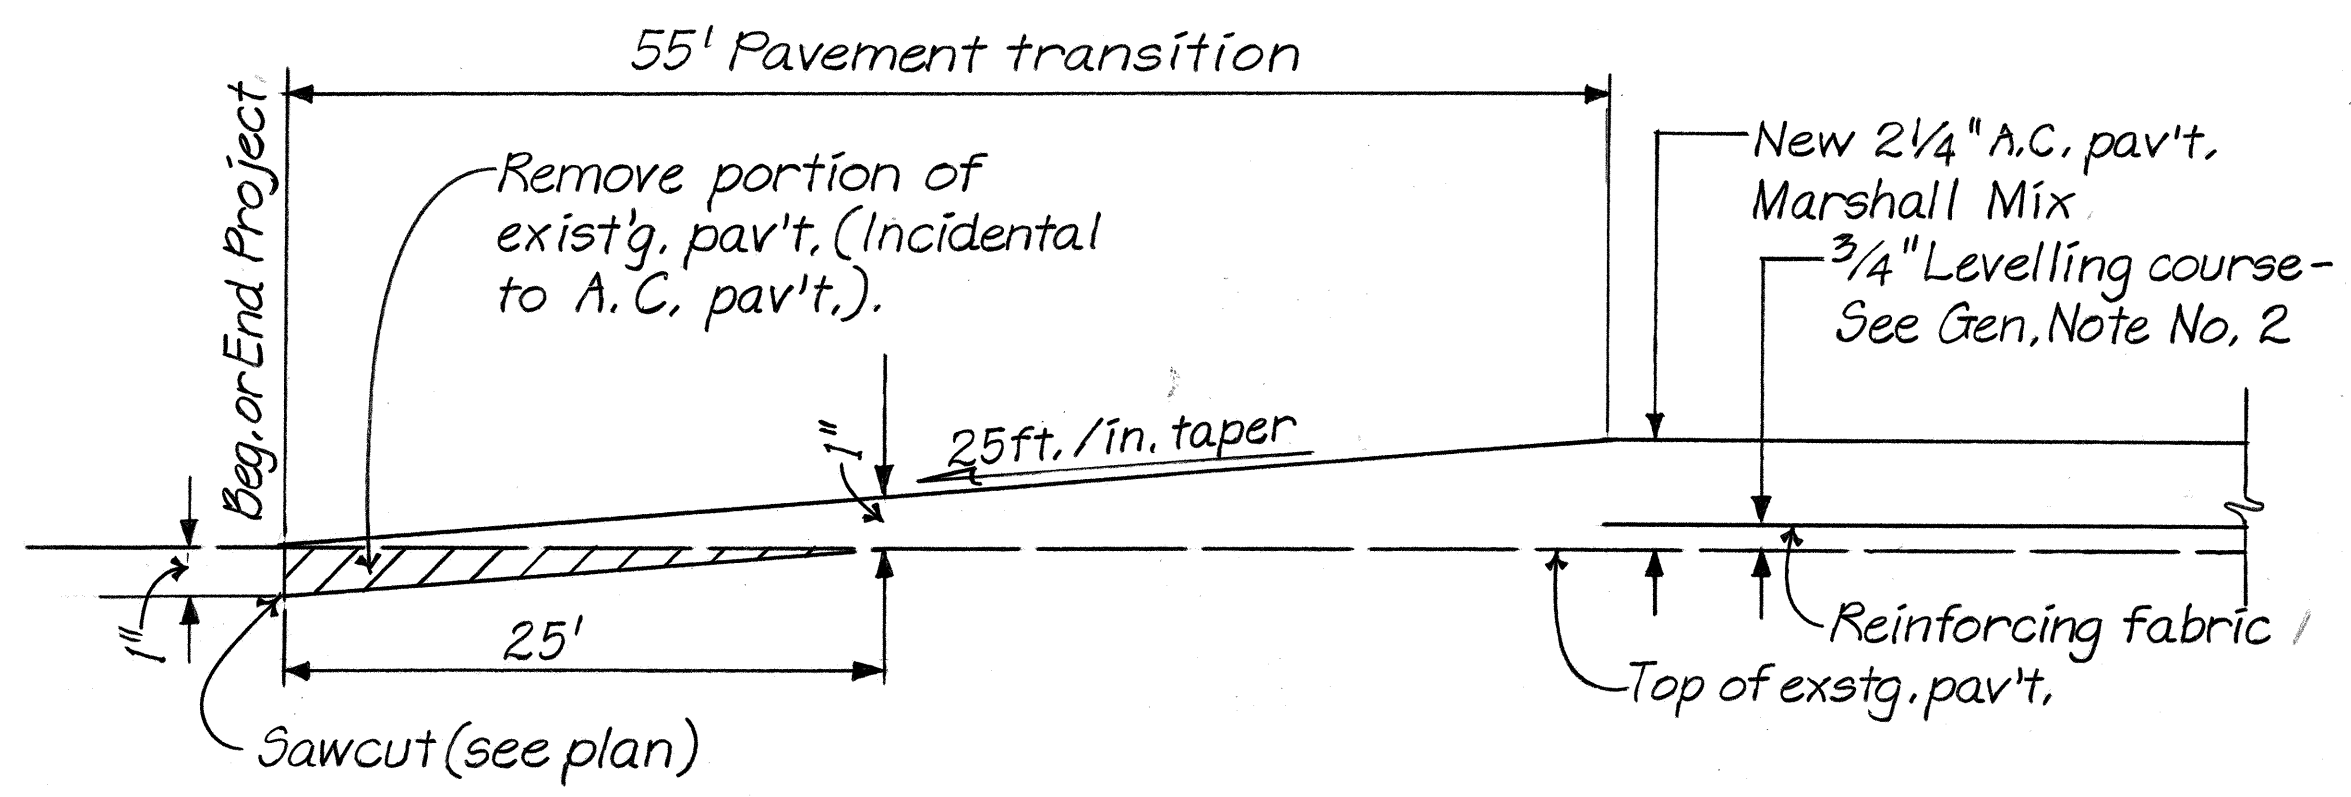

TYPICAL SECTION - PAVEMENT TRANSITION @ BEGIN & END OF PROJECT

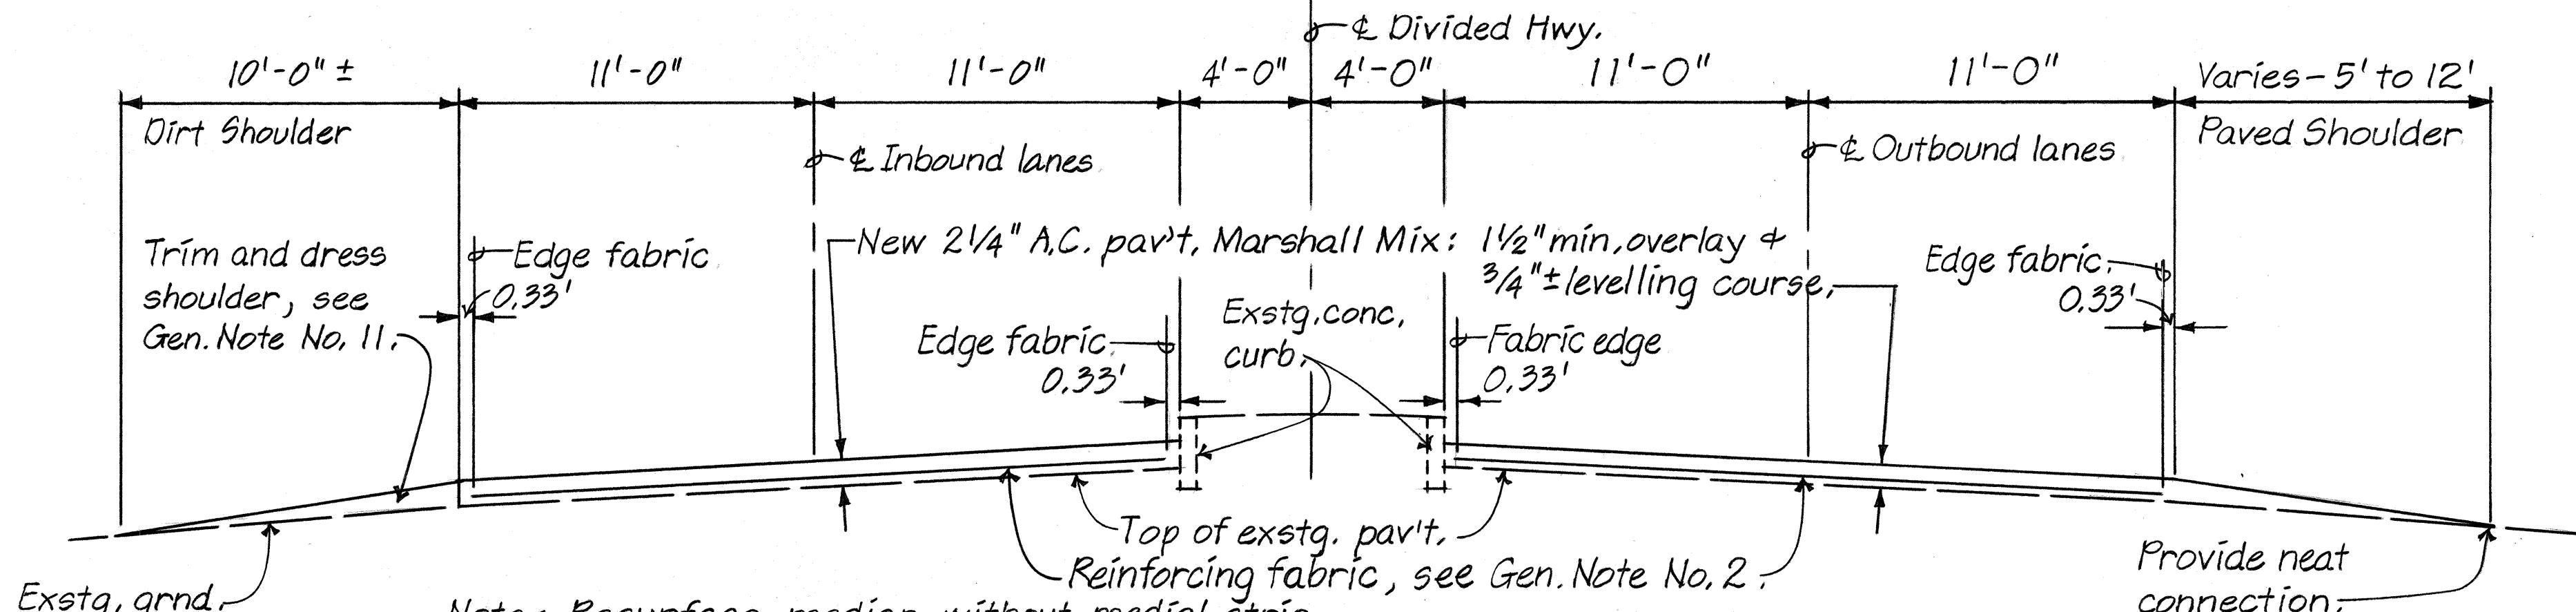

TYPICAL SECTION @ DIVIDED HWY.

STATE OF HAWAII
DEPARTMENT OF TRANSPORTATION
HIGHWAYS DIVISION

WAIALO RD. RESURFACING
Sta. (-)3+50 ± to 16+05
Proj. No. 541A-01-89M
Plan, Typical Sections, and
Estimated Quantities
Scale: As shown Mar. 1989

SHEET No. 5 OF 5 SHEETS

DATE	
SURVEY PLOTTED BY	
DRAWN BY	
DESIGNED BY	
QUANTITIES BY	
CHECKED BY	
ORIGINAL PLAN	
NOTE BOOK	
NO.	