

INDEX TO DRAWINGS	
SHEET NO.	DESCRIPTION
1	TITLE SHEET
2	STANDARD PLAN SUMMARY
3	GENERAL AND PAVEMENT MARKING NOTES
4	PLAN, TYPICAL SECTIONS, DETAILS AND ESTIMATED QUANTITIES - KAUMUALII HIGHWAY
5	PLAN, TYPICAL SECTIONS AND ESTIMATED QUANTITIES - WAIALO ROAD

STATE OF HAWAII

DEPARTMENT OF TRANSPORTATION

HIGHWAYS DIVISION

"AS-BUILT" PLANS FOR

KAUMUALII HIGHWAY RESURFACING

KEKAHA TO MANA

PROJECT NO.50A-01-89M

AND






WAIALO ROAD RESURFACING

PROJECT NO.541A-01-89M

DISTRICTS OF WAIMEA AND KOLOA

ISLAND OF KAUAI

FED. ROAD DIST. NO.	STATE	PROJ. NO.	FISCAL YEAR	SHEET NO.	TOTAL SHEETS
HAWAII	HAW.	50A-01-89M 541A-01-89M	1989	1	5

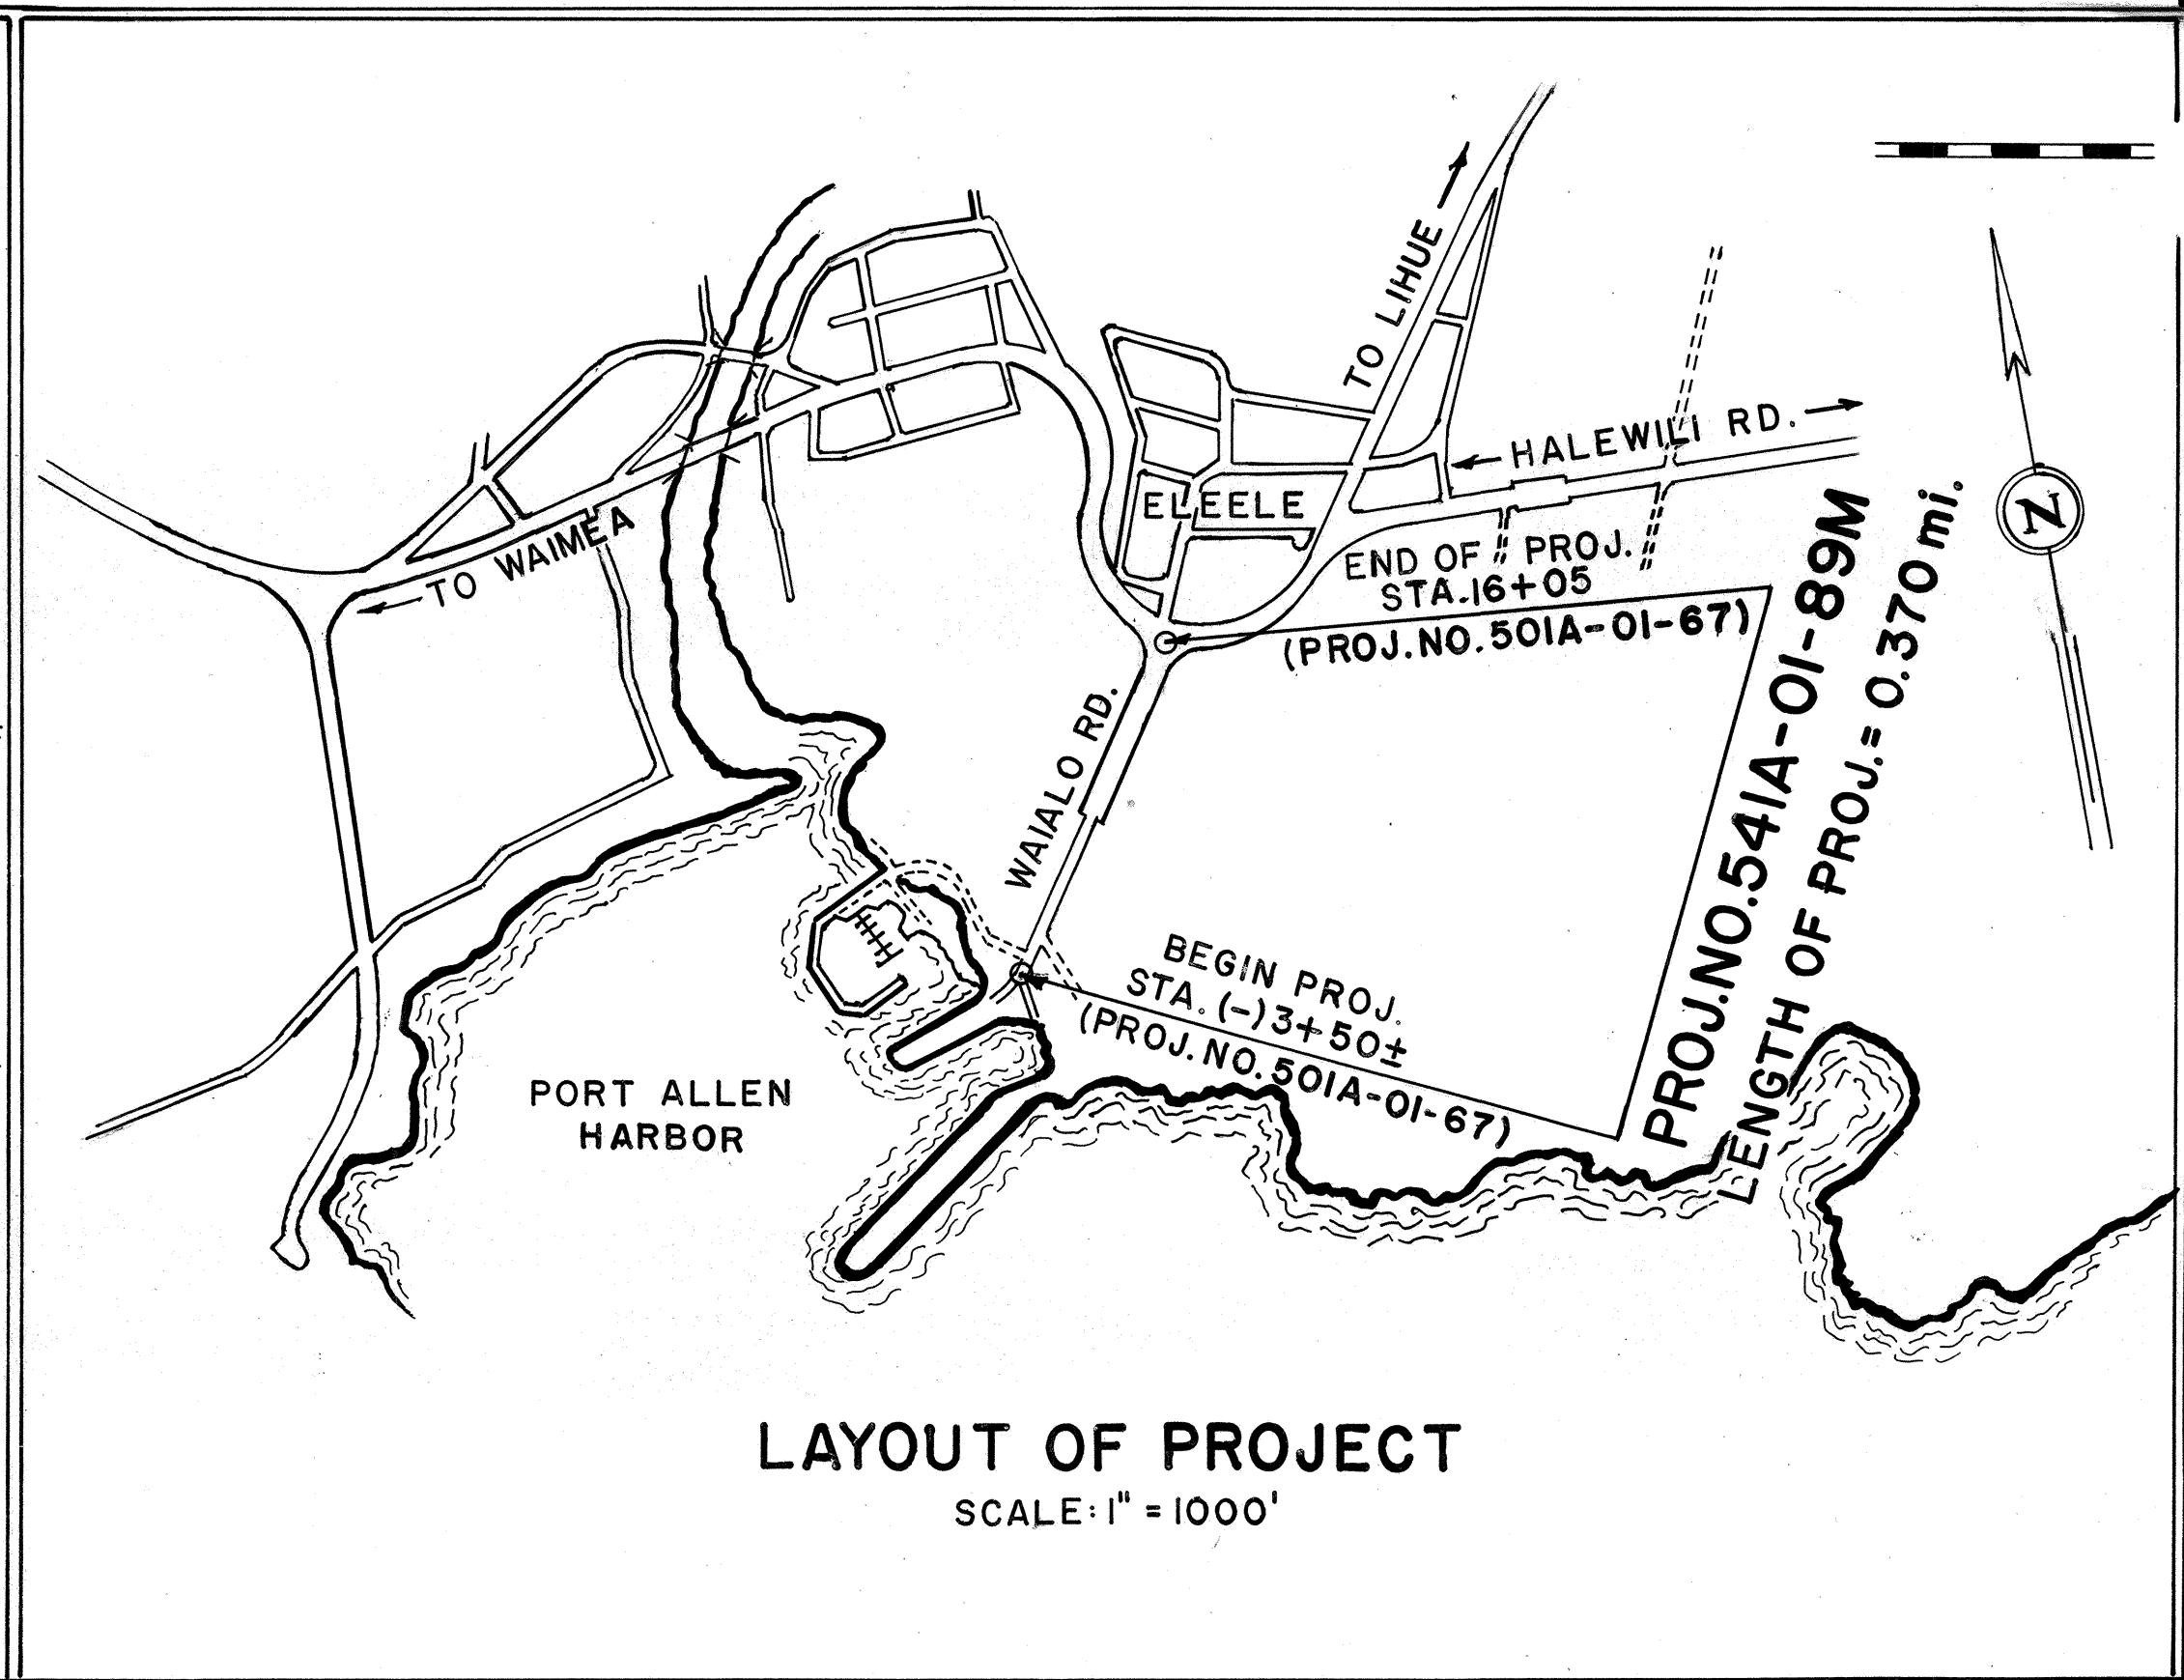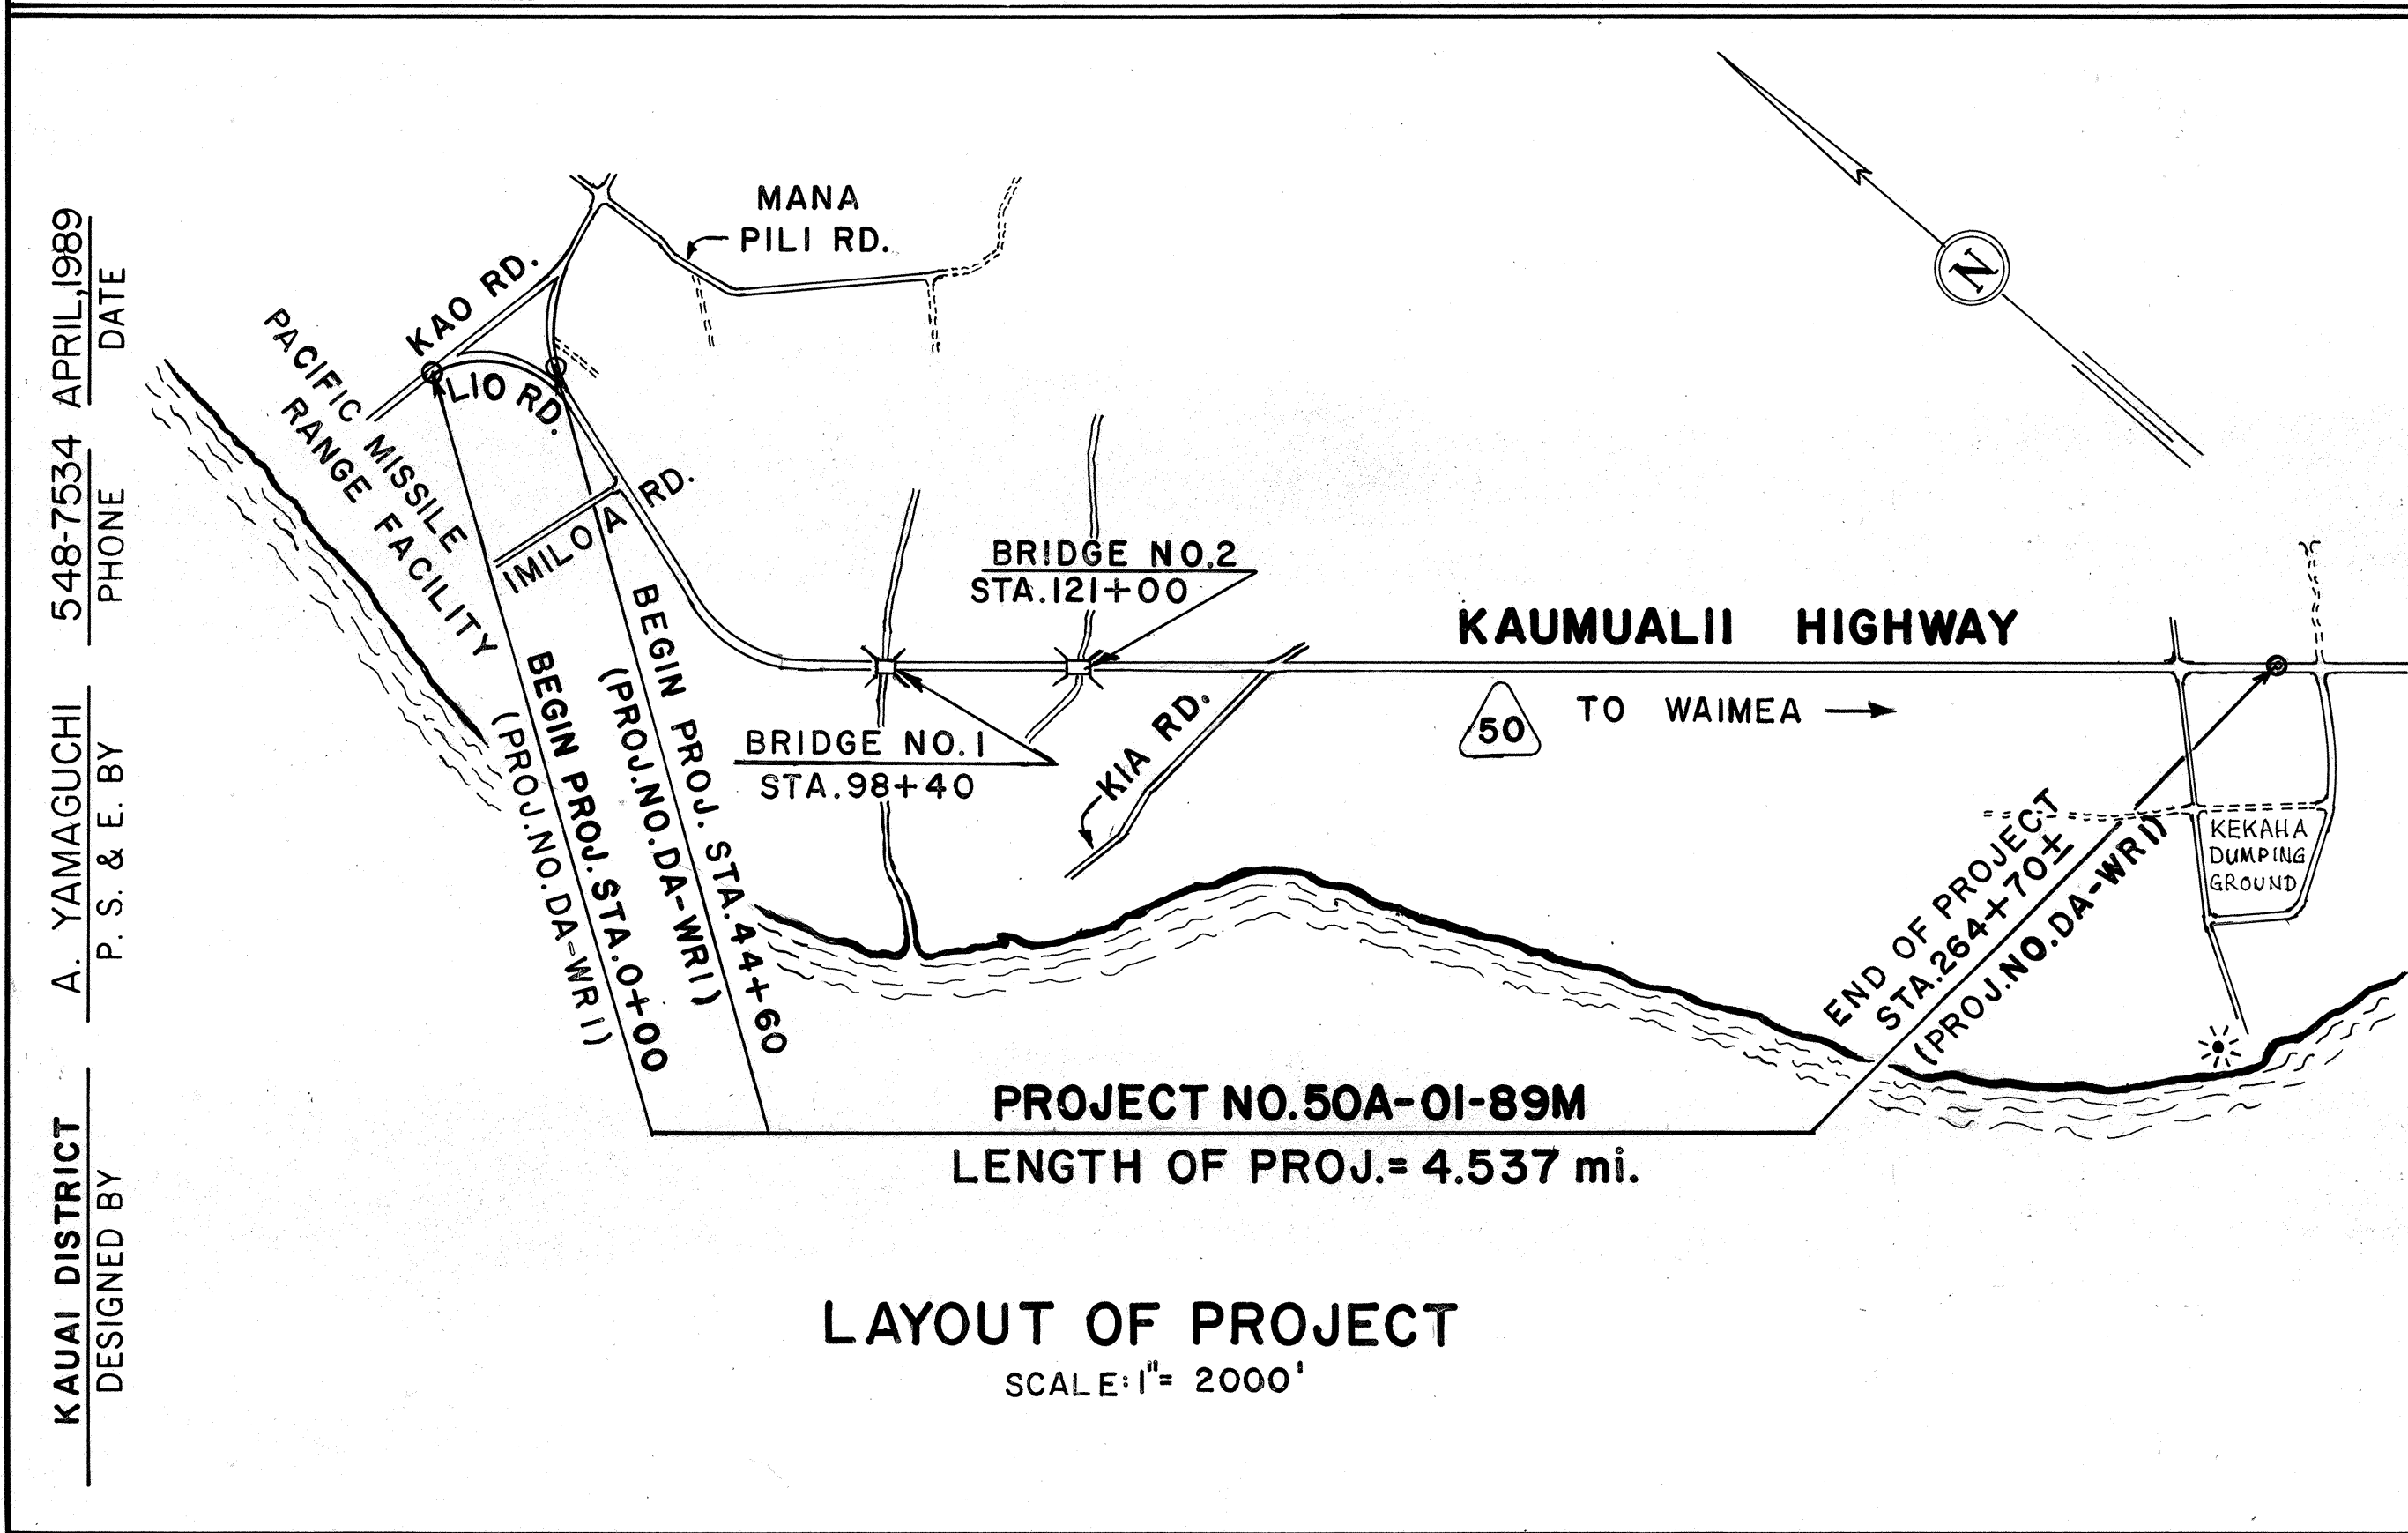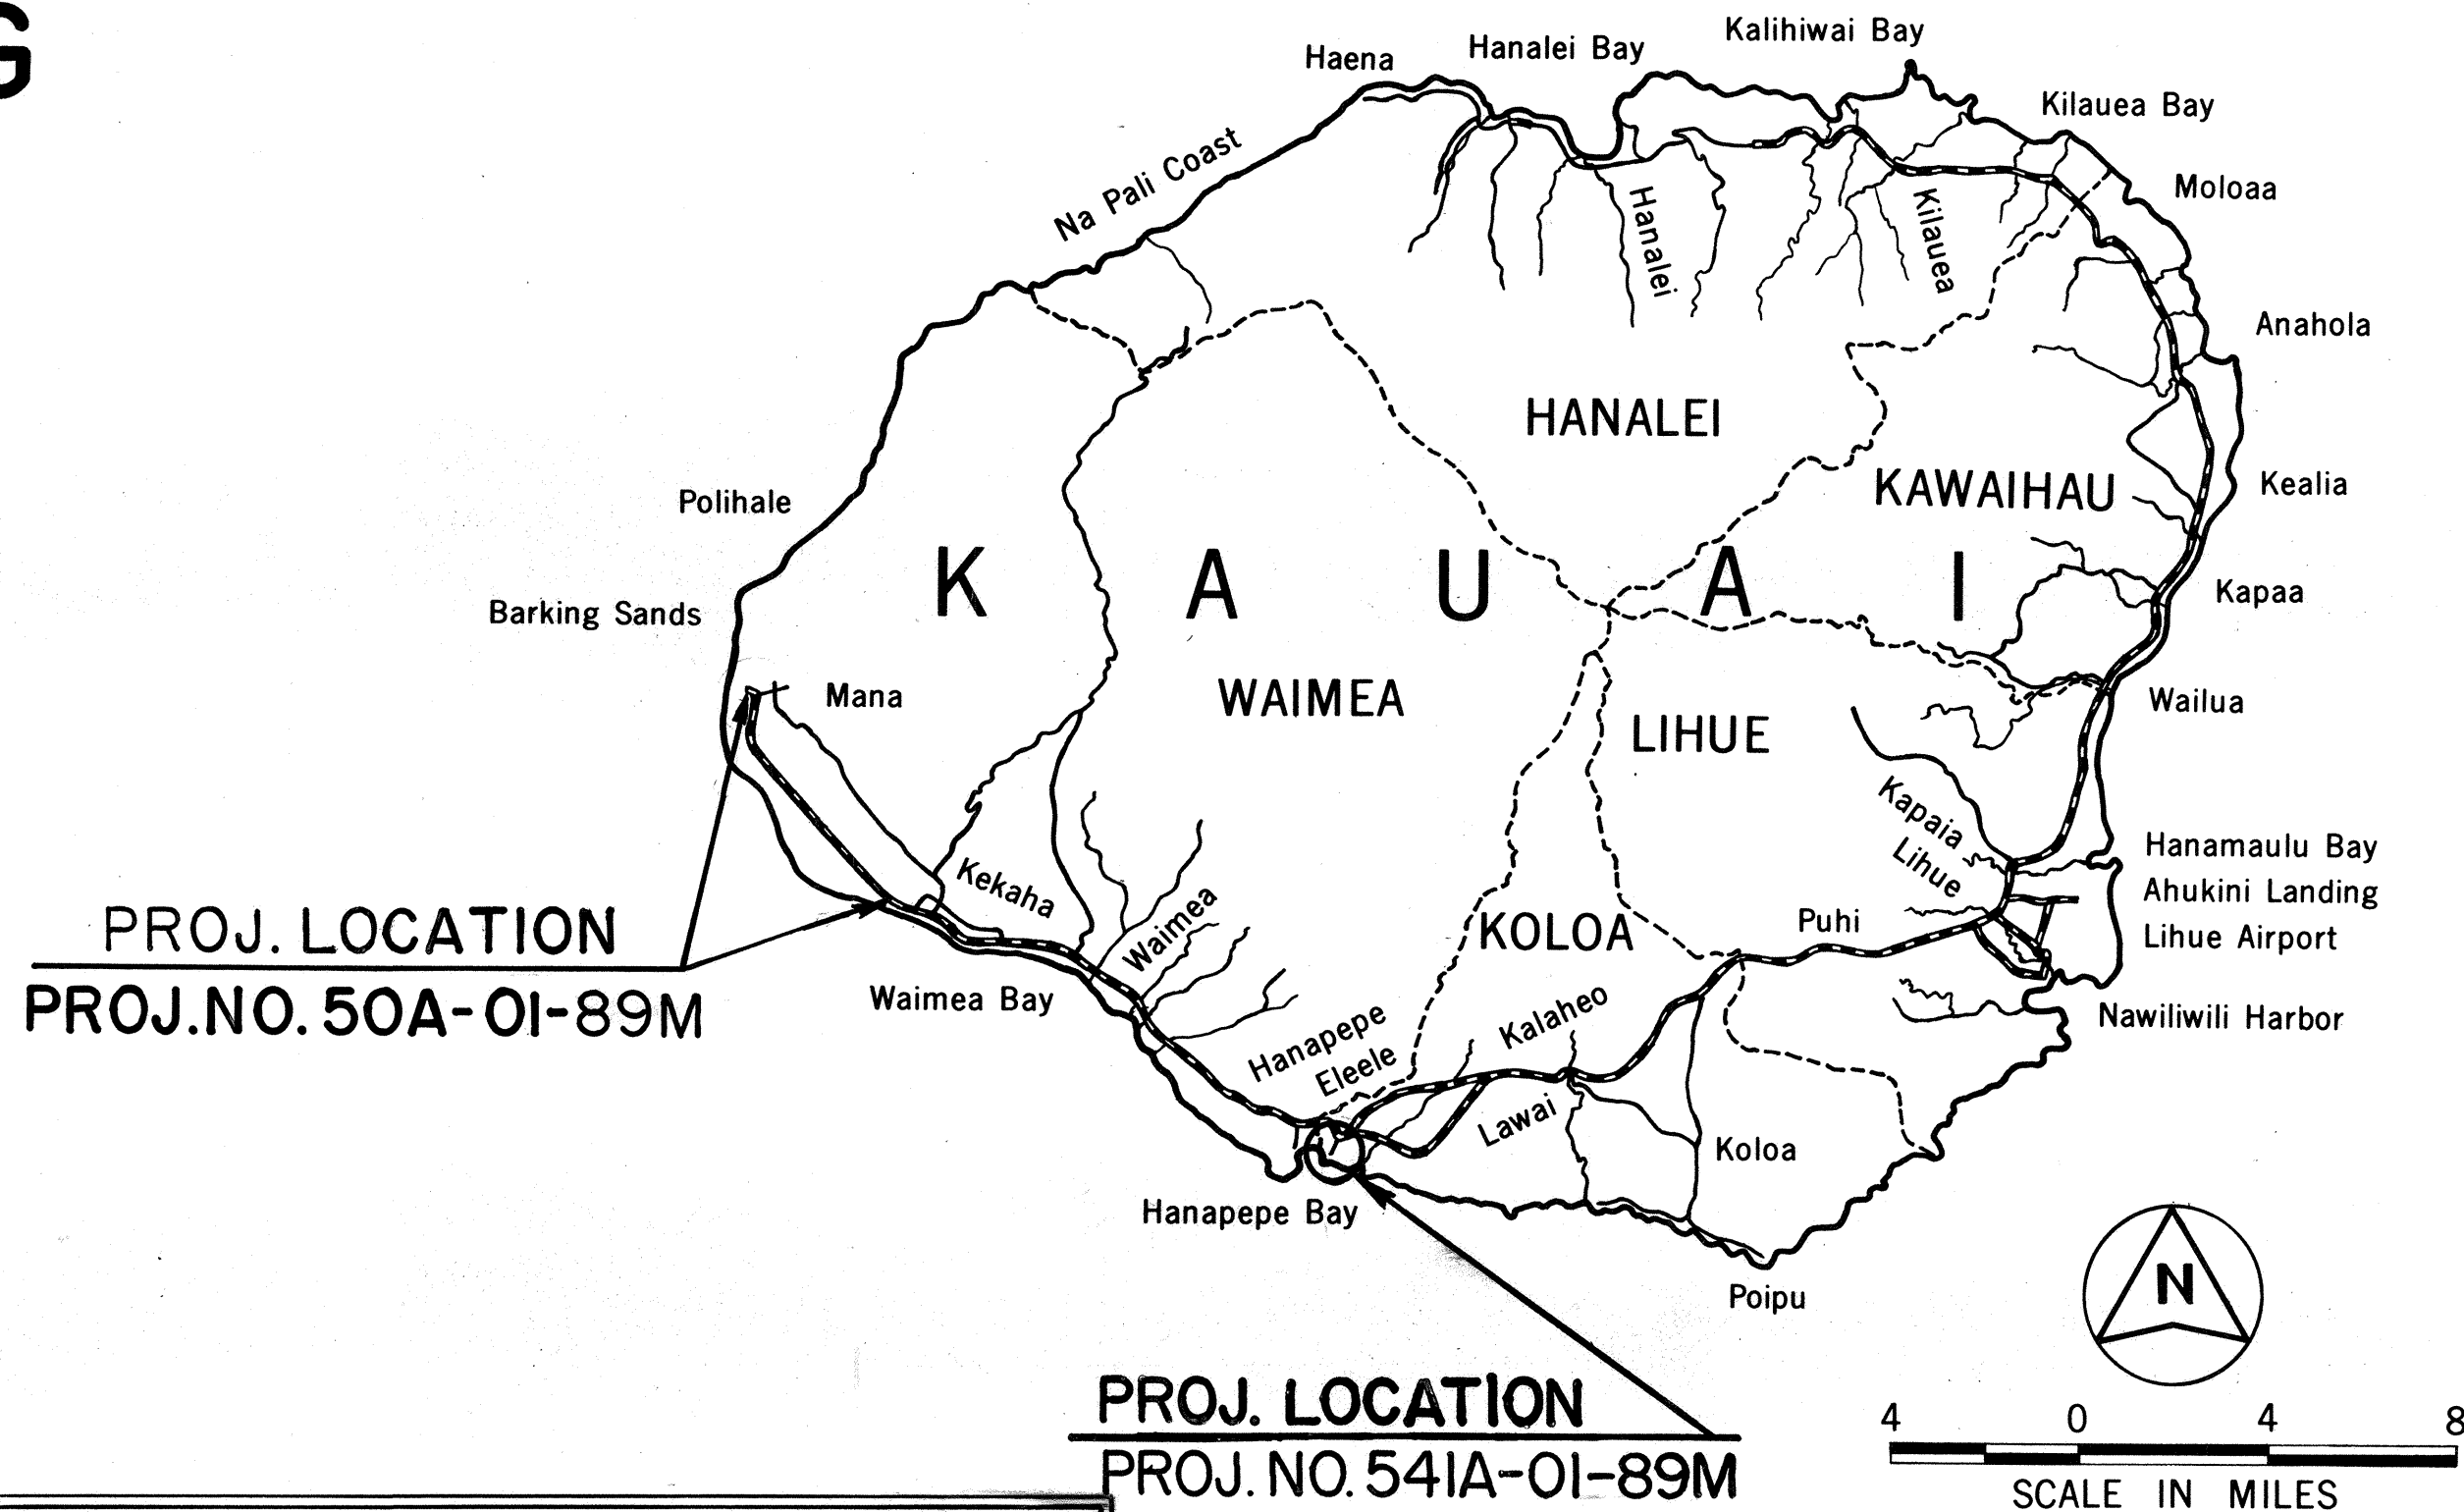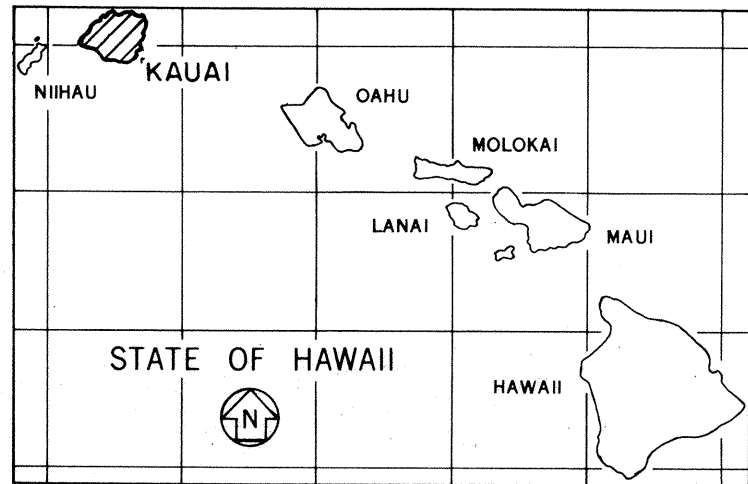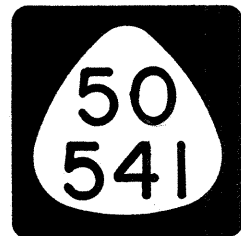

FEDERAL AID PROJECTS PREVIOUSLY CONSTRUCTED OR UNDER CONSTRUCTION

CHANGES MADE DURING CONSTRUCTION HAVE BEEN NOTED ON THESE PLANS AND CHECKED BY:

Donald H. Moeda

RESIDENT ENGINEER

6/27/90

DATE

DEPARTMENT OF TRANSPORTATION

STATE OF HAWAII

APPROVED:

Edward J. Smith

4/24/89

DIR. OF TRANSPORTATION

DATE

KAUAI DISTRICT

DESIGNED BY

A. YAMAGUCHI

548-7534

APRIL 1989

DATE

P. S. & E. BY

PHONE