

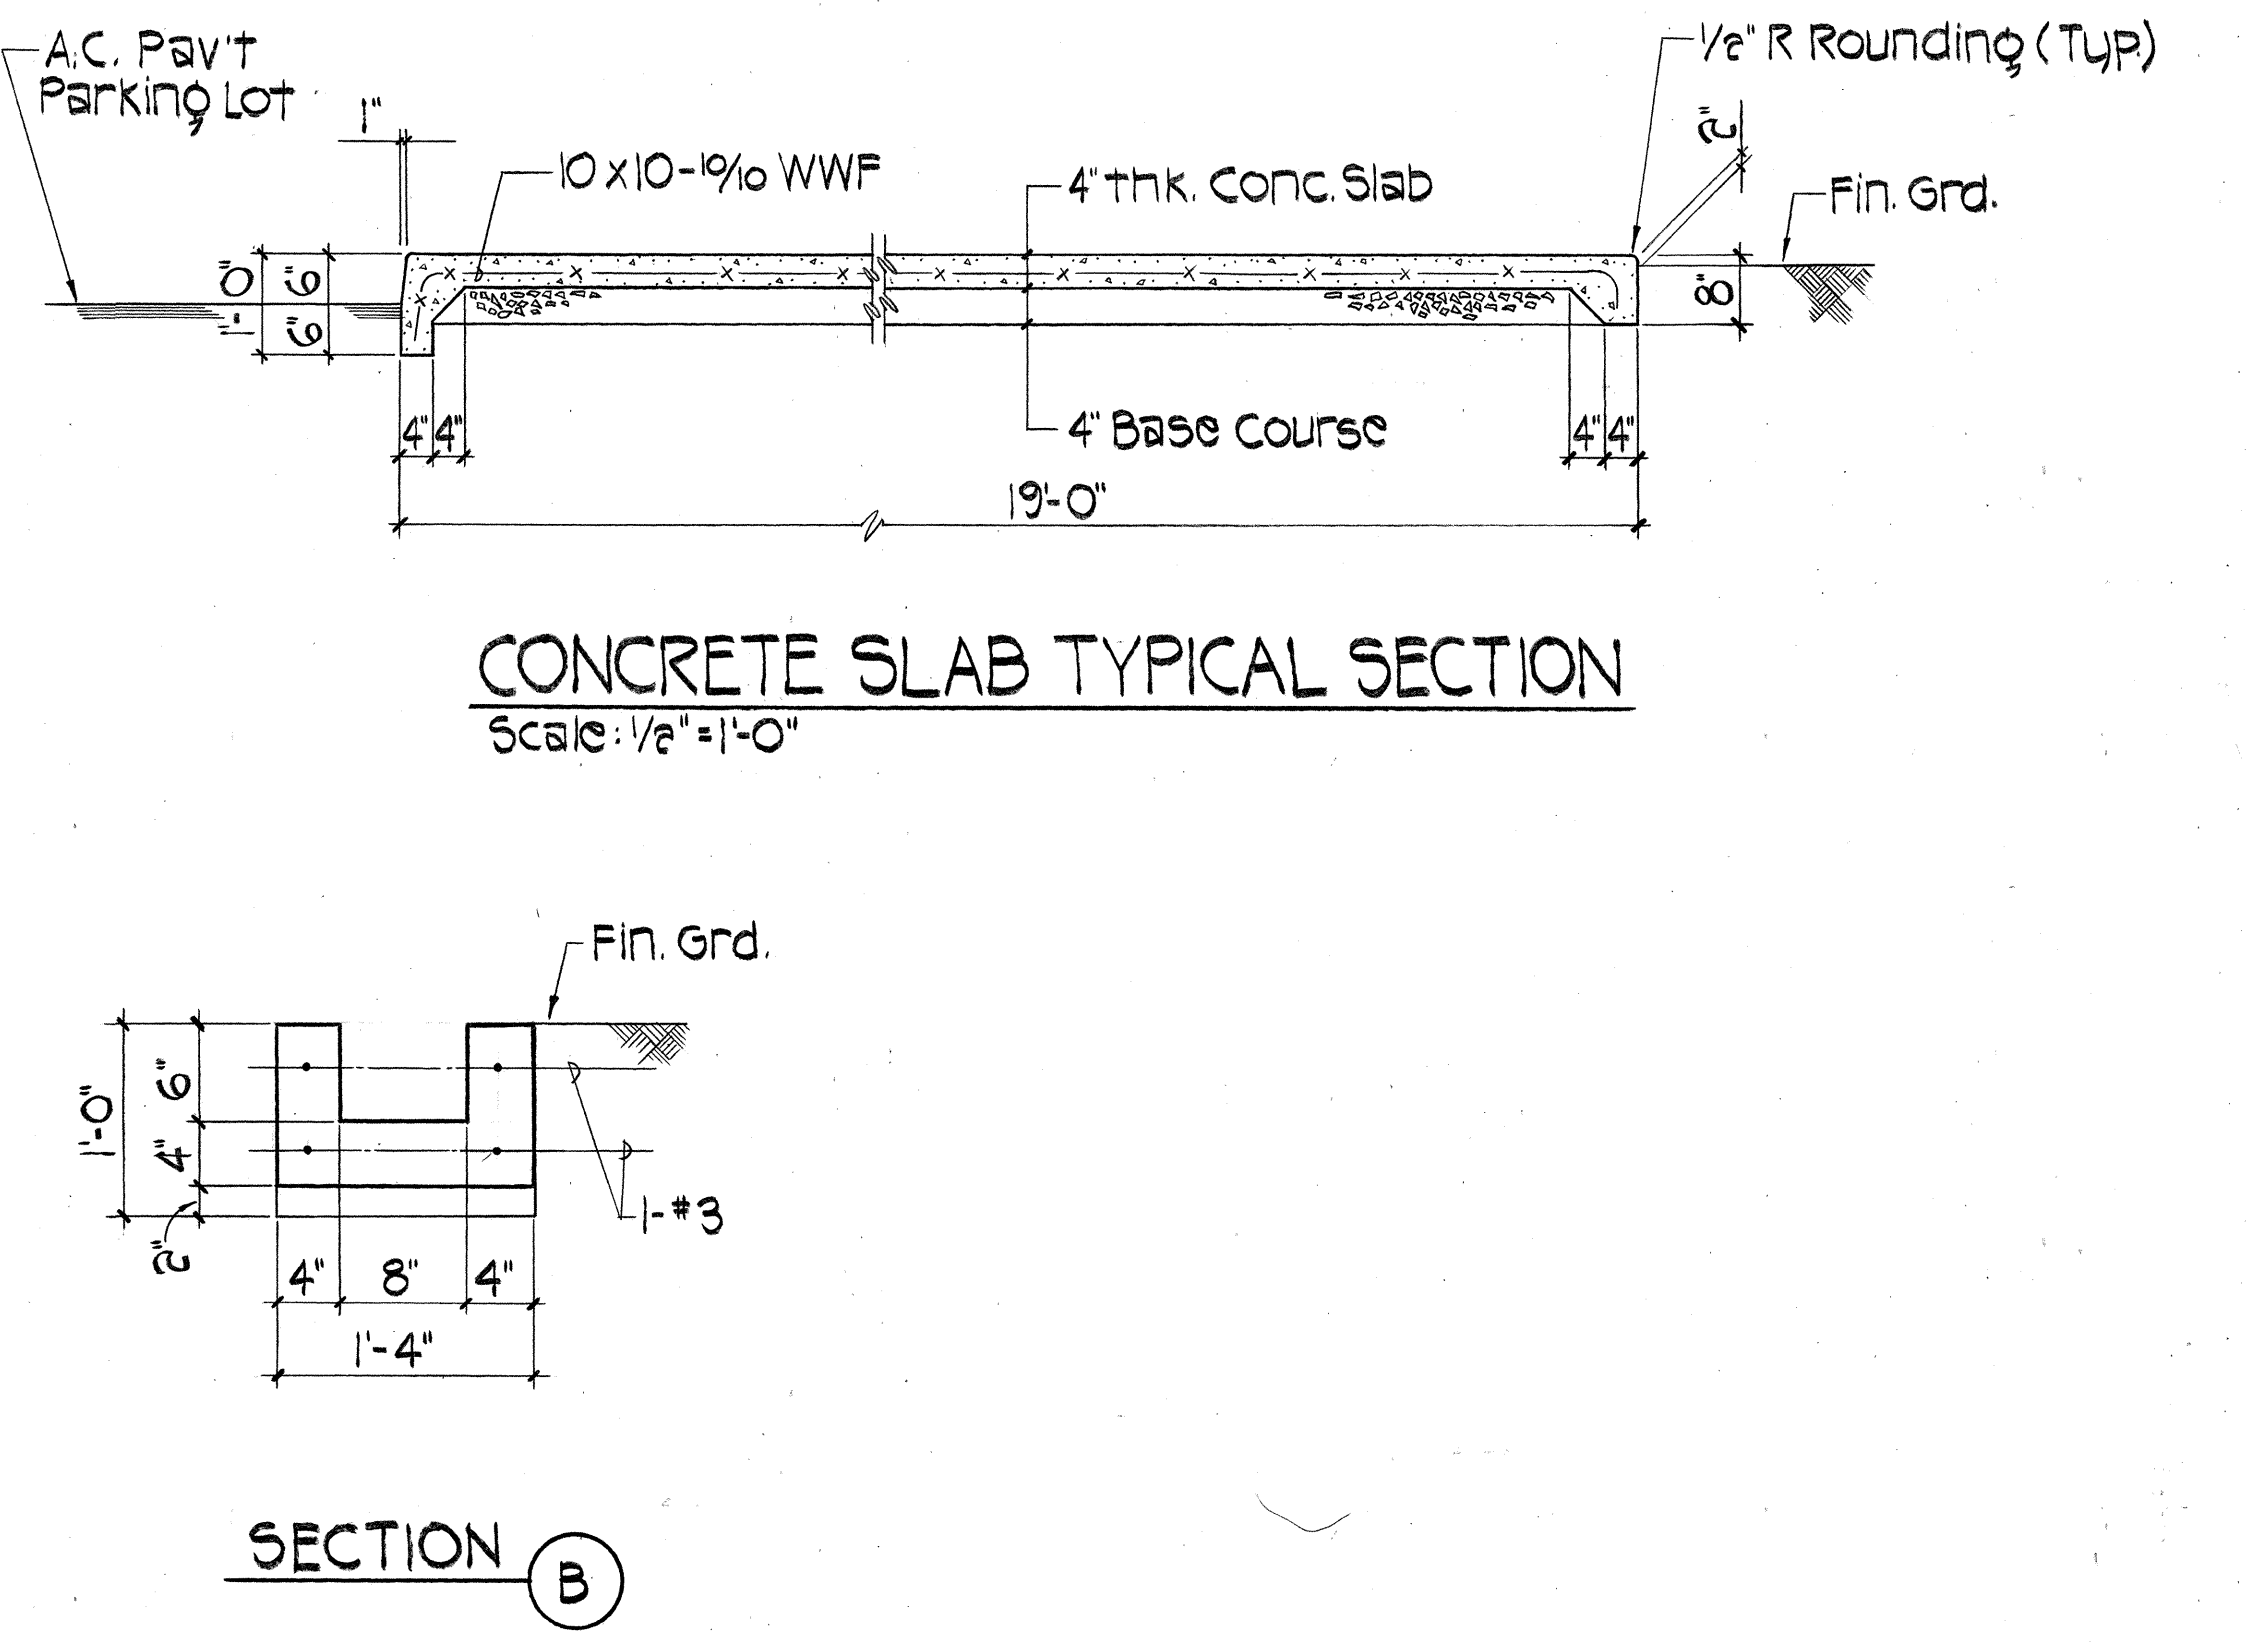
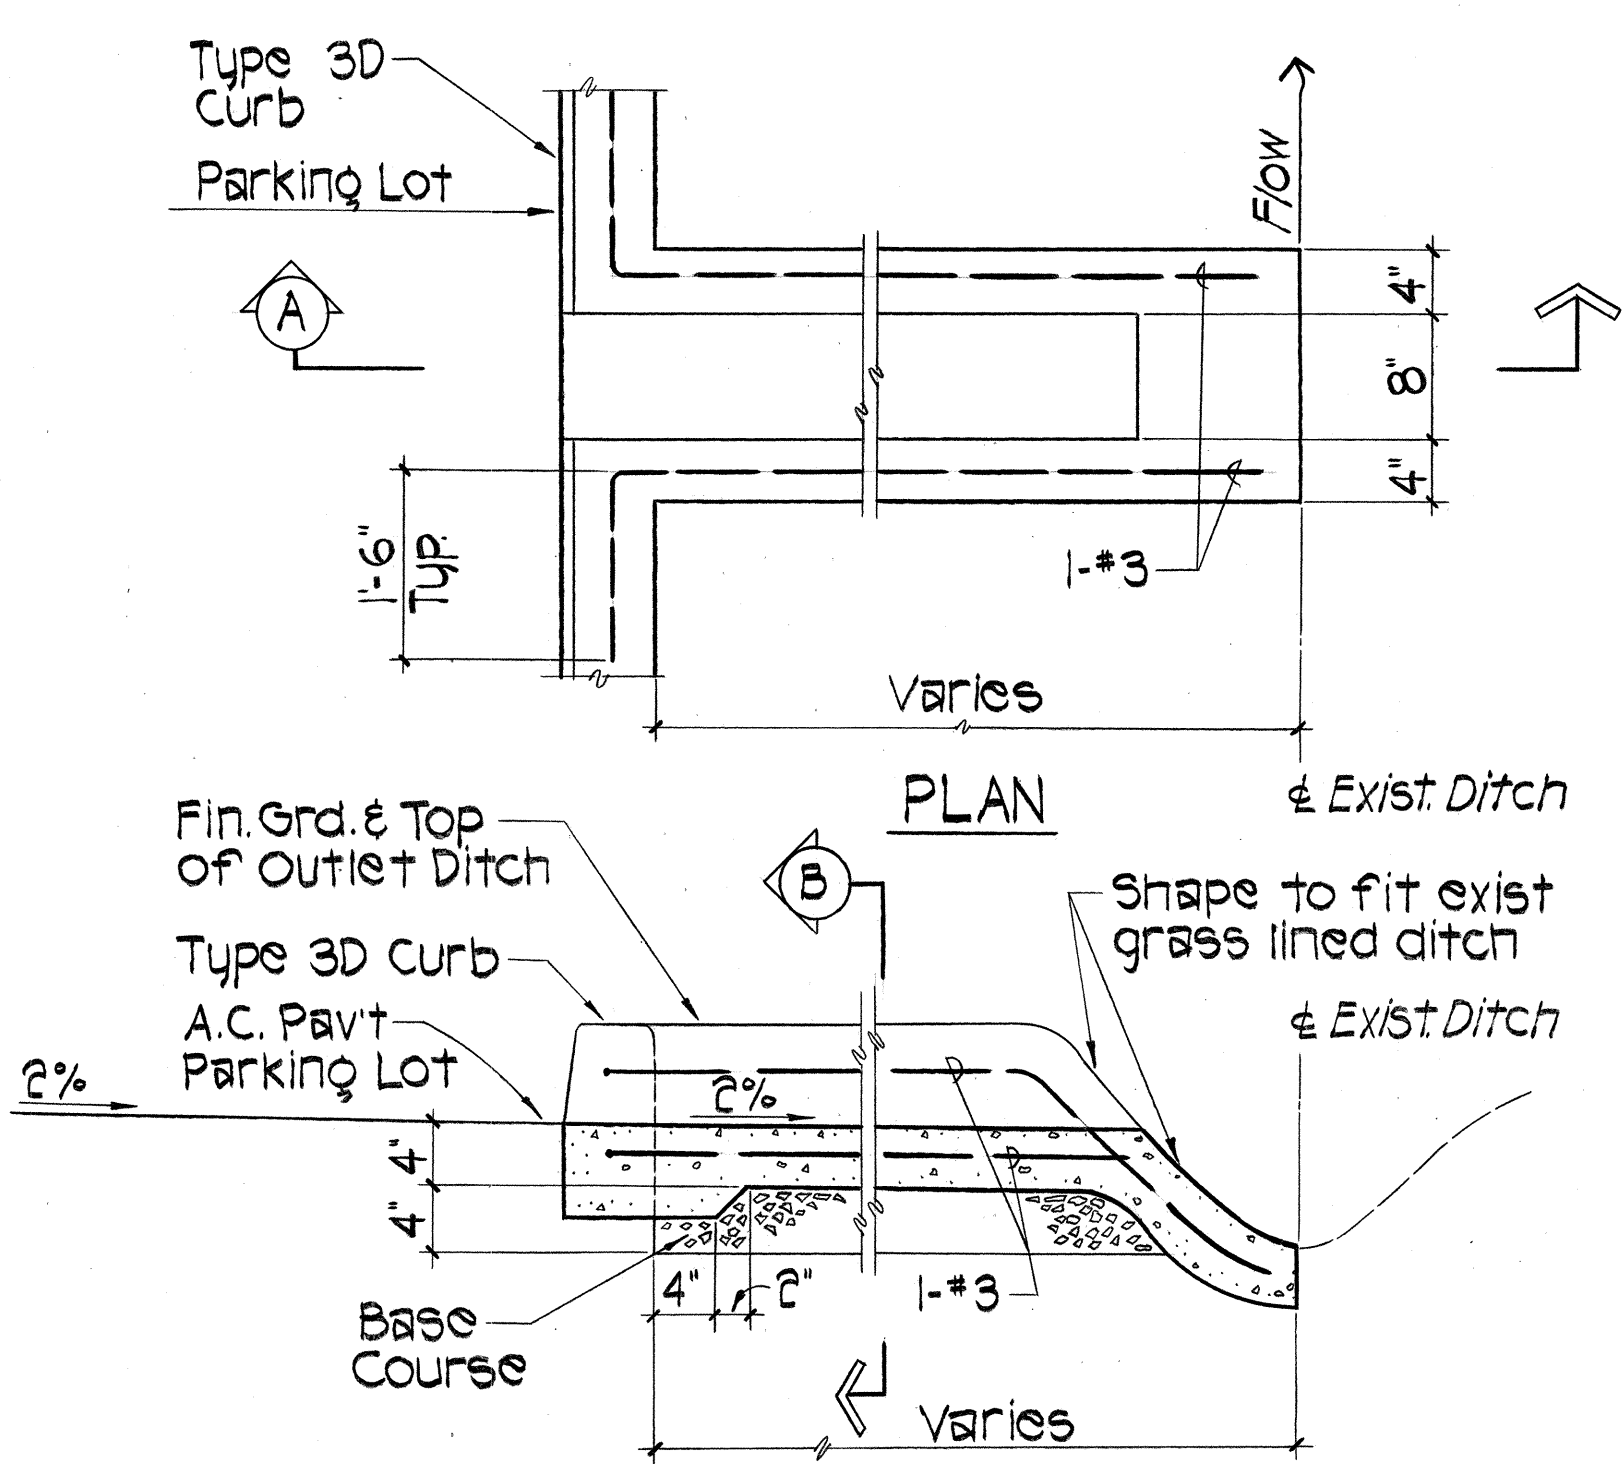
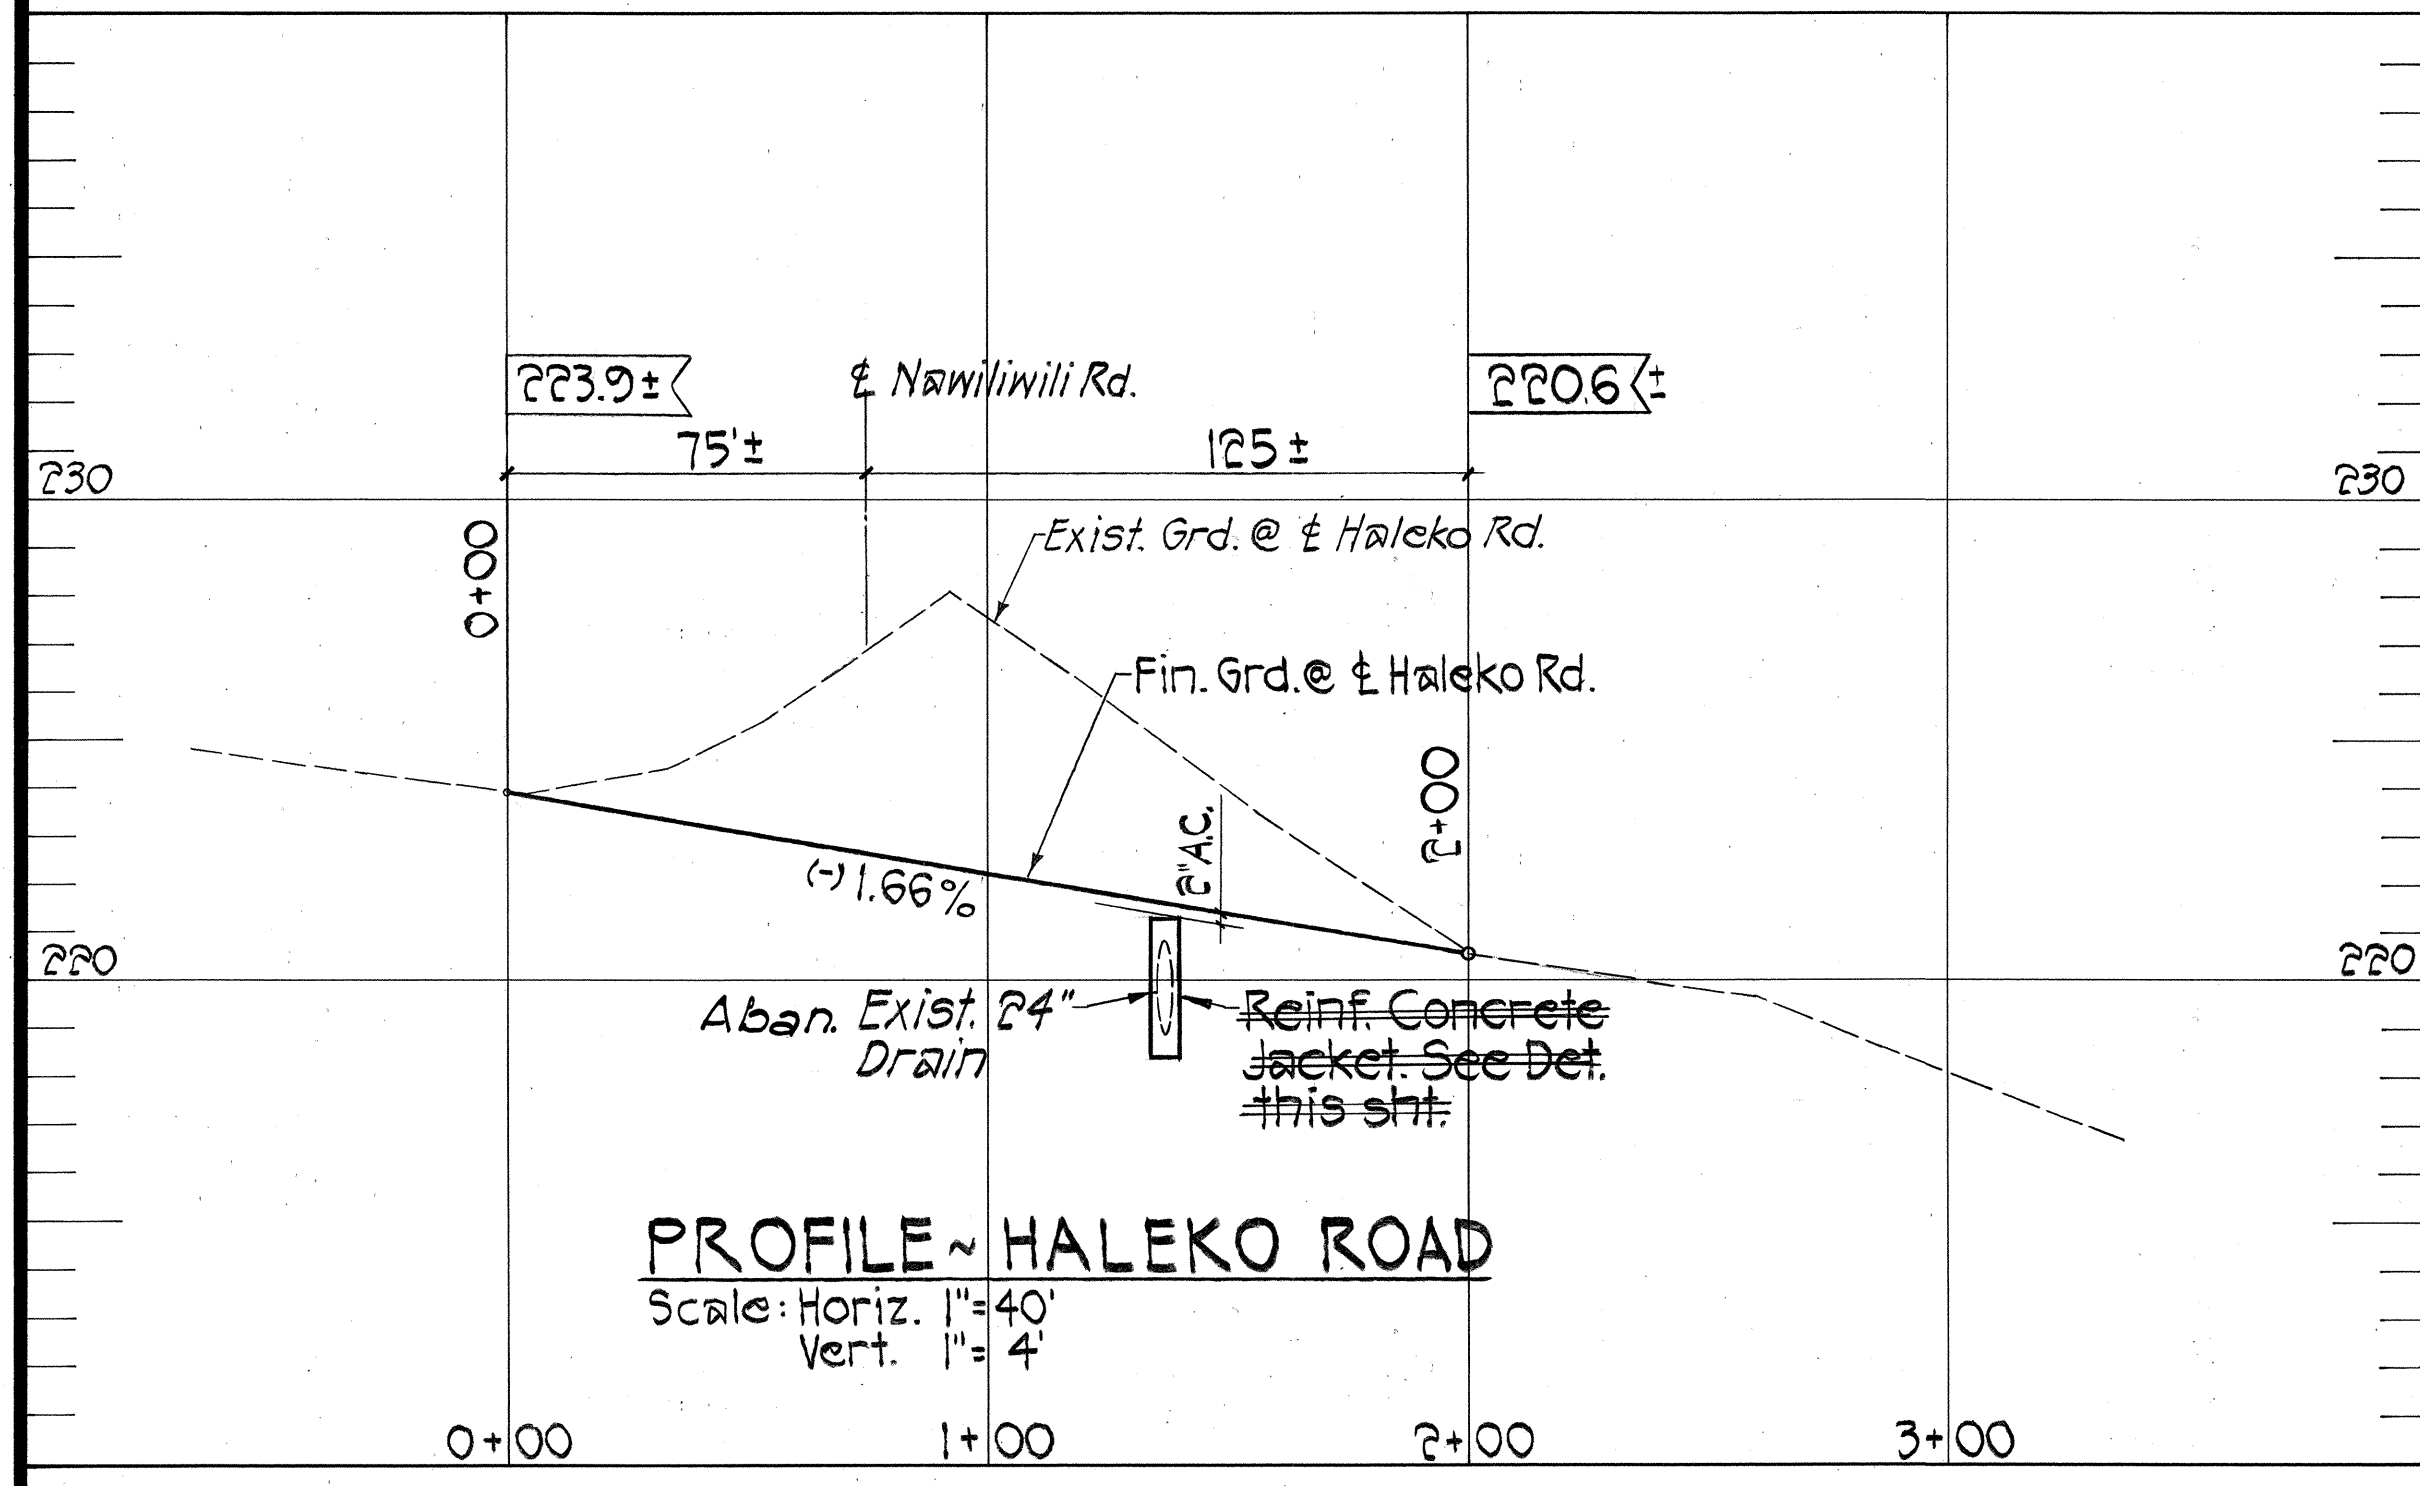
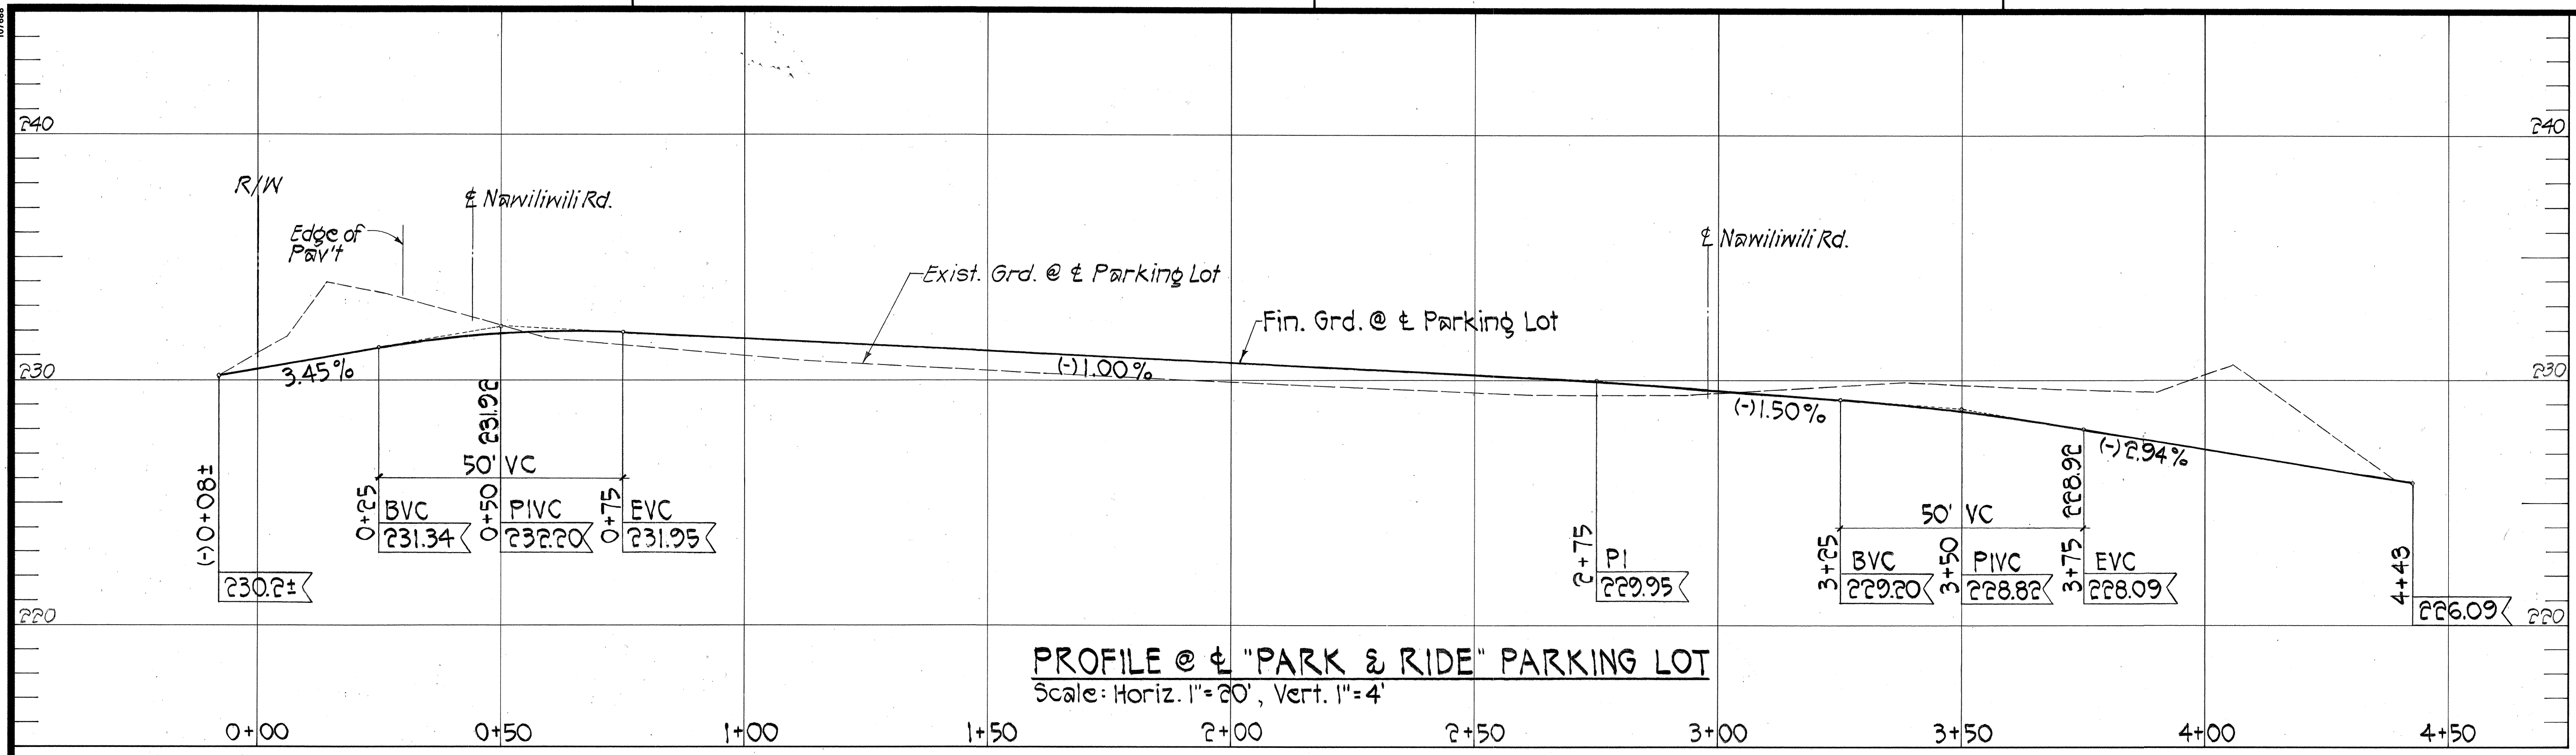


FED. ROAD DIST. NO.	STATE	FED. AID PROJ. NO.	FISCAL YEAR	SHEET NO.	TOTAL SHEETS
HAWAII	HAW.	F-058-1(1)	1990	16	29

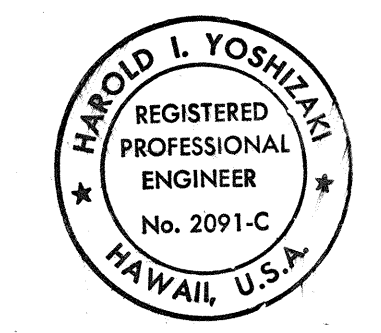

NOTE:
 Location of Parking Lot
 Outlet Drain - 28'± right,
 Stns. 1+53±, 2+59±, 3+74±

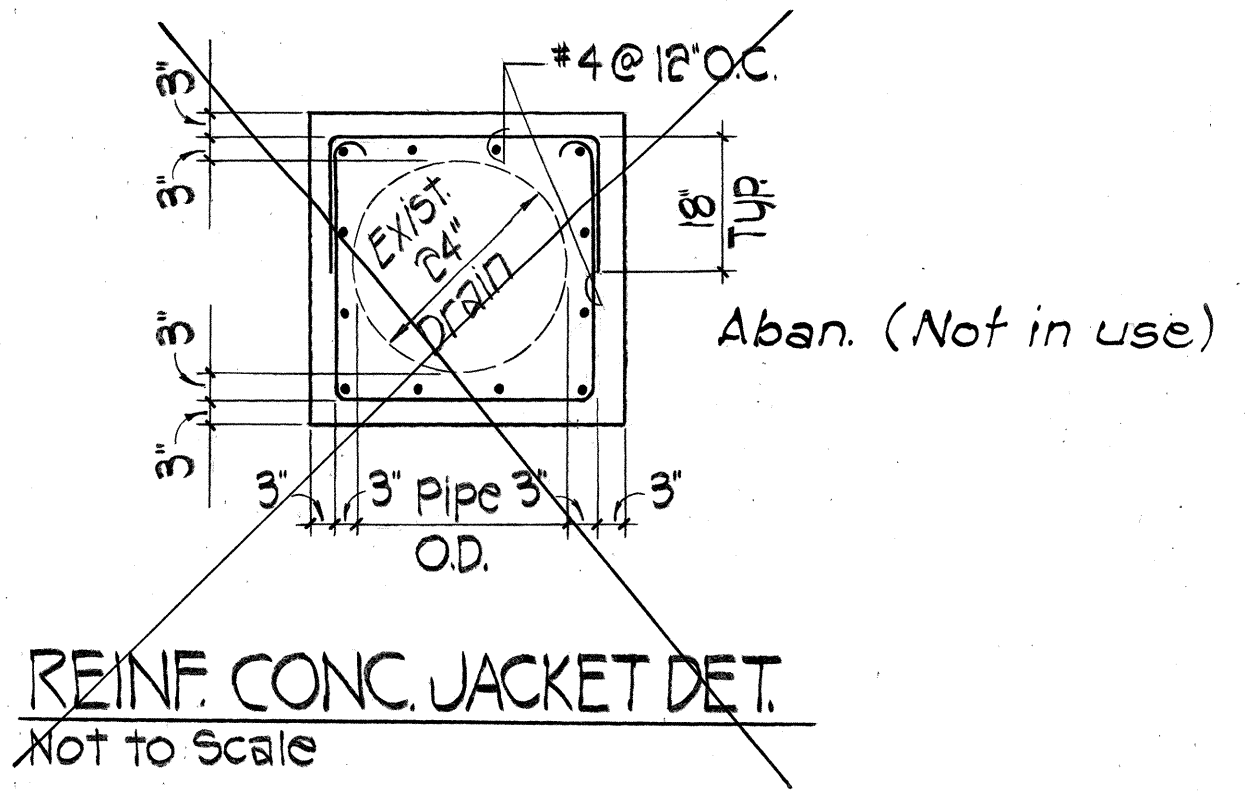

THIS WORK WAS PREPARED BY
 ME OR UNDER MY SUPERVISION.
Harold I. Yoshizaki

STATE OF HAWAII
 DEPARTMENT OF TRANSPORTATION
 HIGHWAYS DIVISION

**PARKING LOT & HALEKO ROAD
 PROFILE & MISC. DETAILS**

NAWILIWILI ROAD REALIGNMENT
 HALEHAKA ROAD TO KAUMUALII HIGHWAY
 FED. AID PROJECT NO. F-058-1(1)
 SCALE: AS NOTED DATE: Sept. 1989

SHEET NO. 1 OF 1 SHEETS