

PAVEMENT MARKING SUMMARY

Station	Type DL	Type HL	Type J	Type CL	Type A	4" Yellow Guide	4" Yellow Solid	4" Yellow Double	12" Yellow Solid	White Arrow	4" White Guide	4" White Edge	8" White Solid	12" White Solid	Remarks		
KAUMUALII HWY.																	
298+05 (1)	12	54	12	73	-	50	105	200	1,020	130	2	605	1,880	160	350	Intersection	
306+32.46 (1)	27	-	-	80	36	40	-	525	-	6	310	935	220	510	410		
311+05 (1)				E	X	C	E	P	T	I	O	N			45	Intersection	
317+15 (1)	18	36	-	42	-	-	-	355	740	100	3	465	1,400	-	20		
3+50 (2)	18	-	-	18	-	-	-	360	-	-	-	730	-	-	-	No Pass	
7+00 (2)	3	-	-	6	-	-	-	40	-	-	-	100	-	-	25	Intersection	
7+50 (2)	46	-	-	46	-	-	-	900	-	-	-	260	1,500	-	-	No Pass	
16+50 (2)																	
Subtotal:	124	90	12	265	36	** *	*	2,380	**	*	***	* *	380	**	760		
						90	105	* 1,760	230	11	1,380	5305	* 2,320	**	90		
KAPULE HWY.																	
37+00 (3)	45	62	-	154	-	126	-	910	1,270	260	16	1,040	3,010	180	820	850	Intersection
8+00 (4)	31	54	-	100	-	90	-	570	960	180	5	555	2,010	95	390	155	Intersection
18+00 (4)	36	-	-	36	-	-	-	710	-	-	-	1,420	-	-	-	-	No Pass
25+10 (4)	6	-	-	4	-	-	-	60	-	-	-	-	-	-	70	Intersection	
25+50 (4)	30	-	-	32	-	-	-	590	-	-	-	1,180	-	-	-	-	No Pass
31+37 (4)																	
Subtotal:	148	116	-	326	-	** *	-	2,840	**	*	***	**	275	**	1,005	**	
						216	-	* 2,230	440	21	1,595	7,620	* 1,210	**	230		
AHUKINI RD.																	
0+10 (5)	11	-	-	14	-	-	-	210	-	-	110	430	22	-	-	Intersection	
2+00 (5)	2	-	-	2	-	-	-	30	-	-	-	60	-	-	-	No Pass	
2+30 (5)	3	-	-	5	-	-	-	20	-	-	-	40	-	-	16	Intersection	
2+60 (5)	16	-	-	16	-	-	-	310	-	-	-	620	-	-	-	No Pass	
5+70 (5)	3	-	-	5	-	-	-	20	-	-	-	40	-	-	16	Intersection	
6+00 (5)	12	-	-	12	-	-	-	230	-	-	-	460	-	-	-	No Pass	
8+30 (5)	3	-	-	5	-	-	-	60	-	-	-	140	-	-	28	Intersection	
8+60 (5)	47	-	-	46	-	-	-	940	-	-	-	1,880	-	-	-	No Pass	
18+00 (5)	4	-	-	7	-	-	-	70	-	-	-	160	-	-	28	Intersection	
18+30 (5)	146	-	-	146	-	-	-	2,905	-	-	-	5,810	-	-	-	No Pass	
47+35 (5)																	
Subtotal:	247	-	-	258	-	-	-	4,795	-	-	110	9,640	22	-	88		
								* 1,795			***	**			***		
TOTALS:	519	206	12	849	36	***	*	10,015	**	*	***	**	677	**	1,765		
						306	105	* 3,990	670	32	3,085	22,565	* 3,530	**	408		
Units	Ea.	Ea.	Ea.	Ea.	Ea.	LF.	LF.	LF.	LF.	Ea.	LF.	LF.	LF.	LF.	LF.		

NOTES:

Stationing based on the following projects:

(1) Project No. F12(17)

(2) Project No. F24(2)

(3) Project No. F12(A)



(4) Project No. DP-F-051-1-(3)

(5) Project No. S-0570(1)

- * Tape, Type I or Thermoplastic Extrusion (No Passing Zones, Channelizing Lines, Solid Lines or Pavement Arrows)
- ** Tape, Type II or Thermoplastic Extrusion (Transverse Median Marking, Transverse Shoulder Marking, Channelizing Island or Edge Striping)
- *** Thermoplastic Extrusion (Guide Lines, Stop Lines, Extension of Edge Lines, or Crosswalk Marking)

STATE OF HAWAII
DEPARTMENT OF TRANSPORTATION
HIGHWAYS DIVISION
PAVEMENT MARKING PLAN #
SUMMARY, MISC. DET.
KAUMUALII HIGHWAY RESURFACING
PROJECT NO. 50E-01-92M
AHUKINI ROAD RESURFACING
PROJECT NO. 570A-01-92M
KAPULE HIGHWAY RESURFACING
PROJECT NO. 51B-01-92M
Scale: As Shown Date: Dec. 1991
SHEET NO. 1 OF 1 SHEETS

AS-BUILT

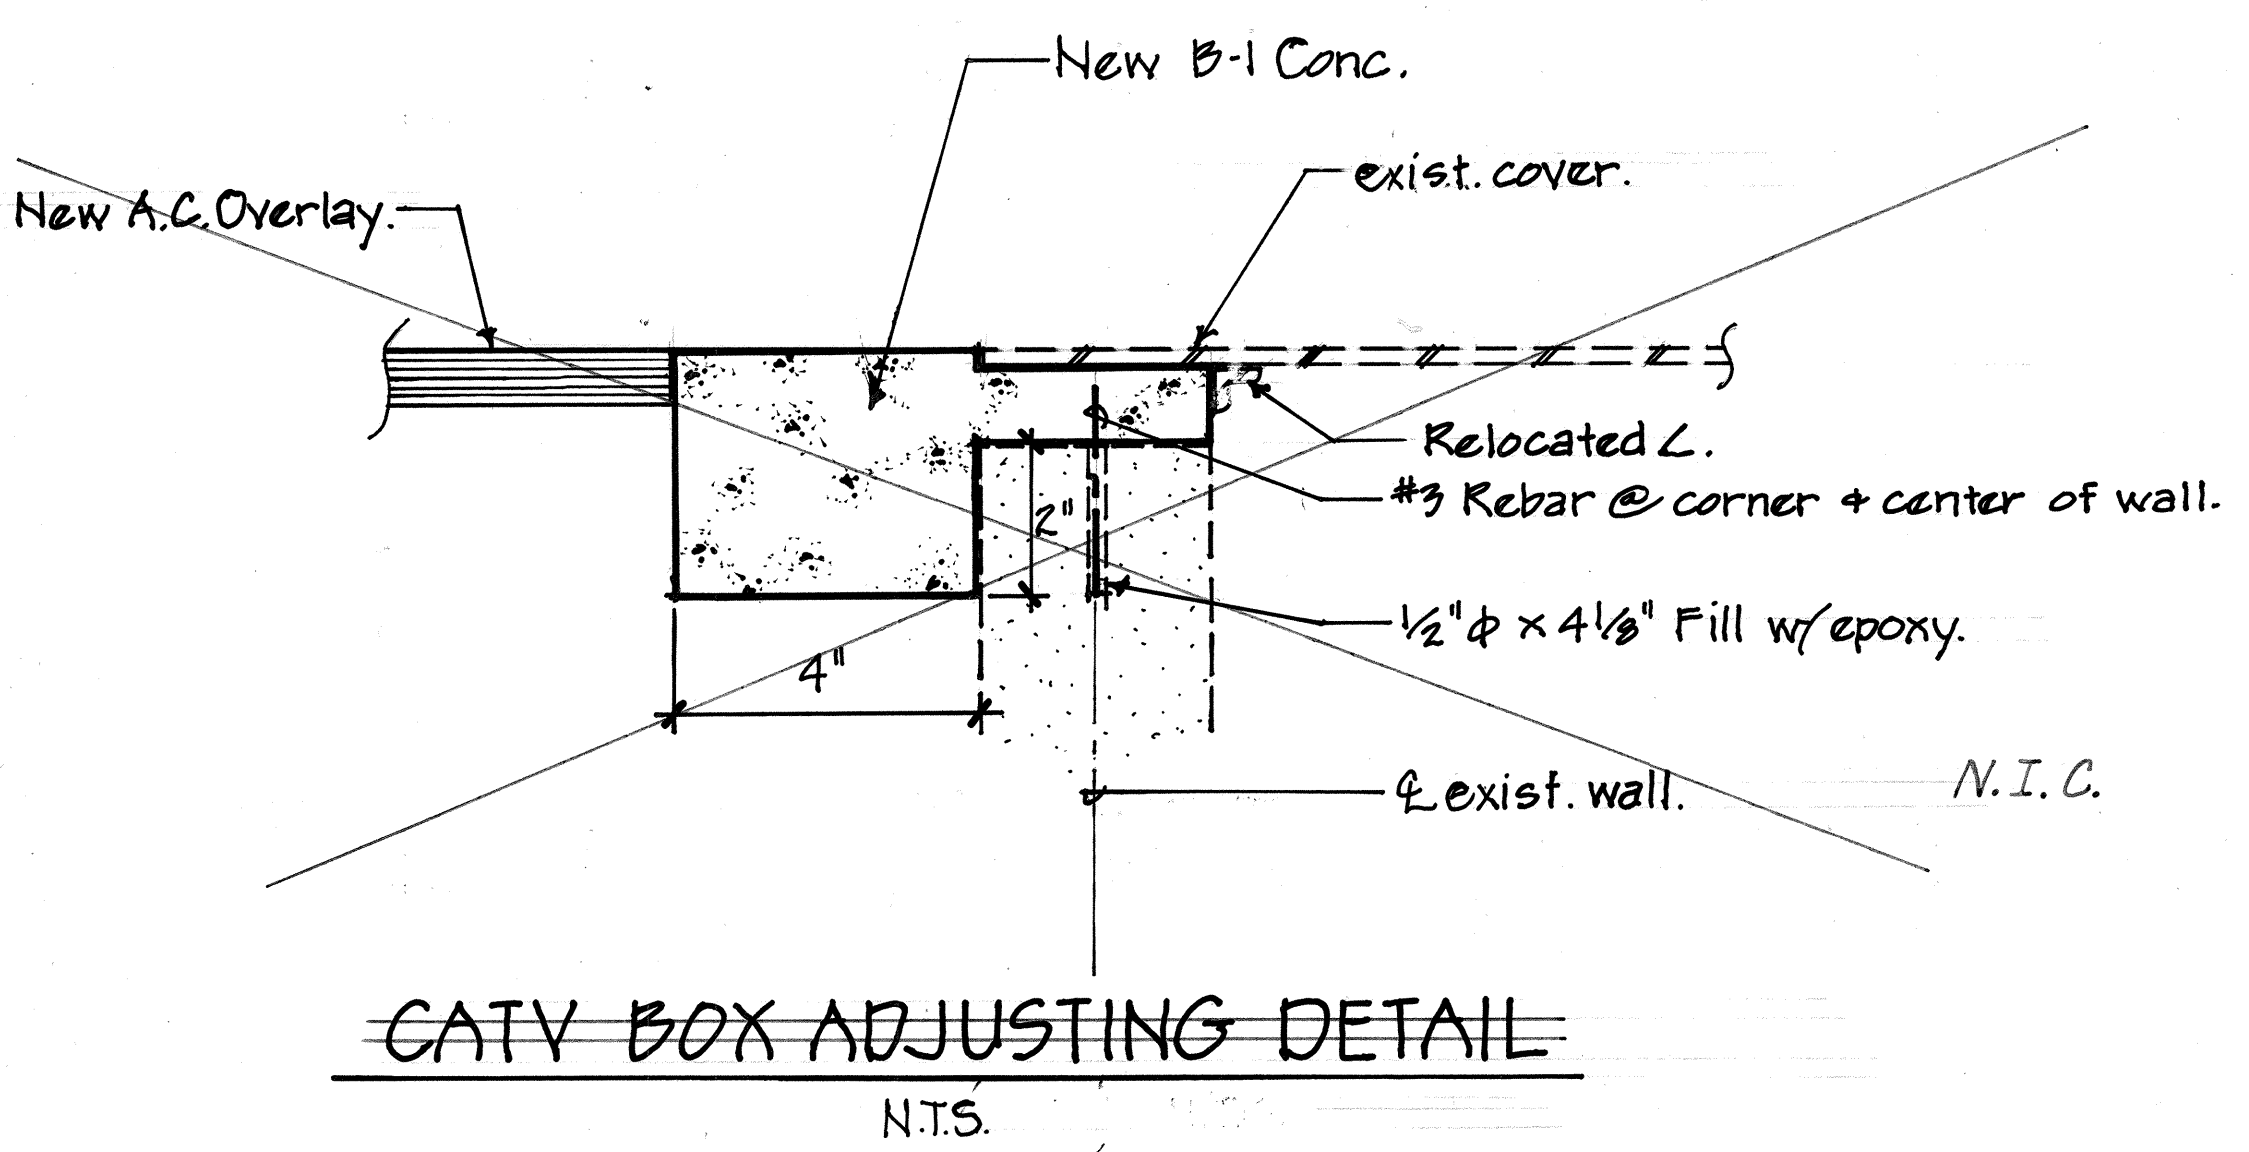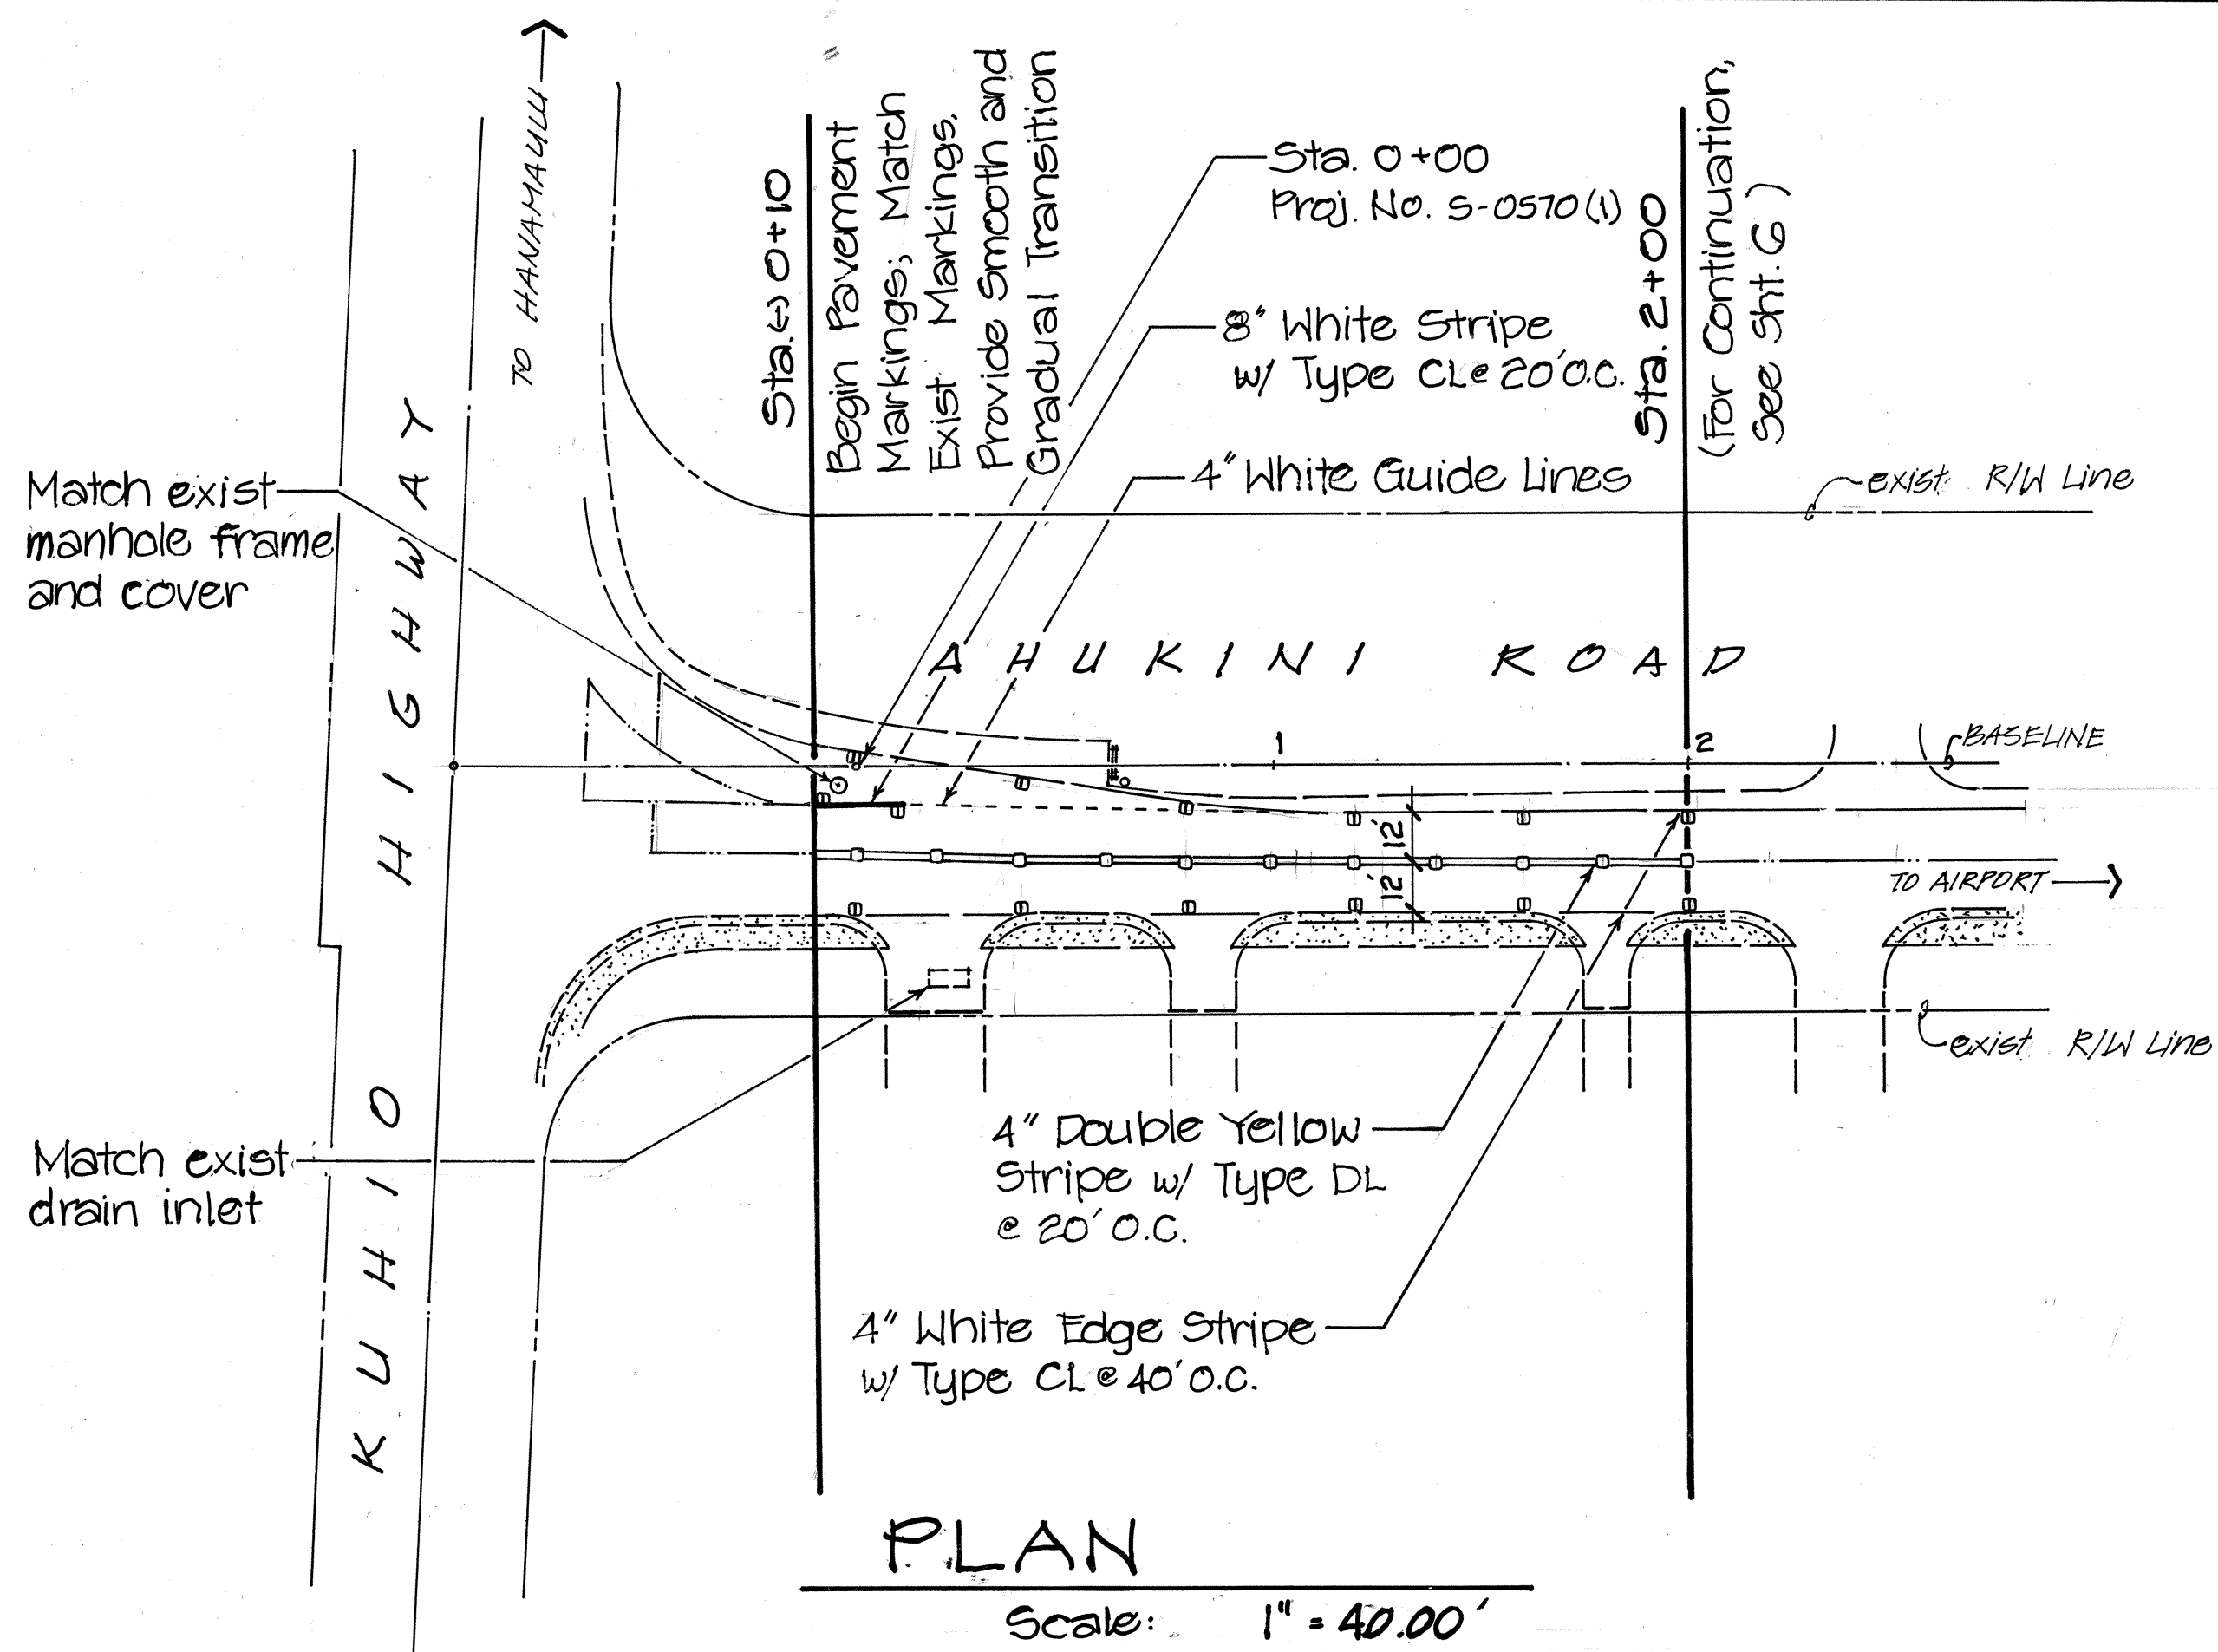

DATE: _____
SURVEY PLOTTED BY: _____
DRAWN BY: _____
CHECKED BY: _____
ORIGINAL PLAN: _____
NOTE BOOK: _____
No. _____