


FED. ROAD DIST. NO.	STATE	PROJ. NO.	FISCAL YEAR	SHEET NO.	TOTAL SHEETS
HAWAII	HAW.	50E-01-92M 51B-01-92M 570A-01-92M	1992	5	14

Curve Data
 $\Delta = 12^\circ 25'$
 $R = 8000.00'$
 $T = 870.26$
 $C = 1730.30$
 $LC = 1733.69$

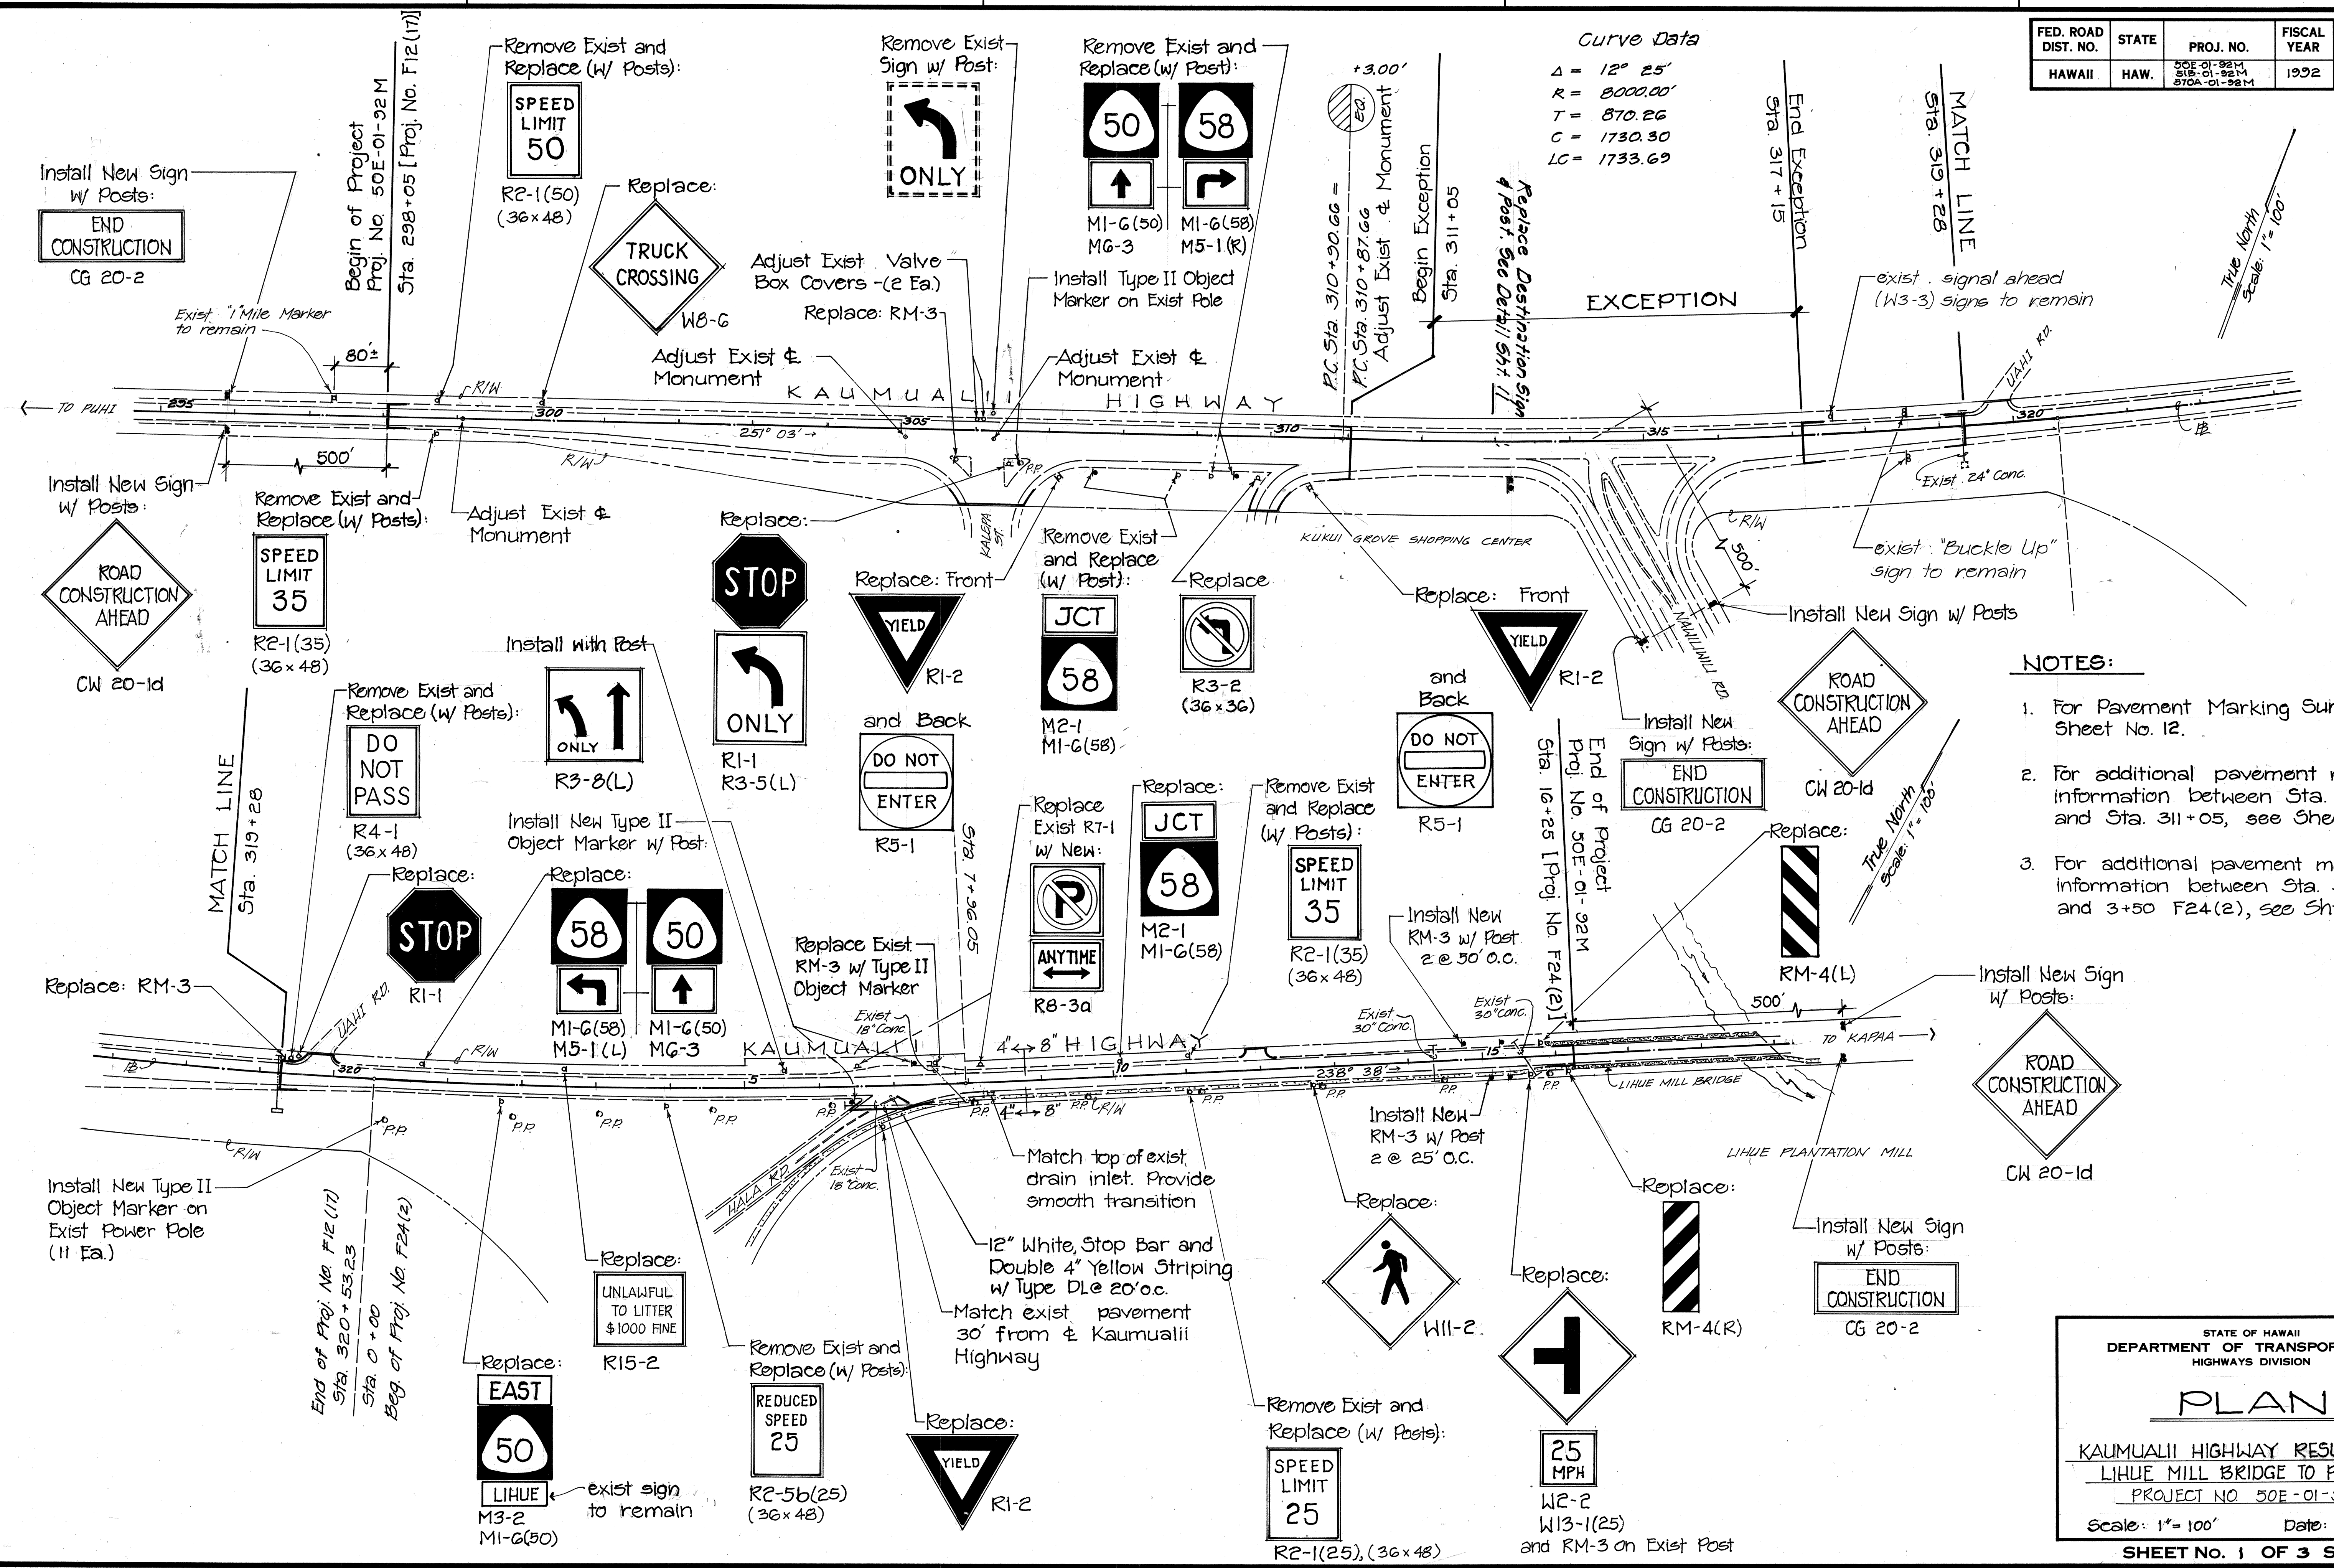

- NOTES:**
1. For Pavement Marking Summary, see Sheet No. 12.
 2. For additional pavement marking information between Sta. 285+05 and Sta. 311+05, see Sheet No. 8.
 3. For additional pavement marking information between Sta. 317+15 and 3+50 F24(2), see Sht. 9.

DATE	_____
SURVEY PLOTTED BY	_____
DRAWN BY	_____
DESIGNED BY	_____
CHECKED BY	_____
ORIGINAL PLAN	_____
NOTE BOOK	_____

STATE OF HAWAII
 DEPARTMENT OF TRANSPORTATION
 HIGHWAYS DIVISION

PLAN

KAUMUALII HIGHWAY RESURFACING
 LIHUE MILL BRIDGE TO PUHI
 PROJECT NO. 50E-01-92M

Scale: 1" = 100' Date: July 1991

SHEET NO. 1 OF 3 SHEETS

FED. ROAD DIST. NO.	STATE	PROJ. NO.	FISCAL YEAR	SHEET NO.	TOTAL SHEETS
HAWAII	HAW.	50A-01-92M 51A-01-92M 51B-01-92M	1992	6	14

Curve Data

$\Delta = 21^\circ 16'$
 $R = 1500.00'$
 $T = 281.62'$
 $C = 553.57'$
 $LC = 556.76'$
 $SE = 0.029 \text{ ft./ft.}$


Curve Data

$\Delta = 20^\circ 21'$
 $R = 1500.00'$
 $T = 270.57'$
 $C = 538.54'$
 $LC = 535.38'$
 $SE = 0.048 \text{ ft./ft.}$

Curve Data

$\Delta = 21^\circ 37'$
 $R = 1500.00'$
 $T = 286.37'$
 $C = 562.57'$
 $LC = 565.92'$
 $SE = 0.068 \text{ ft./ft.}$

Resurface exist a.c. apron. Match top of drain inlet

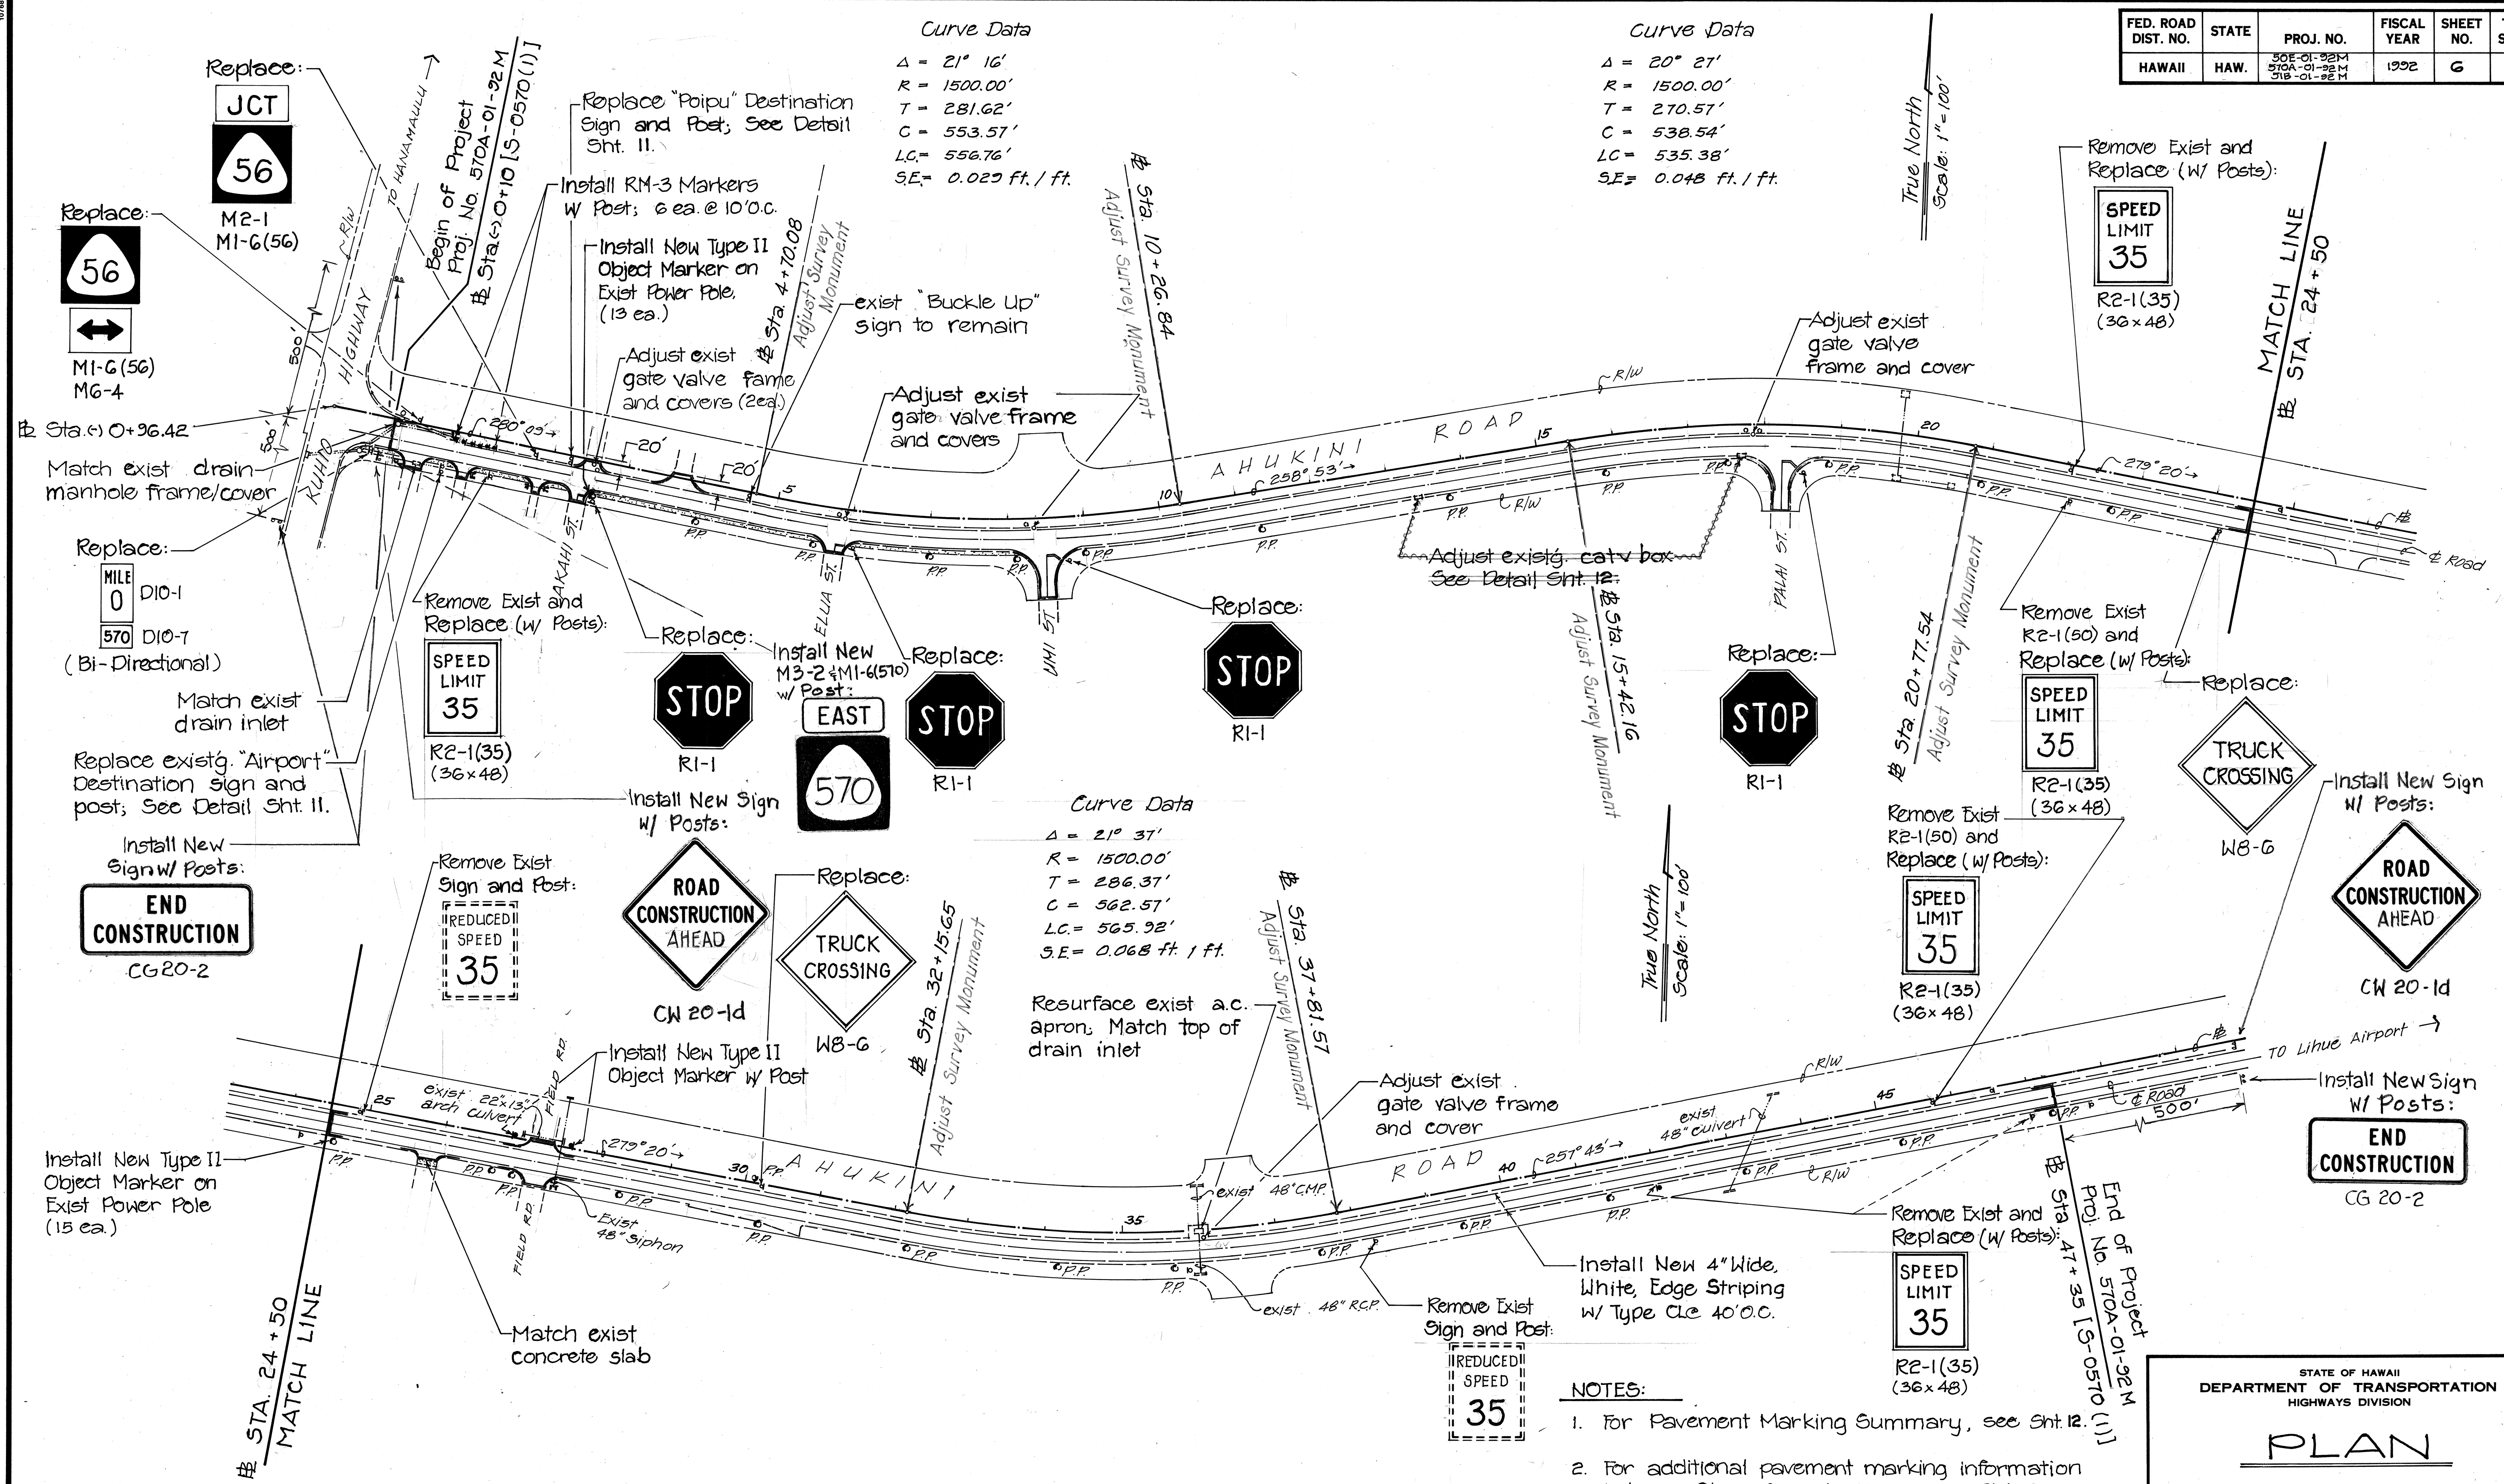

NOTES:

1. For Pavement Marking Summary, see Sht. 12.
2. For additional pavement marking information between Sta. 0+10 to 2+00 see Sht. 12.

STATE OF HAWAII
DEPARTMENT OF TRANSPORTATION
HIGHWAYS DIVISION

PLAN

AHUKINI ROAD RESURFACING
KUHIO HIGHWAY TO KAPULE HIGHWAY
PROJECT NO. 570A-01-92M


Scale: 1"=100' Date: July 1991

SHEET NO. 2 OF 3 SHEETS

AS-BUILT

SURVEY PLOTTED BY	DATE
DRAWN BY	
TRACED BY	
DESIGNED BY	
CHECKED BY	
ORIGINAL PLAN	
NOTE BOOK	
NO.	

FED. ROAD DIST. NO.	STATE	PROJ. NO.	FISCAL YEAR	SHEET NO.	TOTAL SHEETS
HAWAII	HAW.	51B-01-92M 51B-01-92M 51B-01-92M	1992	7	14

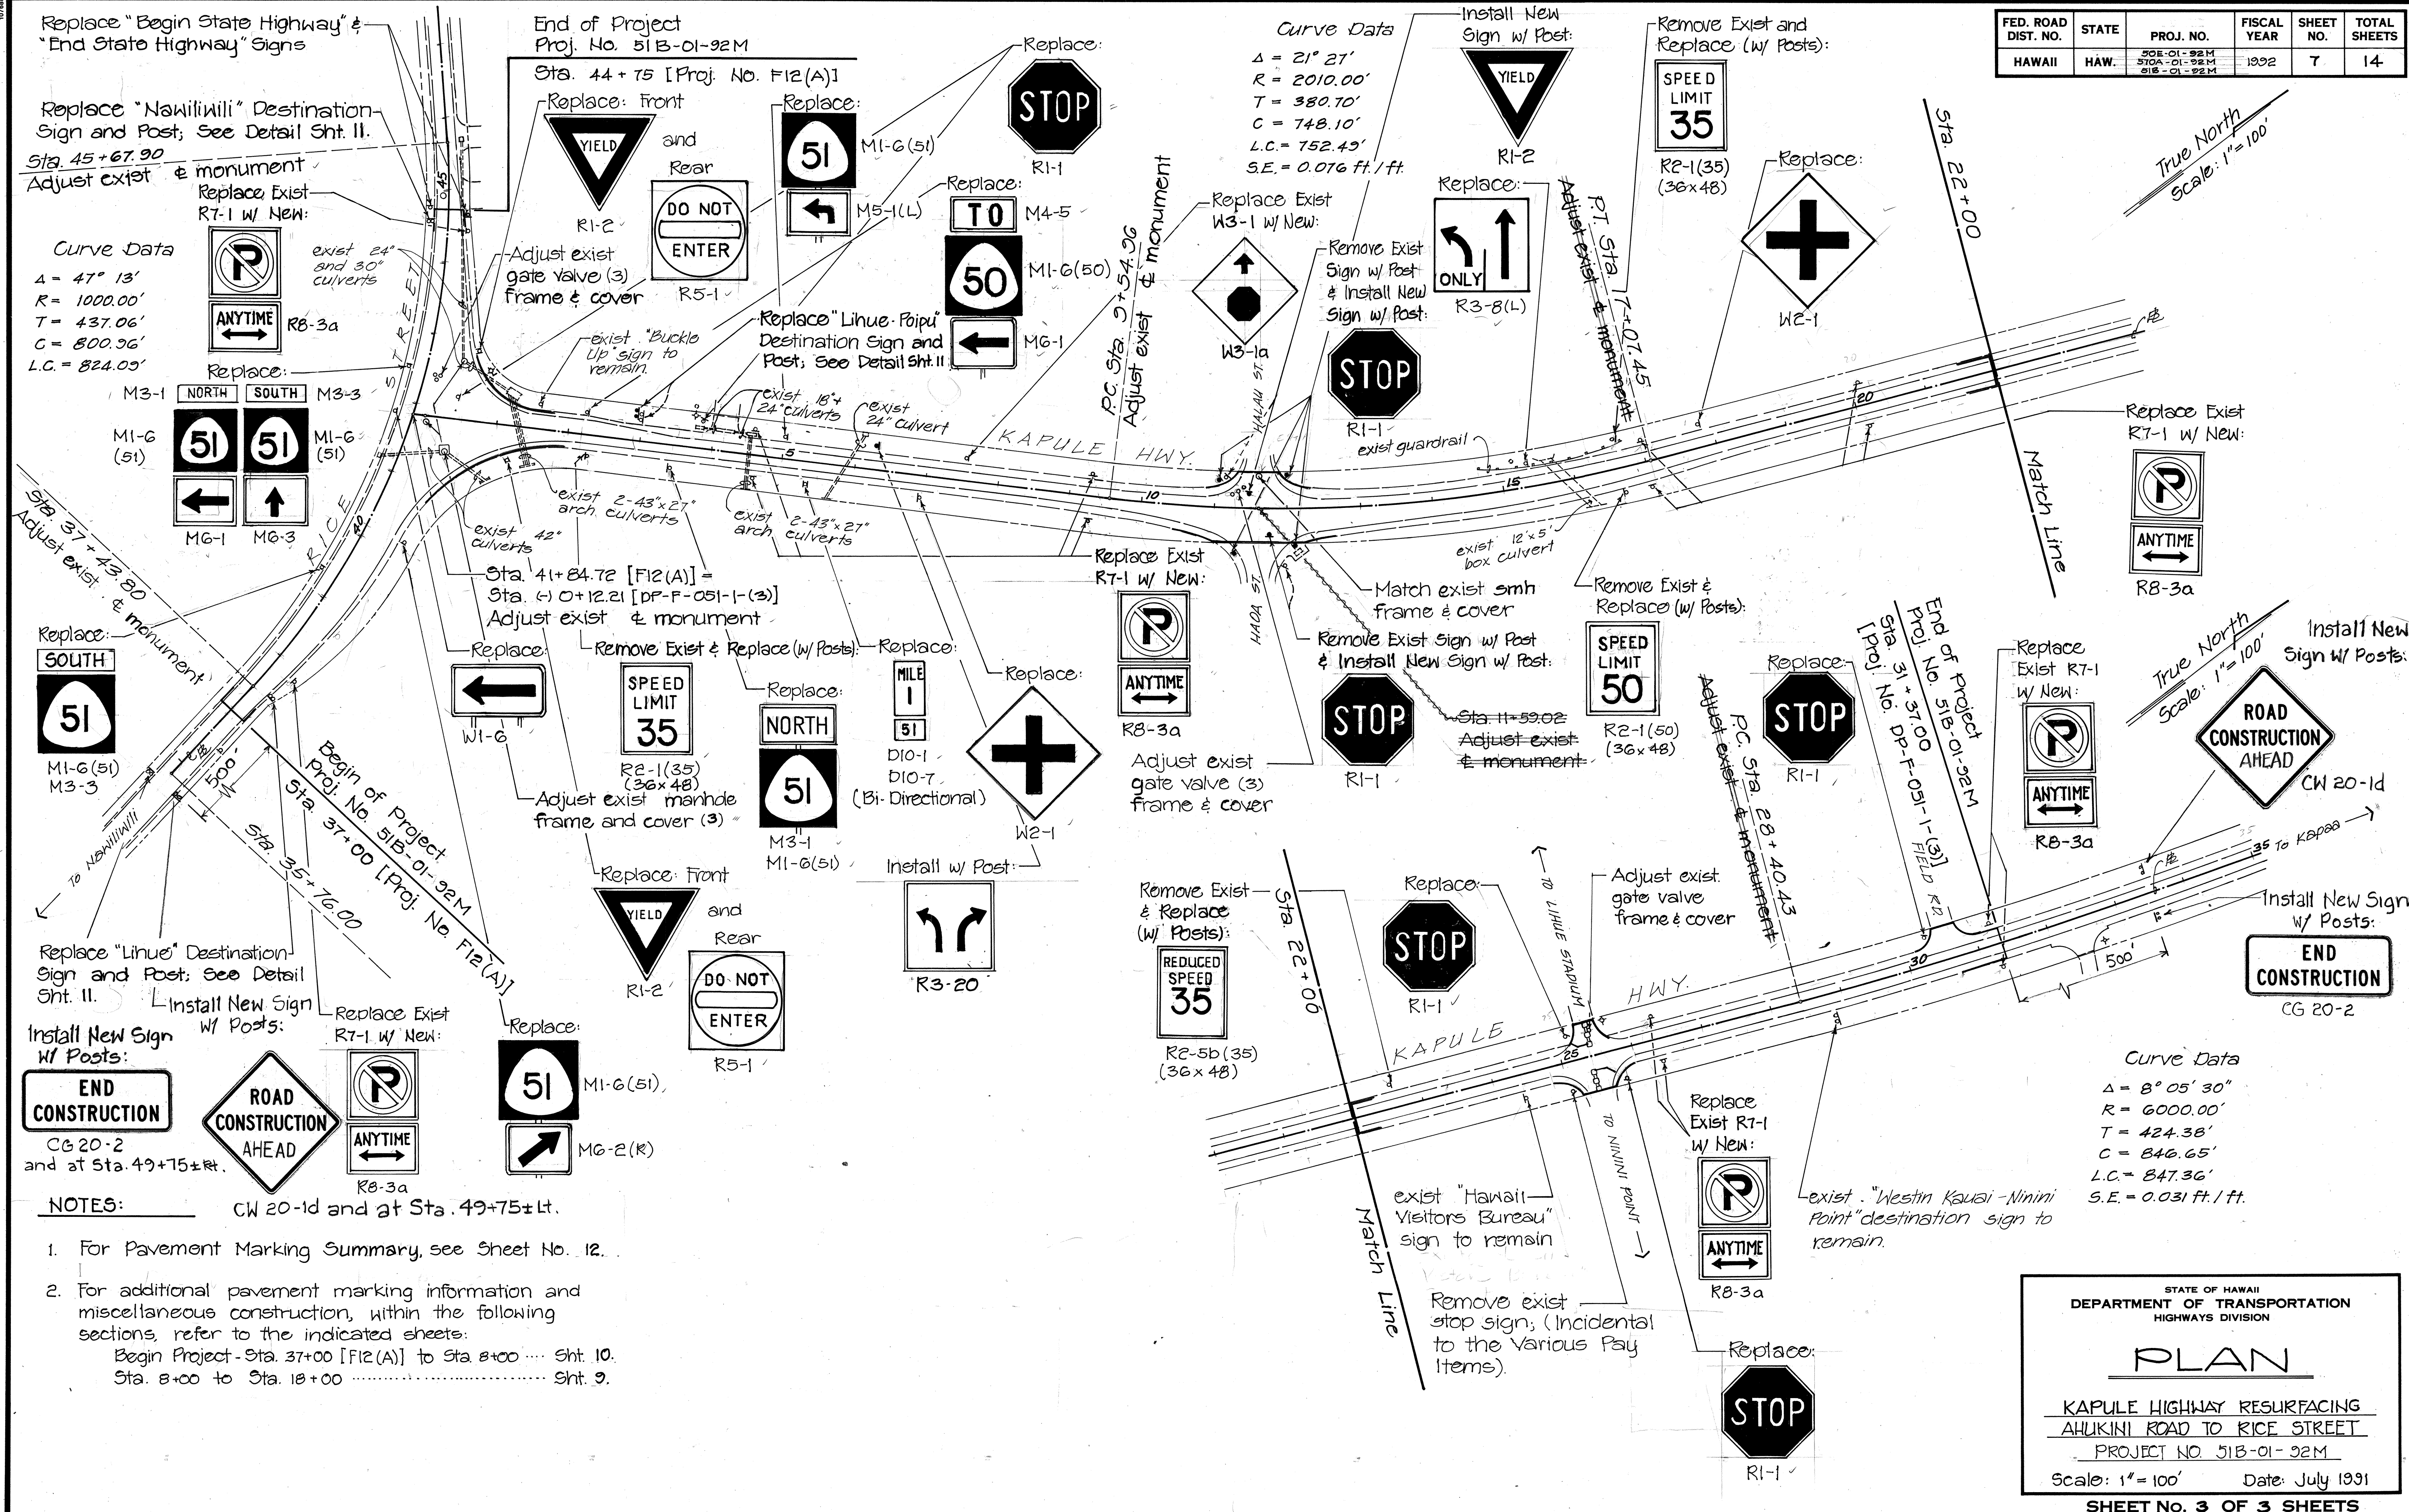

- NOTES:**
- For Pavement Marking Summary, see Sheet No. 12.
 - For additional pavement marking information and miscellaneous construction, within the following sections, refer to the indicated sheets:
 Begin Project - Sta. 37+00 [F12(A)] to Sta. 8+00 Sht. 10.
 Sta. 8+00 to Sta. 18+00 Sht. 9.

STATE OF HAWAII
DEPARTMENT OF TRANSPORTATION
HIGHWAYS DIVISION

PLAN

KAPULE HIGHWAY RESURFACING
AHUKINI ROAD TO RICE STREET
PROJECT NO. 51B-01-92M

Scale: 1" = 100' Date: July 1991

SHEET NO. 3 OF 3 SHEETS

DATE	
SURVEY PLOTTED BY	
DRAWN BY	
DESIGNED BY	
CHECKED BY	
ORIGINAL PLAN	
NOTE BOOK	
NO.	