

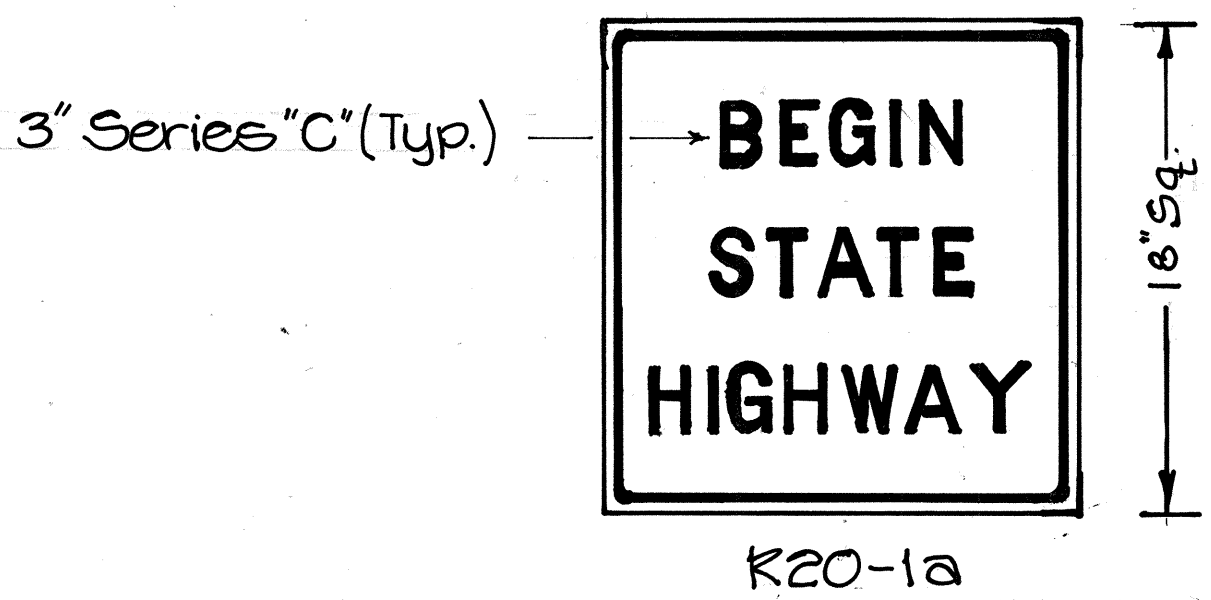
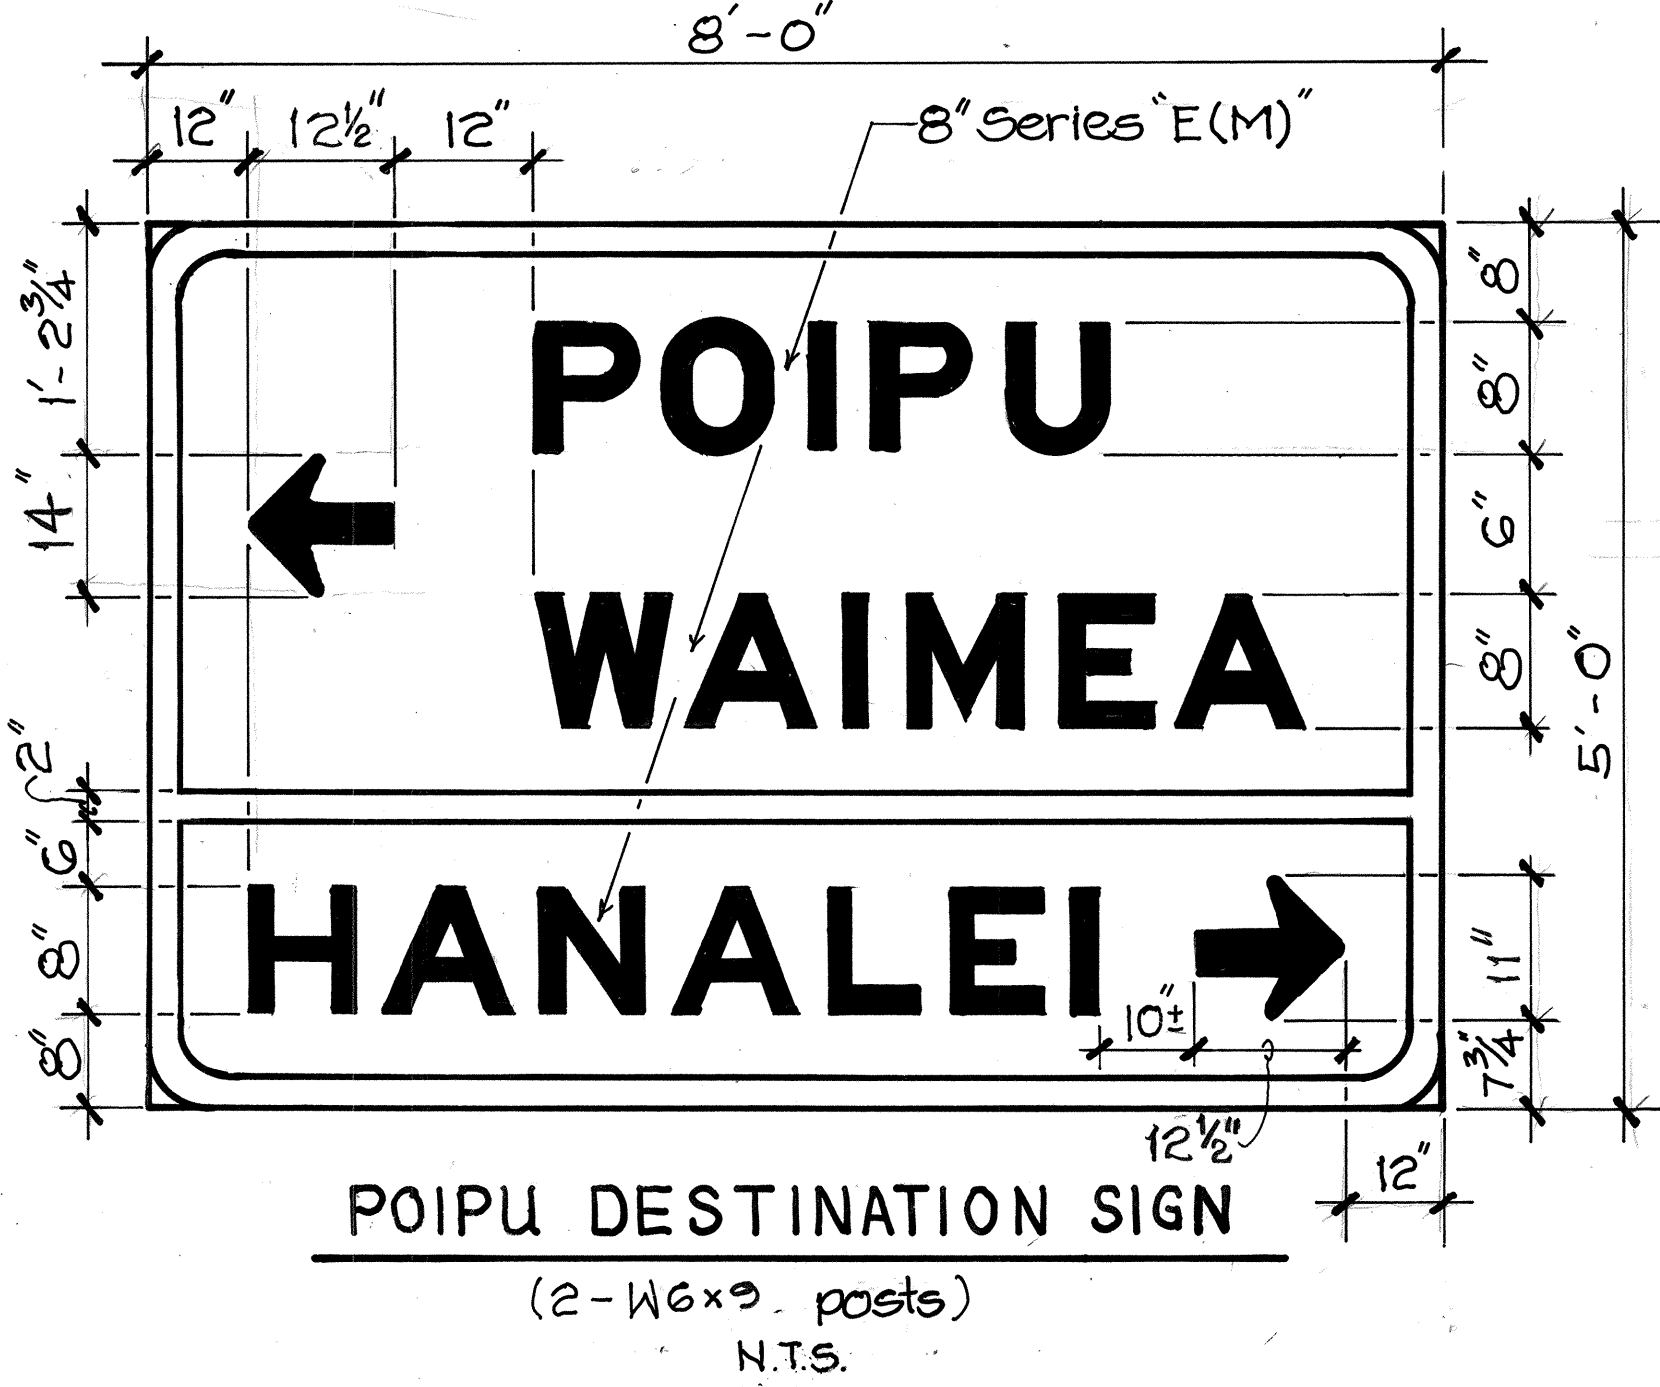
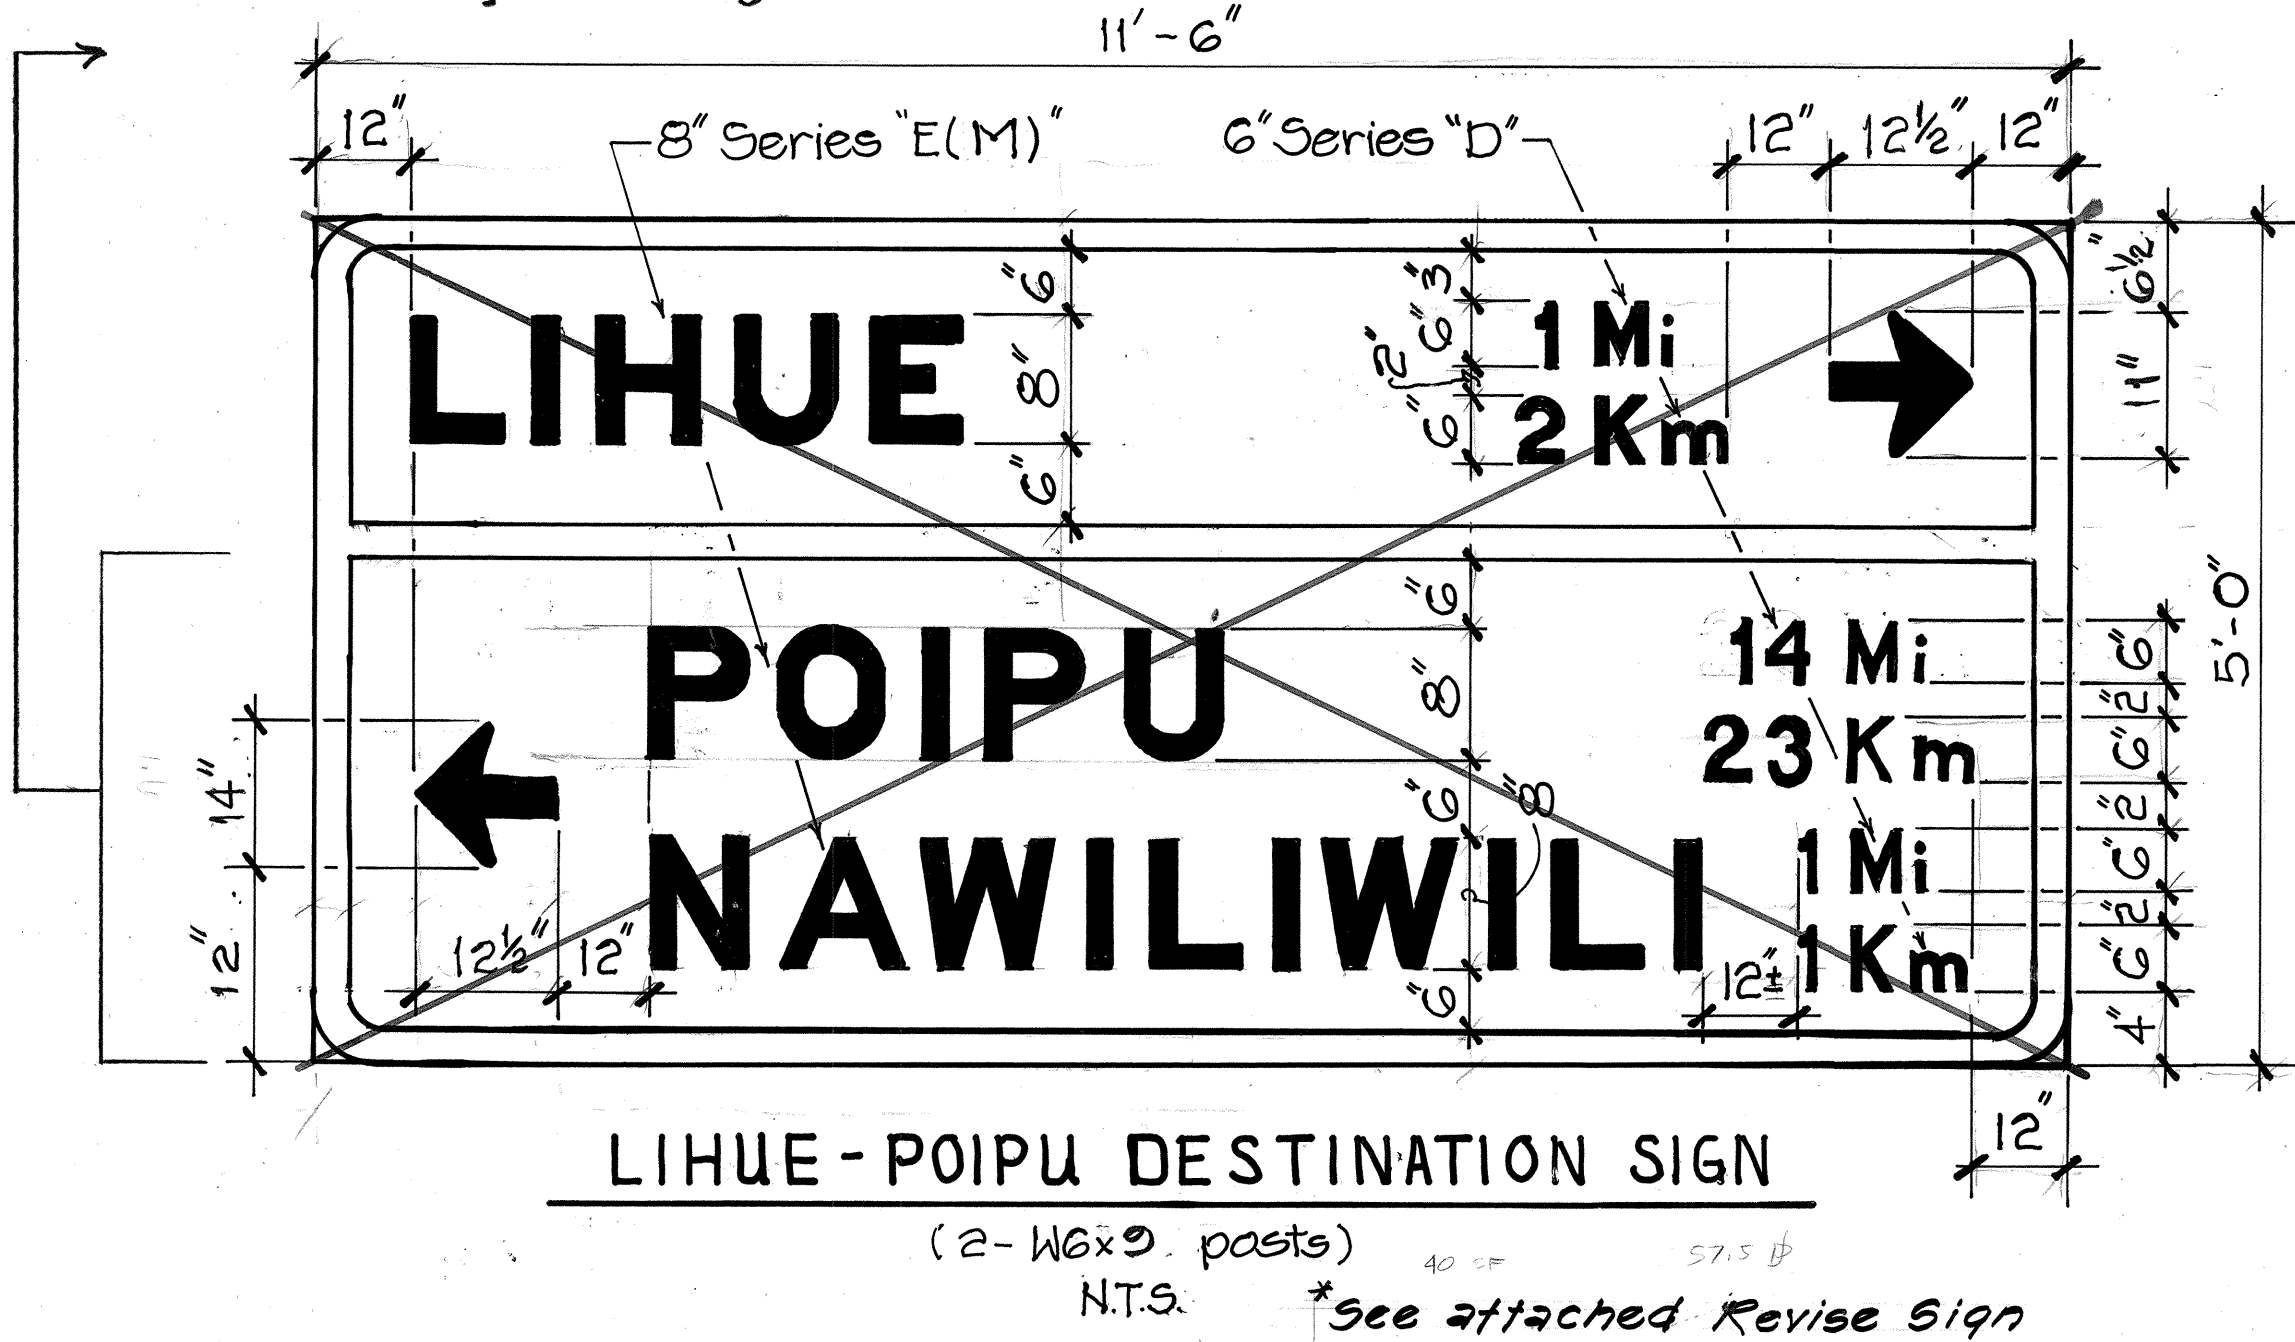
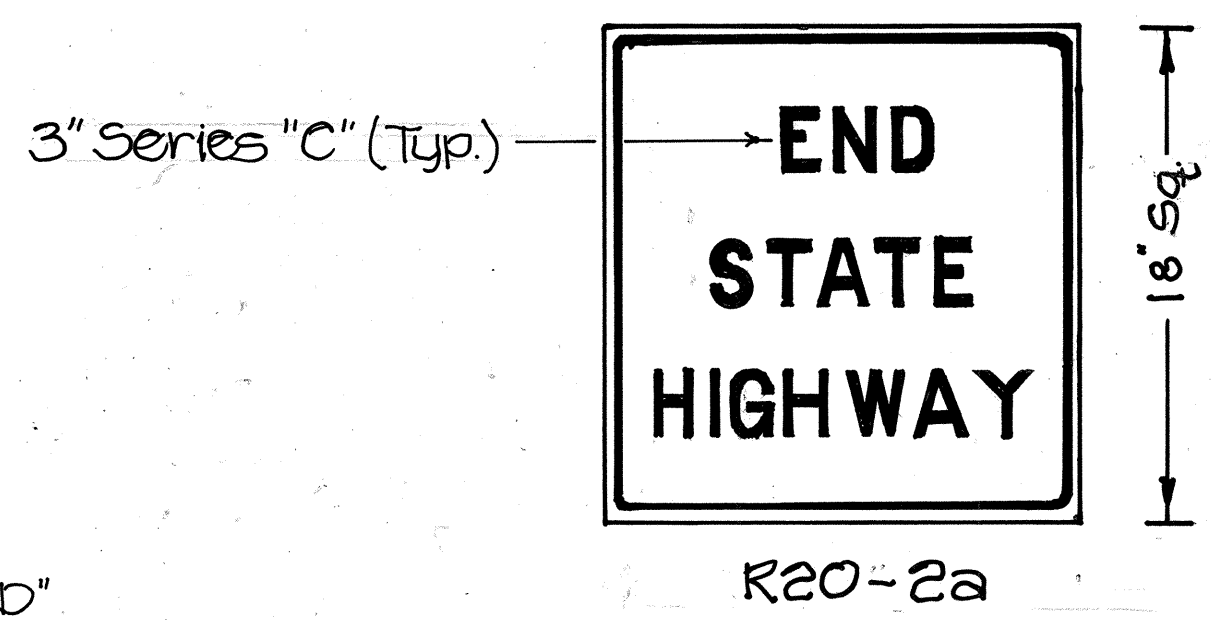


FED. ROAD DIST. NO.	STATE	PROJ. NO.	FISCAL YEAR	SHEET NO.	TOTAL SHEETS
HAWAII	HAW.	50E-01-92M 570A-01-92M 51B-01-92M	1992	11	14



NOTE: Reverse Sign Message

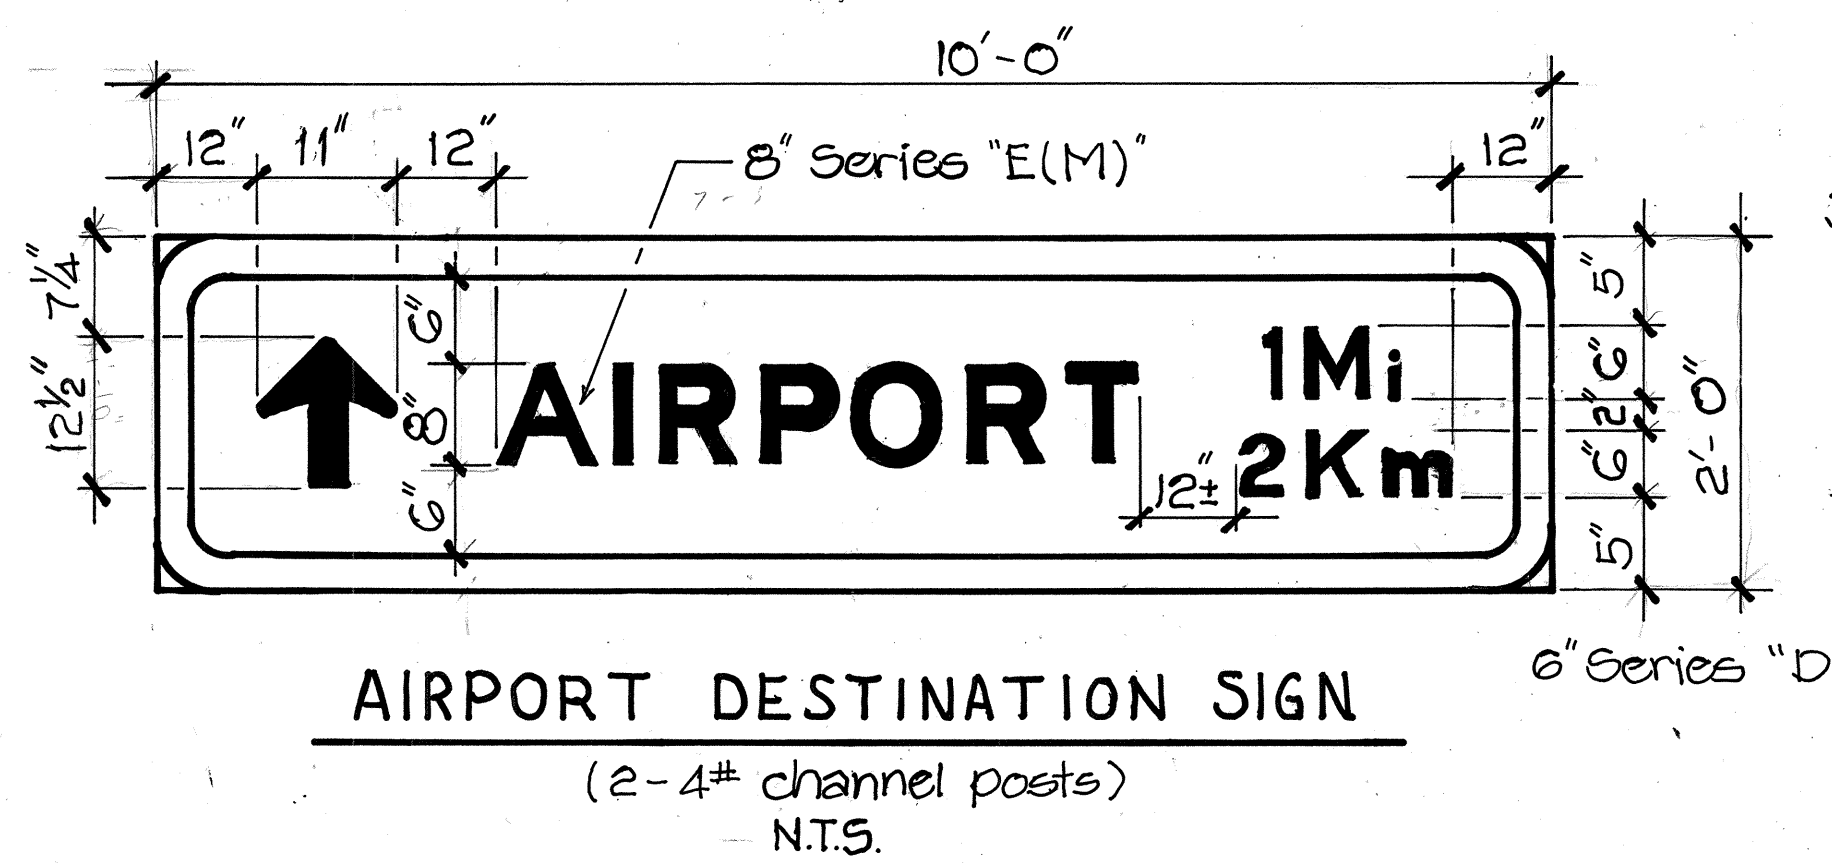

BEGIN STATE HIGHWAY SIGN
N.T.S.

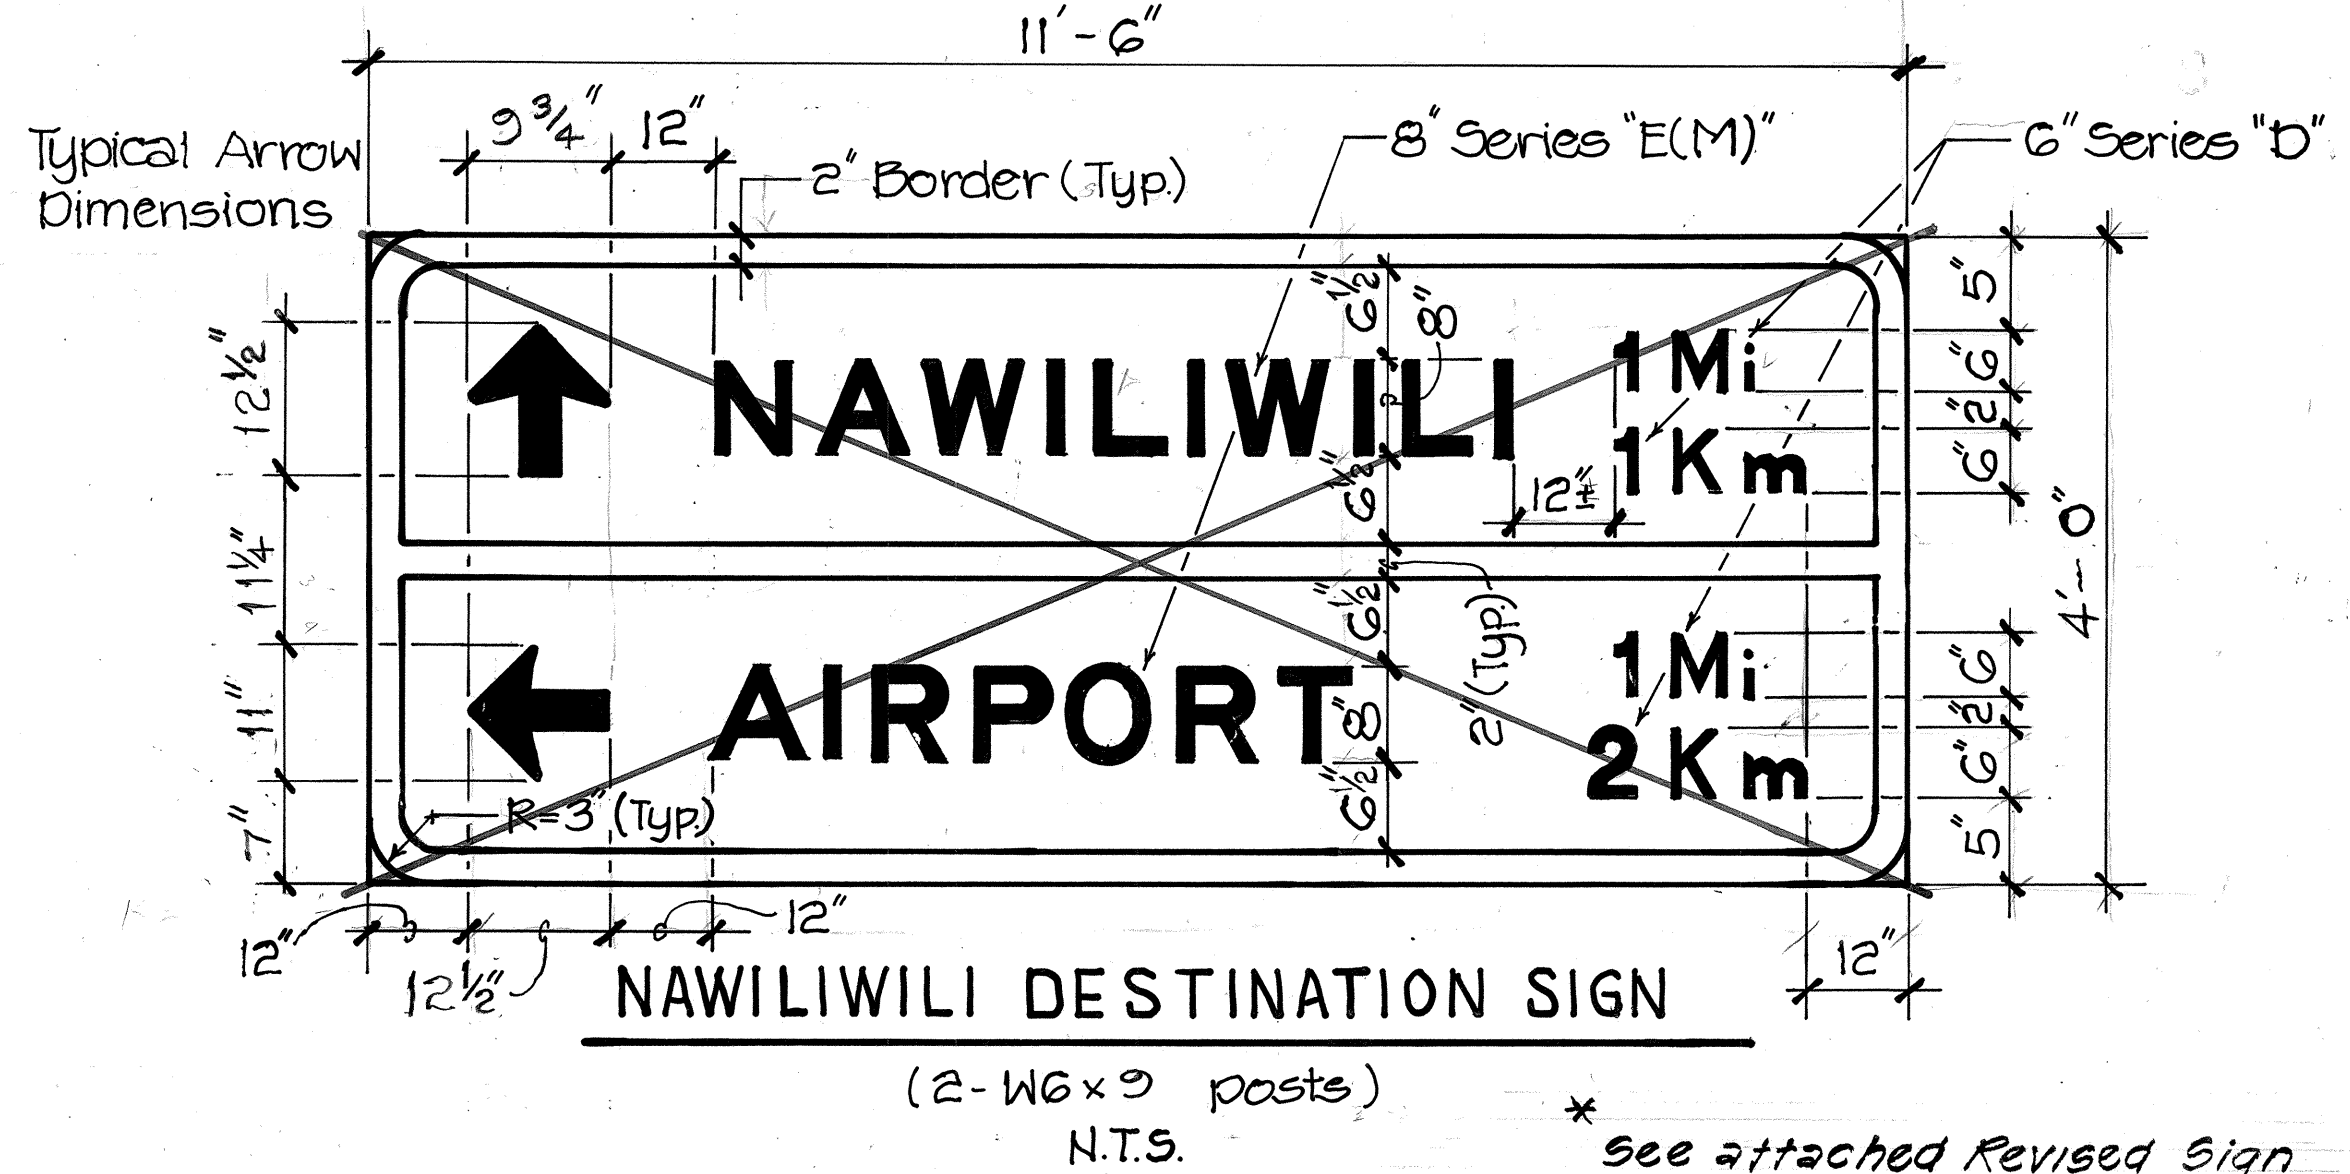

END STATE HIGHWAY SIGN
N.T.S.

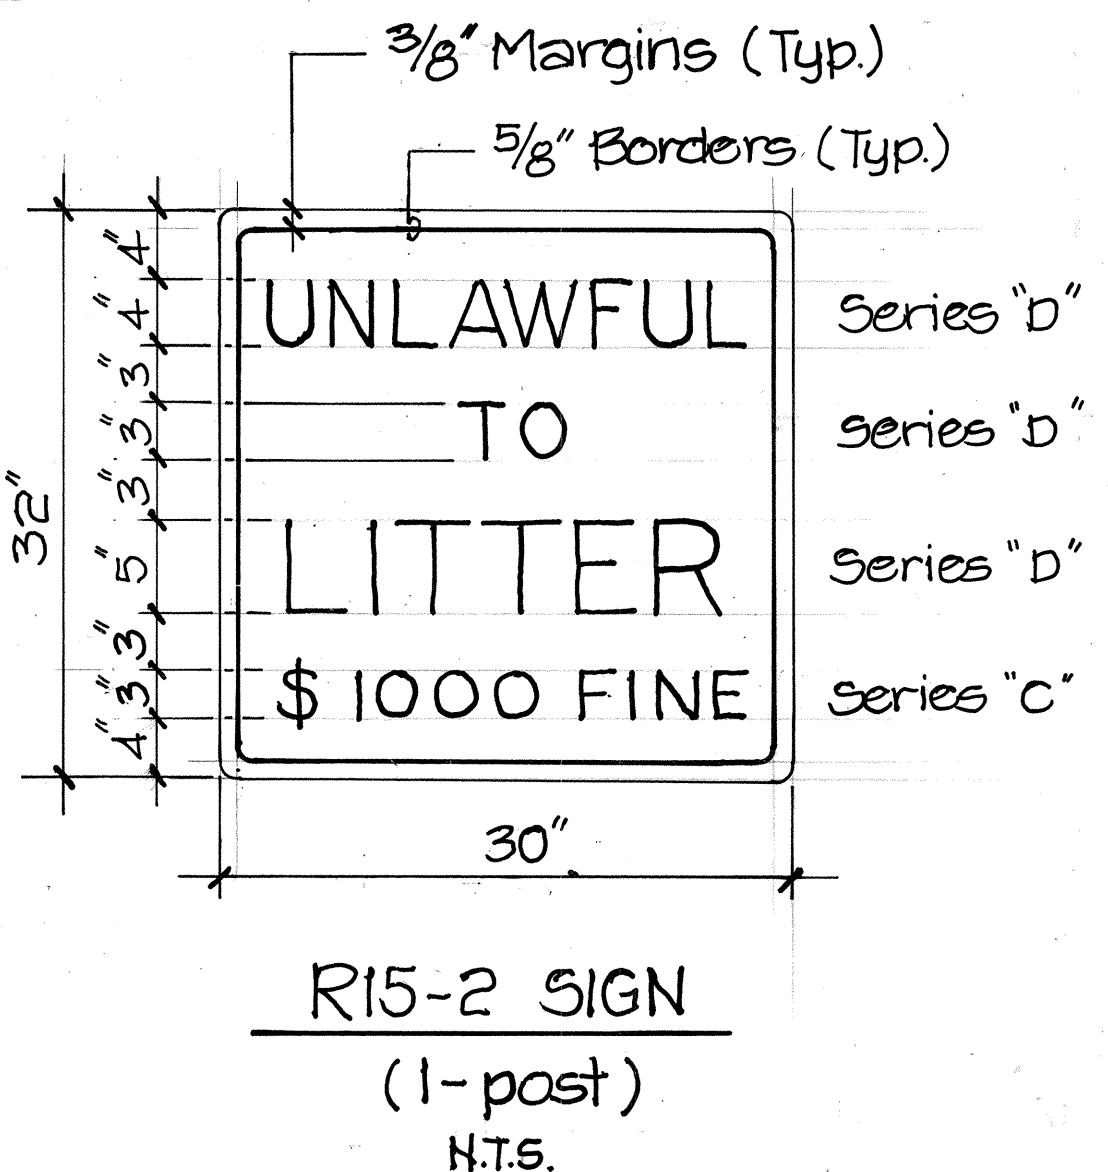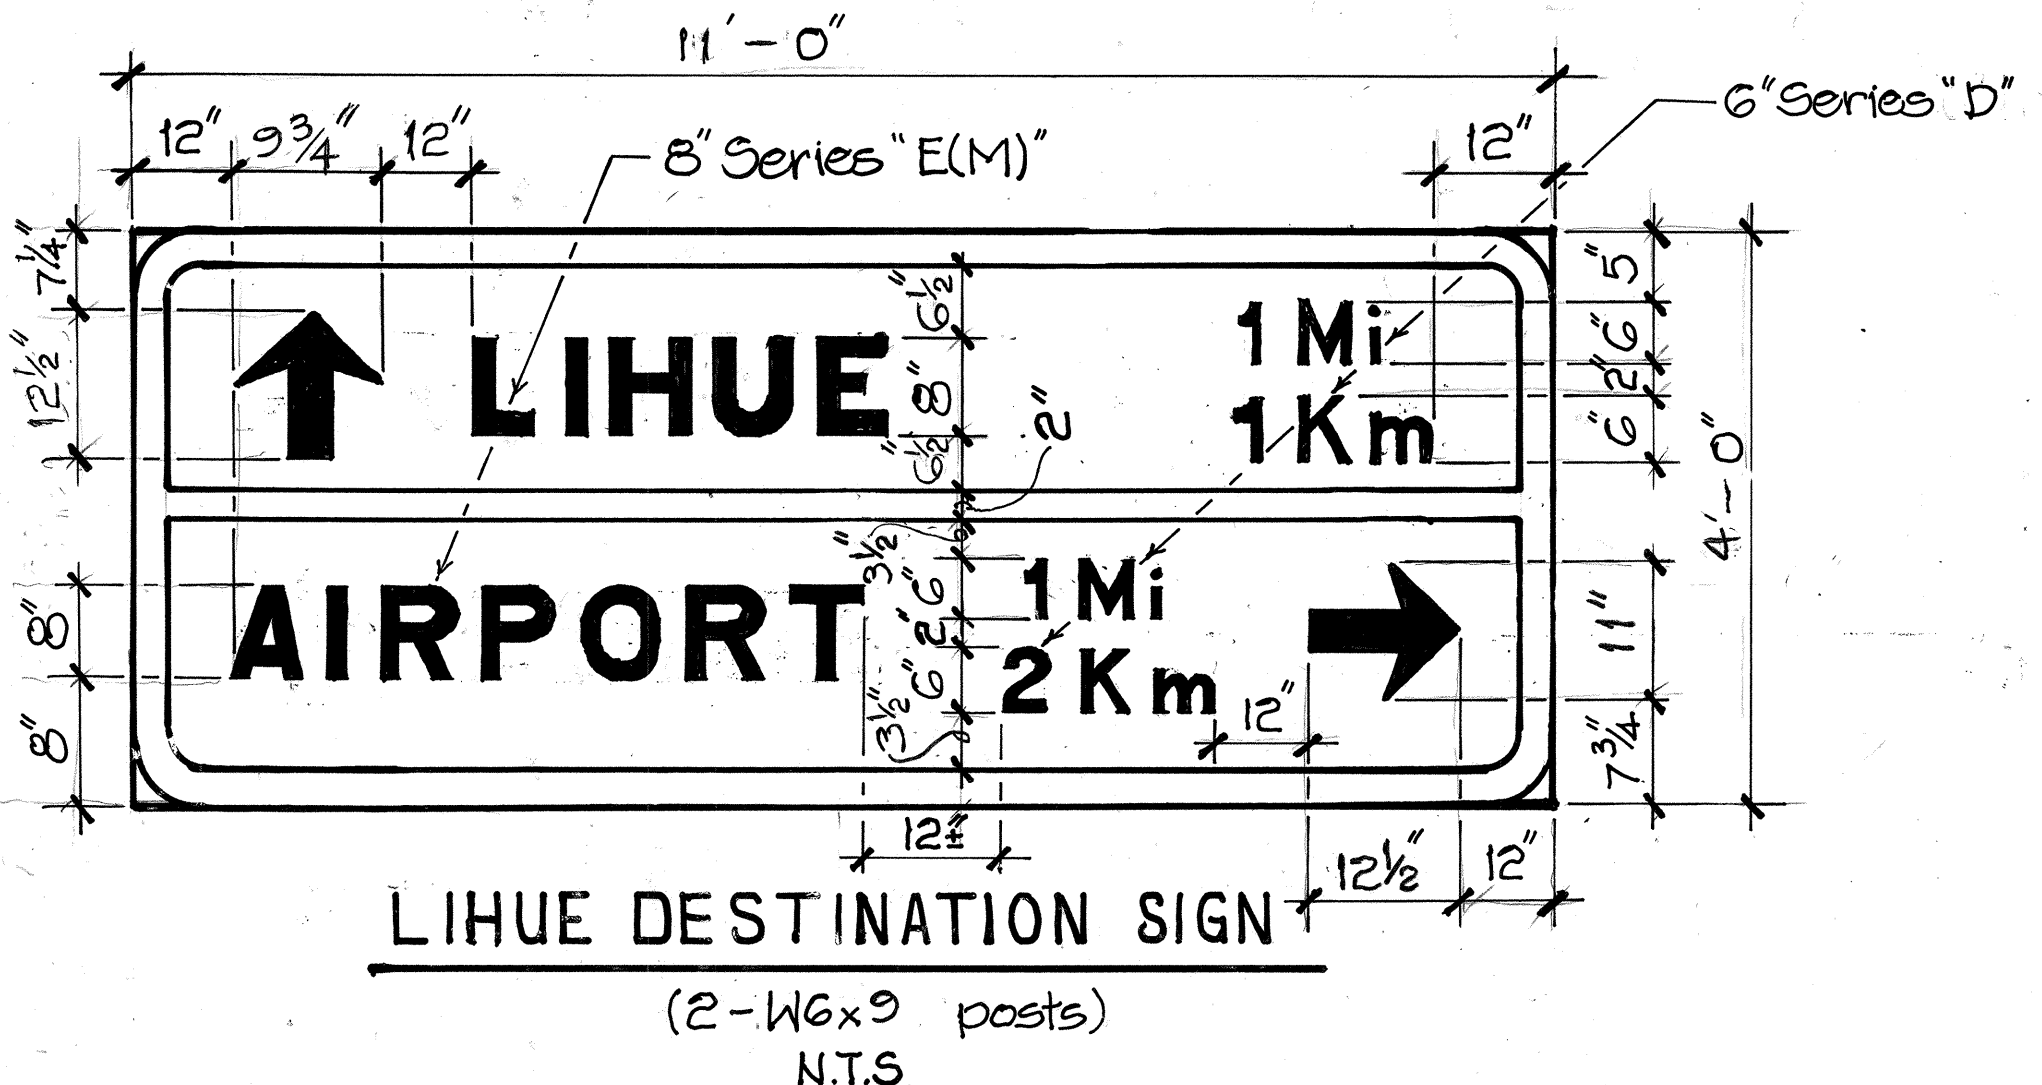

NOTES:

- For typical arrow dimensions, border widths and border radii, for all destination signs, refer to "Nawiliwili Destination Sign" this sheet.
- Refer to Standard Plans TE-02, TE-03, TE-14, and TE-24.
- Unless otherwise noted on the plans all anchor bases for destination signs shall be the breakaway type.

LIHUE-NAWILIWILI DESTINATION SIGN
(2-W6x9 Posts)
*Contract Change Order No. 1(attached)

STATE OF HAWAII
DEPARTMENT OF TRANSPORTATION
HIGHWAYS DIVISION

SIGN DETAILS

KAUMUALII HIGHWAY RESURFACING
PROJECT NO. 50E-01-92M
AHUKINI ROAD RESURFACING
PROJECT NO. 570A-01-92M
KAPULE HIGHWAY RESURFACING
PROJECT NO. 51B-01-92M

Scale: N.T.S.
Date: July 1991

SHEET NO. 1 OF 1 SHEETS

DATE	_____
SURVEY PLOTTED BY	_____
DRAWN BY	_____
TRACED BY	_____
CHECKED BY	_____
ORIGINAL PLAN	_____
NOTE BOOK	_____
No.	_____

