

INDEX TO DRAWINGS	
SHEET NO.	DESCRIPTION
1	TITLE SHEET
2	STANDARD PLAN SUMMARY
3	GENERAL NOTES
4	TYP. PLANS, SECTIONS, & DETAILS
5-7	PLAN
8-10	PAVEMENT MARKING PLAN
①11	SIGN DETAILS
12	PAVEMENT MARKING PLAN & SUMMARY, MISC. DETAILS
13	ROUTE MARKER SUMMARY
14	SUMMARIES & ESTIMATED QUANTITIES

Plan Sht. No. ①11S-1, is a supplementary sheet to this project.
TOTAL SHEET COUNT after "AS-BUILT" postings.
15 Sheets.

CHANGES MADE DURING CONSTRUCTION HAVE BEEN INCORPORATED ON THESE PLANS EXCEPT CHANGES IN THE ORIGINAL THEORETICAL QUANTITIES. FOR ACTUAL QUANTITIES, REFER TO PROJECT LEDGER AND/OR COMPUTATION BOOK.

Douglas H. Mada
RESIDENT ENGINEER

12/4/95
DATE

STATE OF HAWAII
DEPARTMENT OF TRANSPORTATION
HIGHWAYS DIVISION
HONOLULU, HAWAII

"AS-BUILT"

PLANS FOR

KAUMUALII HIGHWAY RESURFACING
LIHUE MILL BRIDGE TO PUHI
PROJECT NO. 50E-01-92M

AND





AHUKINI ROAD RESURFACING
KUHIO HIGHWAY TO KAPULE HIGHWAY
PROJECT NO. 570A-01-92M

AND


KAPULE HIGHWAY RESURFACING
AHUKINI ROAD TO RICE STREET
PROJECT NO. 51B-01-92M

DISTRICT OF LIHUE
ISLAND OF KAUAI


FED. ROAD DIST. NO.	STATE	PROJ. NO.	FISCAL YEAR	SHEET NO.	TOTAL SHEETS
HAWAII	HAW.	570A-01-92M 51B-01-92M 50E-01-92M	1992	1	14

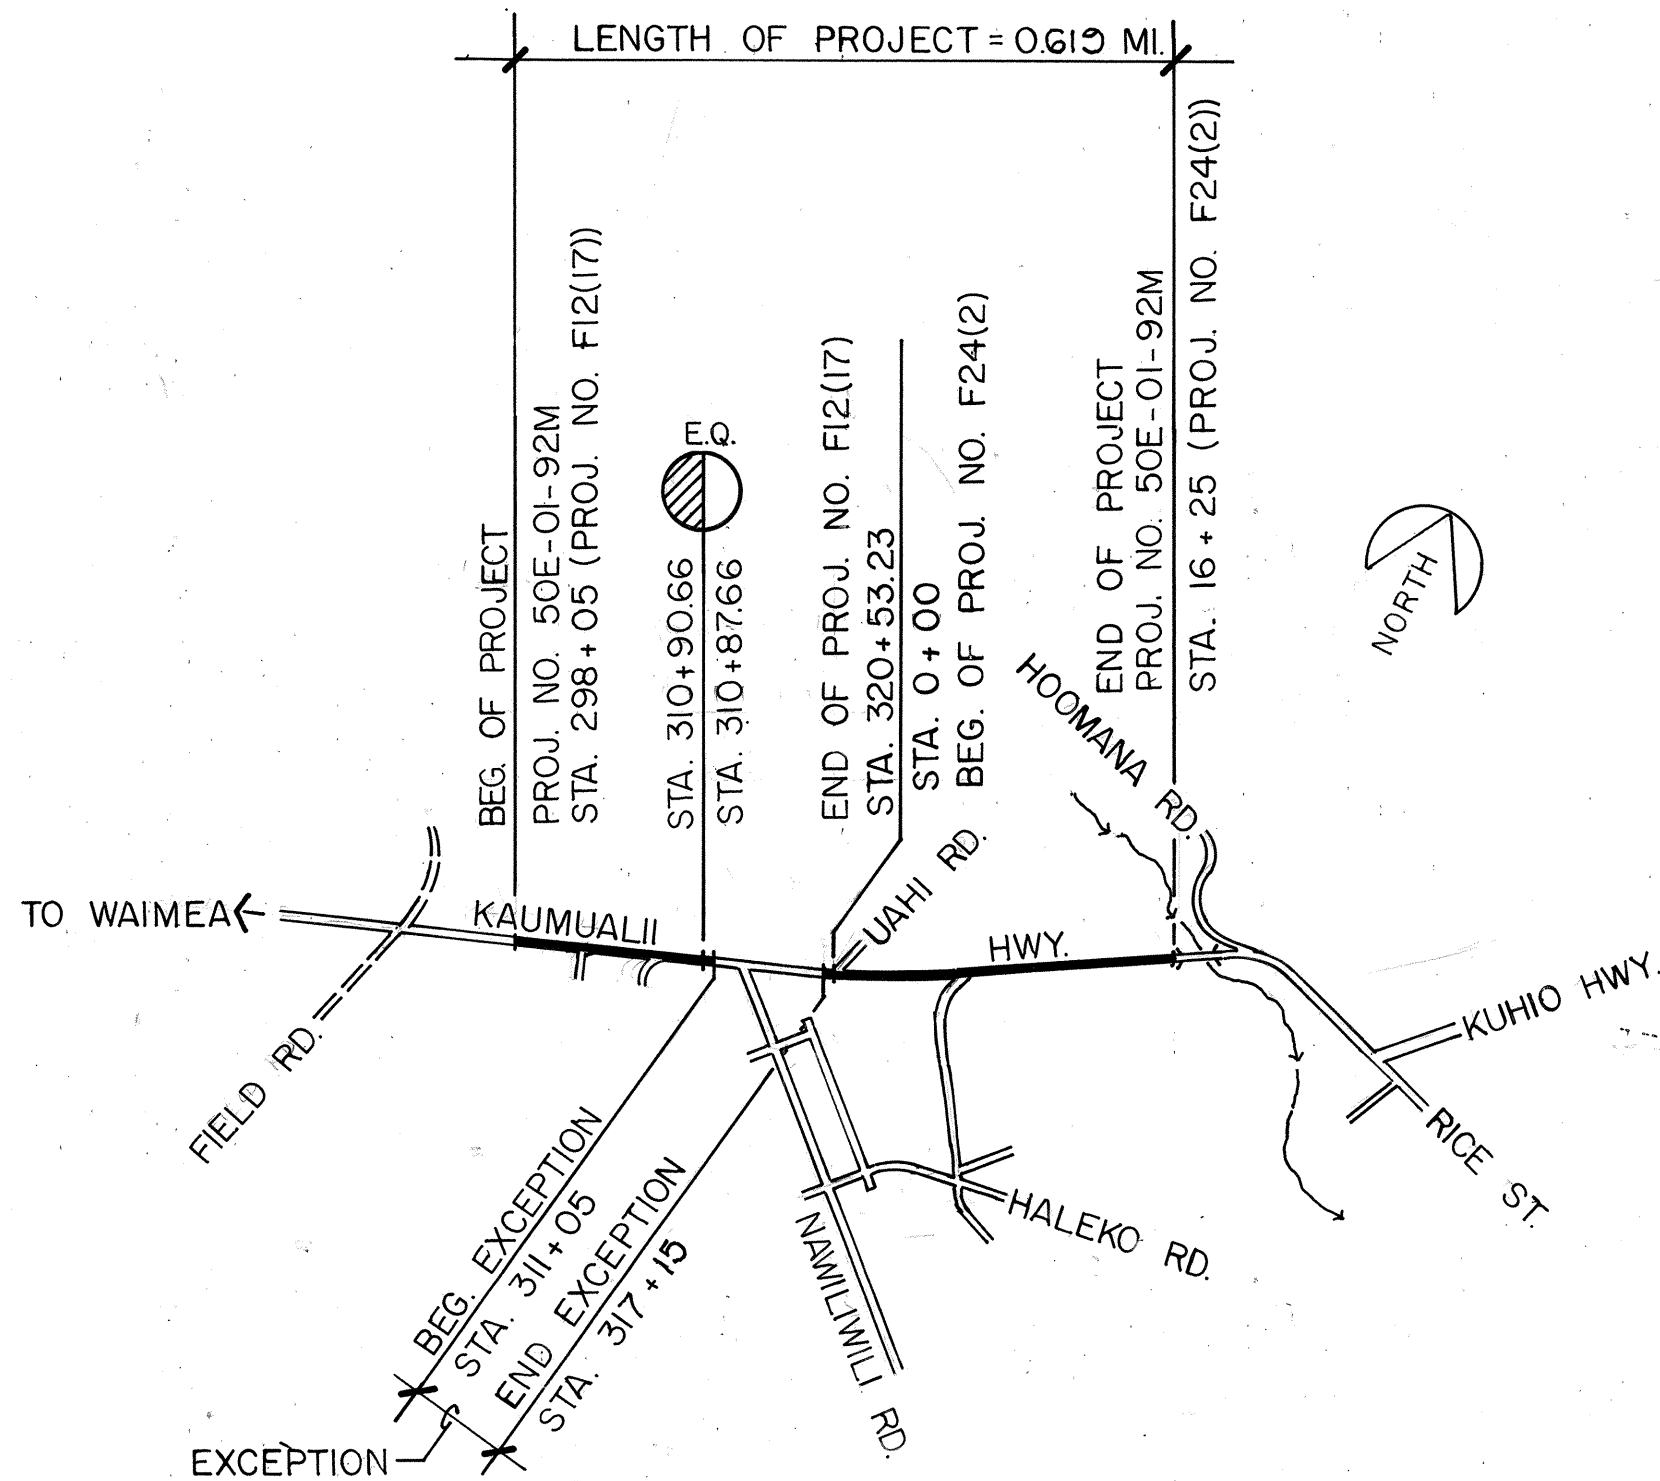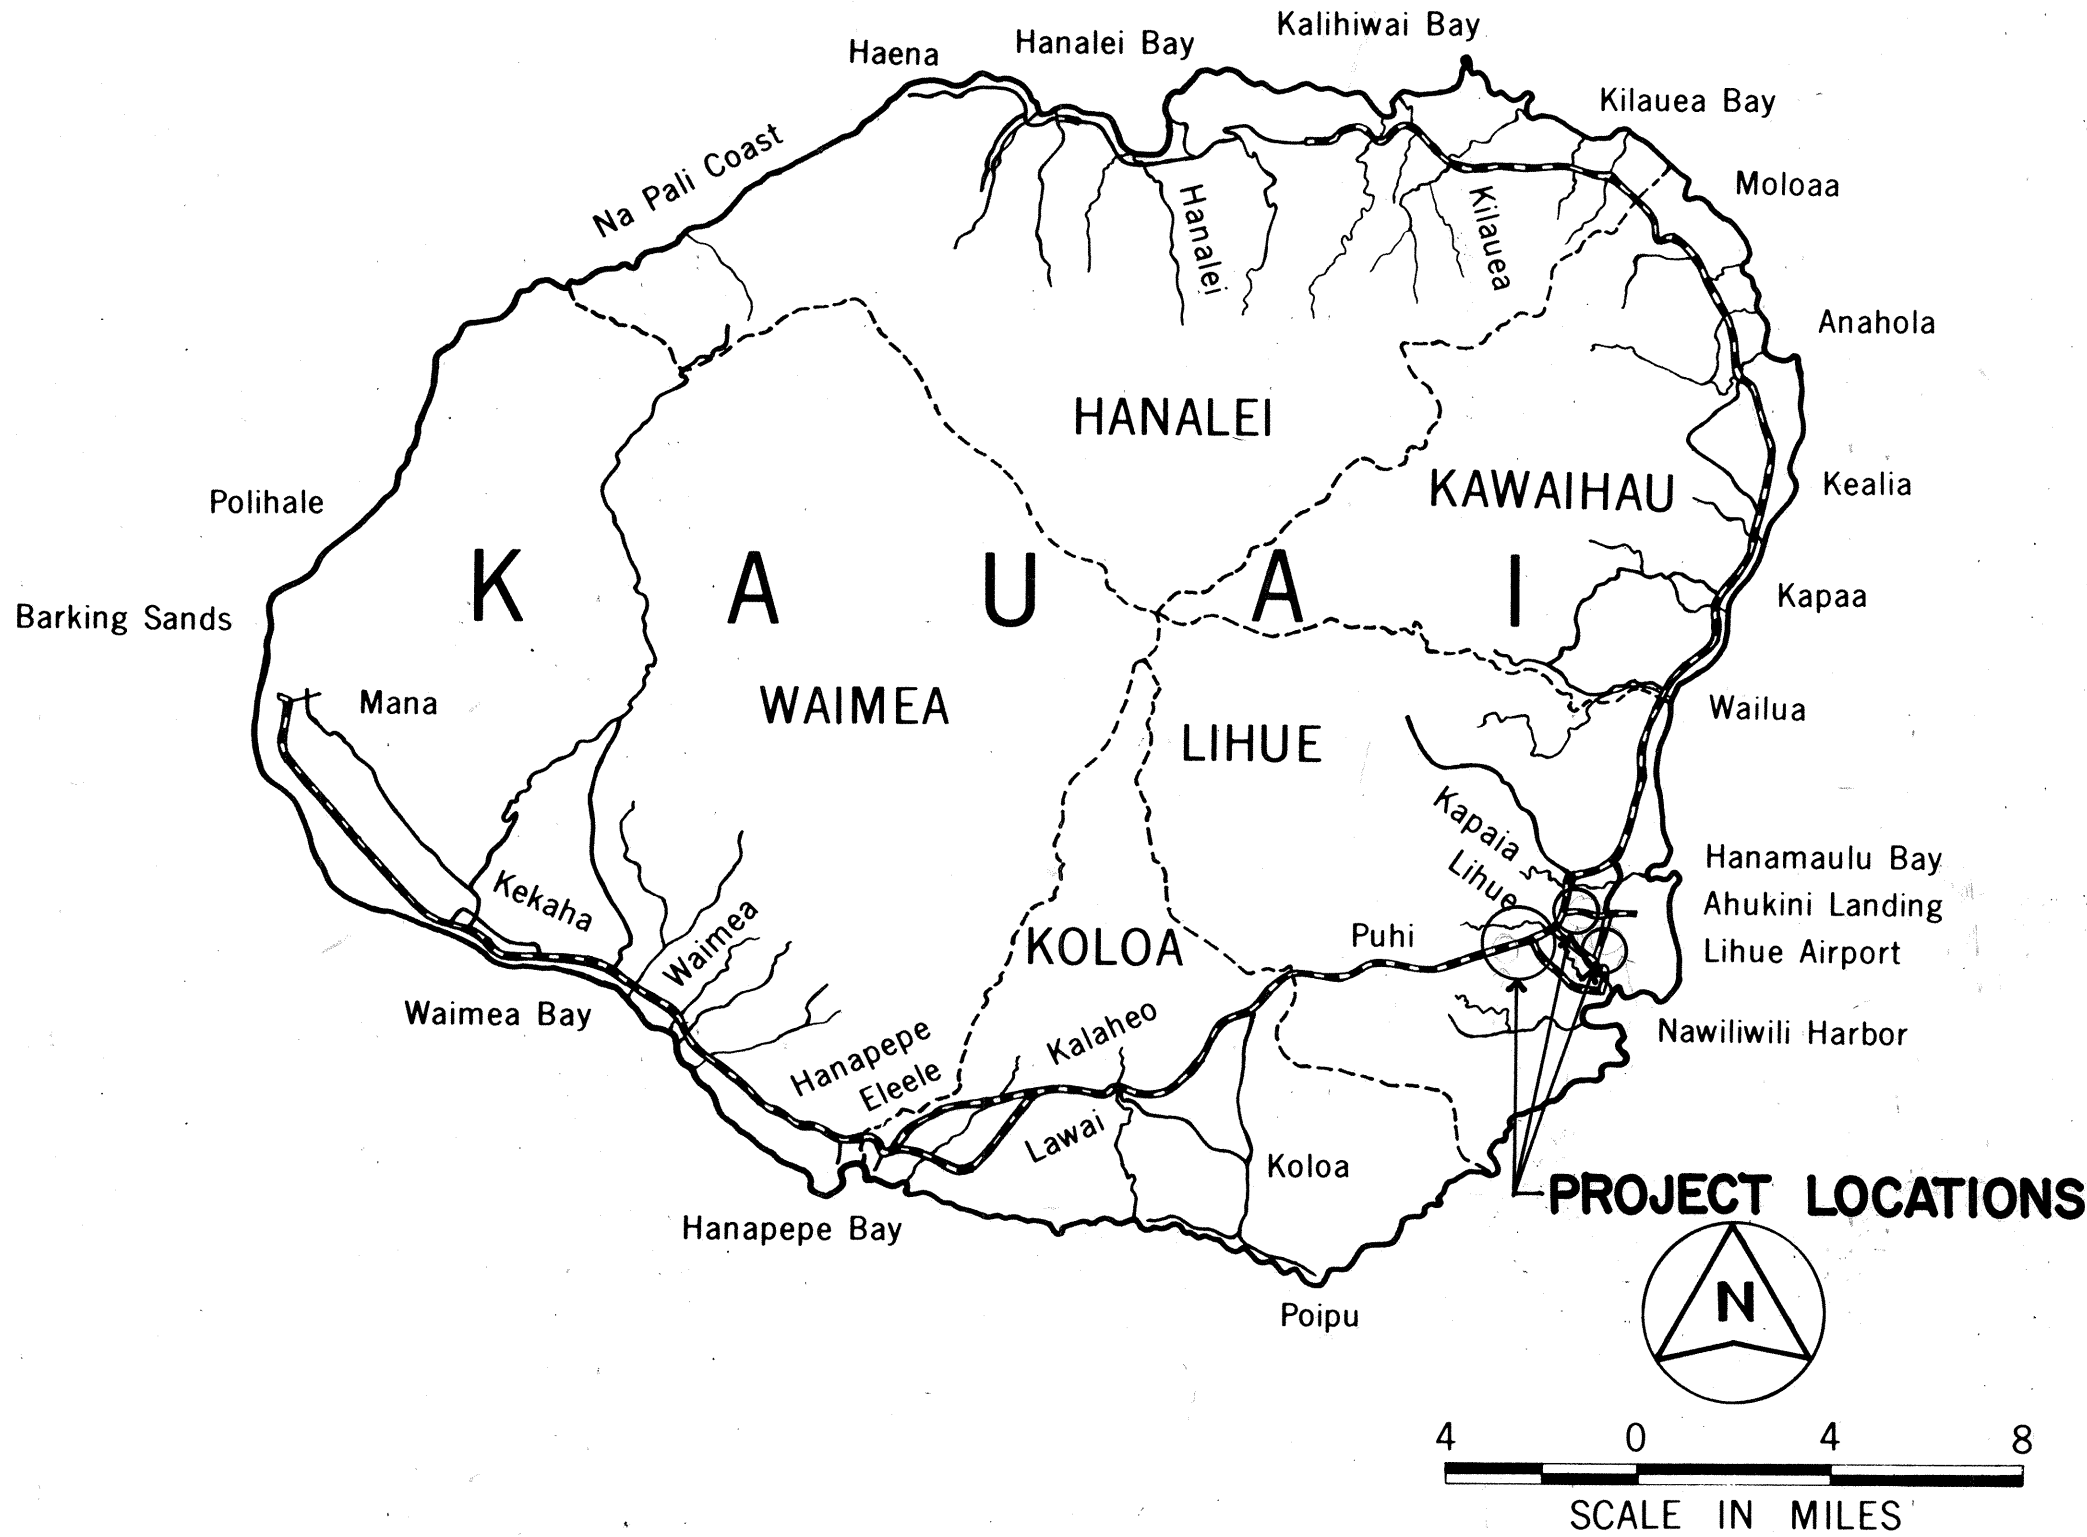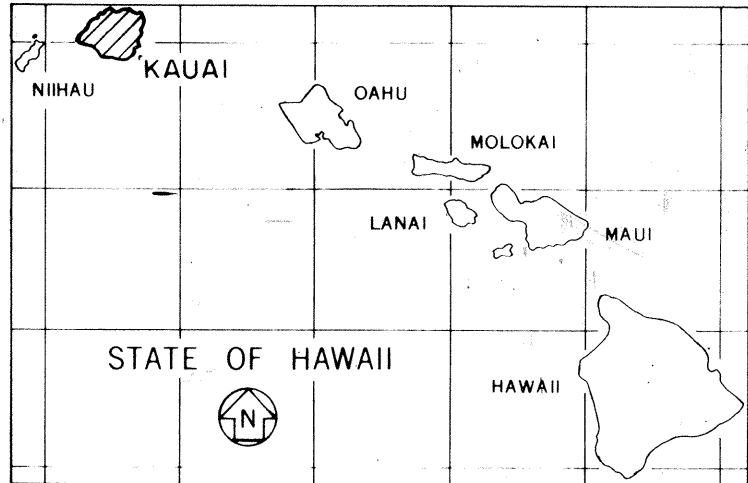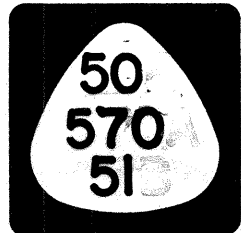

PROJECT NO. 50E-01-92M
(MM 0.985 TO 0.738 & MM 0.623 TO 0.251)

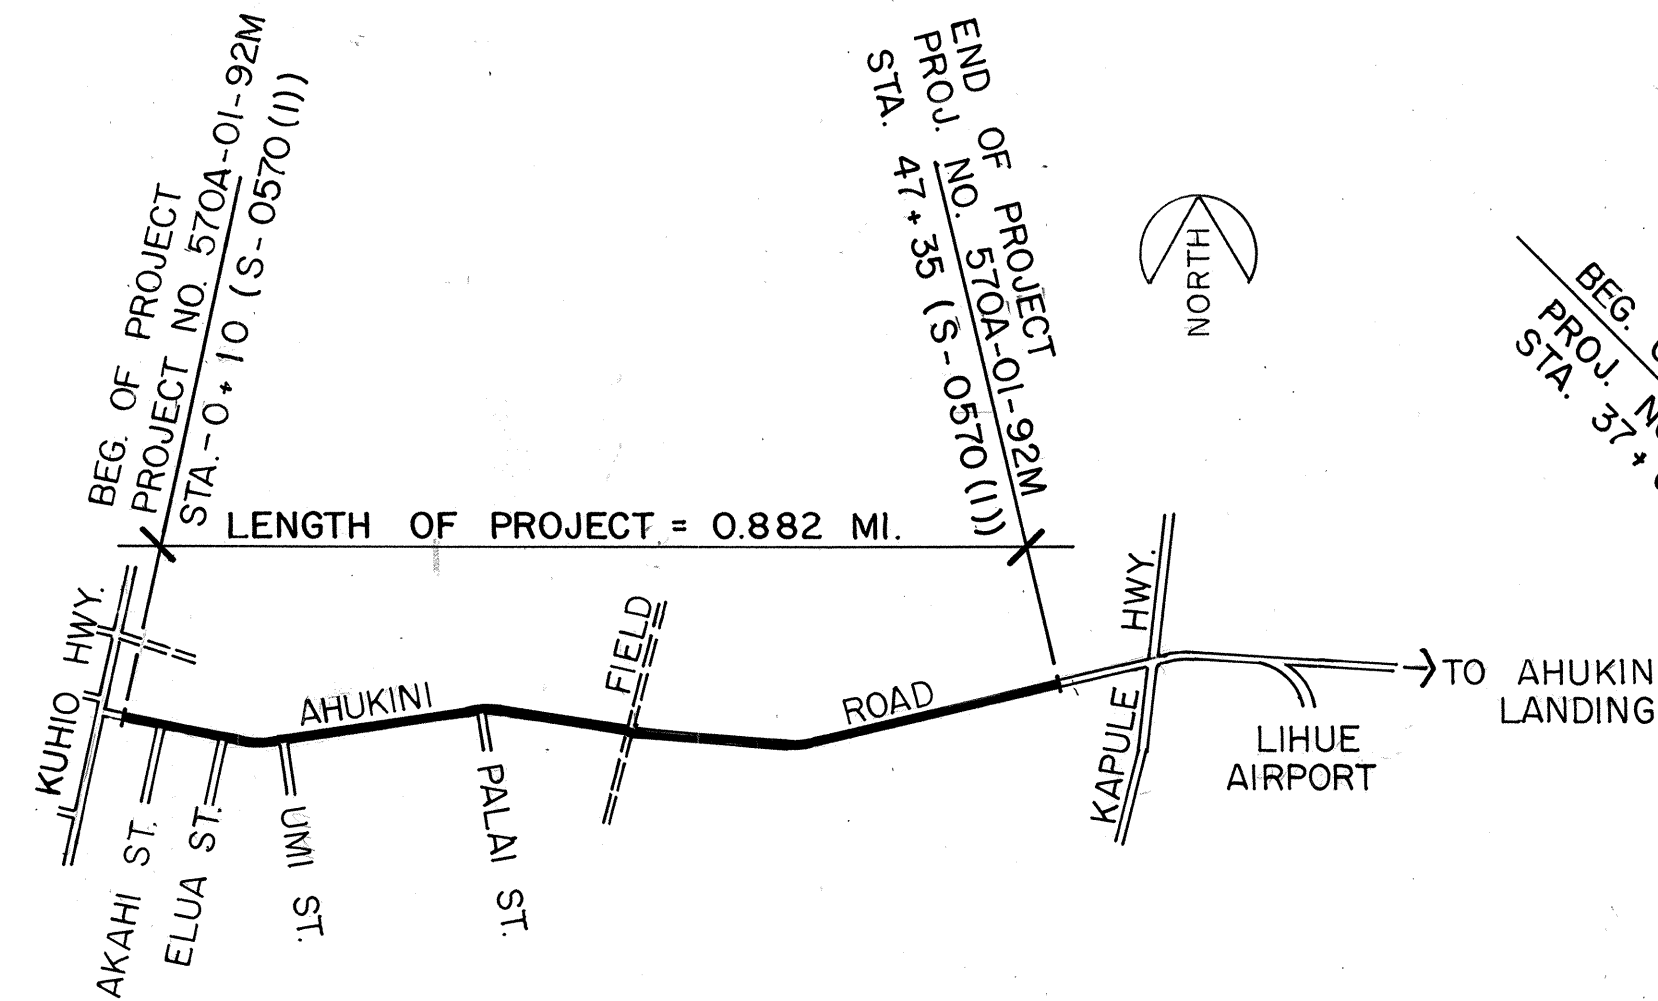


PROJECT NO. 570A-01-92M
(MM 0.0152 TO 0.8968)

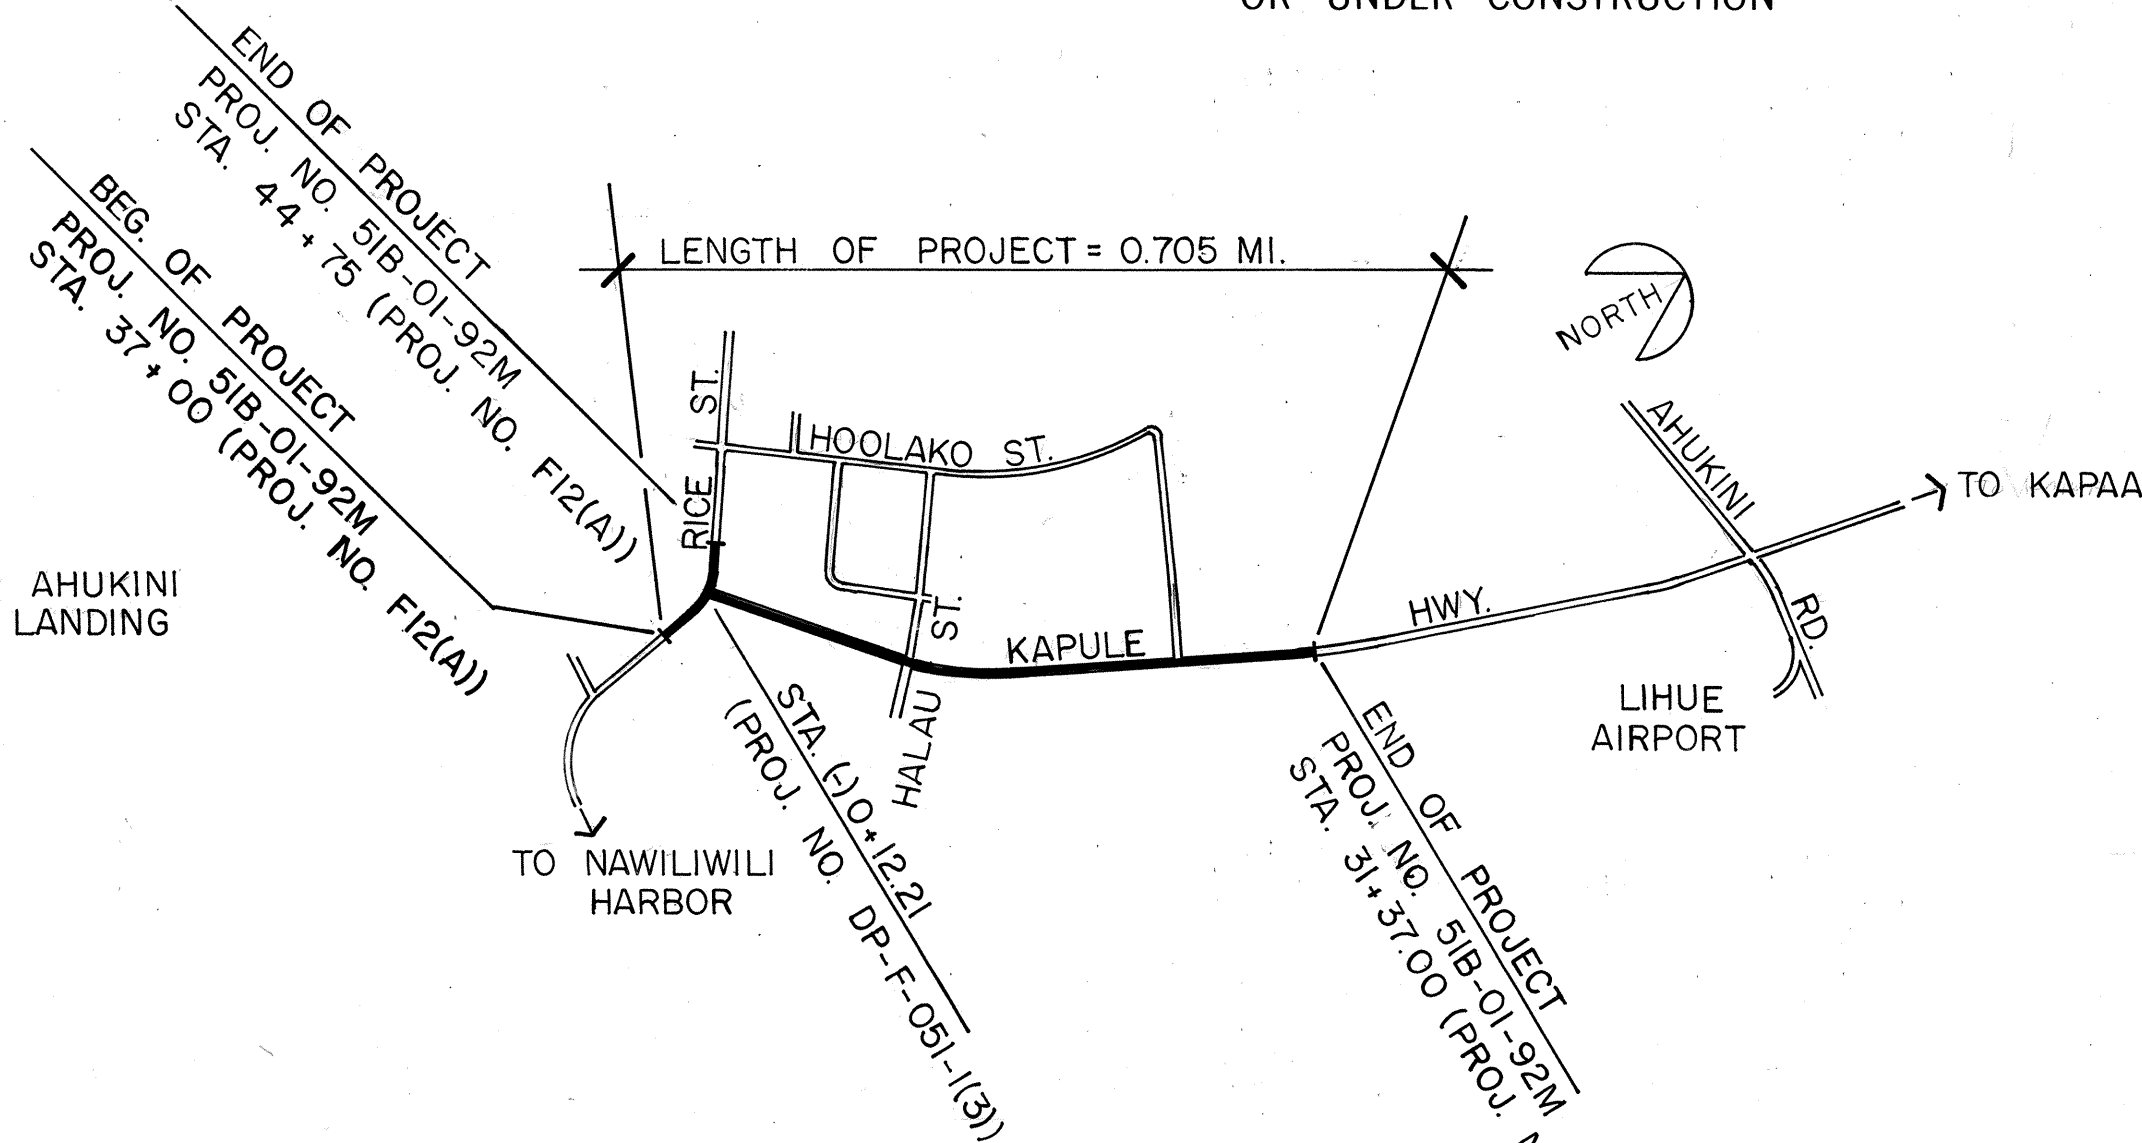

PROJECT NO. 51B-01-92M
(MM 0.842 TO 0.951) RICE STREET
(MM 0.896 TO 1.492) KAPULE HIGHWAY

LAYOUT OF PROJECTS

TOTAL LENGTH OF PROJECTS = 2.205 MILES

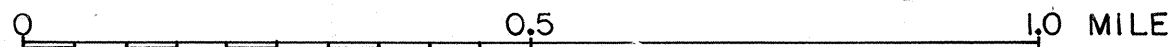

DEPARTMENT OF TRANSPORTATION STATE OF HAWAII	
APPROVED:	DATE
<i>[Signature]</i>	<i>4/24/92</i>
DIRECTOR OF TRANSPORTATION	

AS-BUILT