


FED. ROAD DIST. NO.	STATE	FED. AID PROJ. NO.	FISCAL YEAR	SHEET NO.	TOTAL SHEETS
HAWAII	HAW.	ER-11(3)	1993	4	5

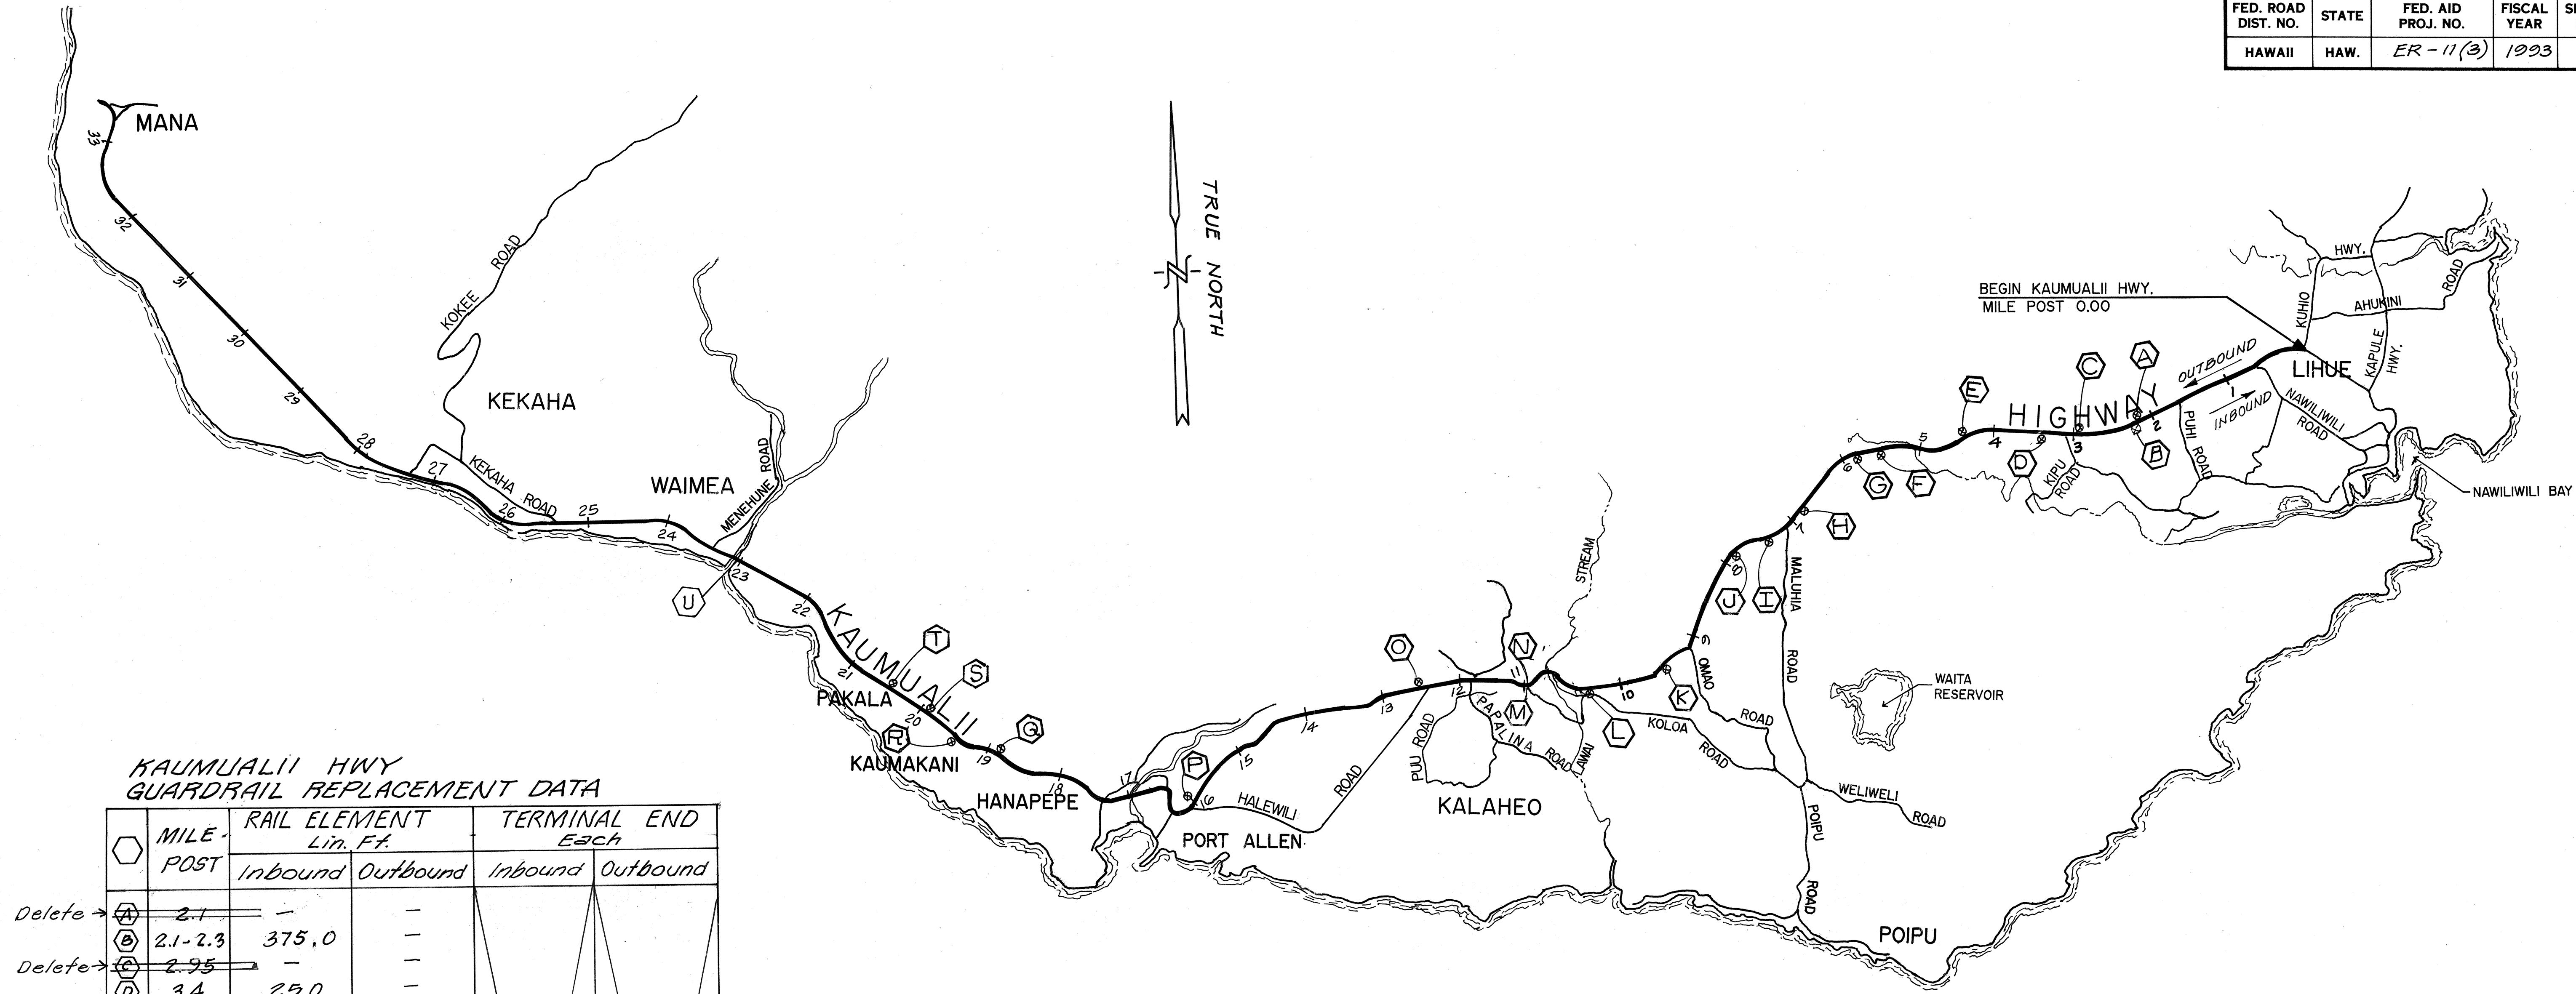

KAUMUALII HWY
GUARDRAIL REPLACEMENT DATA

	MILE POST	RAIL ELEMENT <i>Lin. Ft.</i>		TERMINAL END <i>Each</i>	
		Inbound	Outbound	Inbound	Outbound
Delete → A	2.1	—	—		
B	2.1-2.3	375.0	—		
Delete → C	2.95	—	—		
D	3.4	25.0	—		
E	4.4	—	25.0		
F	5.5	50.0	—		
G	5.8	25.0	—		
H	6.8	50.0	—		
I	7.4	75.0	—		
J	7.8	25.0	—		
K	9.5	25.0	—		
Delete → L	13.2	—	—		
M	11.0	12.5	—		
N	11.0	—	37.5		
O	12.5	—	25.0		
Delete → P	16.0	—	—		
Q	18.8	—	37.5		
R	19.4	25.0	—		
S	19.8	—	25.0		
T	20.4	—	25.0		
U	23.1	25.0	—		
Totals		712.5	175		

PLAN
ROUTE 50 - KAUMUALII HWY.
Scale: 1" = 1 Mile

SURVEY PLOTTED BY _____ DATE _____
 DRAWN BY _____
 DESIGNED BY _____
 CHECKED BY _____

ORIGINAL PLAN _____
 NOTE BOOK _____
 NO. _____

STATE OF HAWAII
 DEPARTMENT OF TRANSPORTATION
 HIGHWAYS DIVISION

PLAN
 ROUTE 50-KAUMUALII HIGHWAY
 RECONSTRUCTION & REPLACEMENT
 OF GUARDRAILS AT VARIOUS LOCATIONS
 F.A. PROJ. NO. ER-11 (3)
 SCALE: 1" = 1 MILE Mar. 1993

SHEET NO. 1 OF 2 SHEETS