


FED. ROAD DIST. NO.	STATE	FED. AID PROJ. NO.	FISCAL YEAR	SHEET NO.	TOTAL SHEETS
HAWAII	HAW.	ER-11(3)	1993	5	5

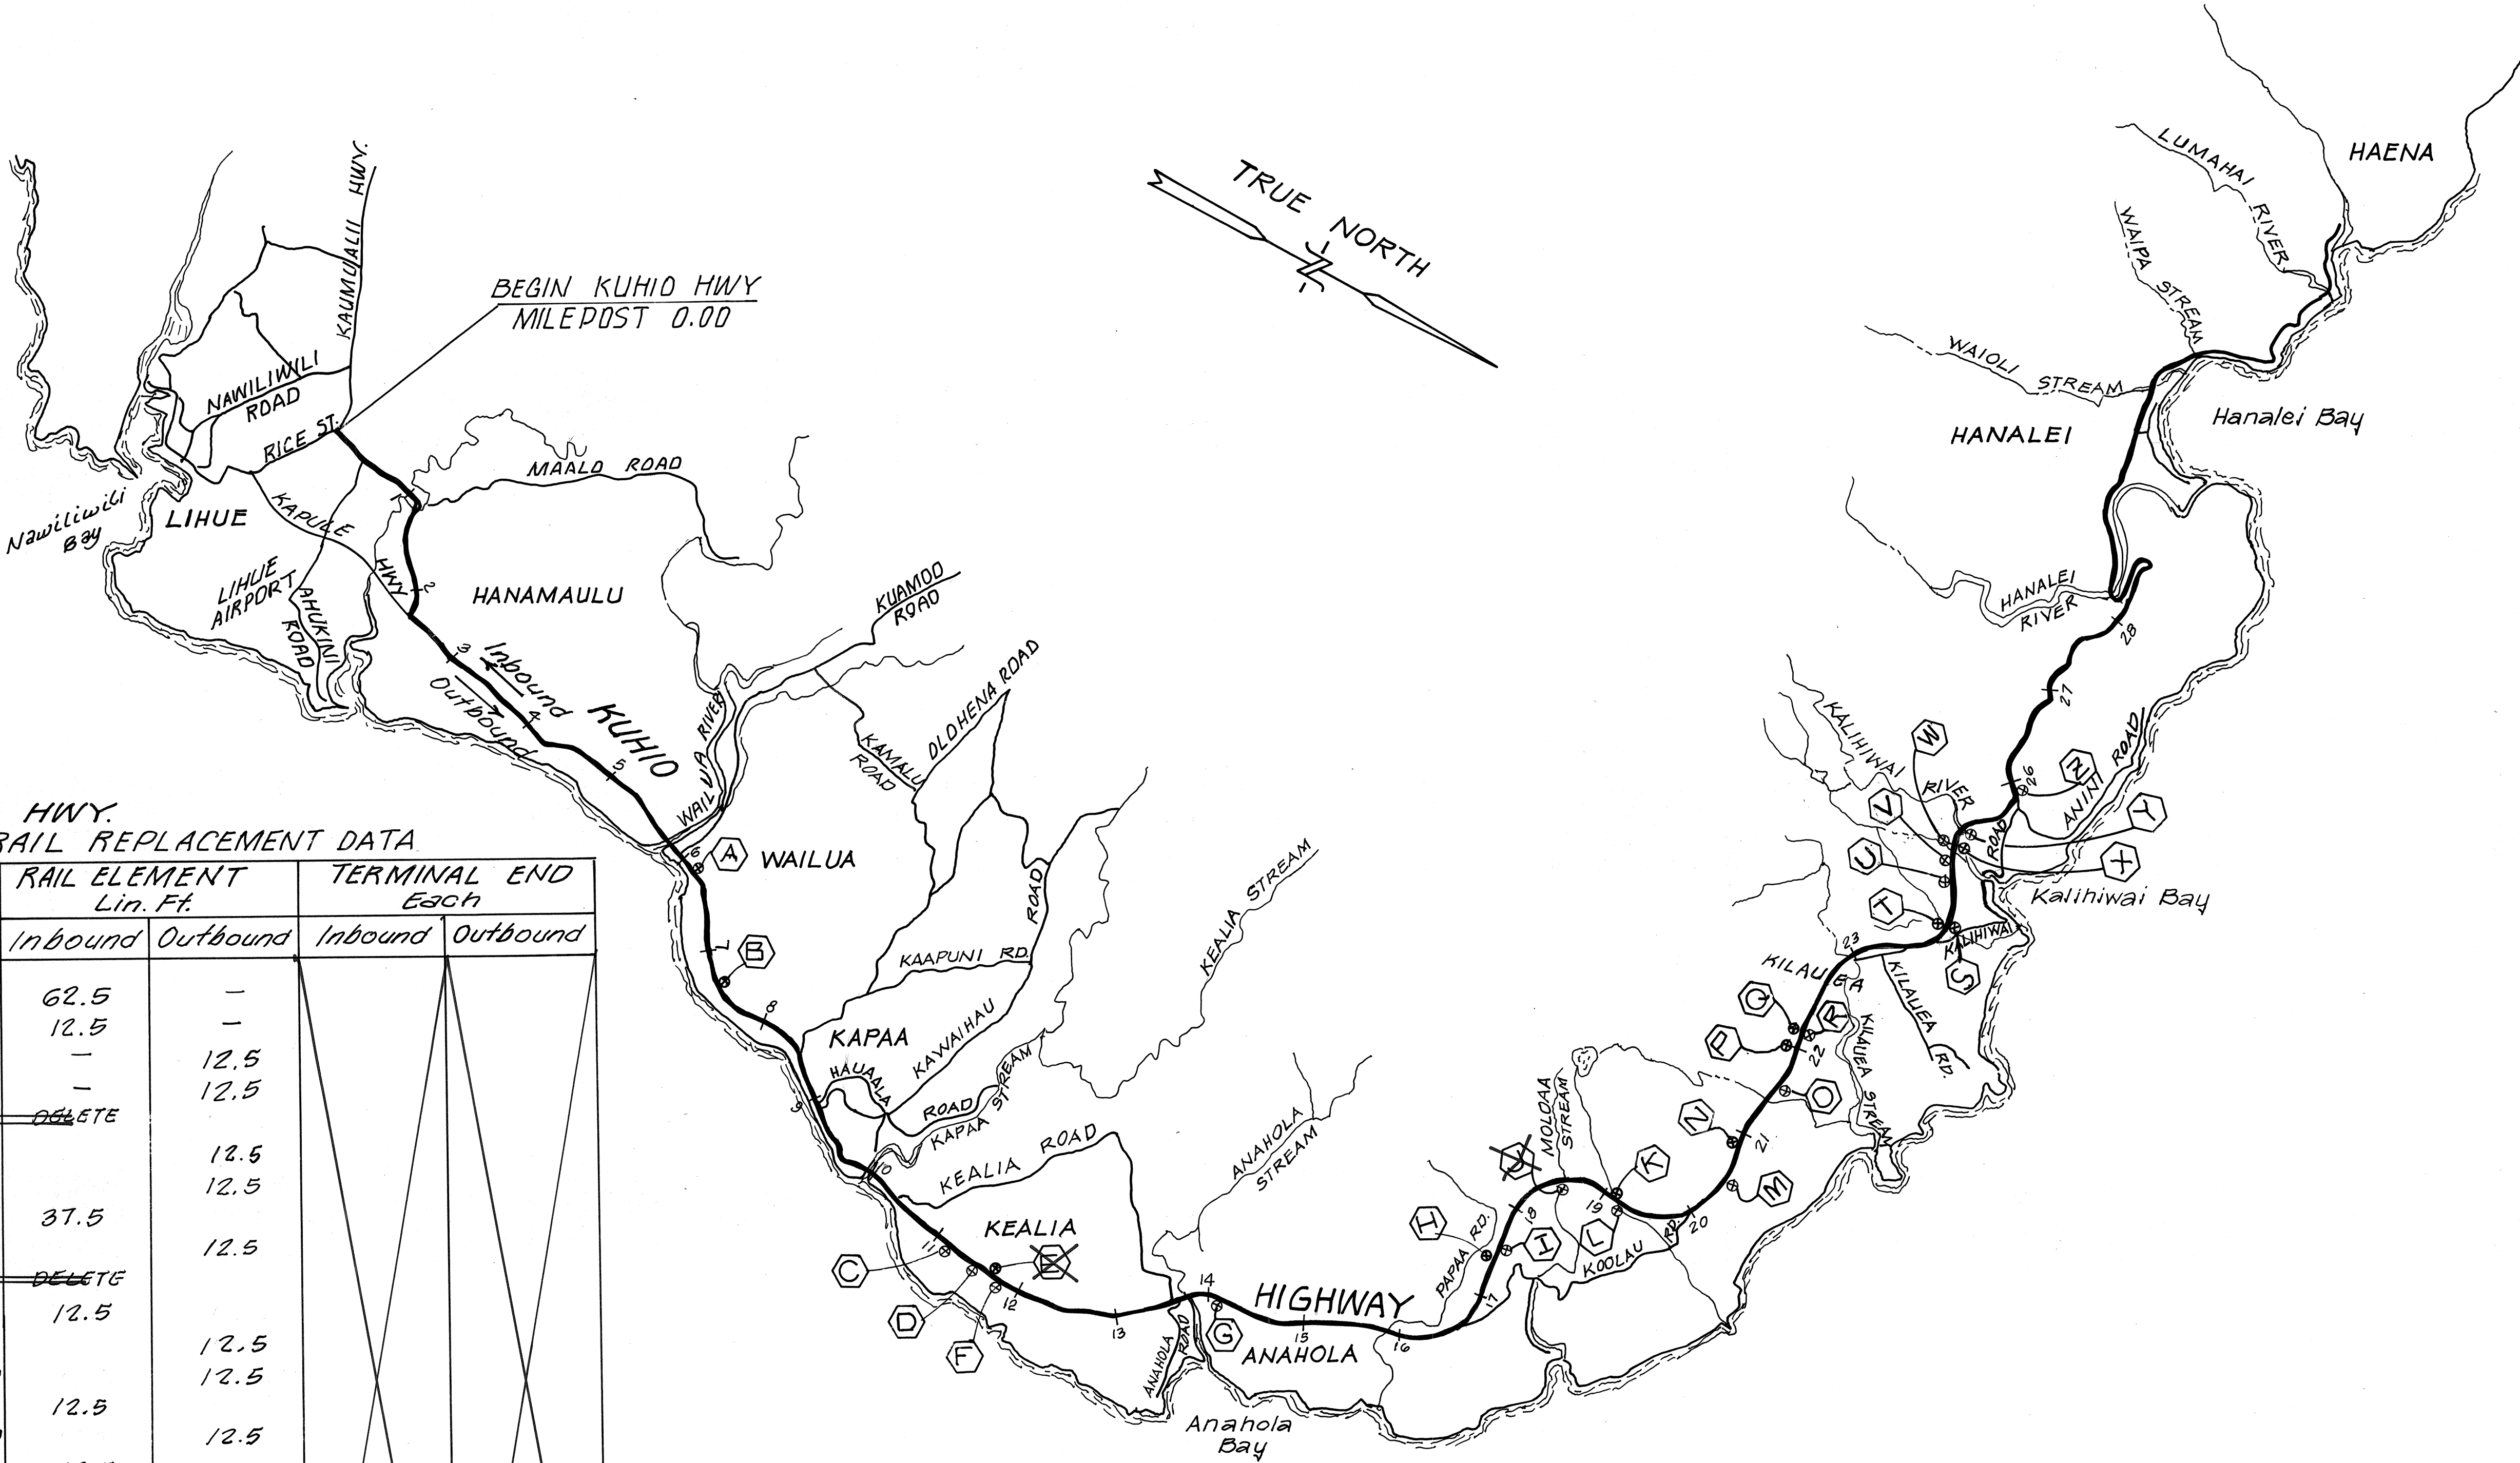

KUHIO HWY
GUARDRAIL REPLACEMENT DATA

MILE POST	RAIL ELEMENT Lin. Ft.		TERMINAL END Each	
	Inbound	Outbound	Inbound	Outbound
6.20	62.5	—		
7.40	12.5	—		
11.20	—	12.5		
11.50	—	12.5		
11.70	DELETE			
11.80		12.5		
14.10		12.5		
17.40	37.5			
17.50		12.5		
18.50	DELETE			
19.10	12.5			
19.20		12.5		
20.50		12.5		
20.90	12.5			
21.60		12.5		
22.00	12.5			
22.20	25.0			
22.20		12.5		
24.00		200.0		
24.00	200.0			
24.50	37.5			
24.80	100.0			
25.00	25.0			
25.00		62.5		
25.20		62.5		
25.80		12.5		
Totals	537.5	450.0		

PLAN
ROUTE 56 - KUHIO HWY
Scale: 1" = 1 Mile

STATE OF HAWAII
DEPARTMENT OF TRANSPORTATION
HIGHWAYS DIVISION

PLAN
ROUTE 56-KUHIO HIGHWAY

RECONSTRUCTION & REPLACEMENT
OF GUARDRAILS AT VARIOUS LOCATIONS
F.A. PROJECT NO. ER-11(3)
Scale: 1" = 1 Mile Mar. 1993
SHEET NO. 2 OF 2 SHEETS

SURVEY PLOTTED BY
DRAWN BY
DESIGNED BY
CHECKED BY

DATE

ORIGINAL PLAN
NOTE BOOK
No.