
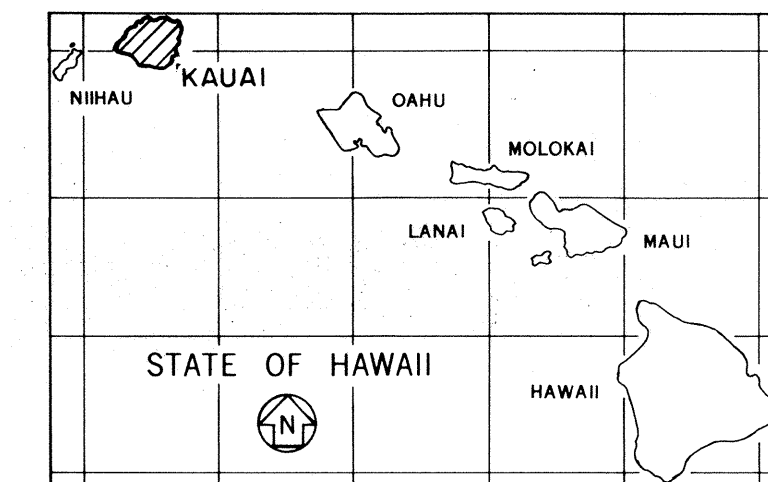



FED. ROAD DIST. NO.	STATE	FED. AID PROJ. NO.	FISCAL YEAR	SHEET NO.	TOTAL SHEETS
HAWAII	HAW.	ER - 11 (3)	1993	1	5

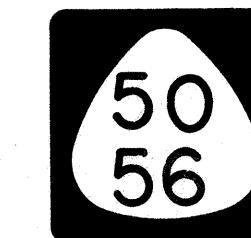

STATE OF HAWAII
DEPARTMENT OF TRANSPORTATION
HIGHWAYS DIVISION
HONOLULU, HAWAII
~~"AS-BUILT"~~
PLANS FOR
KAUMUALII HIGHWAY AND KUHIO HIGHWAY
RECONSTRUCTION AND REPLACEMENT
OF GUARDRAILS AT VARIOUS LOCATIONS
FEDERAL AID PROJECT NO. ER-11(3)

DISTRICTS OF WAIMEA, KOLOA, LIHUE, KAWAIHAU & HANALEI

ISLAND OF KAUAI

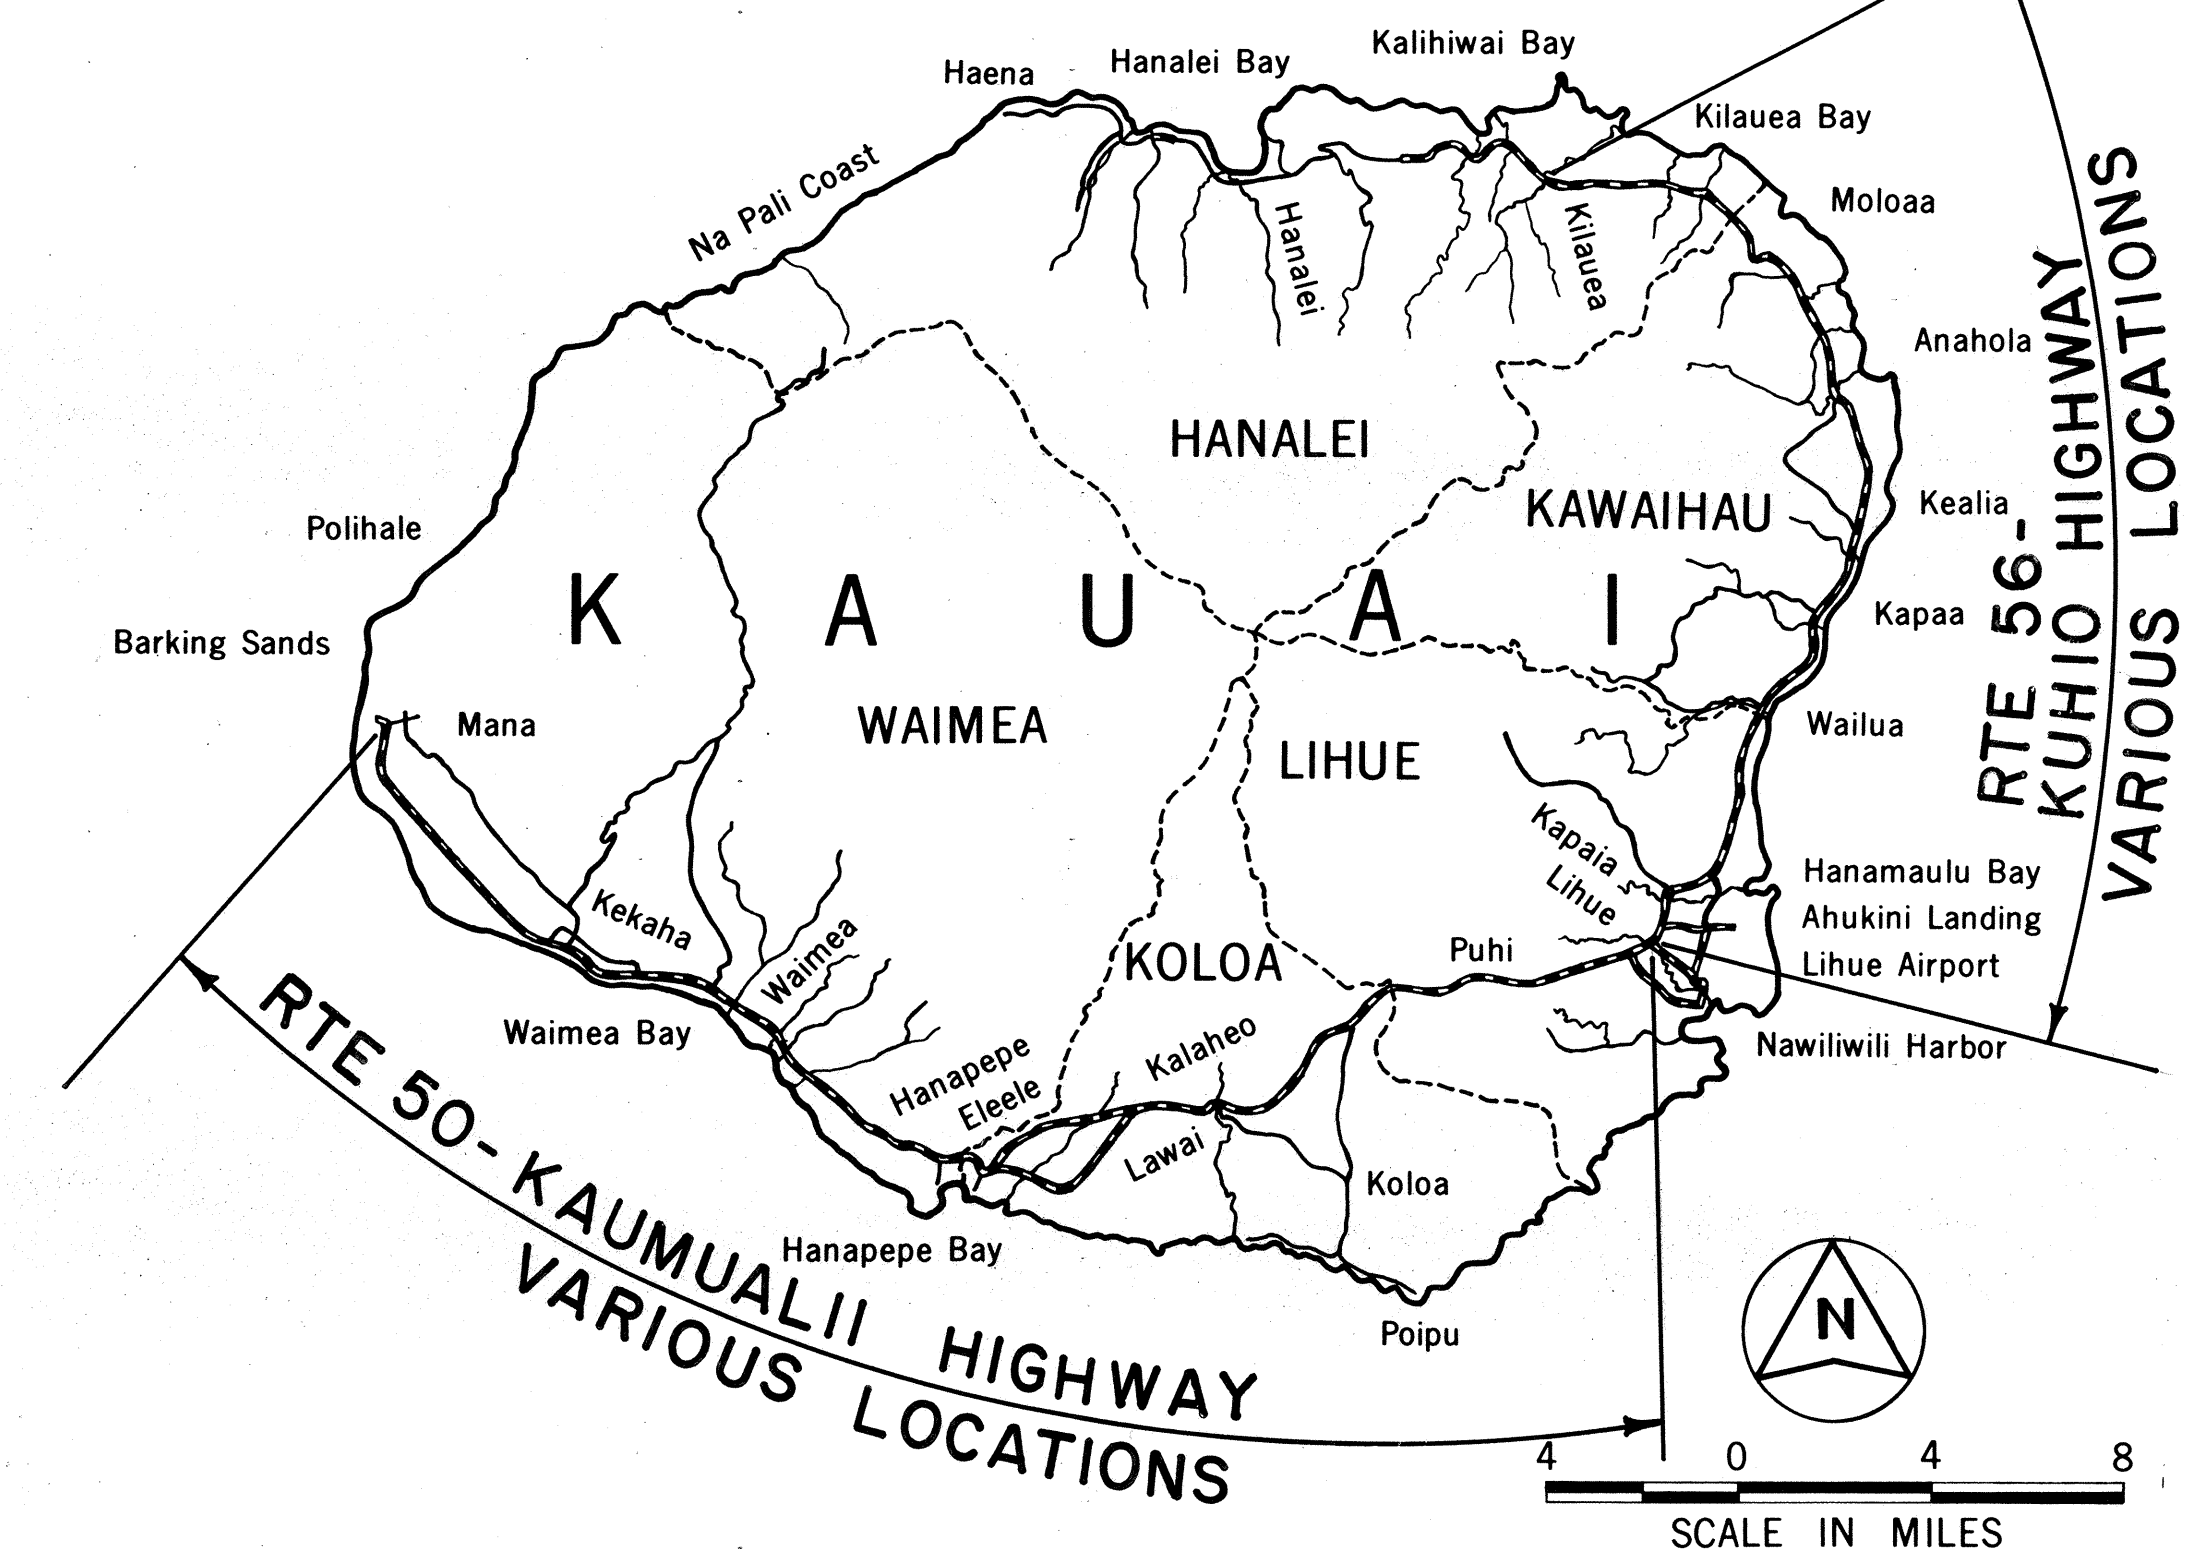

FEDERAL AID PROJECTS PREVIOUSLY CONSTRUCTED
OR UNDER CONSTRUCTION

ROUTE 50 MILE POST 25.9 TO MILE POST 2.1

ROUTE 56 MILE POST 25.8 TO MILE POST 6.2

NO SIGNIFICANT CHANGES WERE MADE DURING CONSTRUCTION ON THESE PLANS EXCEPT CHANGES IN THE ORIGINAL THEORETICAL QUANTITIES. FOR ACTUAL QUANTITIES REFER TO PROJECT LEDGER AND/OR COMPUTATION BOOK.

EVENT

DATE _____

8.16.01

DEPARTMENT OF TRANSPORTATION
STATE OF HAWAII

APPROVED:

For A. Harano 5/11/93
DIR. OF TRANSPORTATION DATE

HWY - K
DESIGNED BY
ALLAN NISHIMURA
P. S. & E. BY
587-2244
PHONE
DATE
MARCH 1993