



- Notes:
1. For Typical Section, See Sheet No. 7.
 2. For Typical Edgeline with Type CL Markers See Sht. 4.
 3. For Typical Resurfacing Limits, See Sht. 4.

FED. ROAD DIST. NO.	STATE	PROJ. NO.	FISCAL YEAR	SHEET NO.	TOTAL SHEETS
HAWAII	HAW.	5508-01-92M	1992	6	7

Kokee Road Resurfacing
Estimated Quantities

Item No	Description	Quant.
401.0600	A.C. Pavt. Marshall Mix	330± T. 3308.93
420.0100	Pavt. Reinf. Fabric	21,957 Sq. Yd. 20,731.1
621.3010	Reg. & Warning Sign	1 Ea.
621.7000	Construction Sign w/ Two Posts	6 Ea.
621.7500	Mile post Markers	2
629.1012	Dbl 4-inch Pavt. Stripe (Yel)	9410 Lin. Ft.
629.1014	4-inch E.P. Striping (Wh.)	18,420 Lin. Ft.

For Pavement Markers, See Sht. No. 4.

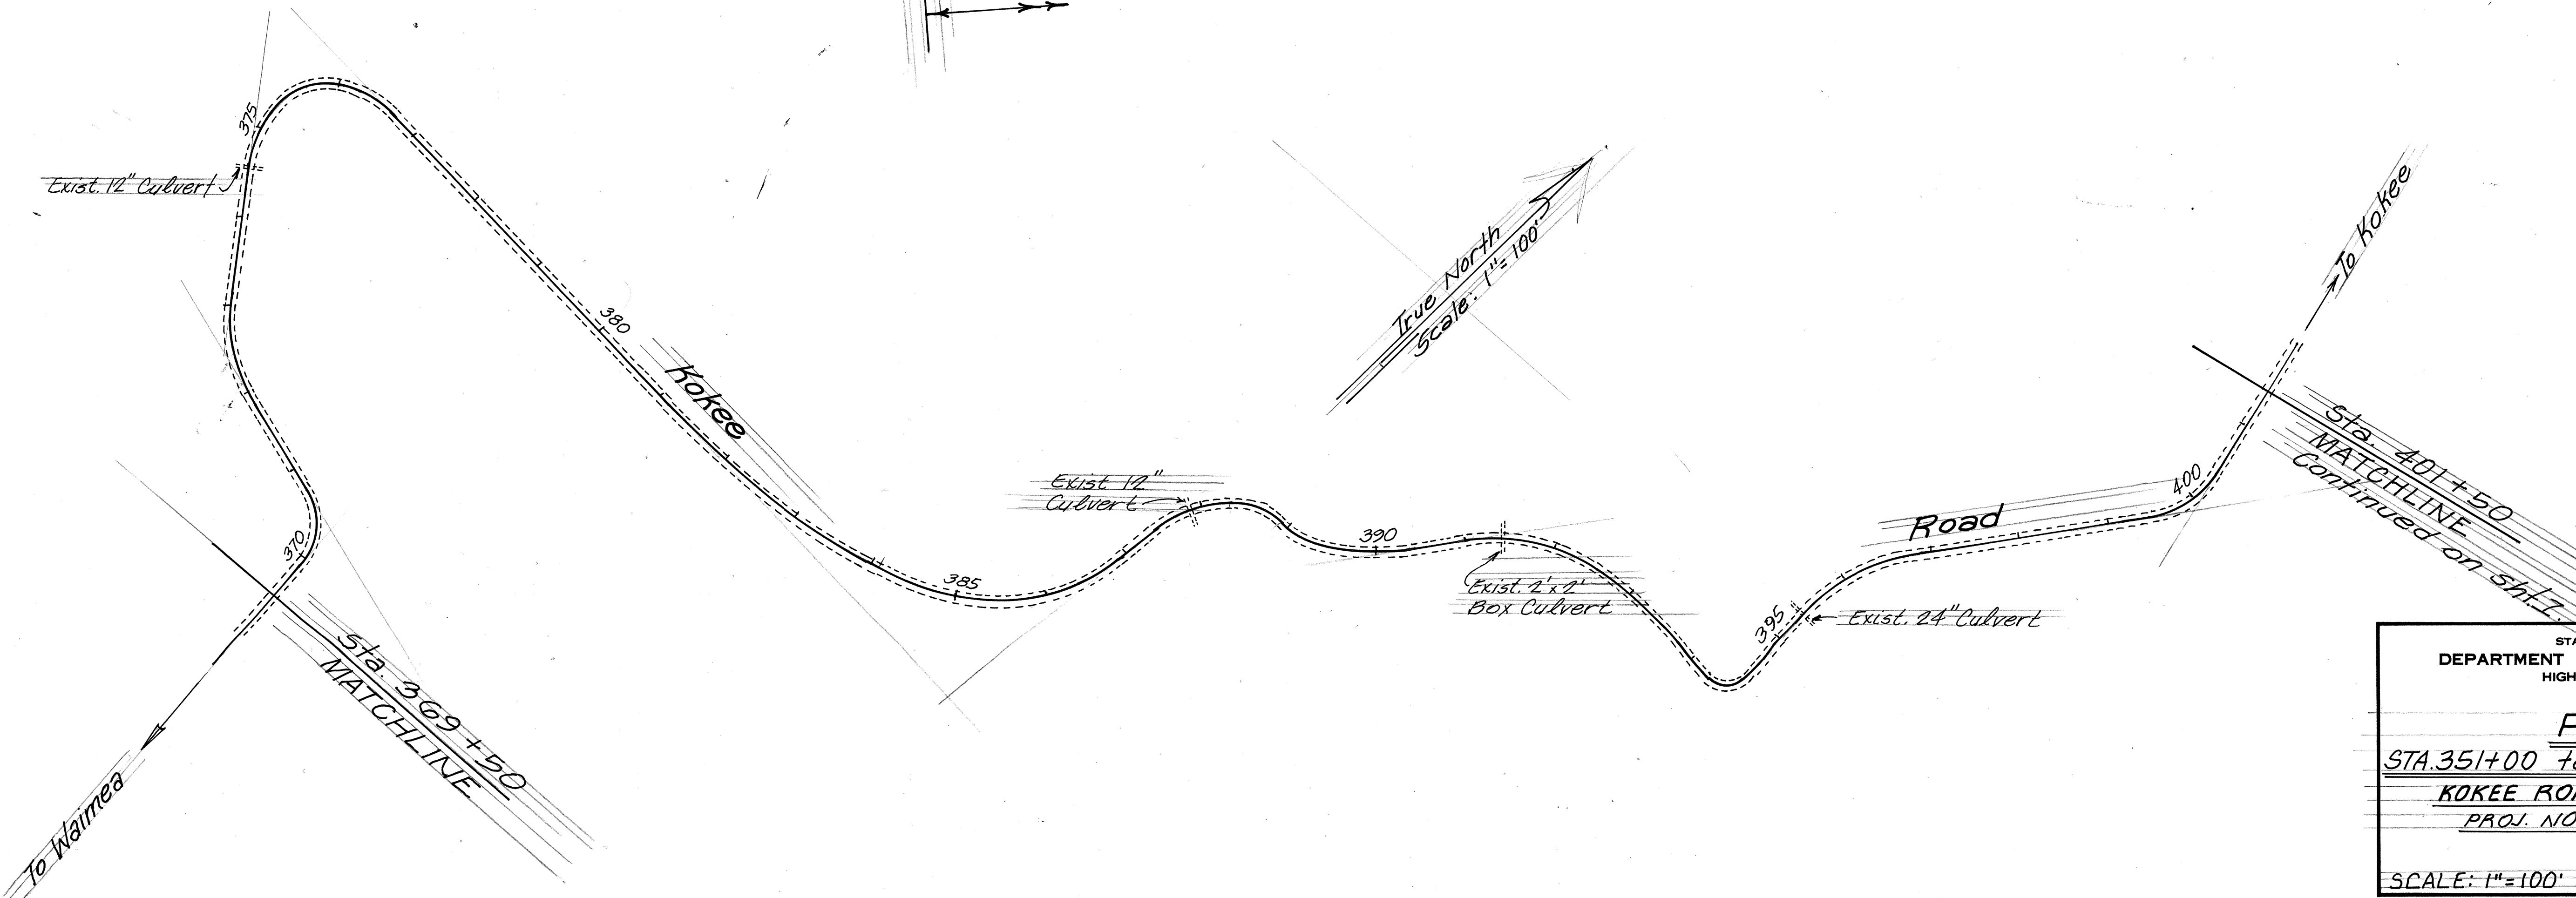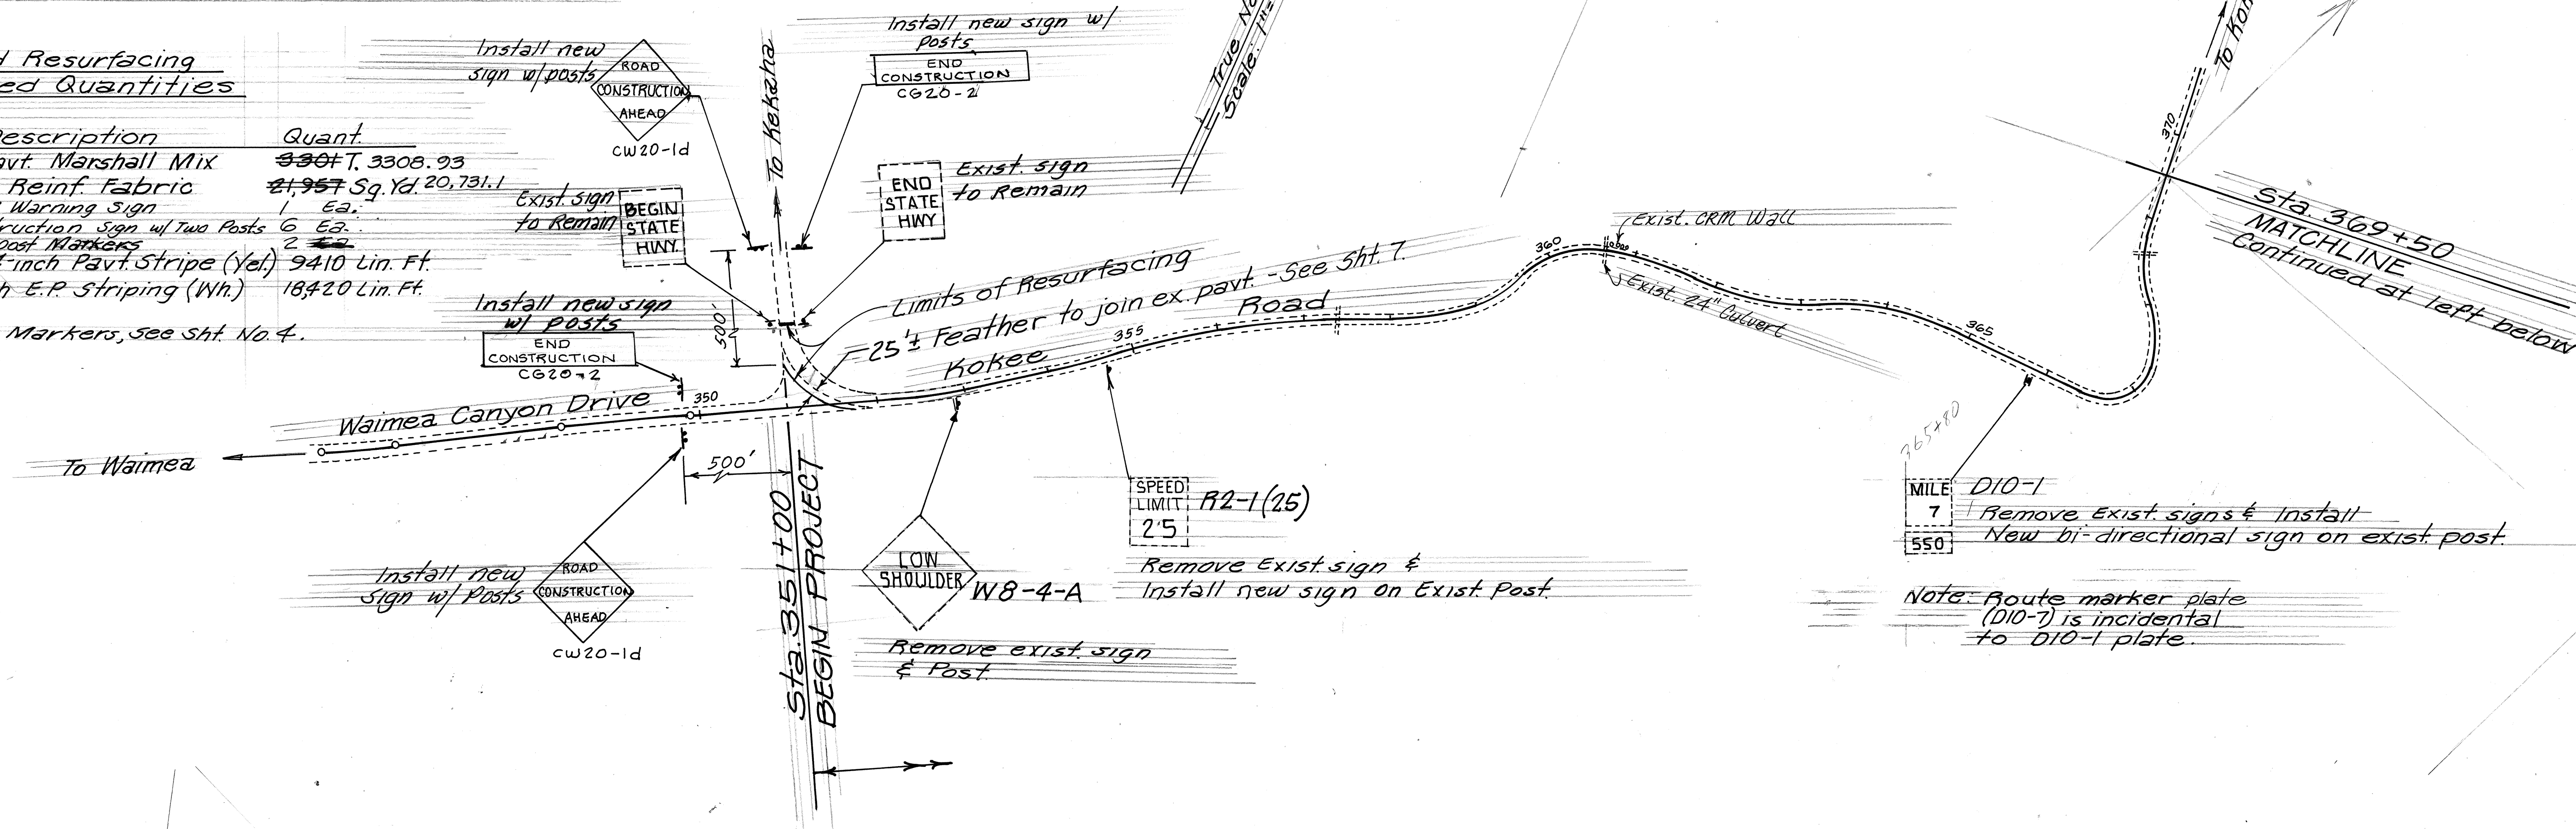

SURVEY PLOTTED BY	DATE
DRAWN BY	
DESIGNED BY	
CHECKED BY	
NO.	

STATE OF HAWAII
DEPARTMENT OF TRANSPORTATION
HIGHWAYS DIVISION

PLAN

STA. 351+00 to STA. 401+50

KOKEE ROAD RESURFACING

PROJ. NO. 5508-01-92M

SCALE: 1"=100'
DATE: JULY, 1991
SHEET NO. 6 OF 7 SHEETS