	i i
	INDEX TO DRAWINGS
SHEET NO.	DESCRIPTION
	TITLE SHEET
2	STANDARD PLANS SUMMARY
	SHEET
3	GENERAL NOTES & SUMMARY
	OF PAVEMENT STRIPING &
	MARKERS
4	TYPICAL SECTION & DETAILS
	(KAUMUALII HWY)
5 .	PLAN - KAUMUALII HWY
6	PLAN - KOKEE ROAD
	PLAN & TYPICAL SECTION-
	KOKEE ROAD
7.	

STATE OF HAWAII

DEPARTMENT OF TRANSPORTATION
HIGHWAYS DIVISION
HONOLULU, HAWAII

"AS-BUILT" PLANS FOR


KAUMUALII HIGHWAY RESURFACING MAHAIKONO BRIDGE TO WAIMEA BRIDGE


PROJECT NO. 50B-01-92M


AND

KOKEE ROAD RESURFACING
WAIMEA CANYON DRIVE TO M.P. 8.5±
PROJECT NO. 550B-01-92M

DISTRICT OF WAIMEA
ISLAND OF KAUAI

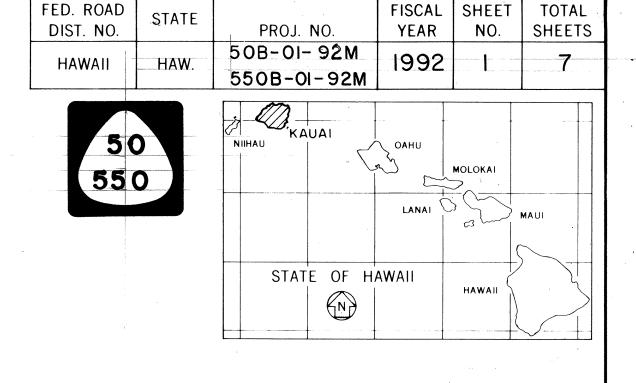

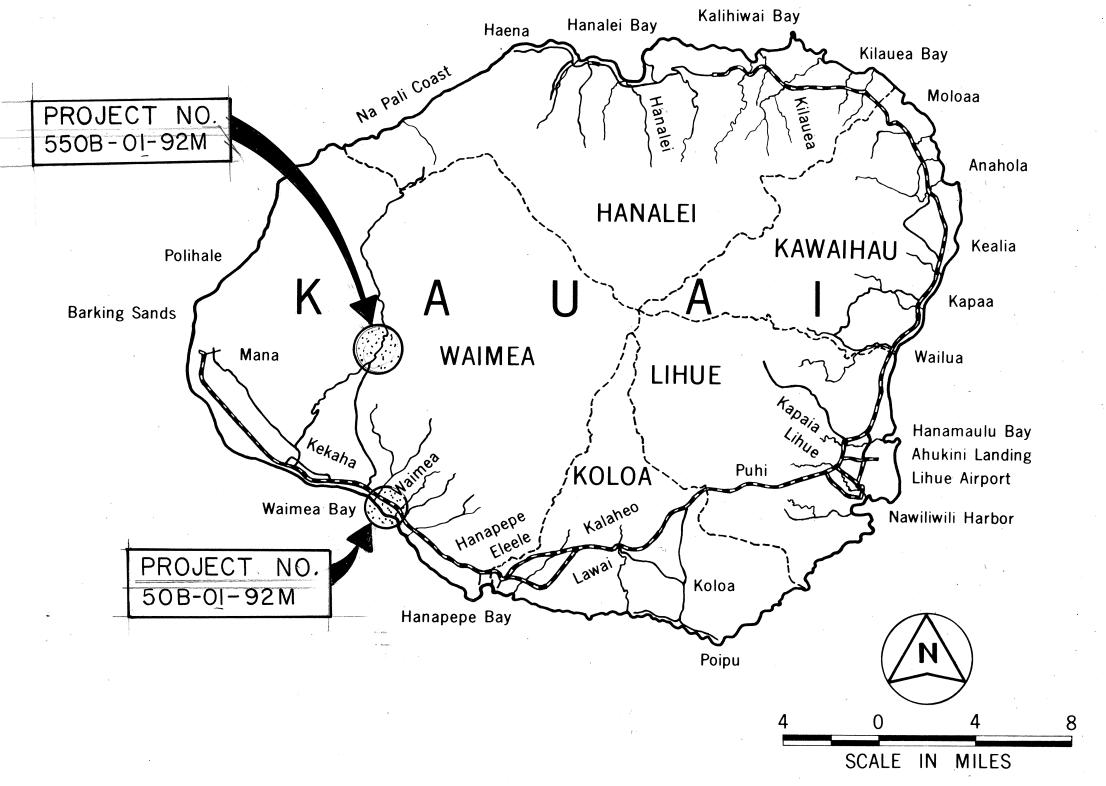

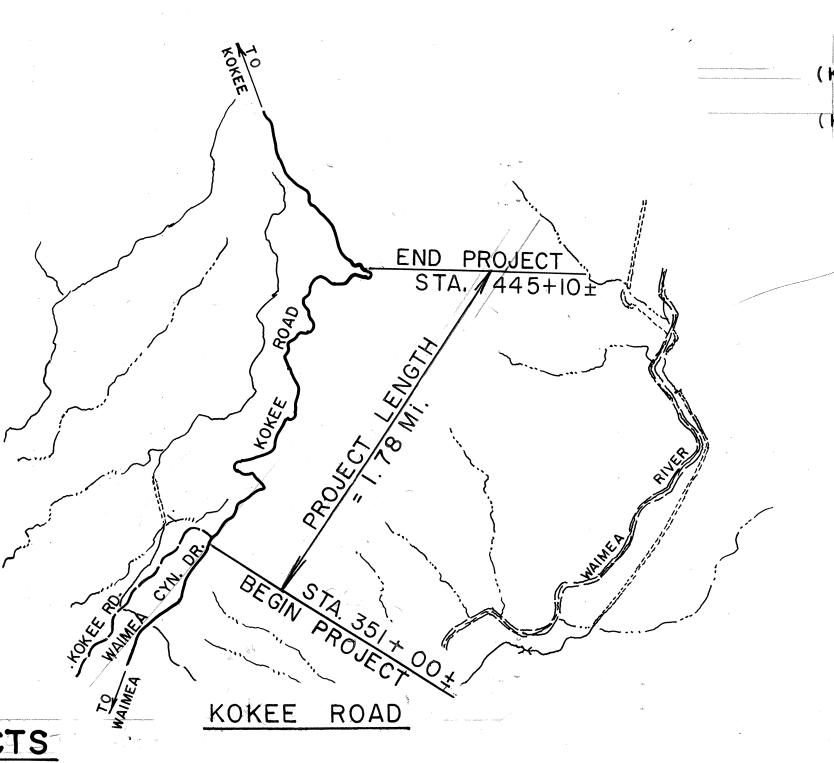

FEDERAL AID PROJECTS PREVIOUSLY CONSTRUCTED OR UNDER CONSTRUCTION

(KAUMUALII HWY) MILE POST 21.42 + TO MILE POST 22.54+

(EE ROAD) MILE POST 6.72 + TO MILE POST 8.50 +

NO SIGNIFICANT CHANGES WERE MADE DURING CONSTRUCTION ON THESE PLANS EXCEPT CHANGES IN THE ORIGINAL THEORETICAL QUANTITIES. FOR ACTUAL QUANTITIES, REFER TO PROJECT LEDGER AND/OR COMPUTATION BOOK.

RESIDENT ENGINEER

Z///93 DATE

DEPARTMENT OF TRANSPORTATION
STATE OF HAWAII

APPROVED:

Clearly 19/4/91

DIR. OF TRANSPORTATION DATE

WAIMEA

LAYOUT OF PROJECTS

SCALE: | " = 2000'