

FED. ROAD DIST. NO.	STATE	FED. AID PROJ. NO.	FISCAL YEAR	SHEET NO.	TOTAL SHEETS
HAWAII	HAW.	STP-050-1(9)	1995	10	29

# CURVE DATA												
	1	2	3	4	5	6	7	8	9	10	11	12
Δ	42°31'32.48"	70°18'19.46"	22°46'57.41"	53°00'00"	79°31'30"	79°31'30"	53°00'00"	151°40'40.1"	90°00'00"	90°00'00"	20°28'9"	39°55'50.1"
R	339.00'	143.29'	364.81'	176.00'	92.00'	65.95'	150.00'	2.00'	30.00'	30.00'	57.55'	287.35'
T	131.92'	100.90'	73.68'	87.75'	76.55'	54.87'	74.79'	1.08'	30.00'	30.00'	10.39'	104.39'
Lc	251.61'	175.83'	145.06'	162.80'	127.70'	91.54'	138.75'	5.29'	47.12'	47.12'	20.56'	200.26'
C	245.87'	165.00'	144.11'	157.06'	117.69'	84.36'	133.86'	3.88'	42.43'	42.43'	20.45'	196.23'


# CURVE DATA	
	13
Δ	28°26'33.42"
R	298.66'
T	75.69'
Lc	148.26'
C	146.74'

LEGEND FOR
AS-BUILT POSTINGS

Squiggly line for as-built deletion

Double line for as-built deletion

Text for as-built posting

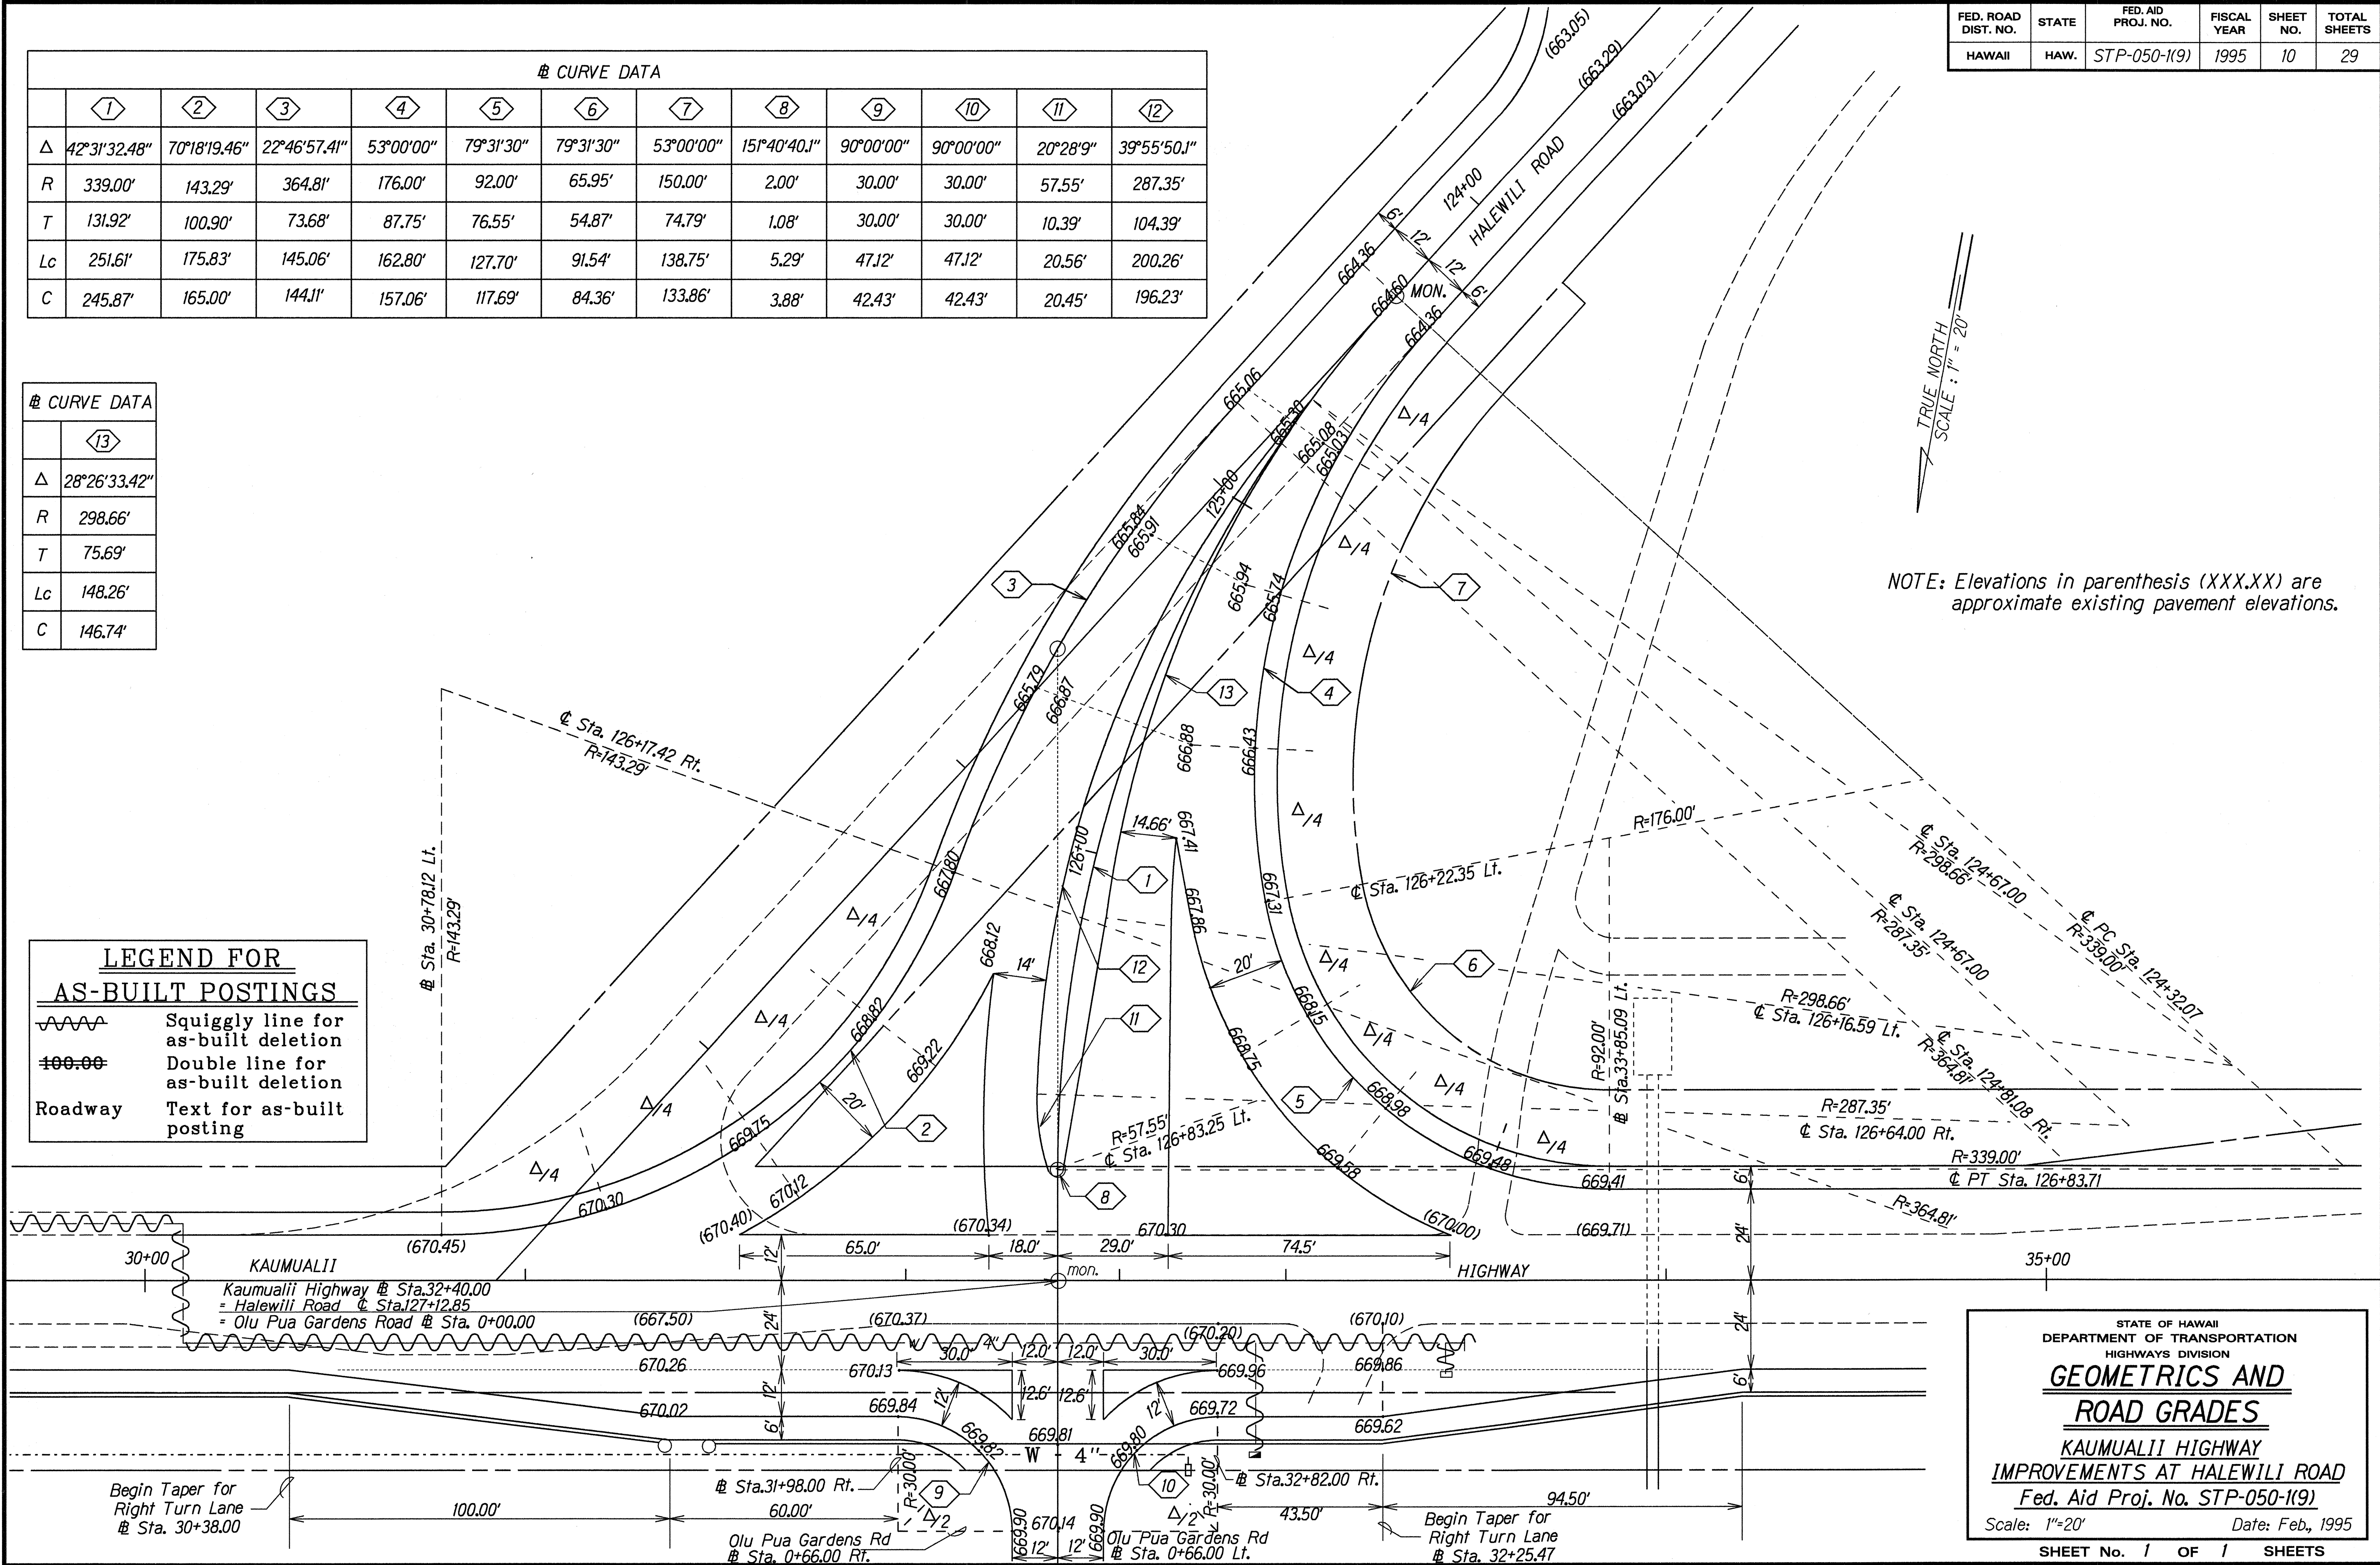

ORIGINAL PLAN	SURVEY PLOTTED BY	DATE
NOTED	DRAWN BY	
DESIGNED BY	TRACED BY	
CHECKED BY	CHECKED BY	

STATE OF HAWAII
DEPARTMENT OF TRANSPORTATION
HIGHWAYS DIVISION

GEOMETRICS AND
ROAD GRADES

KAUMUALII HIGHWAY
IMPROVEMENTS AT HALEWILI ROAD
Fed. Aid Proj. No. STP-050-1(9)

Scale: 1"=20' Date: Feb., 1995

SHEET No. 1 OF 1 SHEETS

"AS-BUILT"