


FED. ROAD DIST. NO.	STATE	FED. AID PROJ. NO.	FISCAL YEAR	SHEET NO.	TOTAL SHEETS
HAWAII	HAW.	STP-050-1(9)	1995	9	29

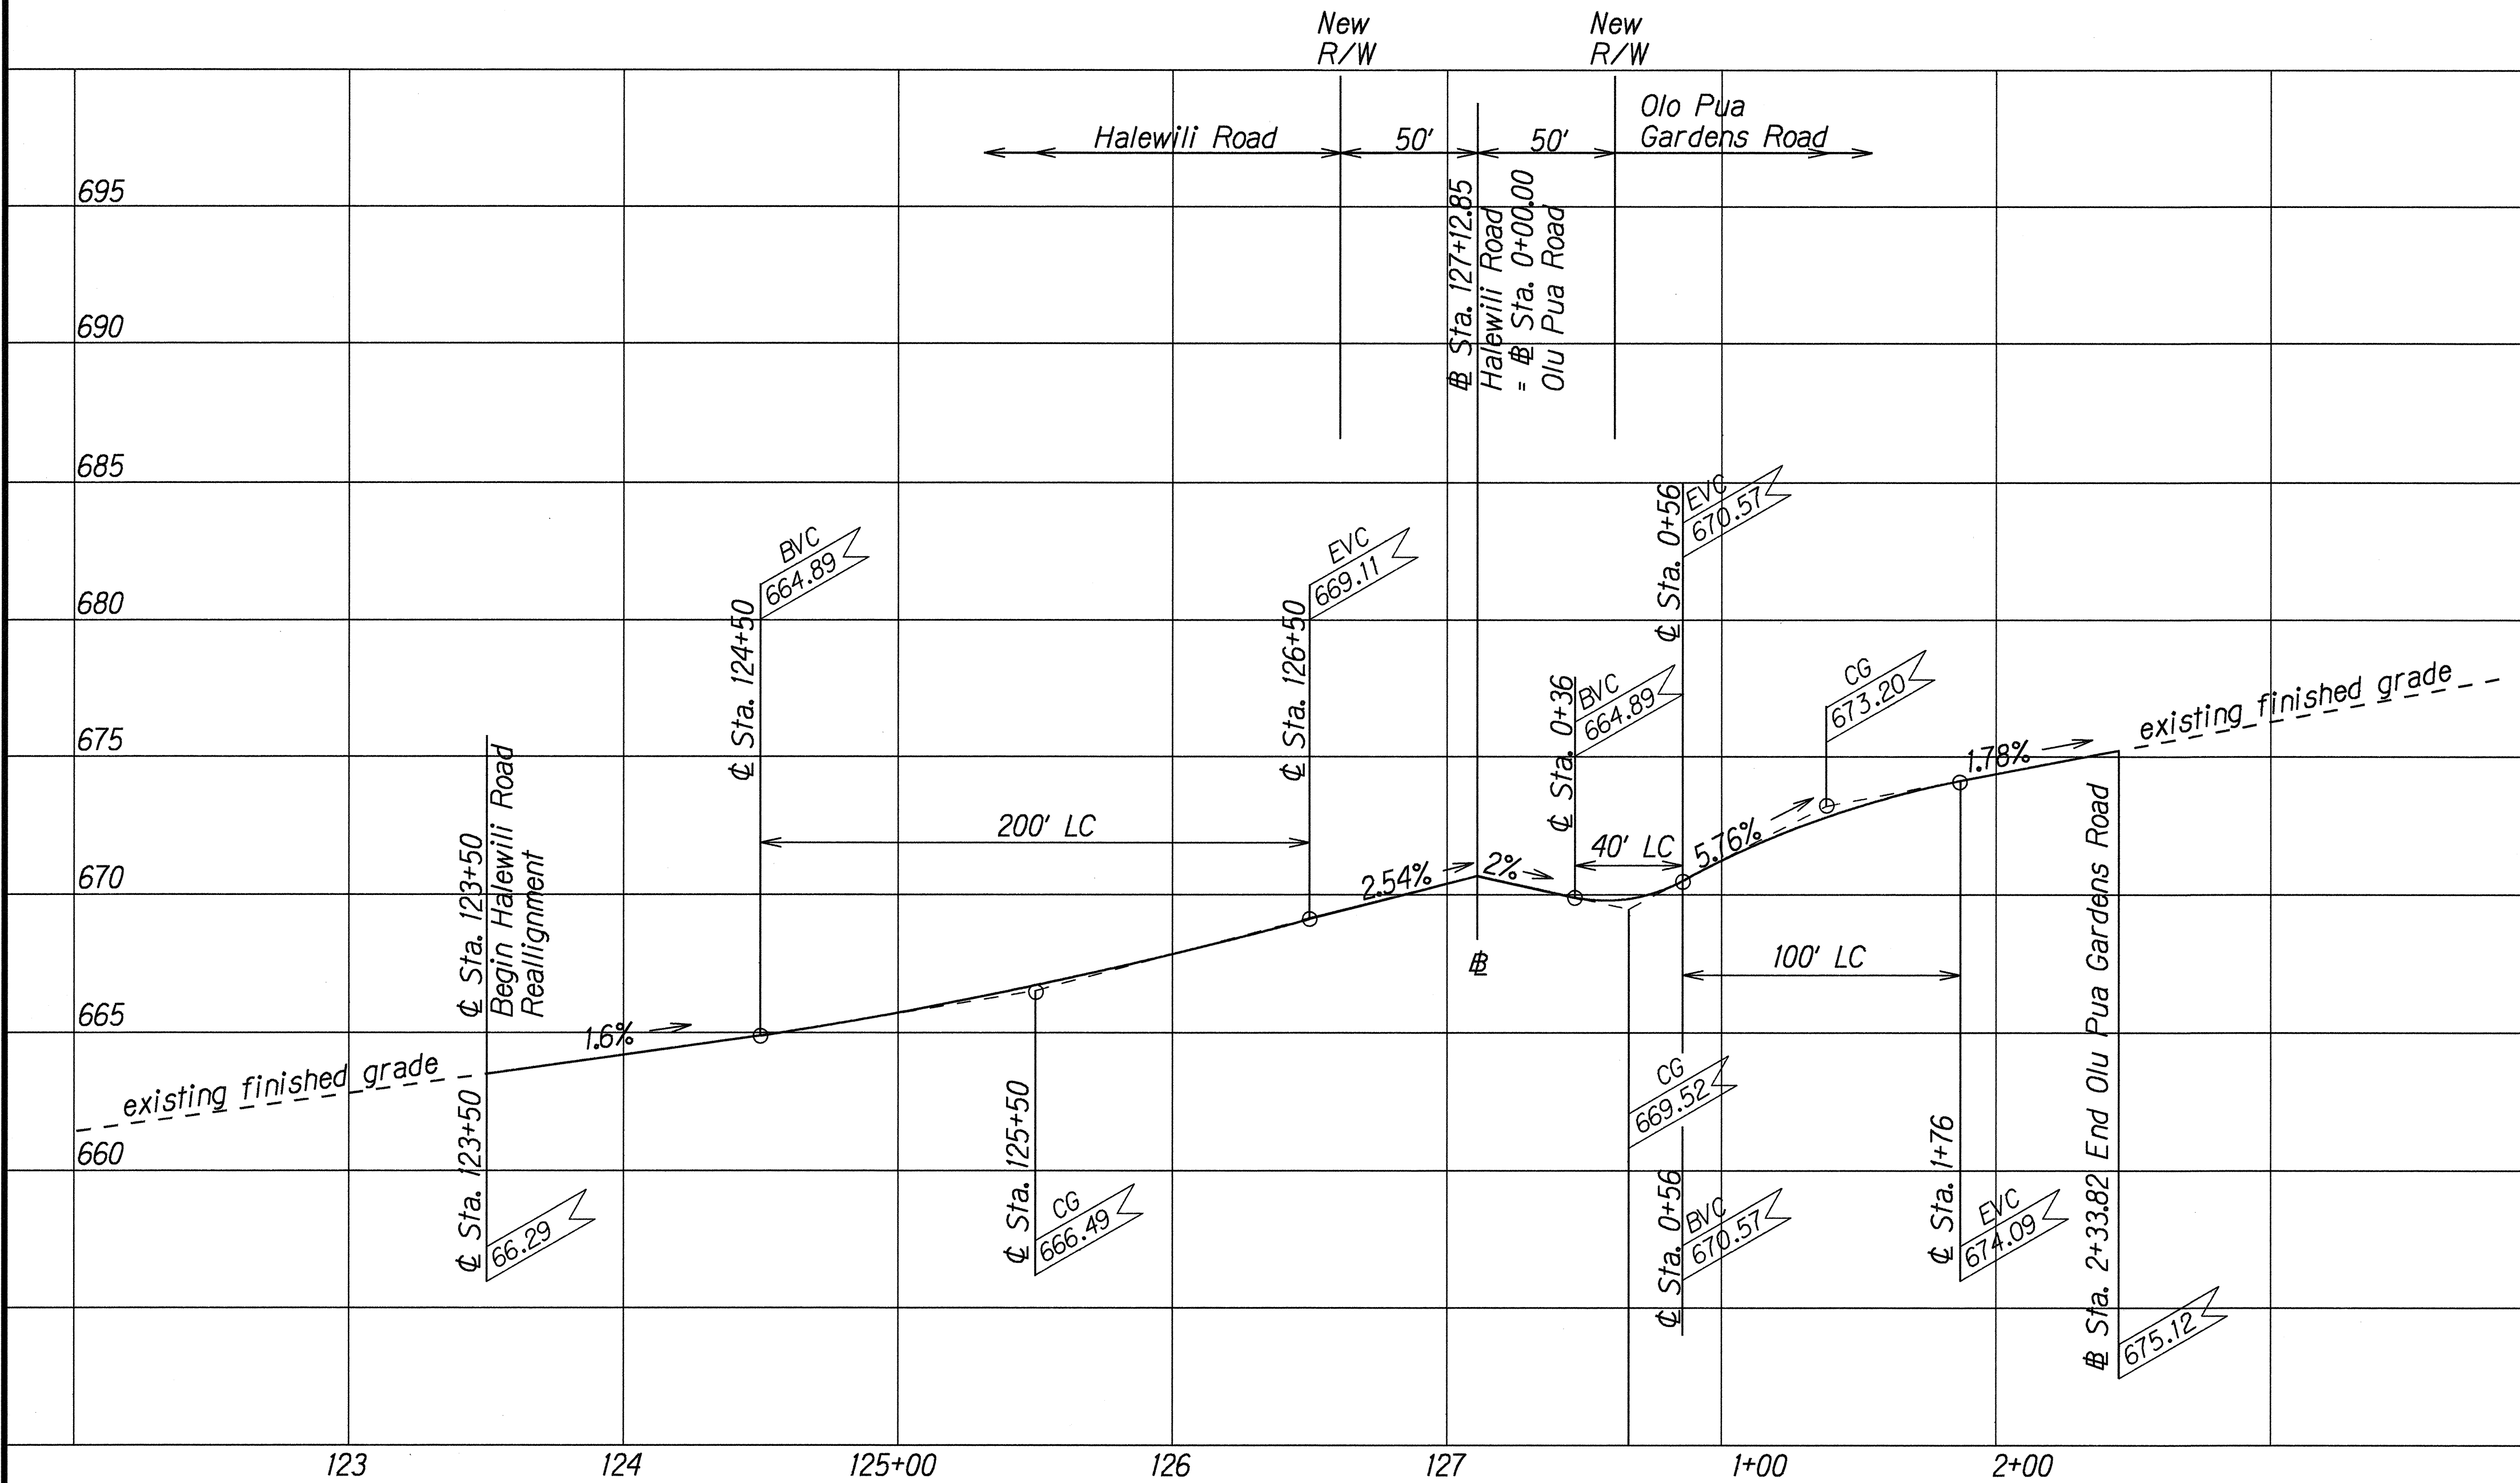

Scale:
 Horiz.: 1"=40.0'
 Vert.: 1"=4.0'

ORIGINAL PLAN	SURVEY PLOTTED BY	DATE
NOTED BY	DRAWN BY	4/1994
CHECKED BY	DESIGNED BY	
	QUANTITIES BY	
	CHECKED BY	

STATE OF HAWAII
 DEPARTMENT OF TRANSPORTATION
 HIGHWAYS DIVISION
PROFILE
HALEWILI ROAD/OLO PUA GARDENS ROAD
KAUMUALII HIGHWAY IMPROVEMENTS AT HALEWILI ROAD
 Fed. Aid Project No. STP-050-1(9)
 Scale: As Shown Date: Feb., 1995
 SHEET No. 1 OF 1 SHEETS