




FED. ROAD DIST. NO.	STATE	FED. AID PROJ. NO.	FISCAL YEAR	SHEET NO.	TOTAL SHEETS
HAWAII	HAW.	STP-050-1(9)	1995	4	29

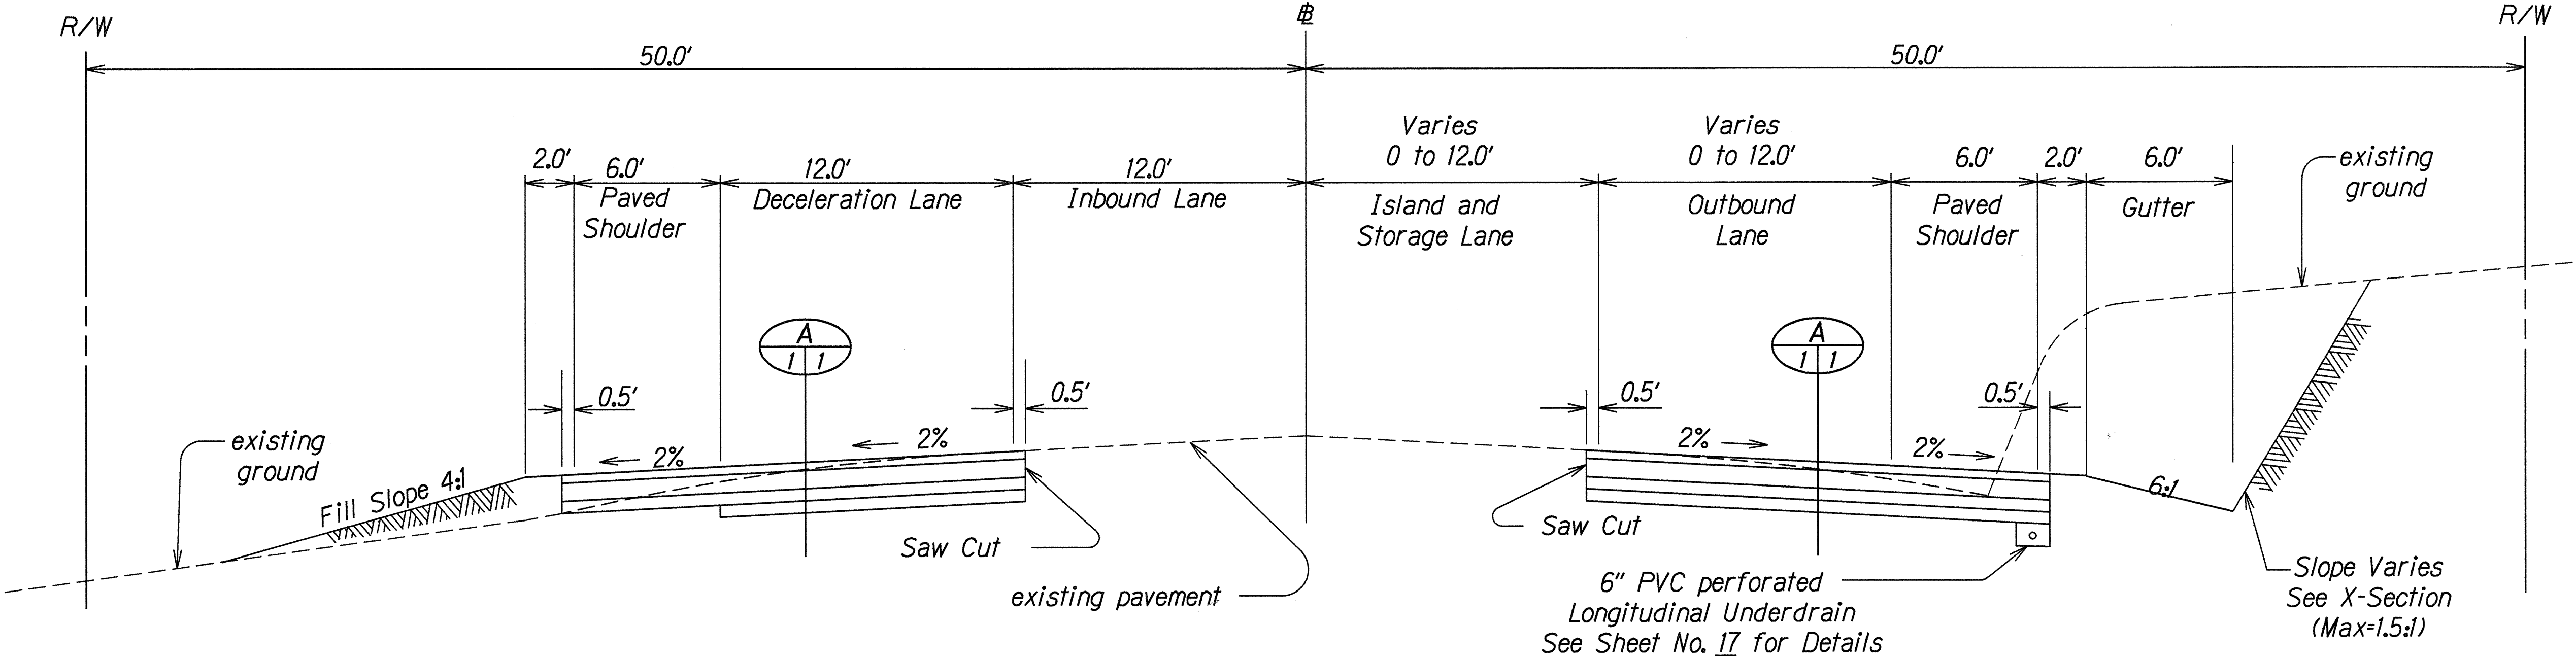


TYPICAL SECTION - KAUMUALII HIGHWAY
 # Sta. 30+78 to # Sta. 37+00 Lt.
 # Sta. 34+20 to # Sta. 39+20 Rt.
 (Exception @ Halewili Road Connection)
 Scale: 1/4" = 1'-0"

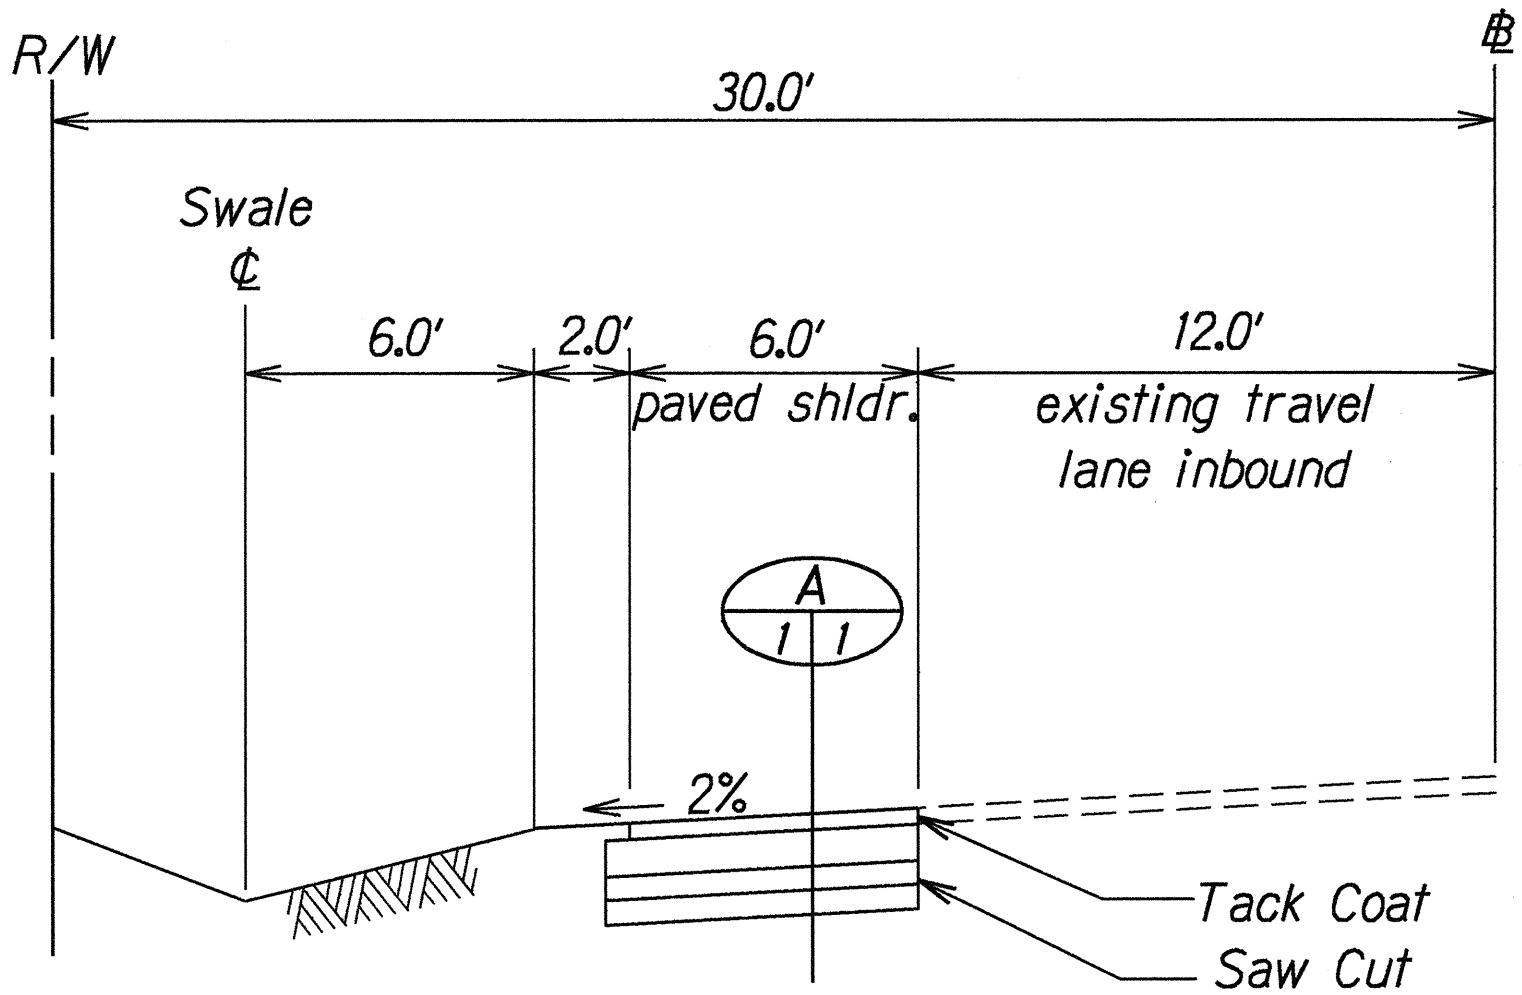

TYPICAL SECTION - KAUMUALII HIGHWAY
 # Sta. 30+00 to # Sta. 30+78 Lt.
 Scale: 1/4" = 1'-0"

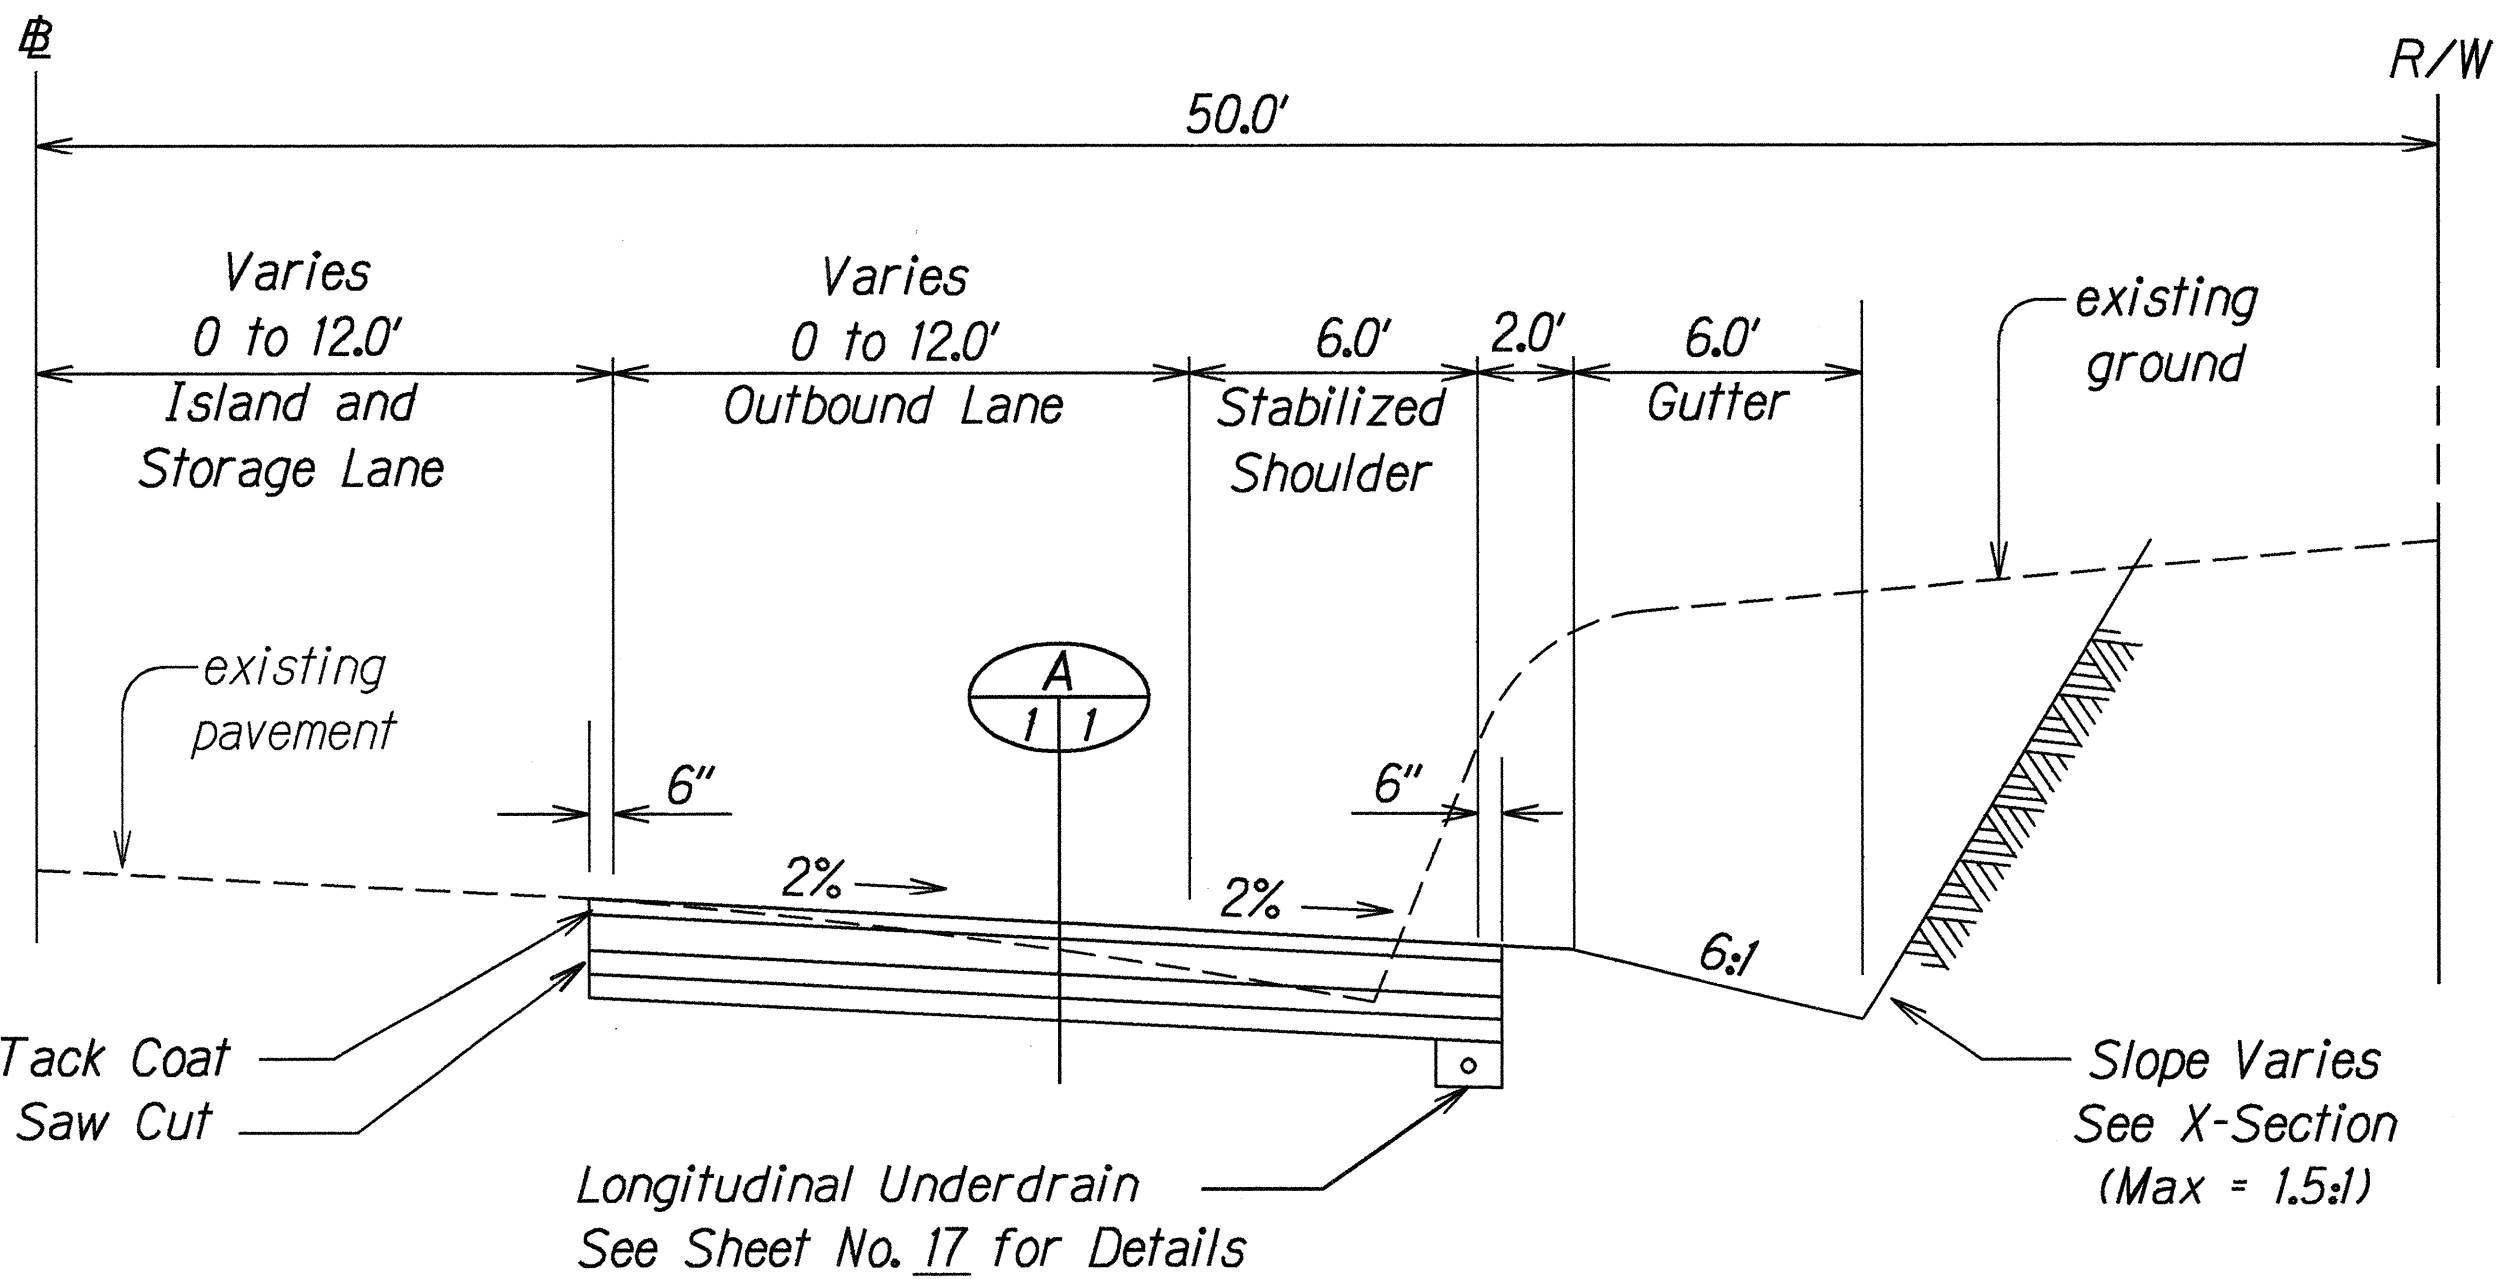

TYPICAL SECTION - KAUMUALII HIGHWAY
 # Sta. 24+00 to # Sta. 30+40 Rt.
 Scale: 1/4" = 1'-0"

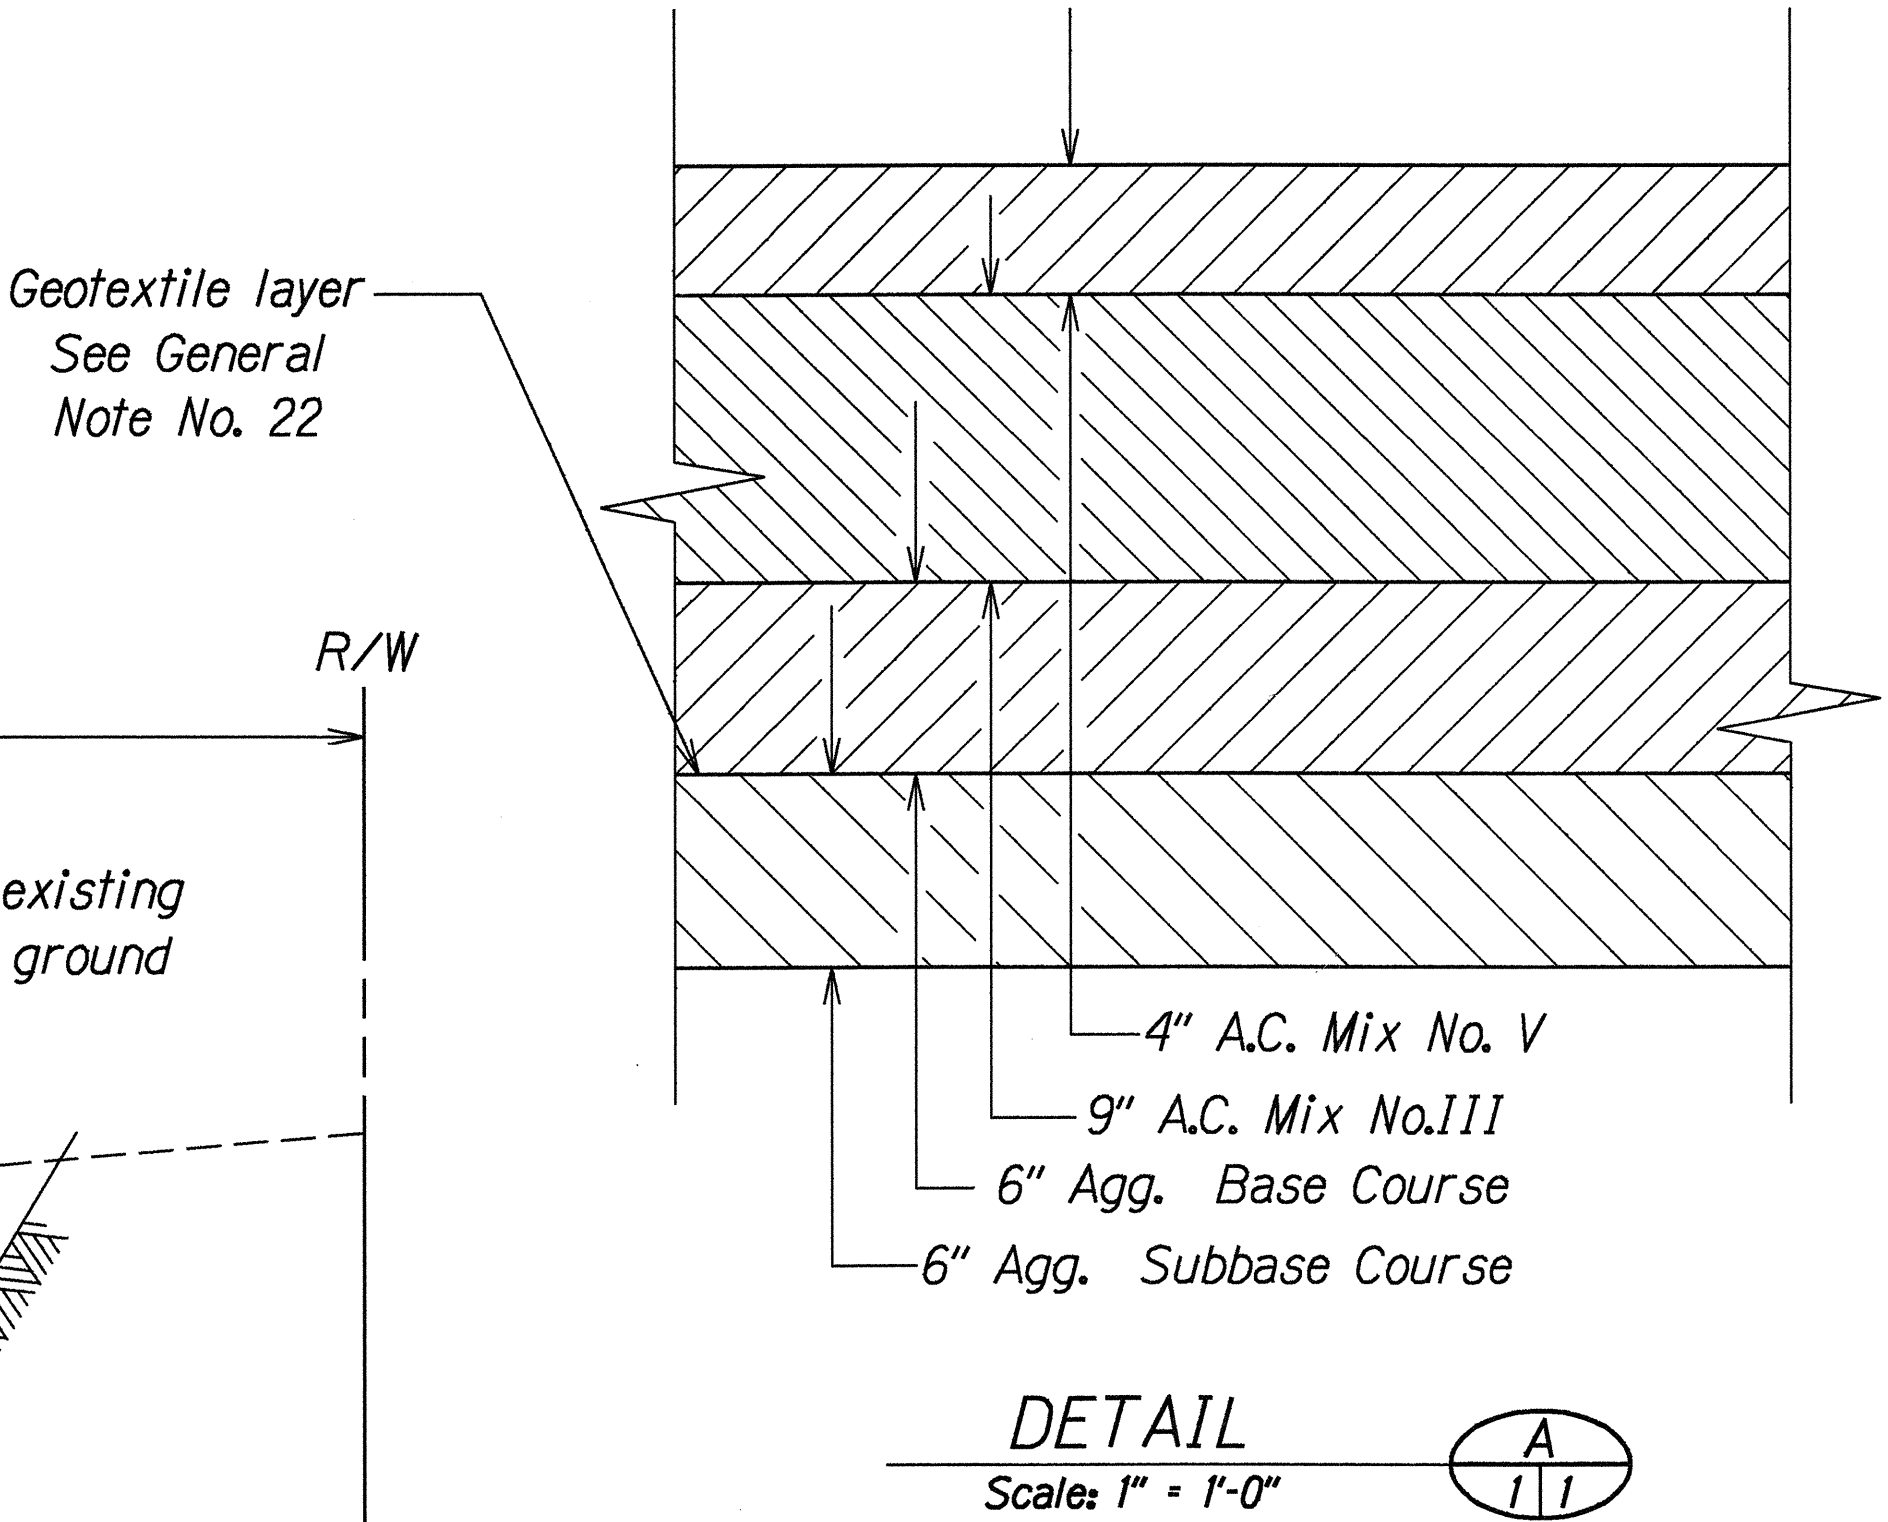

DETAIL
 Scale: 1" = 1'-0"

STATE OF HAWAII

DEPARTMENT OF TRANSPORTATION

HIGHWAYS DIVISION

TYPICAL SECTIONS

KAUMUALII HIGHWAY

IMPROVEMENTS AT HALEWILI ROAD

Fed. Aid. Proj. No. STP-050-1(9)

Scale: As Shown

Date: Feb., 1995



SHEET No. 1

OF 3

SHEETS

ORIGINAL PLAN	SURVEY PLOTTED BY	DATE
NOTE BOOK	DRAWN BY	
Redgery	CHECKED BY	
2/20/95	CHECKED BY	

FED. ROAD DIST. NO.	STATE	FED. AID PROJ. NO.	FISCAL YEAR	SHEET NO.	TOTAL SHEETS
HAWAII	HAW.	STP-050-1(9)	1995	5	29

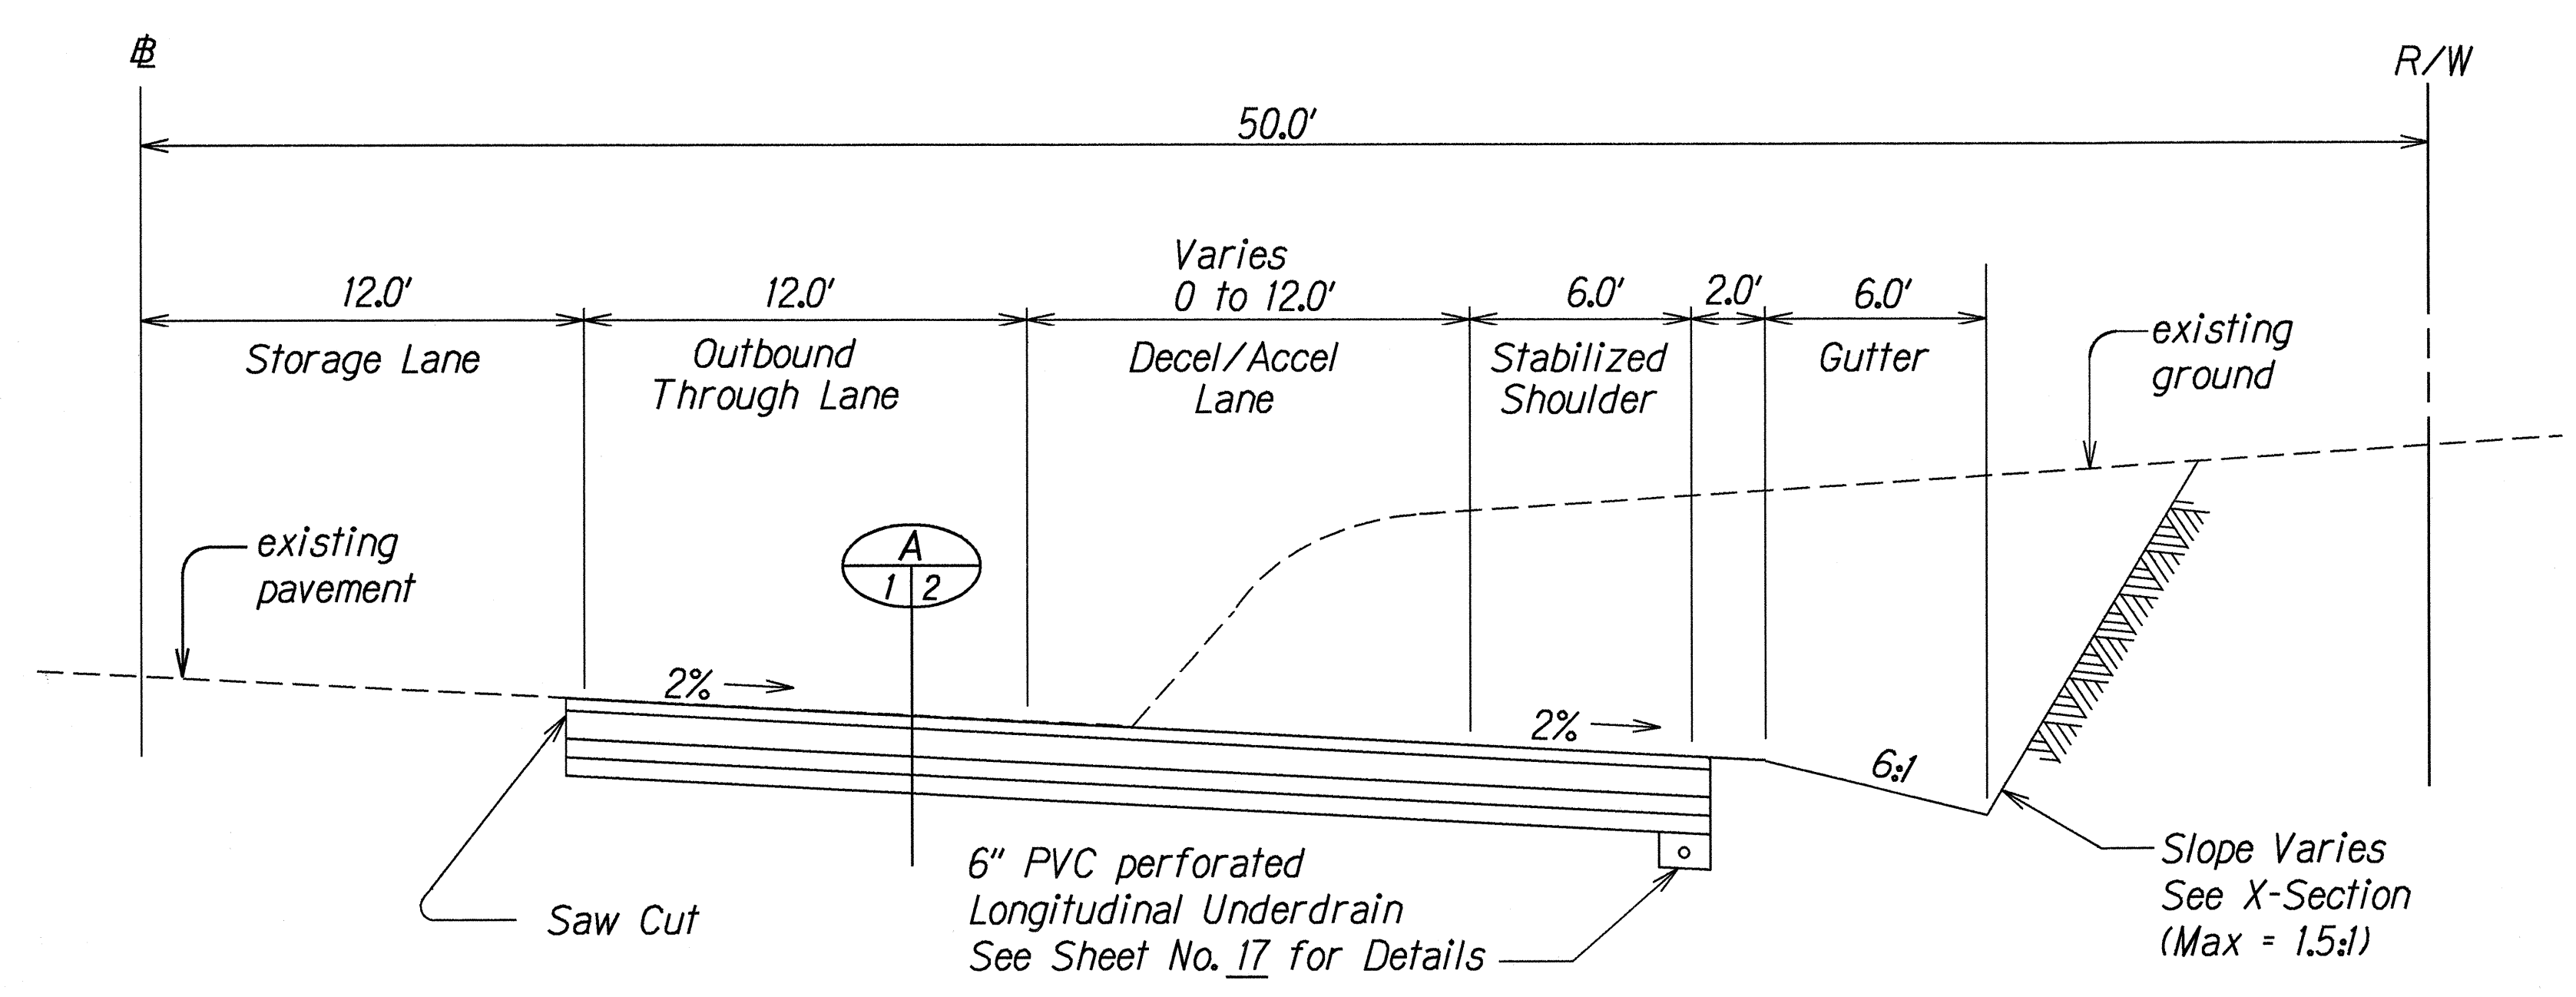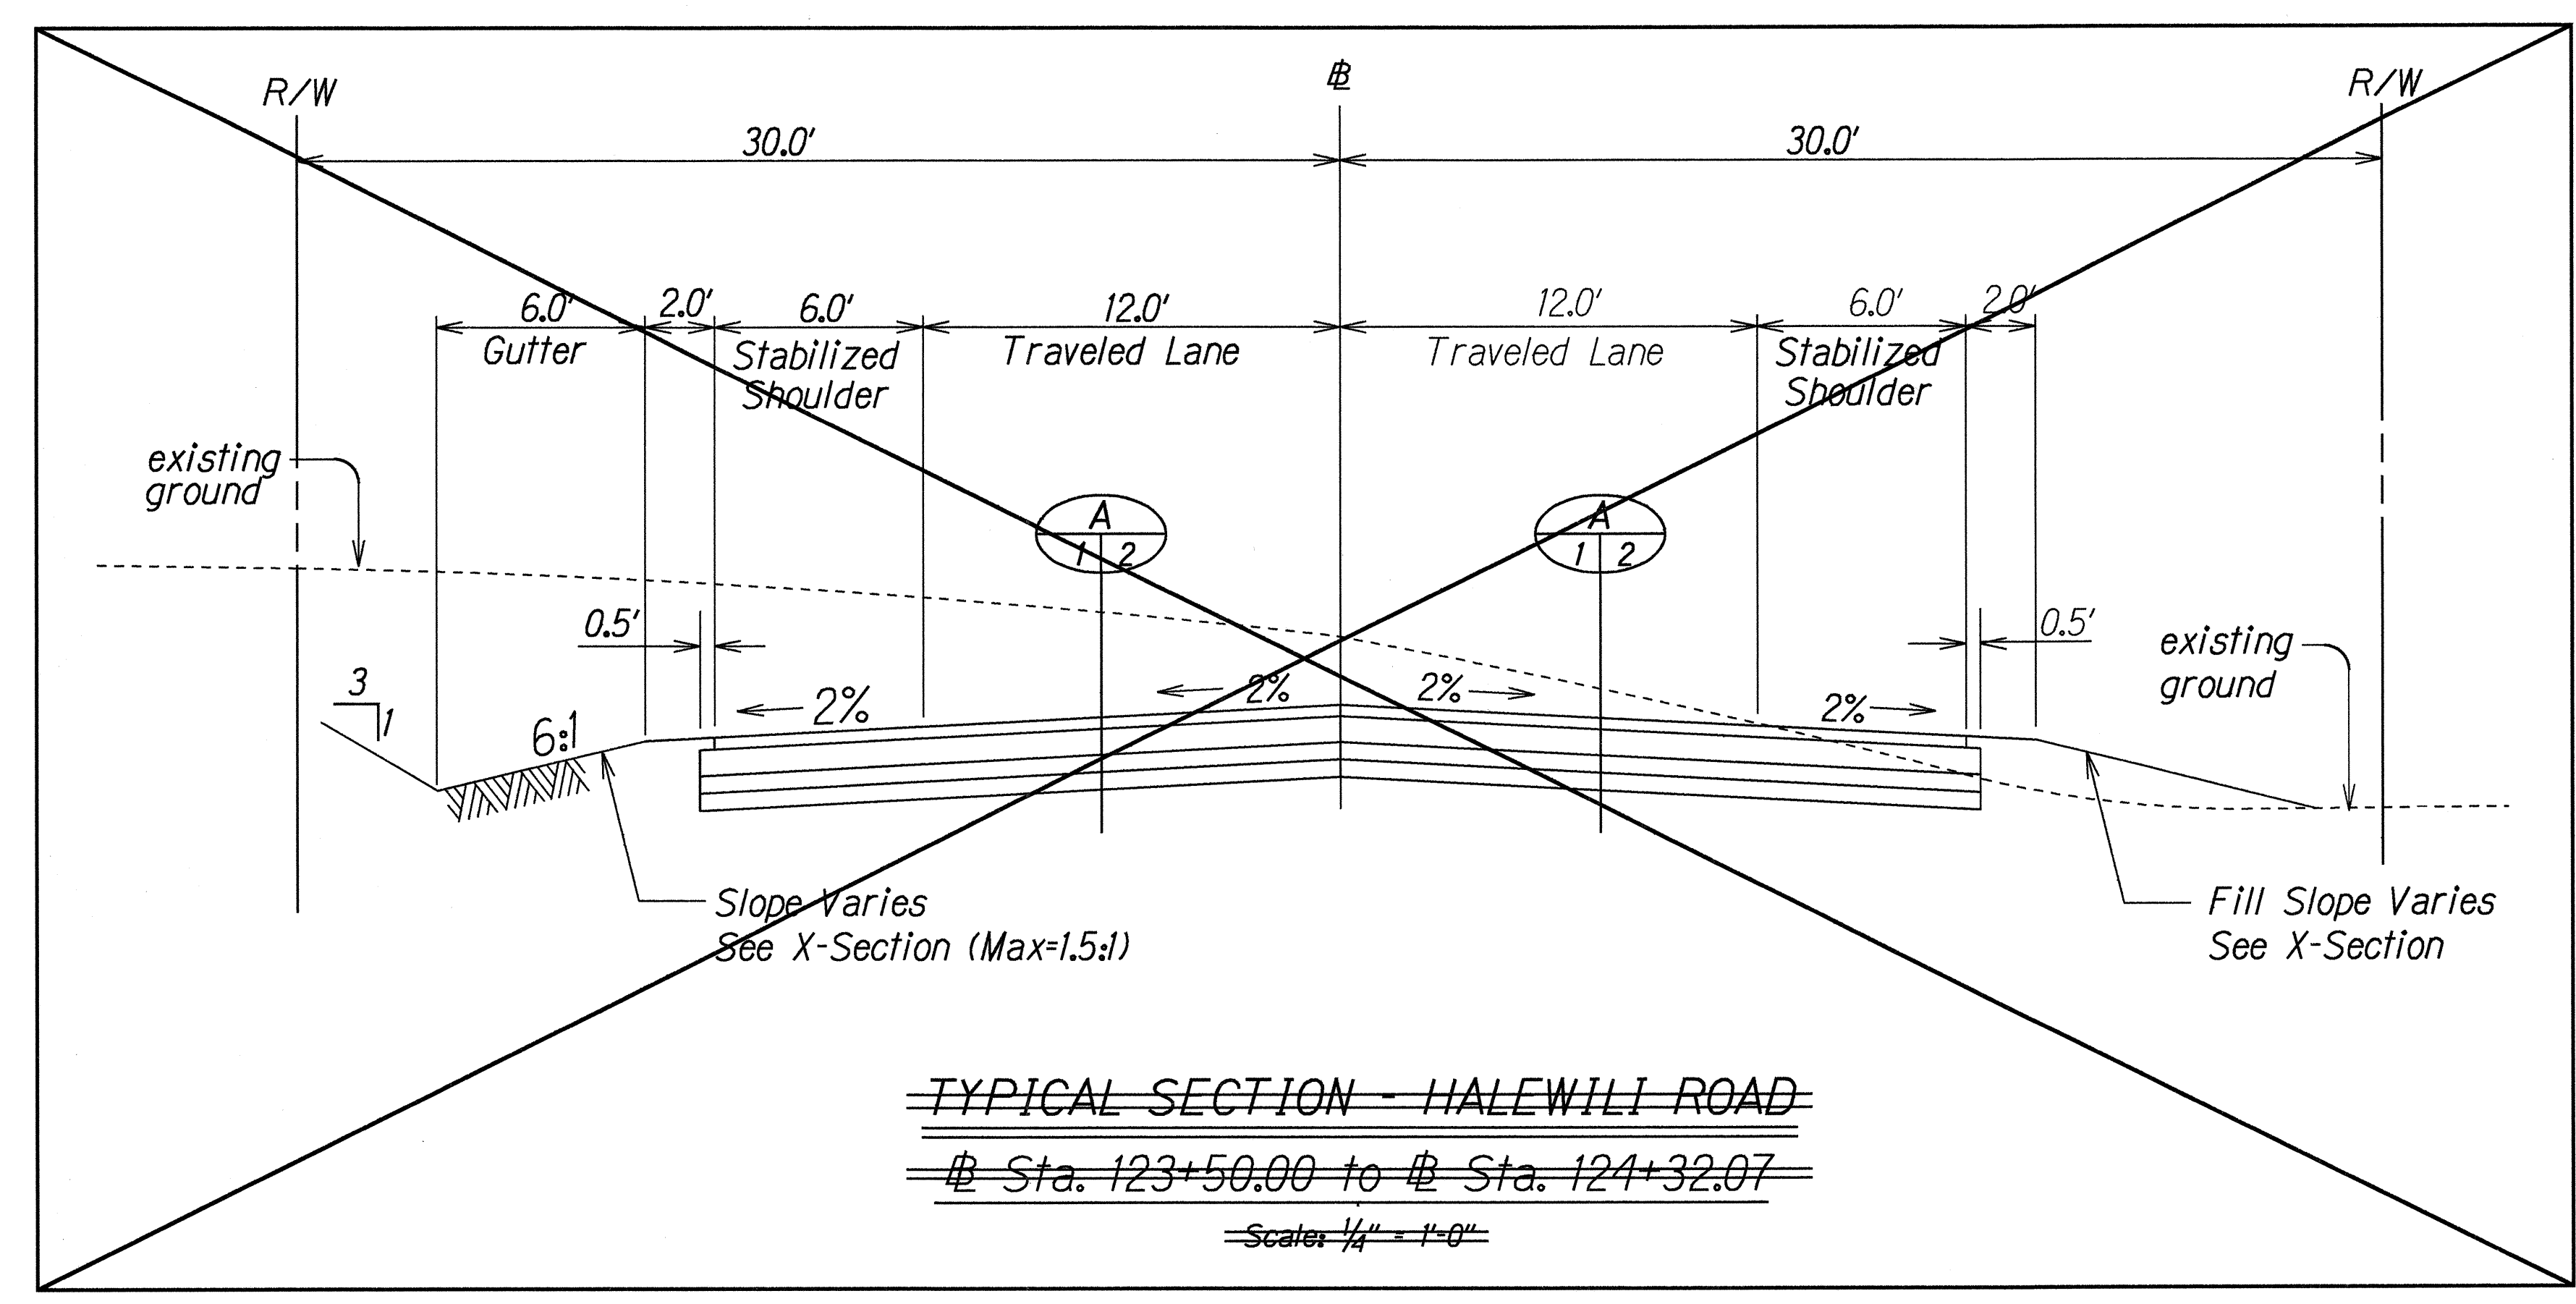

TYPICAL SECTION - KAUMUALII HIGHWAY
 Sta. 30+40.00 to Sta. 34+20.00 Rt.
 (Exception @ Olu Pua Gardens Road Connection)
 Scale: 1/4" = 1'-0"

LEGEND FOR AS-BUILT POSTINGS	
	Squiggly line for as-built deletion
	Double line for as-built deletion
Roadway	Text for as-built posting




STATE OF HAWAII
DEPARTMENT OF TRANSPORTATION
HIGHWAYS DIVISION

TYPICAL SECTIONS
KAUMUALII HIGHWAY
IMPROVEMENTS AT HALEWILI ROAD
Fed. Aid. Proj. No. STP-050-1(9)
Scale: As Shown Date: Feb., 1995
SHEET No. 2 OF 3 SHEETS

SURVEY PLOTTED BY	DATE
DRAWN BY	
TRACED BY	
NOTED BY	
QUANTITIES BY	
CHECKED BY	

"AS-BUILT"

FED. ROAD DIST. NO.	STATE	FED. AID PROJ. NO.	FISCAL YEAR	SHEET NO.	TOTAL SHEETS
HAWAII	HAW.	STP-050-1(9)	1995	6	29

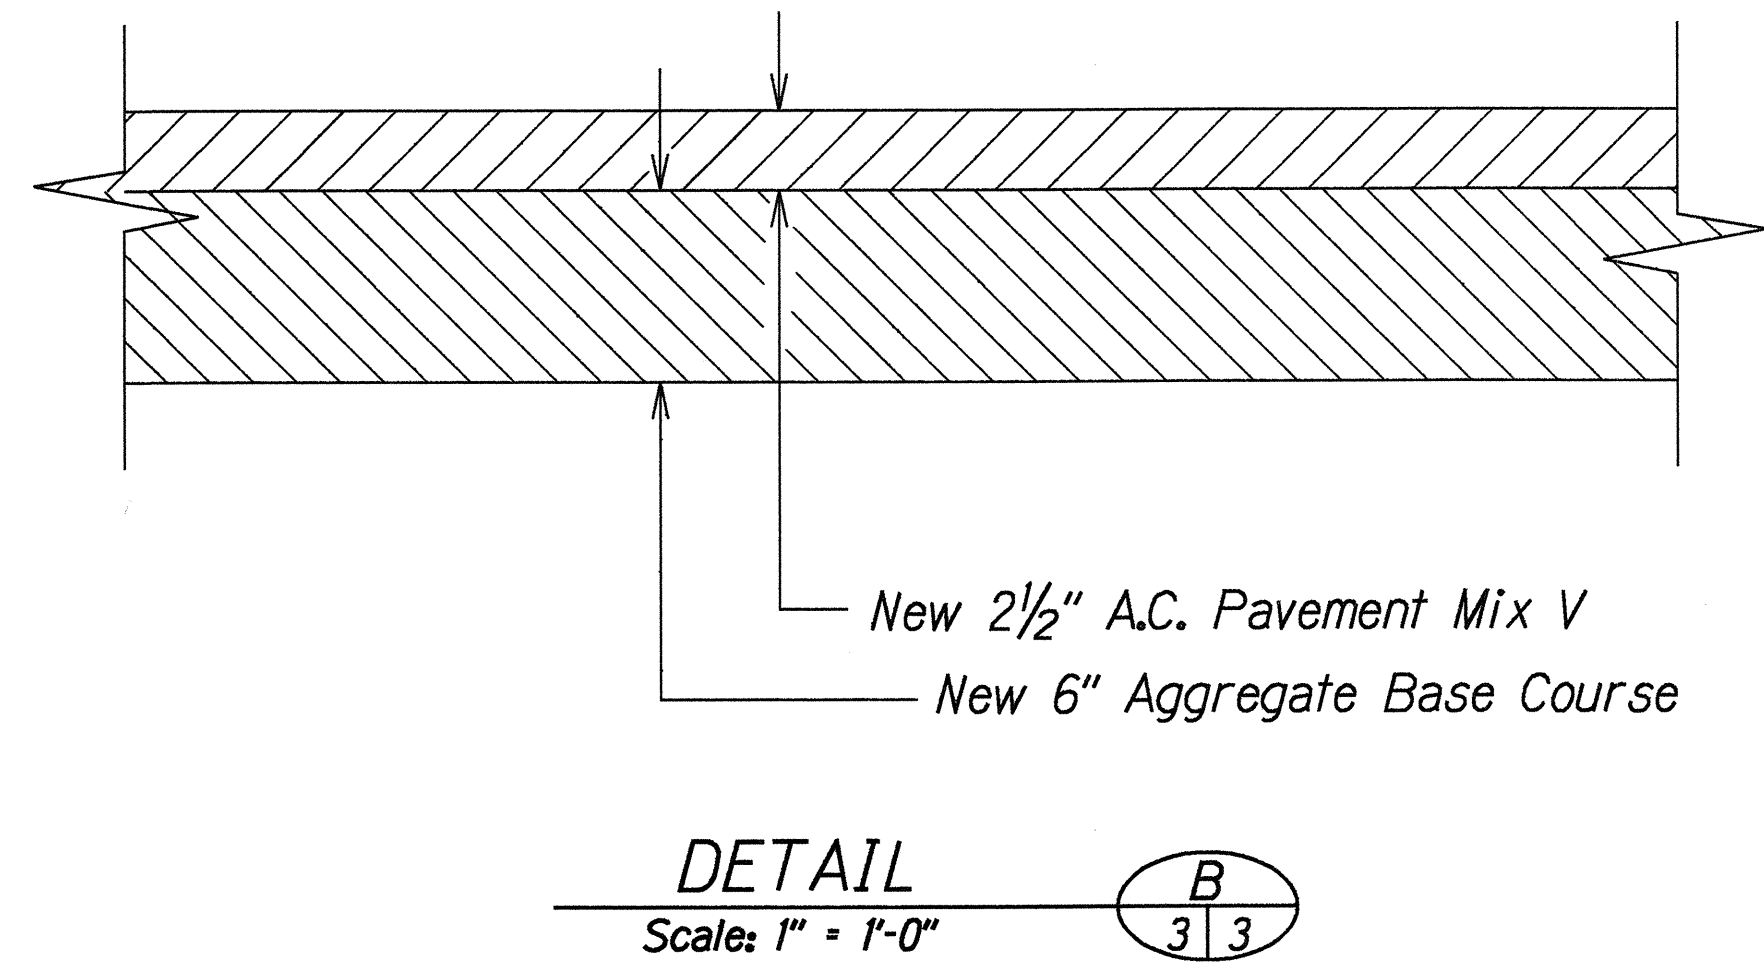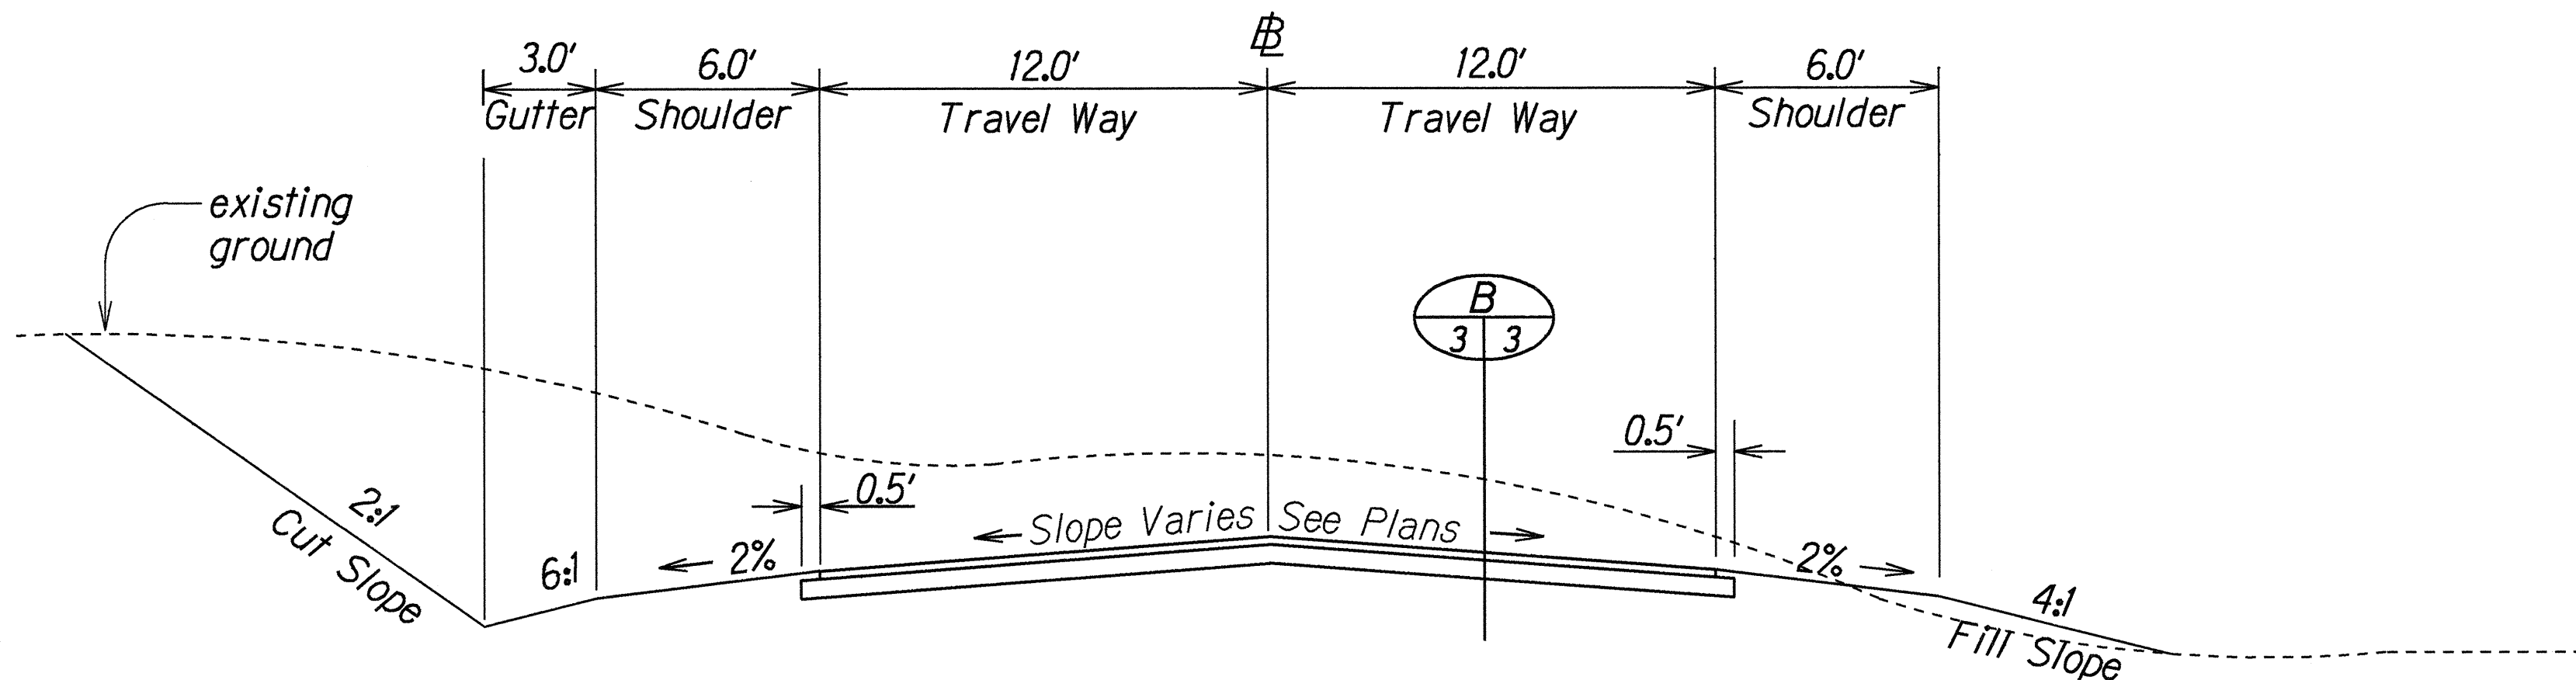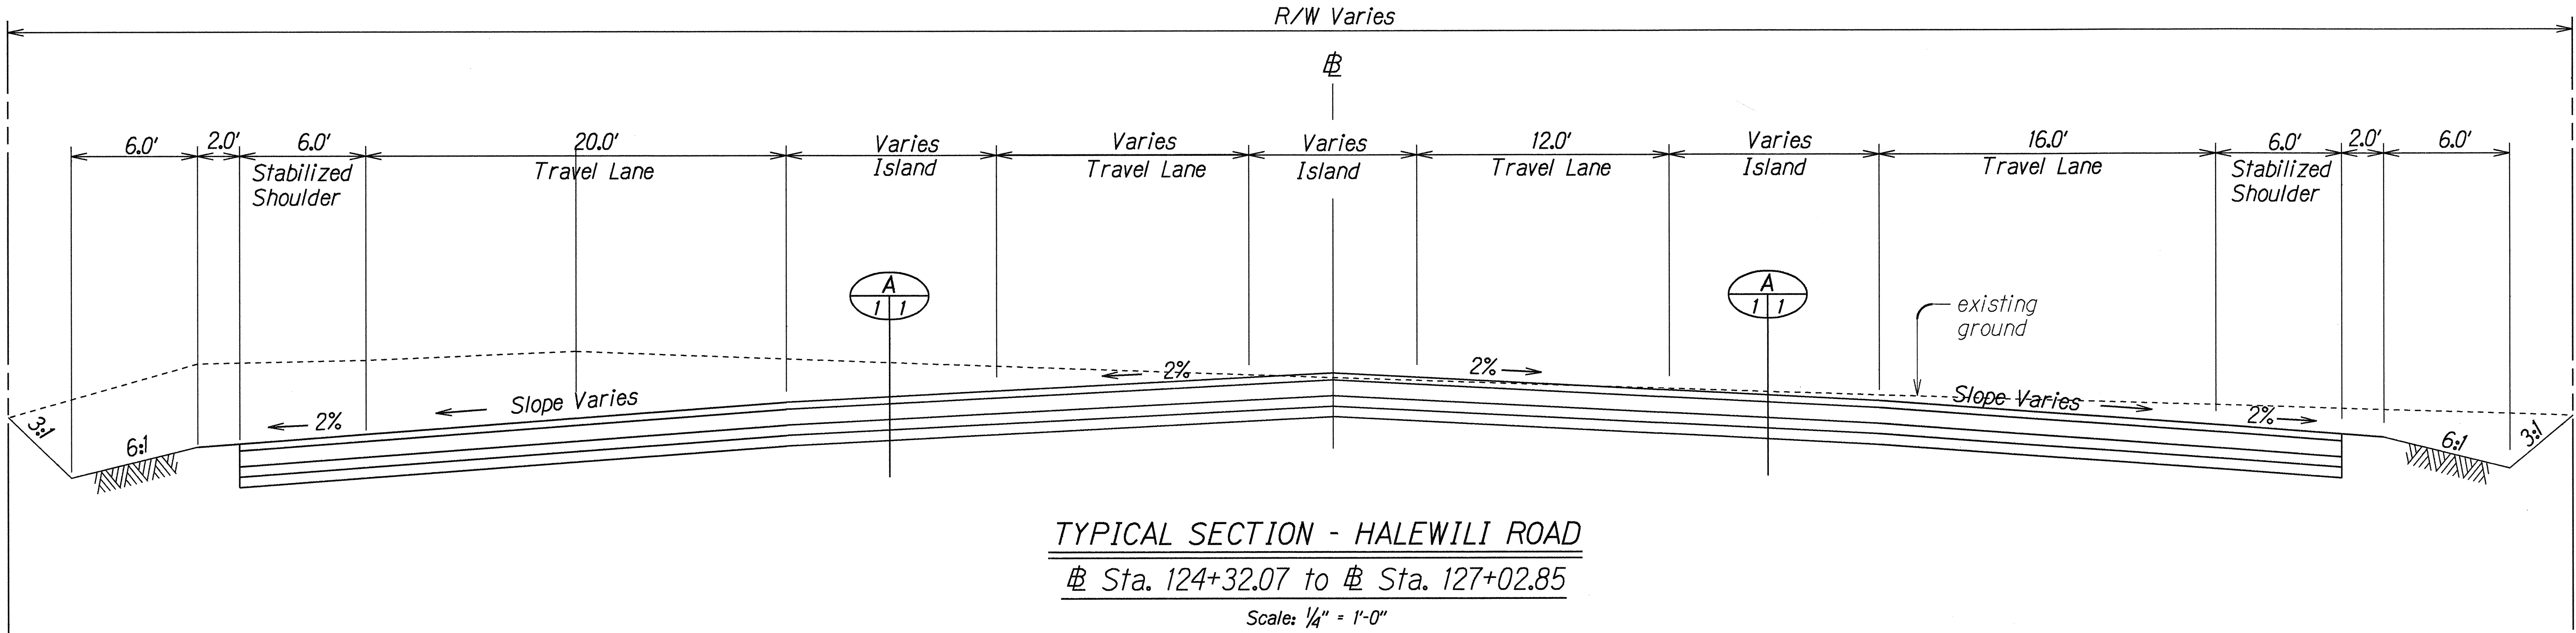

ORIGINAL PLAN	DATE
DRAWN BY	
CHECKED BY	
NOTED BY	
DESIGNED BY	
QUANTITIES BY	
CHECKED BY	
DATE	

STATE OF HAWAII
DEPARTMENT OF TRANSPORTATION
HIGHWAYS DIVISION

TYPICAL SECTIONS
KAUMUALII HIGHWAY
IMPROVEMENTS AT HALEWILI ROAD
Fed. Aid. Proj. No. STP-050-1(9)

Scale: As Shown Date: Feb, 1995

SHEET No. 3 OF 3 SHEETS