



FED. ROAD DIST. NO.	STATE	FED. AID PROJ. NO.	FISCAL YEAR	SHEET NO.	TOTAL SHEETS
HAWAII	HAW.	STP-050-1(24)	2002	35	40

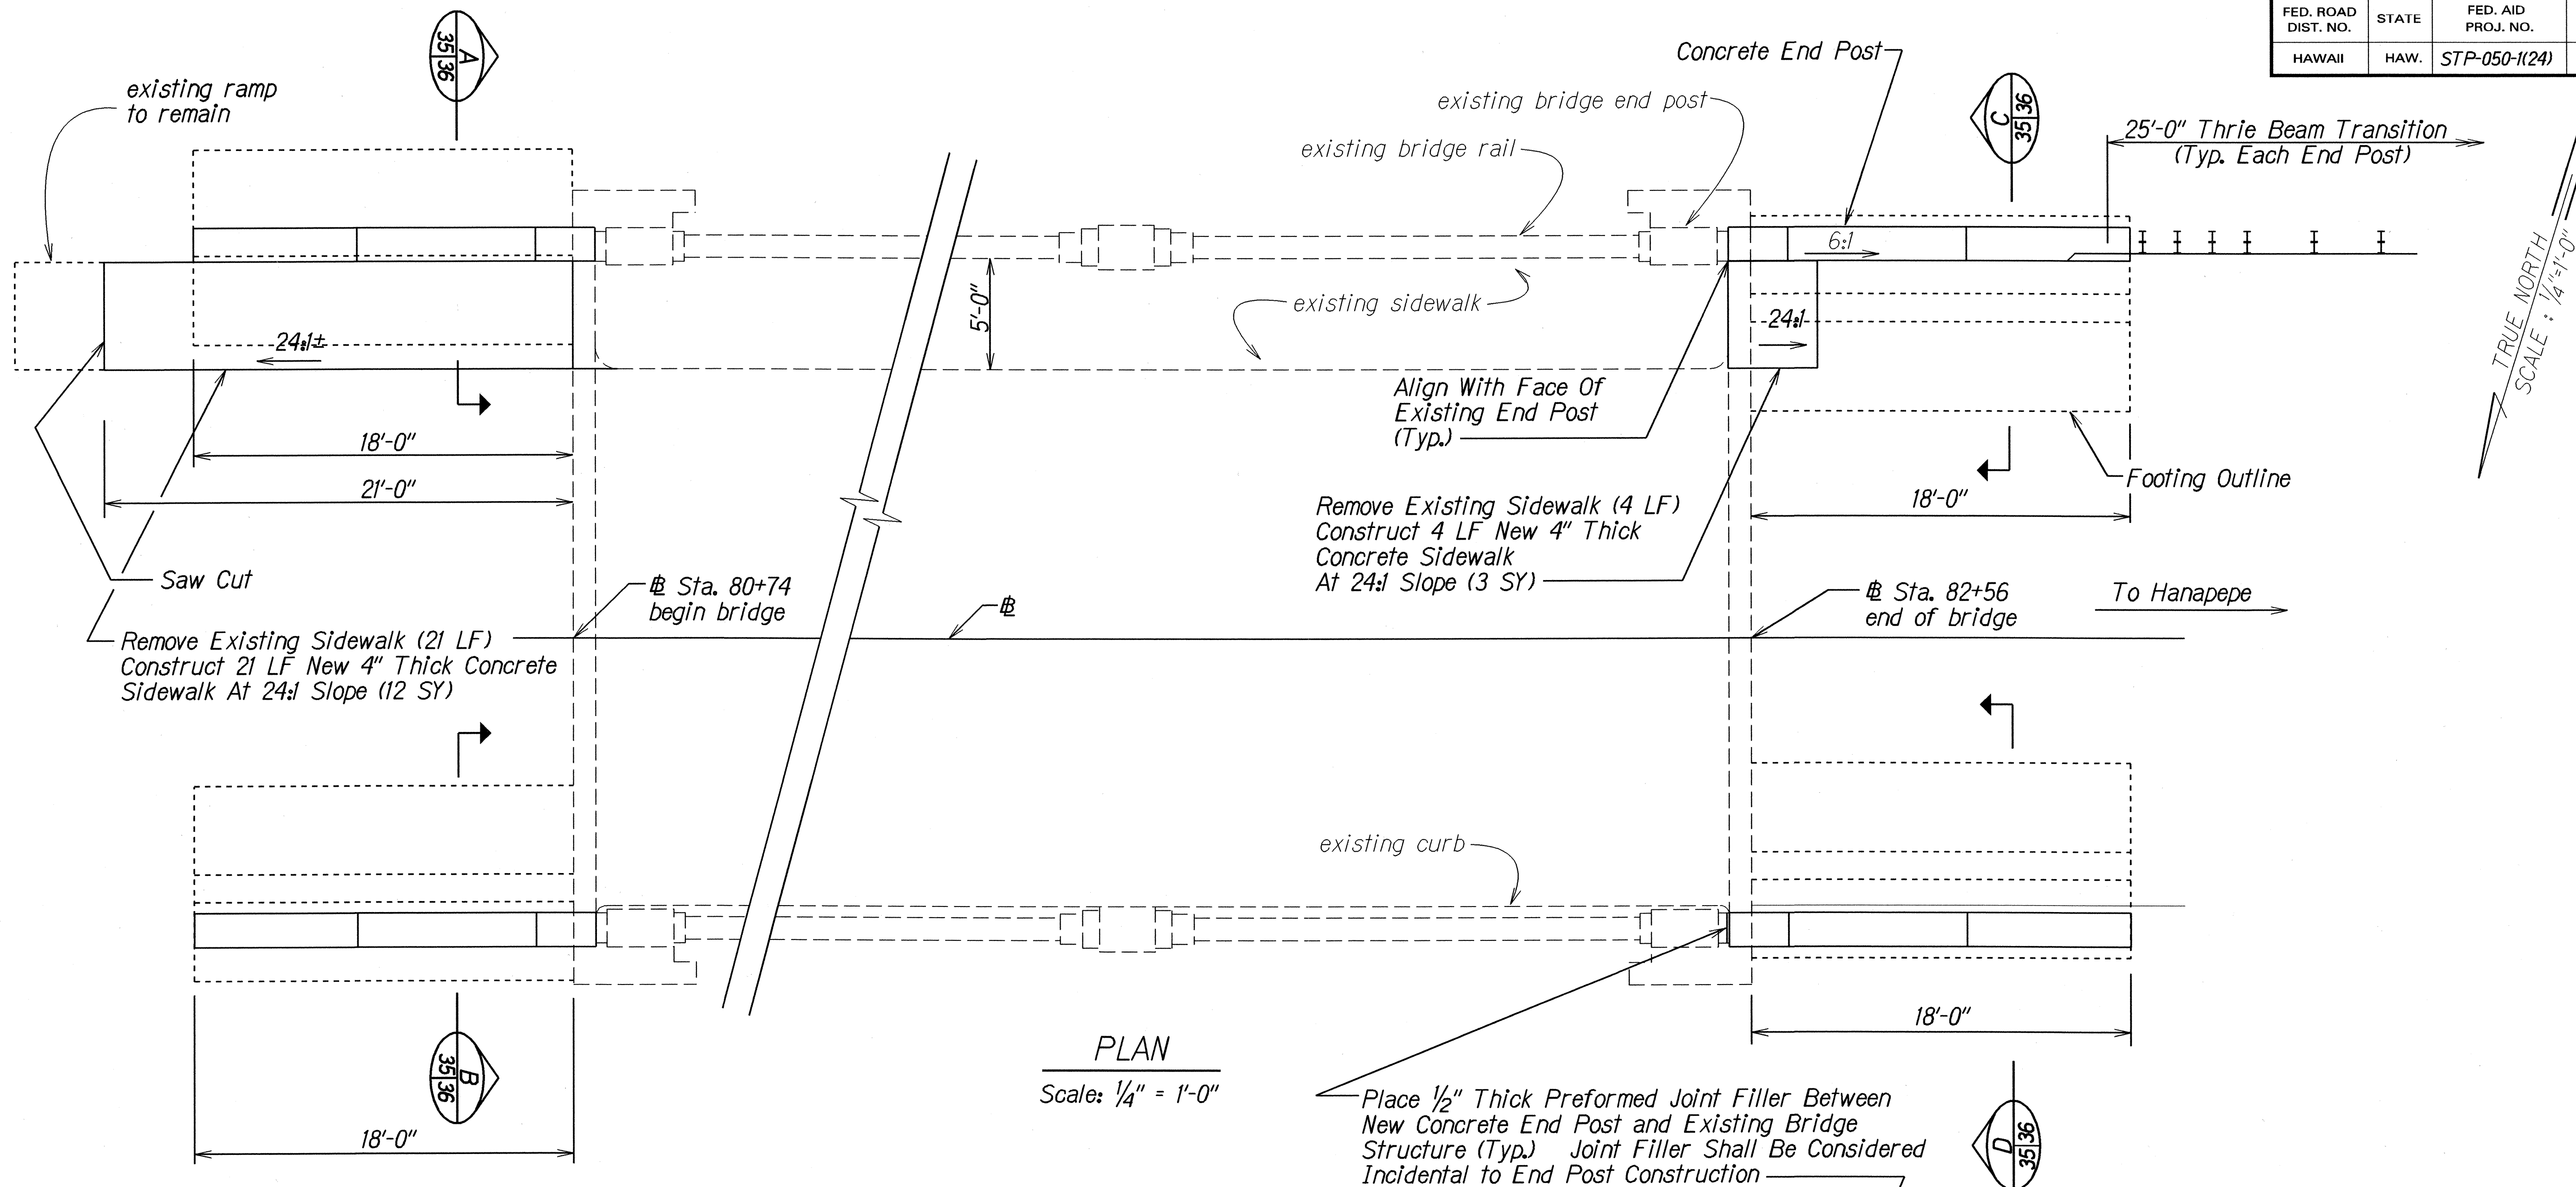

PLAN
Scale: 1/4" = 1'-0"

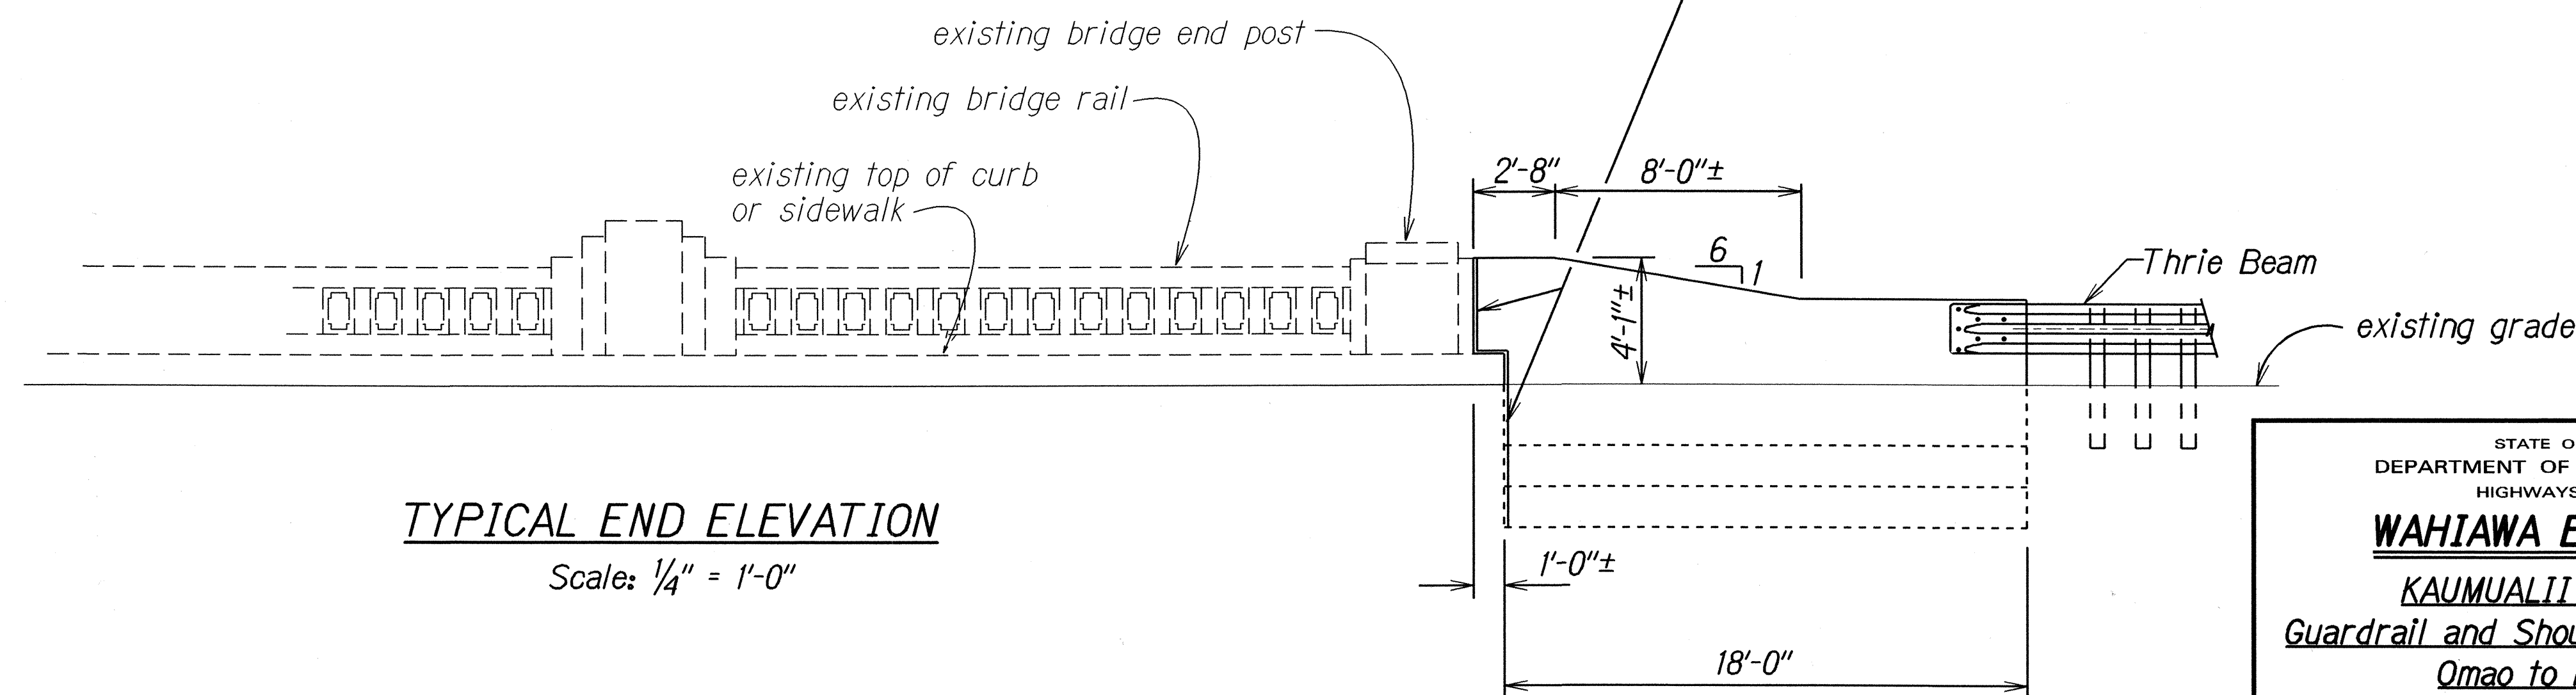


TYPICAL END ELEVATION
Scale: 1/4" = 1'-0"


DESIGNED BY	DATE	DATE
TRACED BY		
QUANTITIES BY		
CHECKED BY		

STATE OF HAWAII
DEPARTMENT OF TRANSPORTATION
HIGHWAYS DIVISION
WAHIAWA END POSTS
KAUMUALII HIGHWAY
Guardrail and Shoulder Improvements
Omao to Hanapepe
Fed. Aid Project No. STP-050-1(24)
Scale: As Shown Date: July 2001
SHEET No. 1 OF 2 SHEETS


FED. ROAD DIST. NO.	STATE	FED. AID PROJ. NO.	FISCAL YEAR	SHEET NO.	TOTAL SHEETS
HAWAII	HAW.	STP-050-1(24)	2002	36	40

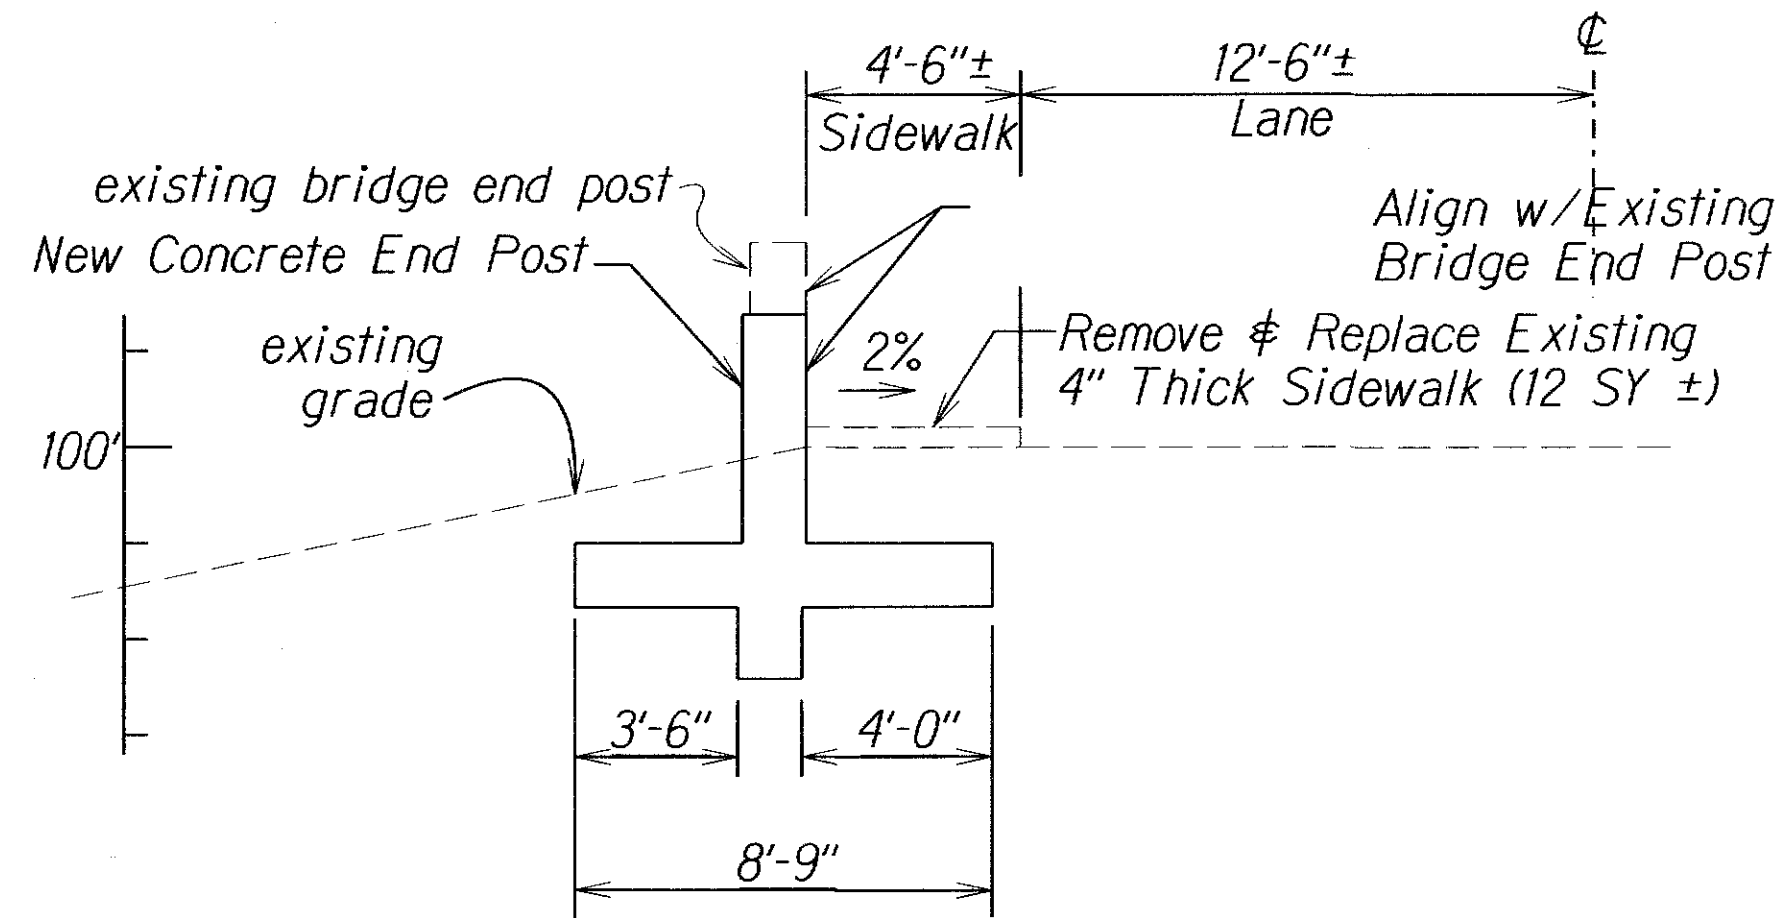


A SECTION - LIHUE END - MAKAI
Scale: 1/4"=1'-0"

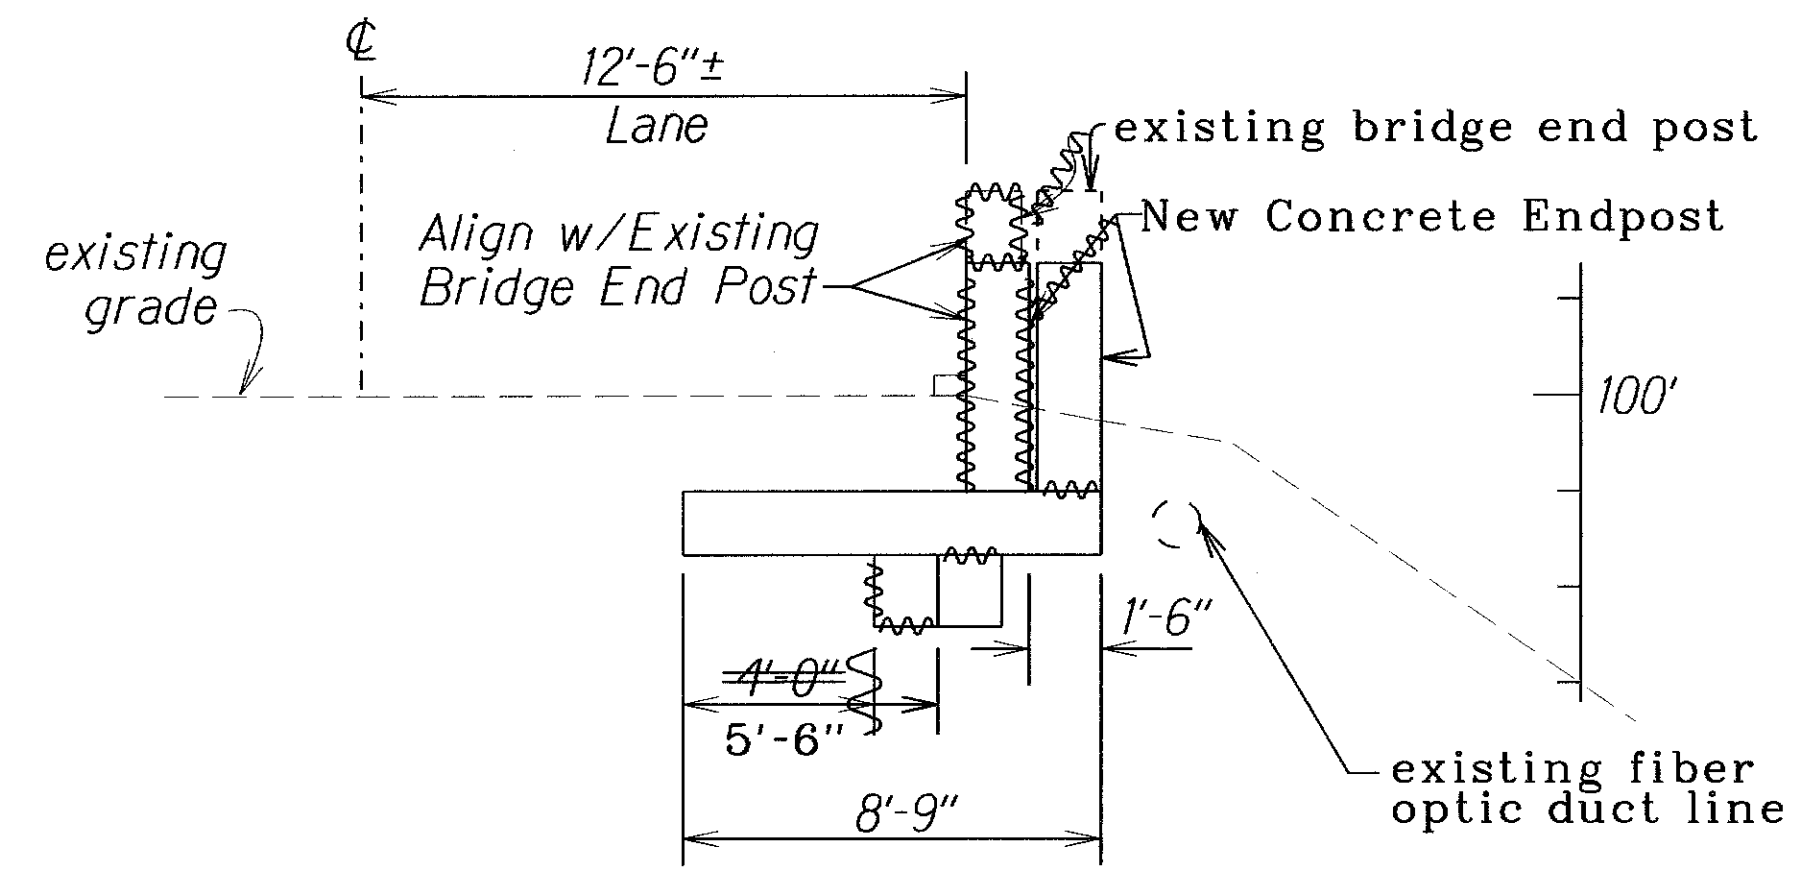

B SECTION - LIHUE END - MAUKA
Scale: 1/4"=1'-0"

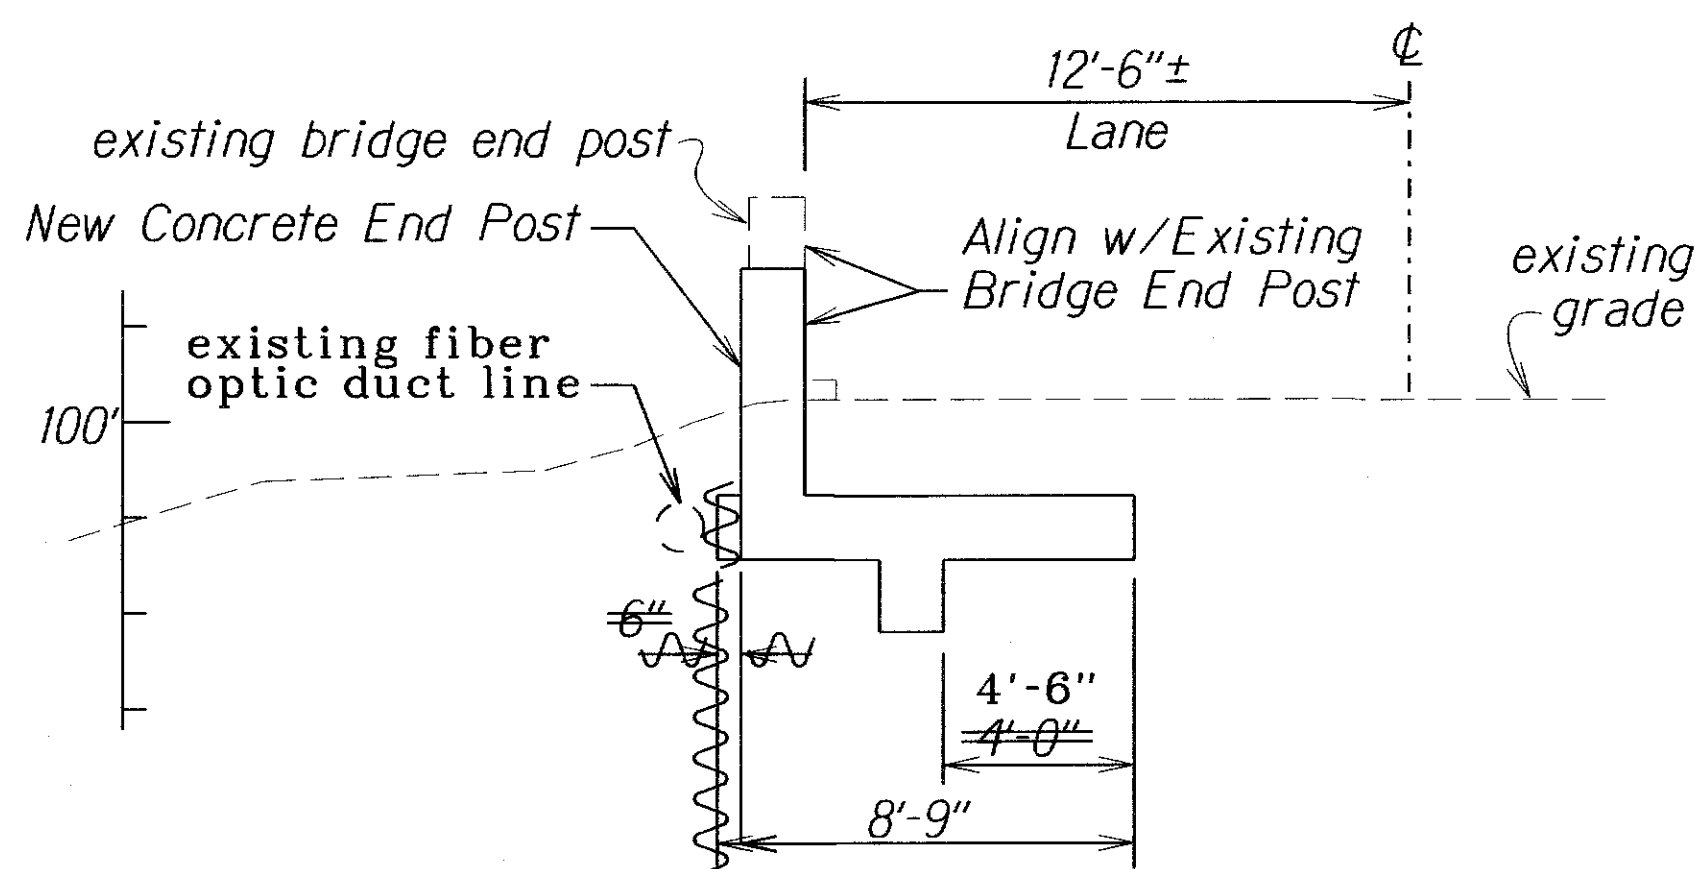

D SECTION - WAIMEA END - MAUKA
Scale: 1/4"=1'-0"

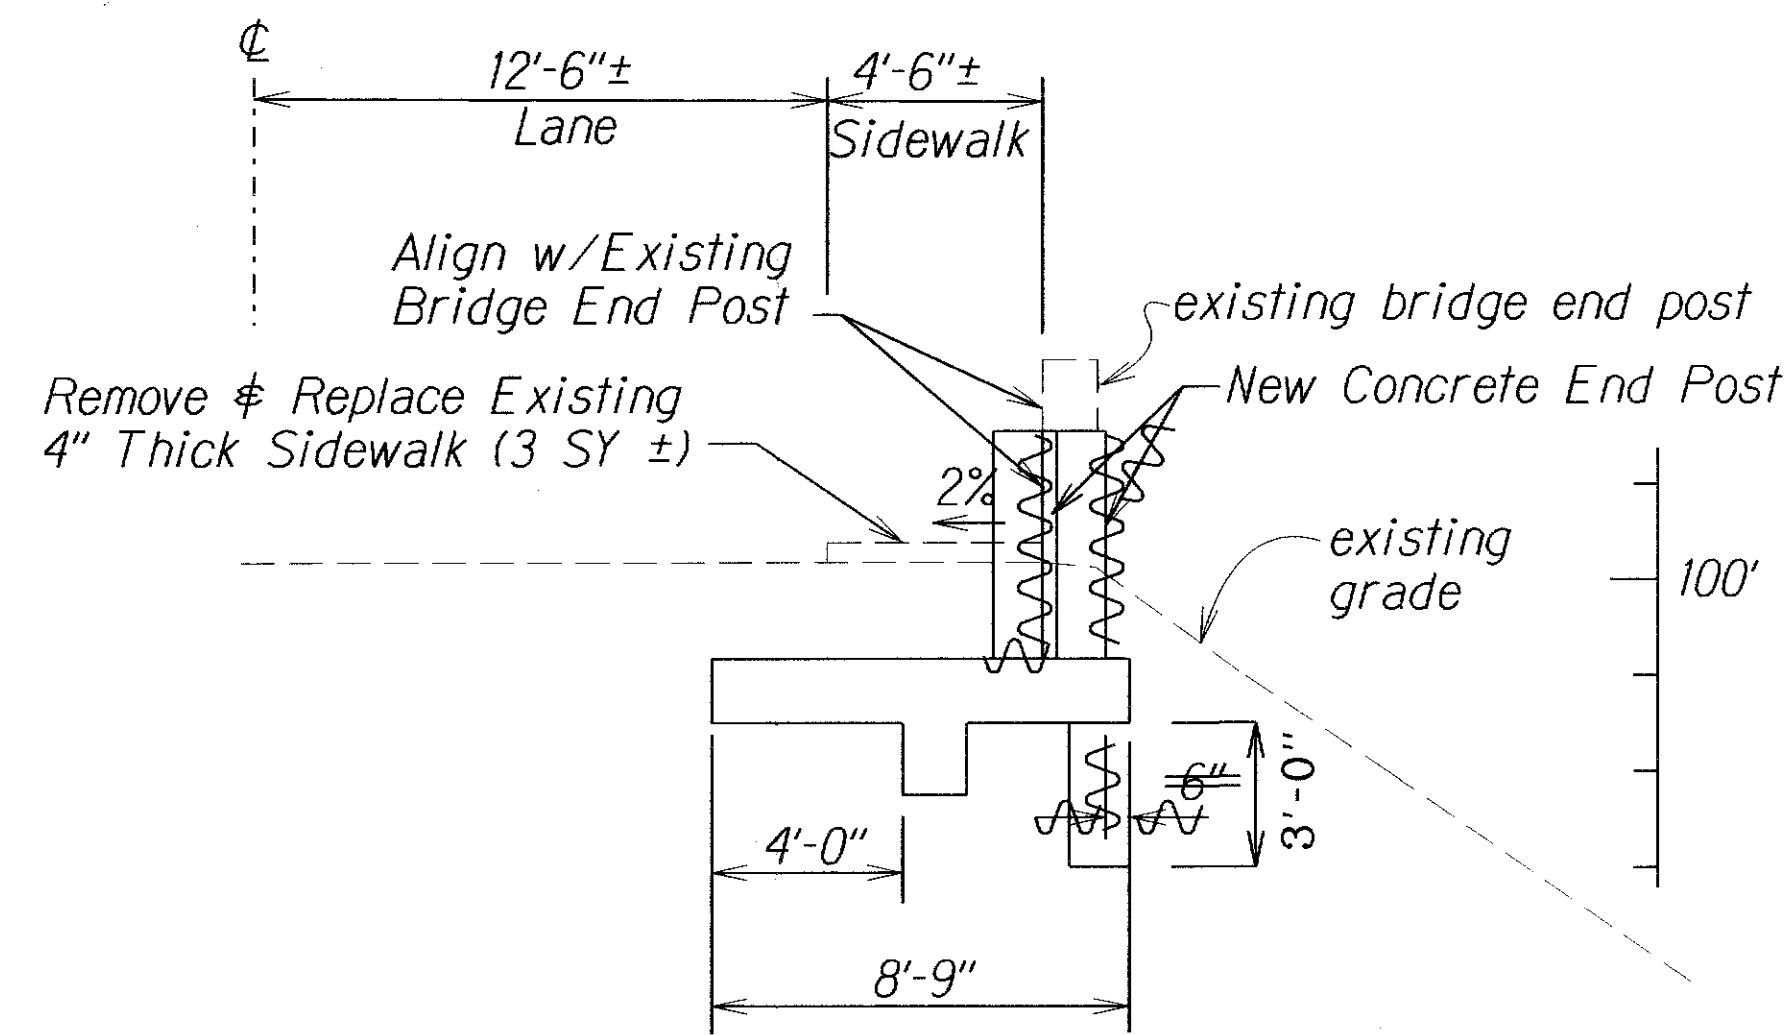

C SECTION - WAIMEA END - MAKAI
Scale: 1/4"=1'-0"

SURVEY PLOTTED BY	DATE
DRAWN BY	
NOTE BOOK	
DESIGNED BY	
QUANTITIES BY	
CHECKED BY	

LEGEND FOR AS-BUILT POSTINGS	
	Squiggly line for as-built deletion
	Double line for as-built deletion
Roadway	Text for as-built posting

STATE OF HAWAII
DEPARTMENT OF TRANSPORTATION
HIGHWAYS DIVISION
WAHIAWA END POSTS
KAUMUALII HIGHWAY
Guardrail and Shoulder Improvements
Omao to Hanapepe
Fed. Aid Project No. STP-050-1(24)
Scale: As Shown Date: July 2001
SHEET No. 2 OF 2 SHEETS