


FED. ROAD DIST. NO.	STATE	FED. AID PROJ. NO.	FISCAL YEAR	SHEET NO.	TOTAL SHEETS
HAWAII	HAW.	STP-050-1(24)	2002	39	40

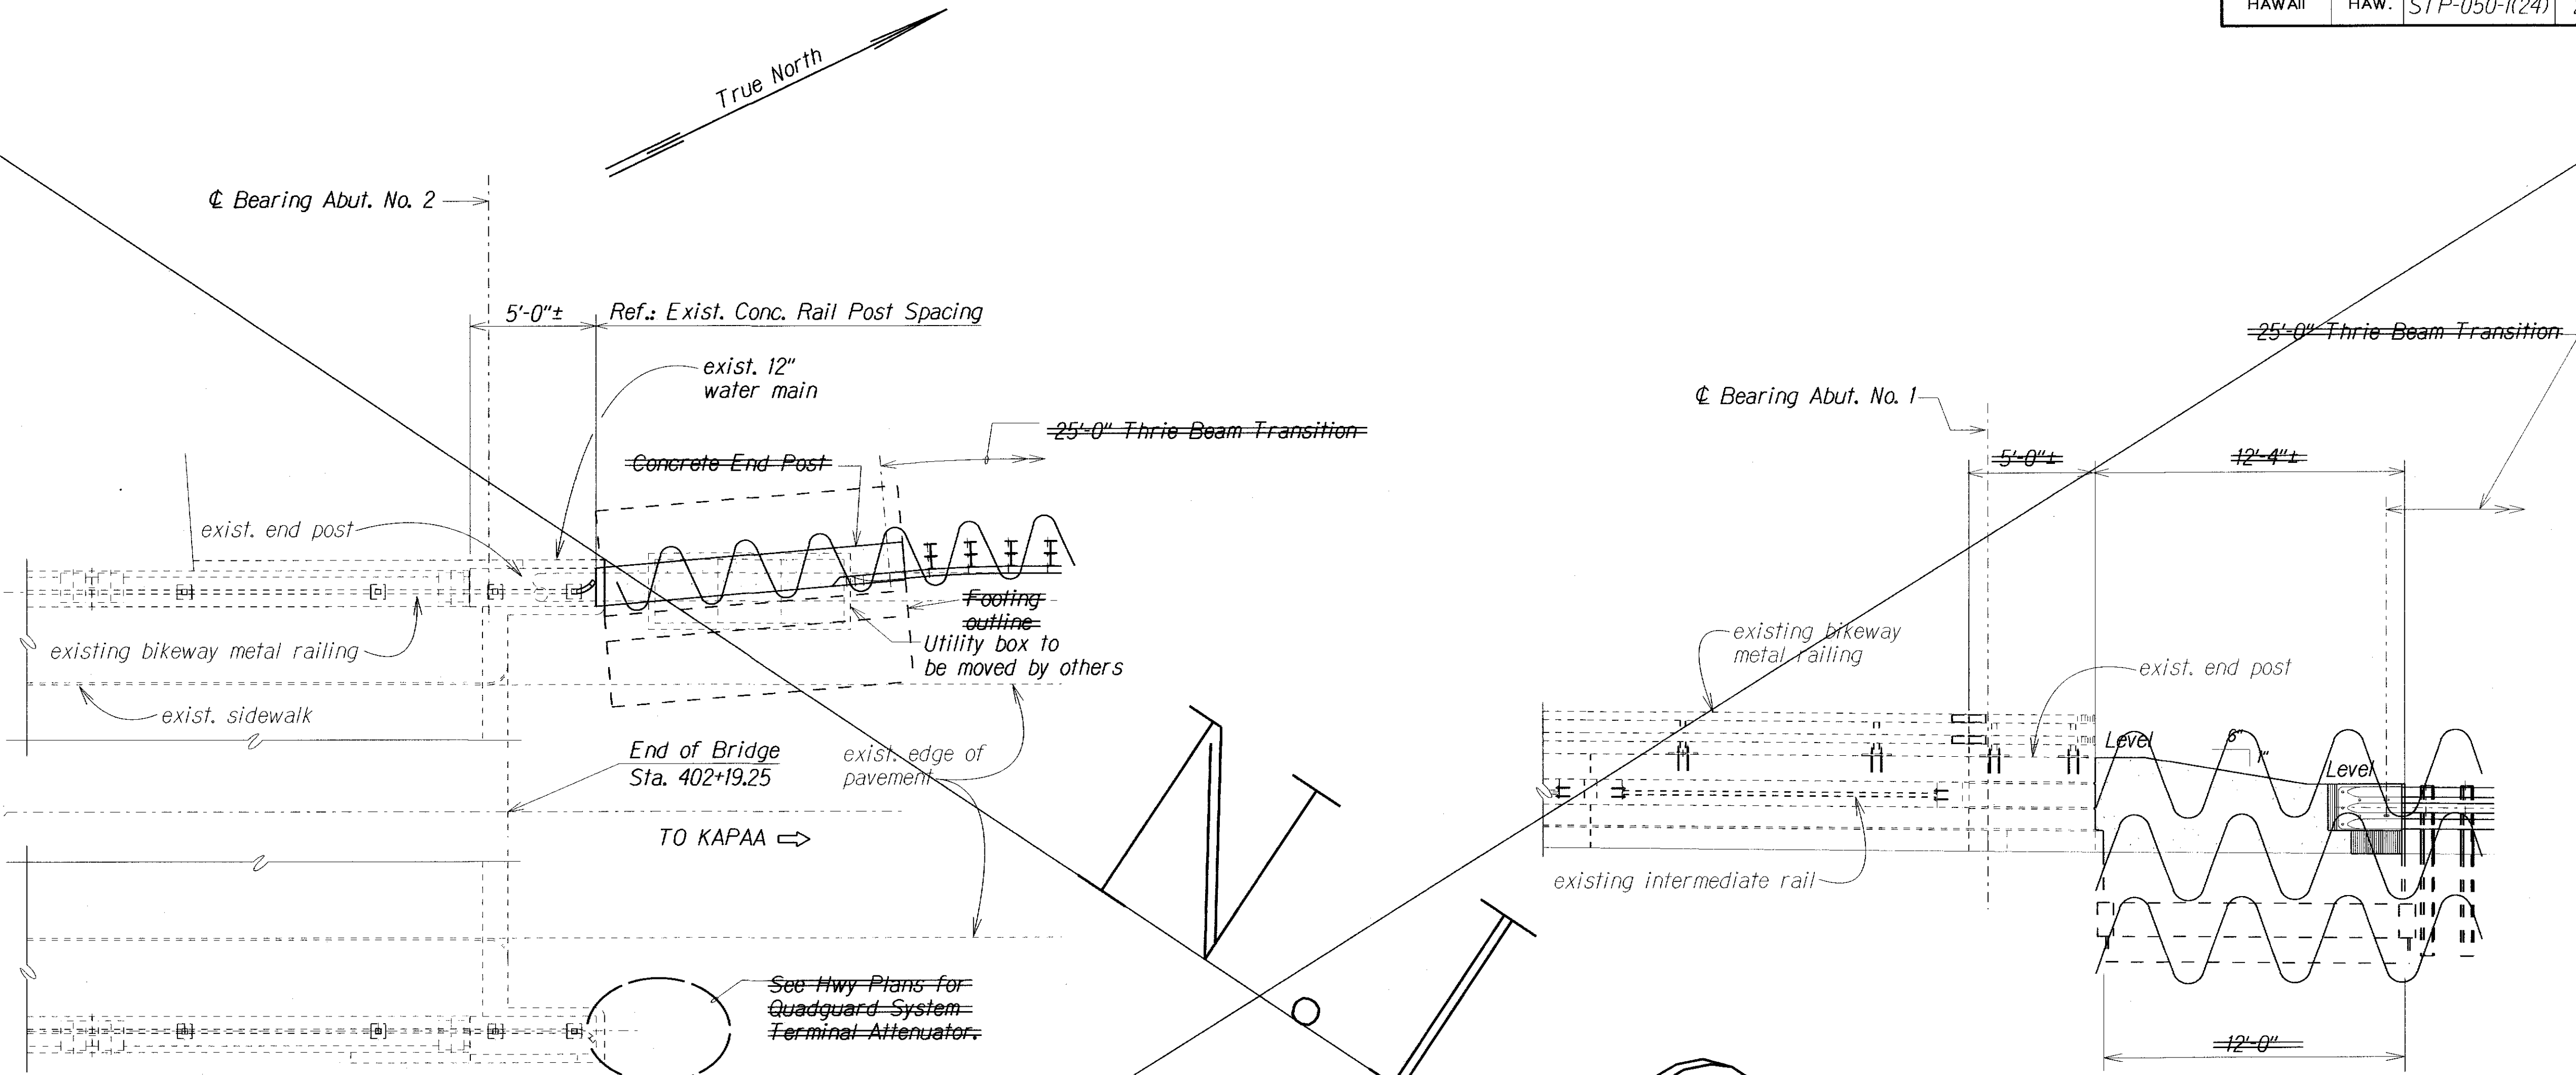

NOTE:
End post work shall be staggered so construction will not occur on both sides of the road simultaneously.

LAYOUT PLAN
Scale: $\frac{1}{4}" = 1'-0"$

ELEVATION
Scale: $\frac{1}{4}" = 1'-0"$

ORIGINAL PLAN	SURVEY PLOTTED BY	DATE
NOTED	DRAWN BY	
DESIGNED BY		
QUANTITIES BY		
CHECKED BY		

LEGEND FOR AS-BUILT POSTINGS	
	Squiggly line for as-built deletion
	Double line for as-built deletion
Roadway	Text for as-built posting

STATE OF HAWAII
DEPARTMENT OF TRANSPORTATION
HIGHWAYS DIVISION
WAILUA STREAM BRIDGE
LAYOUT PLAN
KAUMUALII HIGHWAY
Guardrail and Shoulder Improvements
Omao To Hanapepe
Fed. Aid Project No. STP-050-1(24)
Scale: As Noted Date: July 2001
SHEET No. 1 OF 1 SHEETS