


TRUE NORTH
Scale: 1" = 30'

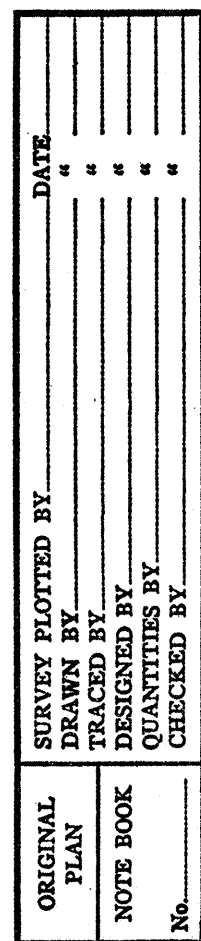

STATE OF HAWAII
DEPARTMENT OF TRANSPORTATION
HIGHWAYS DIVISION

ROUTE 51: RICE STREET/ROUTE 51
JUNCTION TO AHUKINI ROAD

PROJ. No. DP-F-051-1(3)

INTERSECTION DETAILS
(RICE STREET)

Scale: As Shown July 1973

SHEET No. 1 OF 2 SHEETS

