A STATE OF THE STA	
INDEX TO DRAWINGS	
SHEET NO	DESCRIPTION
	TITLE SHEET
2 - 4	TYPICAL SECTIONS
5 - 8	PLAN AND PROFILE
9 - 10	INTERSECTION DETAILS
11 - 14	GRADE PLANS
15 - 20	STANDARD ROADWAY DETAILS
21 - 36	DRAINAGE DETAILS
37 - 49	PAVEMENT MARKERS, LAND- SCAPING, UTILITIES, ROADWAY SIGNS PLANS AND DETAILS
50 - 61	CROSS SECTIONS

STATE OF HAWAII

DEPARTMENT OF TRANSPORTATION

HIGHWAYS DIVISION

"AS BUILT"

PLANS FOR


ROUTE 51: RICE STREET/ROUTE 51 JUNCTION TO AHUKINI ROAD (AHUKINI ROAD - NAWILIWILI)


FEDERAL AID PROJECT NO. DP-F-051-1(3)

DISTRICT OF LIHUE ISLAND OF KAUAI

SCALES:

PLAN & PROFILE HOR. I"=50' VER. I"=10'

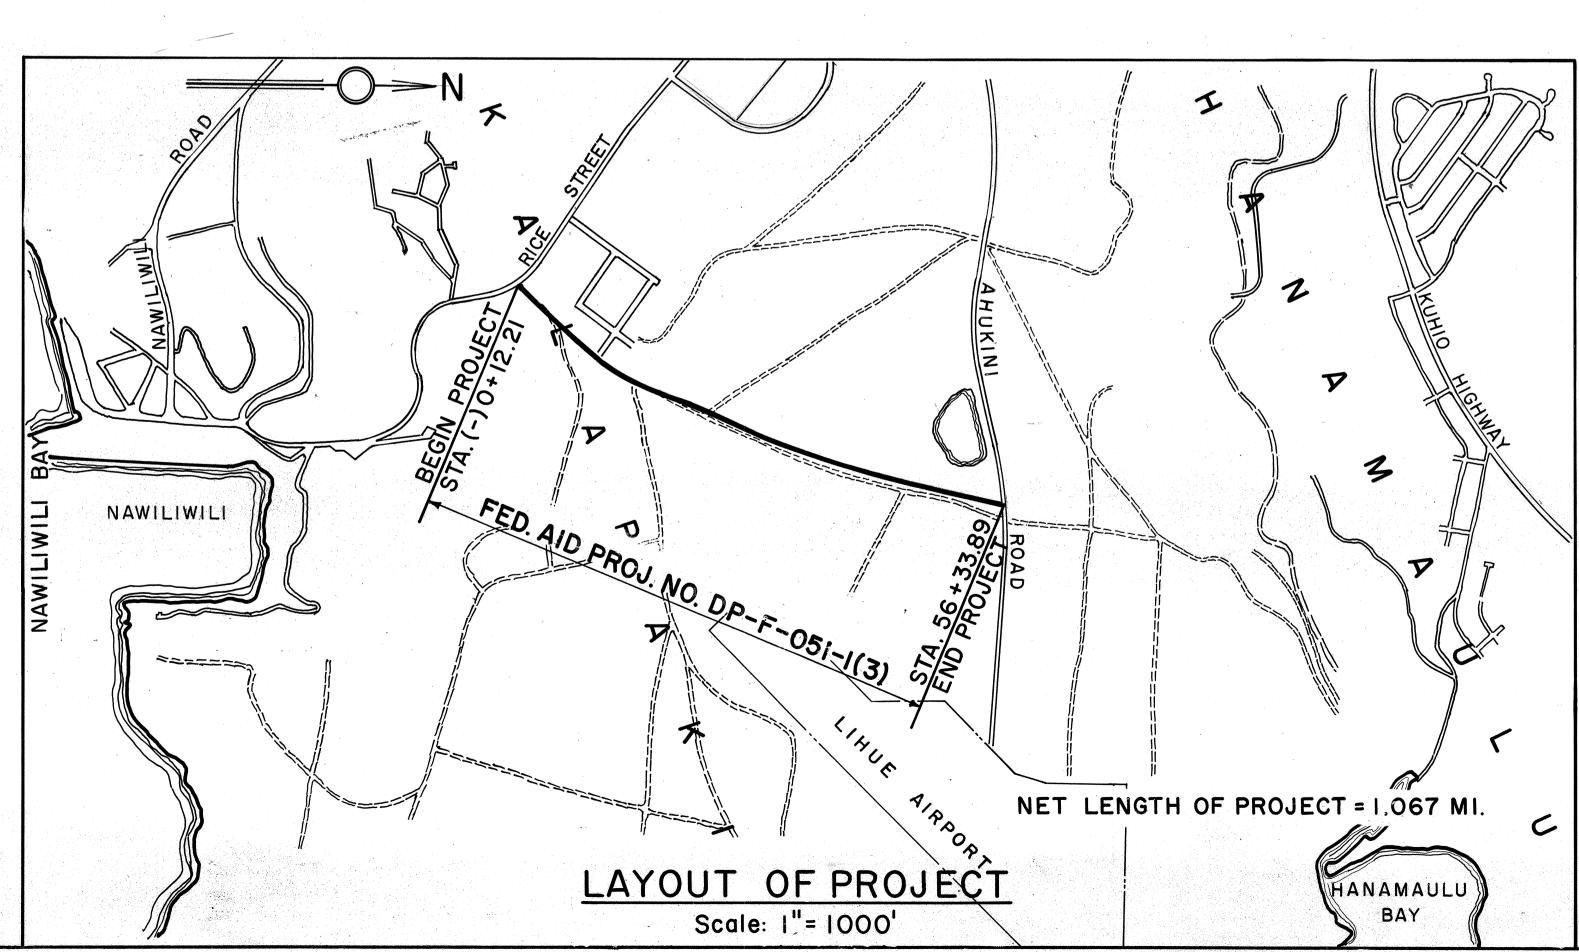

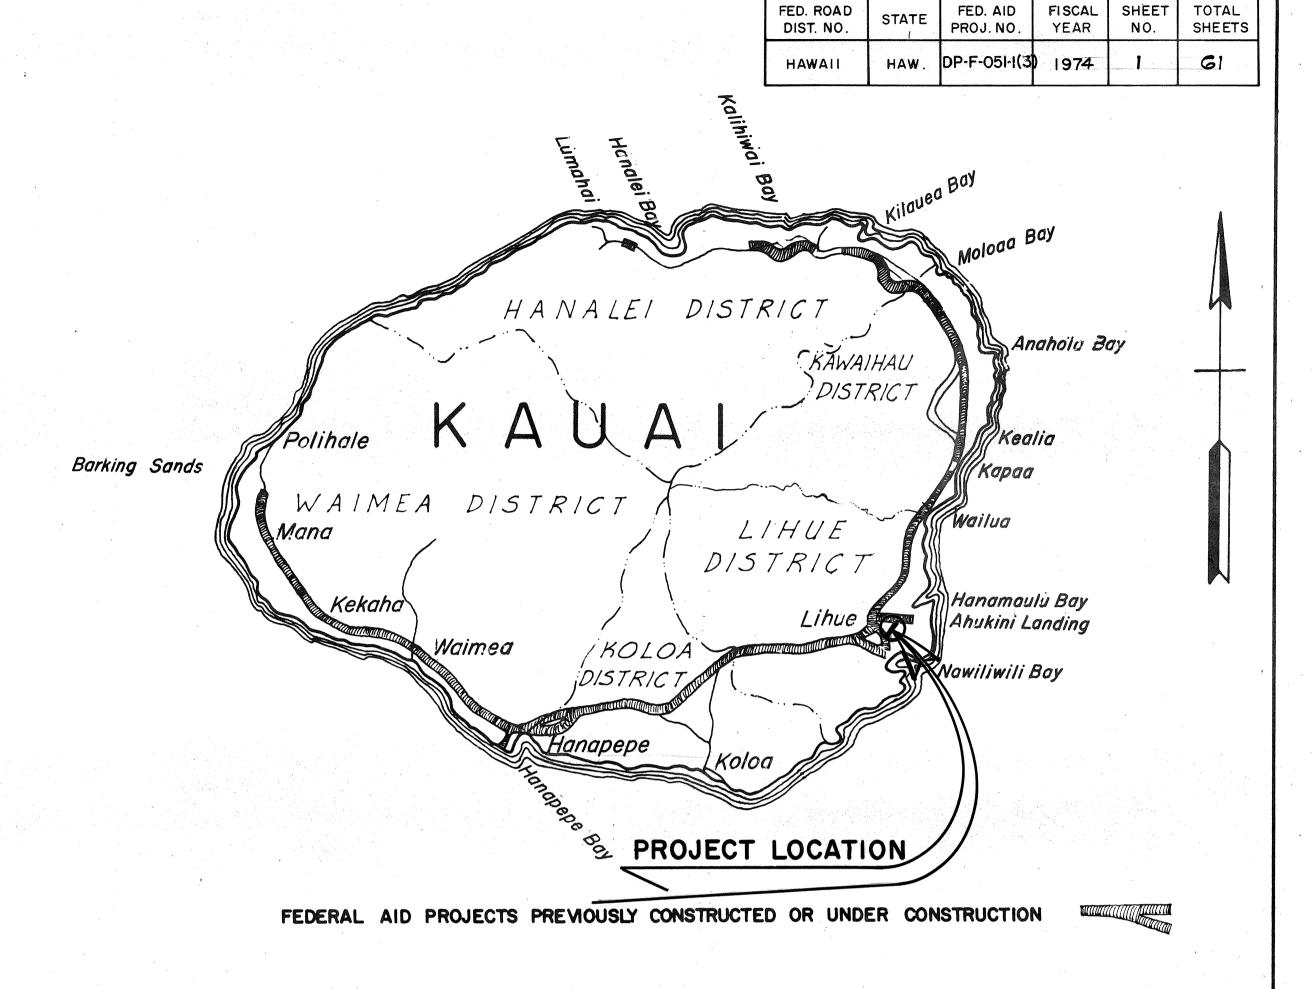

NOTE:

ALL CHANGES MADE DURING CONSTRUCTION HAVE BEEN NOTED IN RED ON THESE TRACINGS AND CHECKED BY

10-20-77

DESIGN CLASSIFICATION ADT(1974).....

ADT(1994).....6940 D...... 55/45 T..... 2.5% V 60 m.p.h.

> DEPARTMENT OF TRANSPORTATION FEDERAL HIGHWAY ADMINISTRATION 5.20.74

DEPARTMENT OF TRANSPORTATION STATE OF HAWAII APPROVED:

PRINTED ON LILETZGEN 198M AGEPROOF

DD-B-7-2