


FED. ROAD DIST. NO.	STATE	PROJ. NO.	FISCAL YEAR	SHEET NO.	TOTAL SHEETS
HAWAII	HAW.	58A-01-00M	1988	6	10

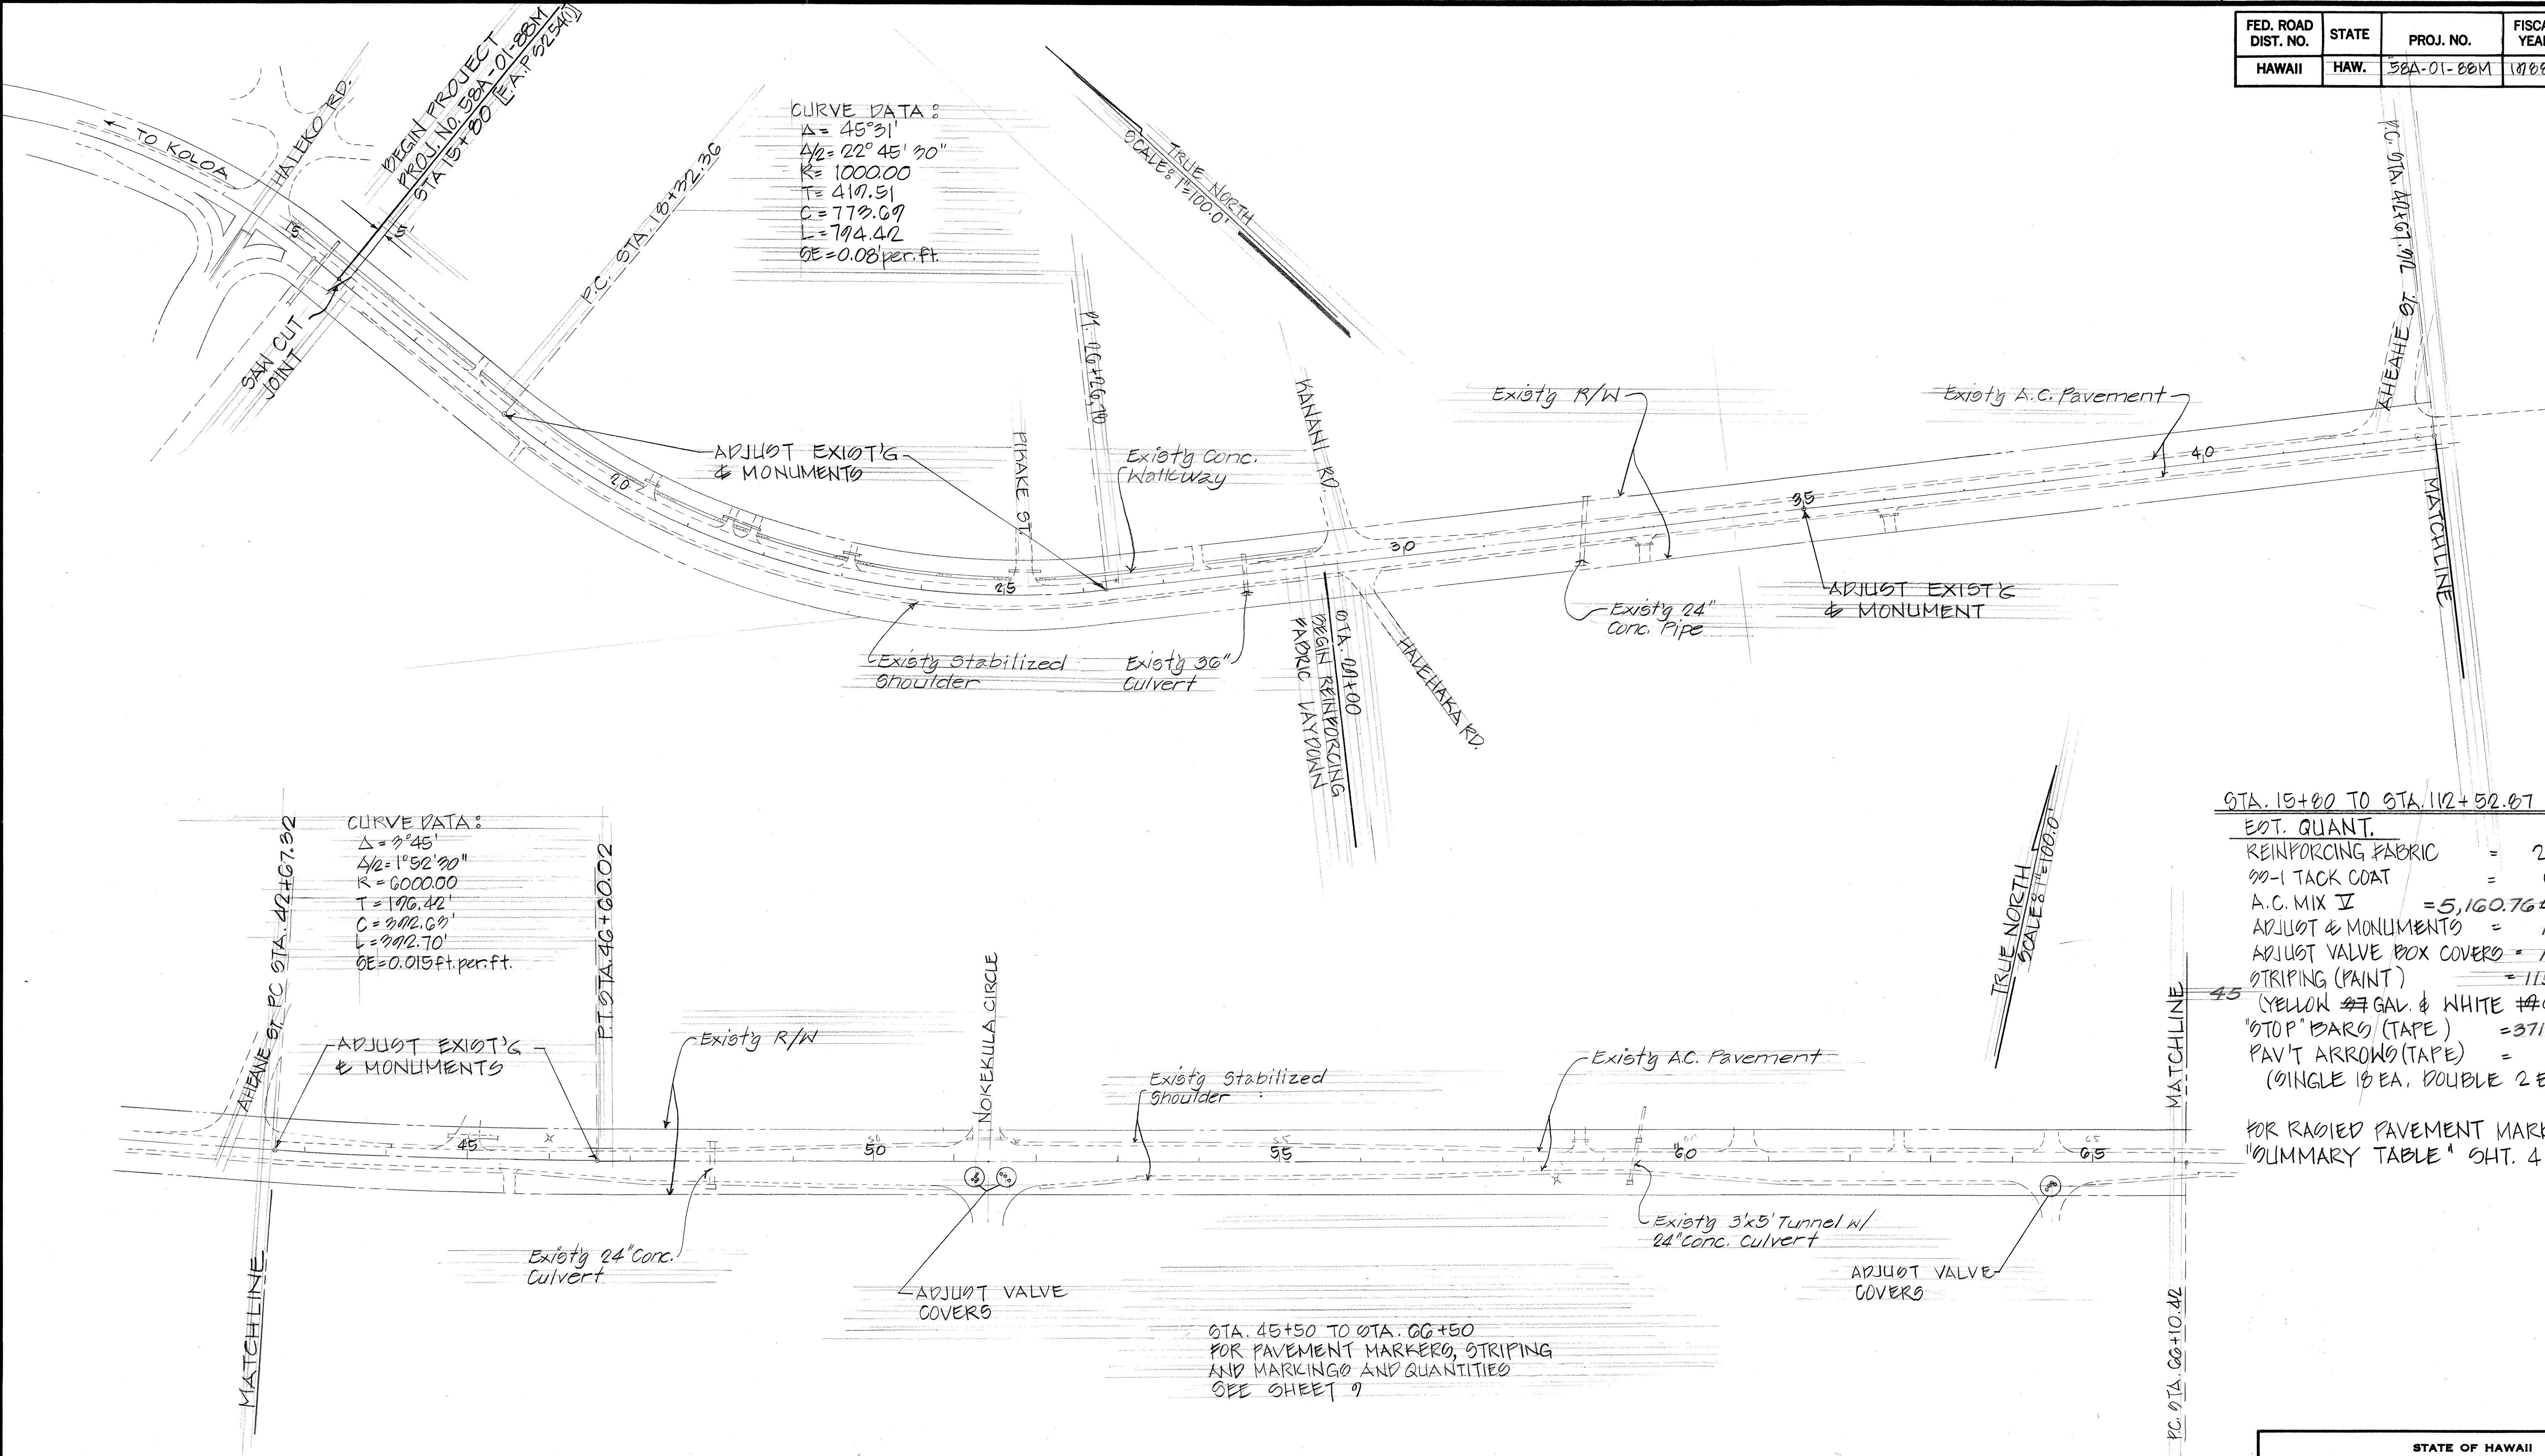

STATE OF HAWAII
DEPARTMENT OF TRANSPORTATION
LAND TRANSPORTATION FACILITIES DIVISION


PLAN

NAWILIWILI ROAD RESURFACING
PROJ. NO. 58A-01-00M



SCALE 8 1"=100.0'
JAN 13, 1988

ORIGINAL PLAN	SURVEY PLOTTED BY	DATE
DESIGNED BY	DRAWN BY	
CHECKED BY	TRACED BY	
	NOTED BY	
	QUANTITIES BY	
	CHECKED BY	

ORIGINAL PLAN	SURVEY PLOTTED BY _____	DATE _____
	DRAWN BY _____	" _____
	TRACED BY _____	" _____
NOTE BOOK	DESIGNED BY _____	" _____
	QUANTITIES BY _____	" _____
No. _____	CHECKED BY _____	" _____

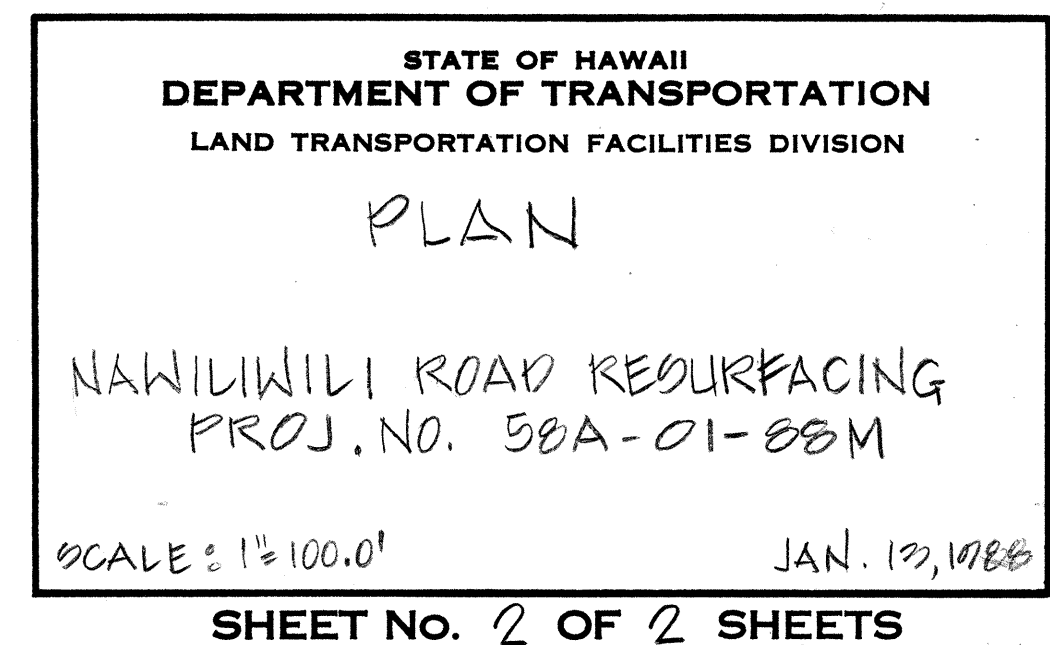

FED. ROAD DIST. NO.	STATE	PROJ. NO.	FISCAL YEAR	SHEET NO.	TOTAL SHEETS
HAWAII	HAW.	51A-01-88M	1988	8	10

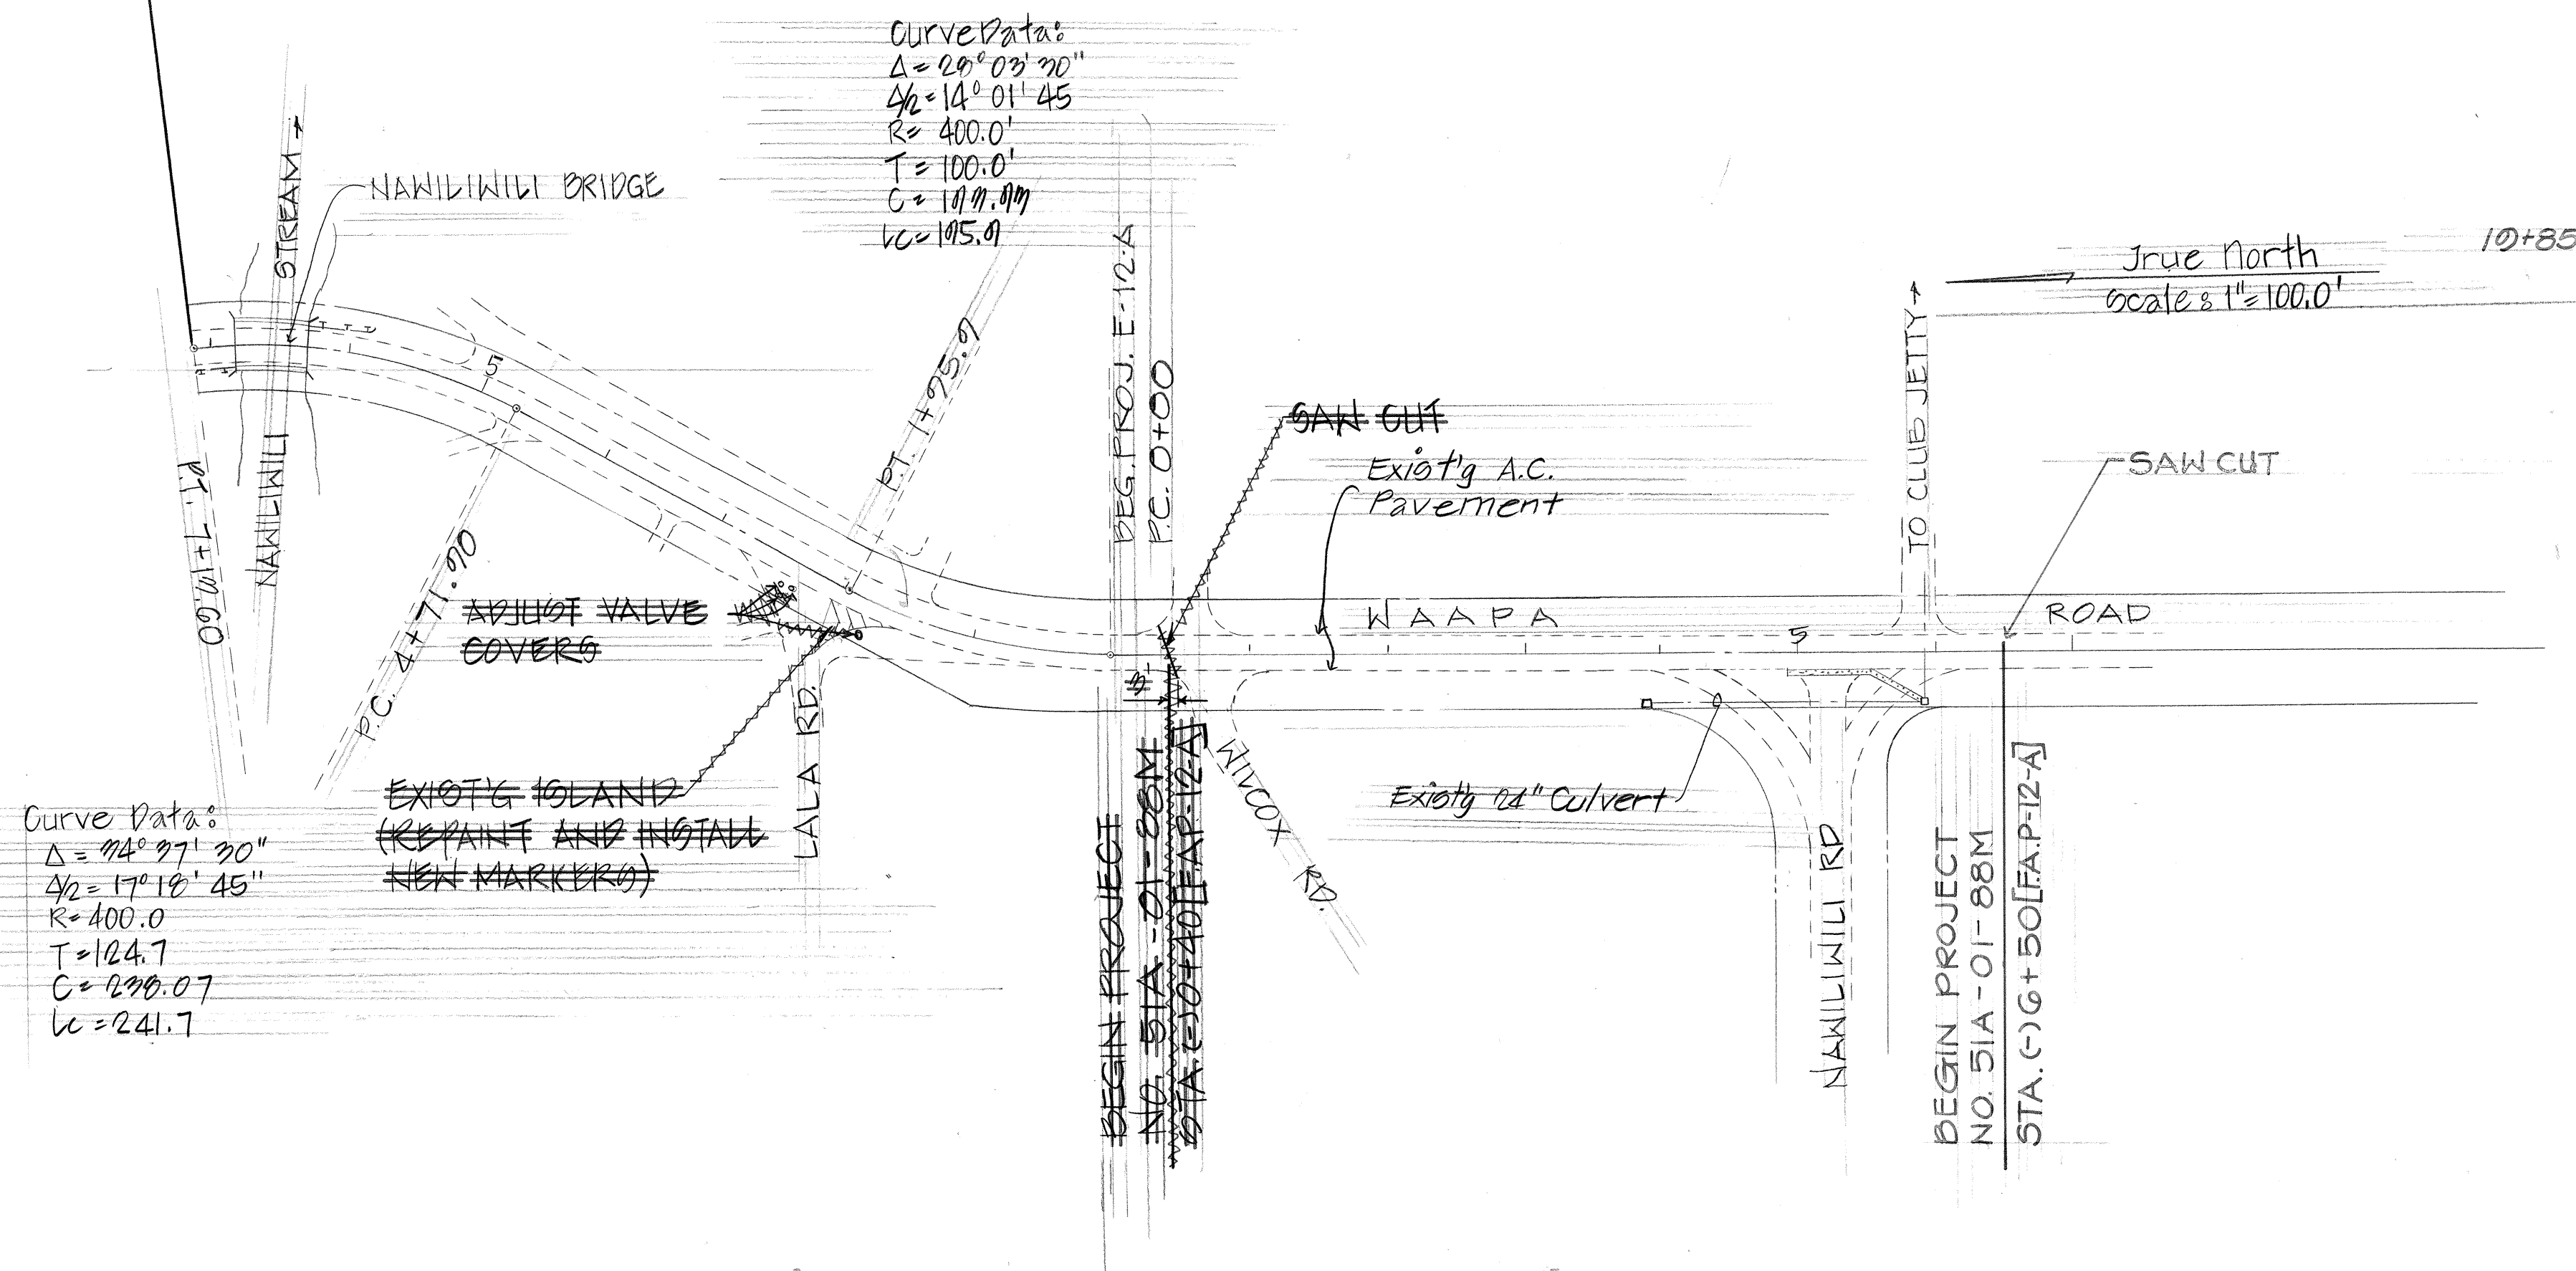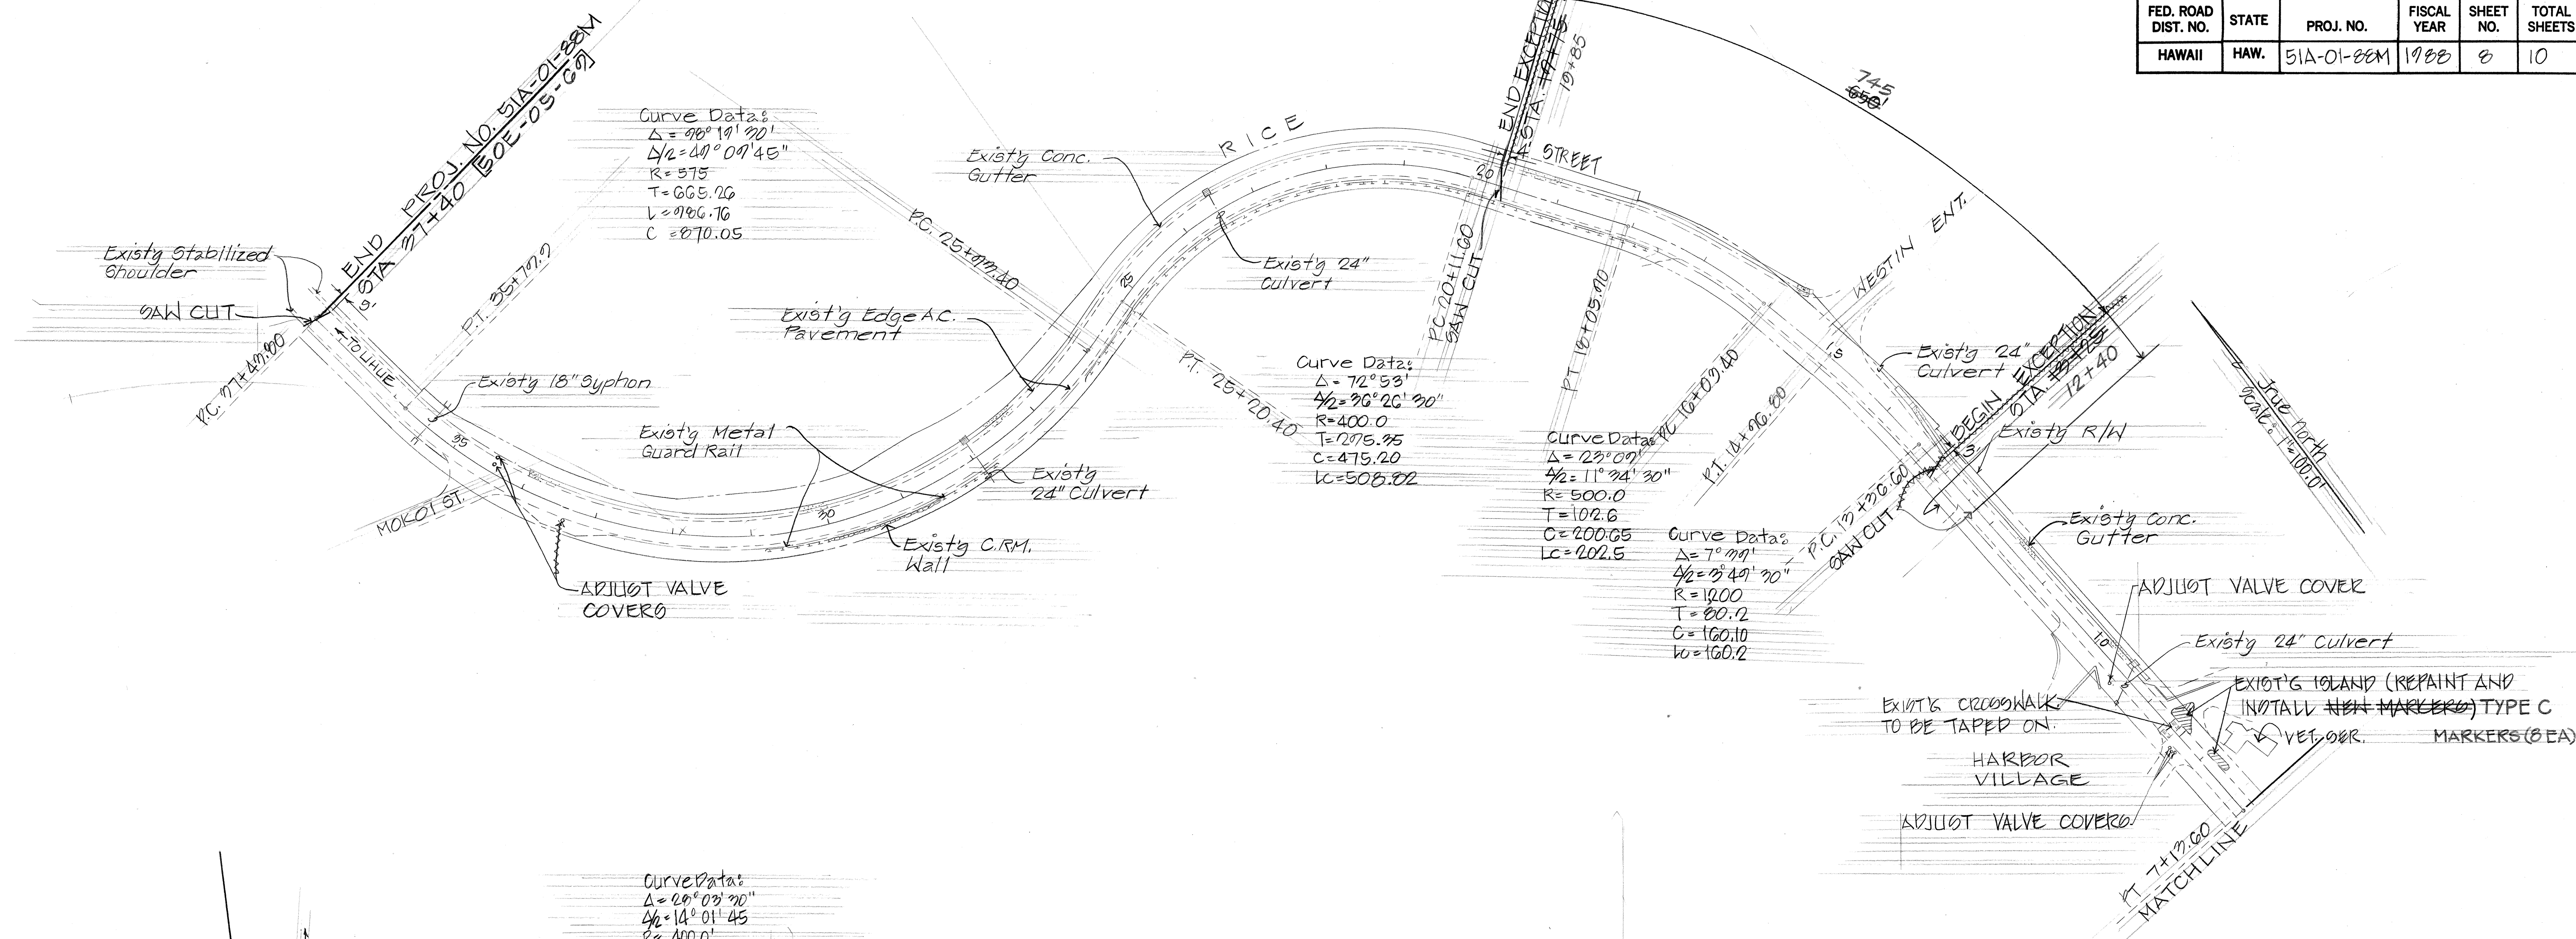

(C)G+50	12+40
STA 0+00 TO STA 12+25	
STA 12+25 TO STA 12+40	
EST. QUANT.	9,471.3
REINFORCING FABRIC	735 S.Y.
GG-1 TACK COAT	715 GAL.
A.C. MIX V	1,304.26 TONS
STRIPING (PAINT)	75.45 GAL.
(YELLOW #3 GAL. & WHITE #2 GAL.)	
CROSSWALK (TAPE)	2 LANES
PAV'T ARROWS (TAPE)	1 EA.
STOP LINES (TAPE)	113.4 FT.
TYPE A PAV'T MARKERS	176 EA.
TYPE C PAV'T MARKERS	66 EA.
TYPE D PAV'T MARKERS	183 EA.
ADJUST VALVE COVERS	3 EA.

STATE OF HAWAII
DEPARTMENT OF TRANSPORTATION
LAND TRANSPORTATION FACILITIES DIVISION

PLAN

RICE STREET REOURFACING
PROJ. NO. 51A-01-88M

SCALE: 1" = 100.0' JAN 13, 1988

SHEET NO. 1 OF 1 SHEETS

ORIGINAL PLAN	DATE
SURVEY PLOTTED BY	
DRAWN BY	
DESIGNED BY	
QUANTITIES BY	
CHECKED BY	