


FED. ROAD DIST. NO.	STATE	PROJ. NO.	FISCAL YEAR	SHEET NO.	TOTAL SHEETS
HAWAII	HAW.	58A-01-88M	1988	9	10

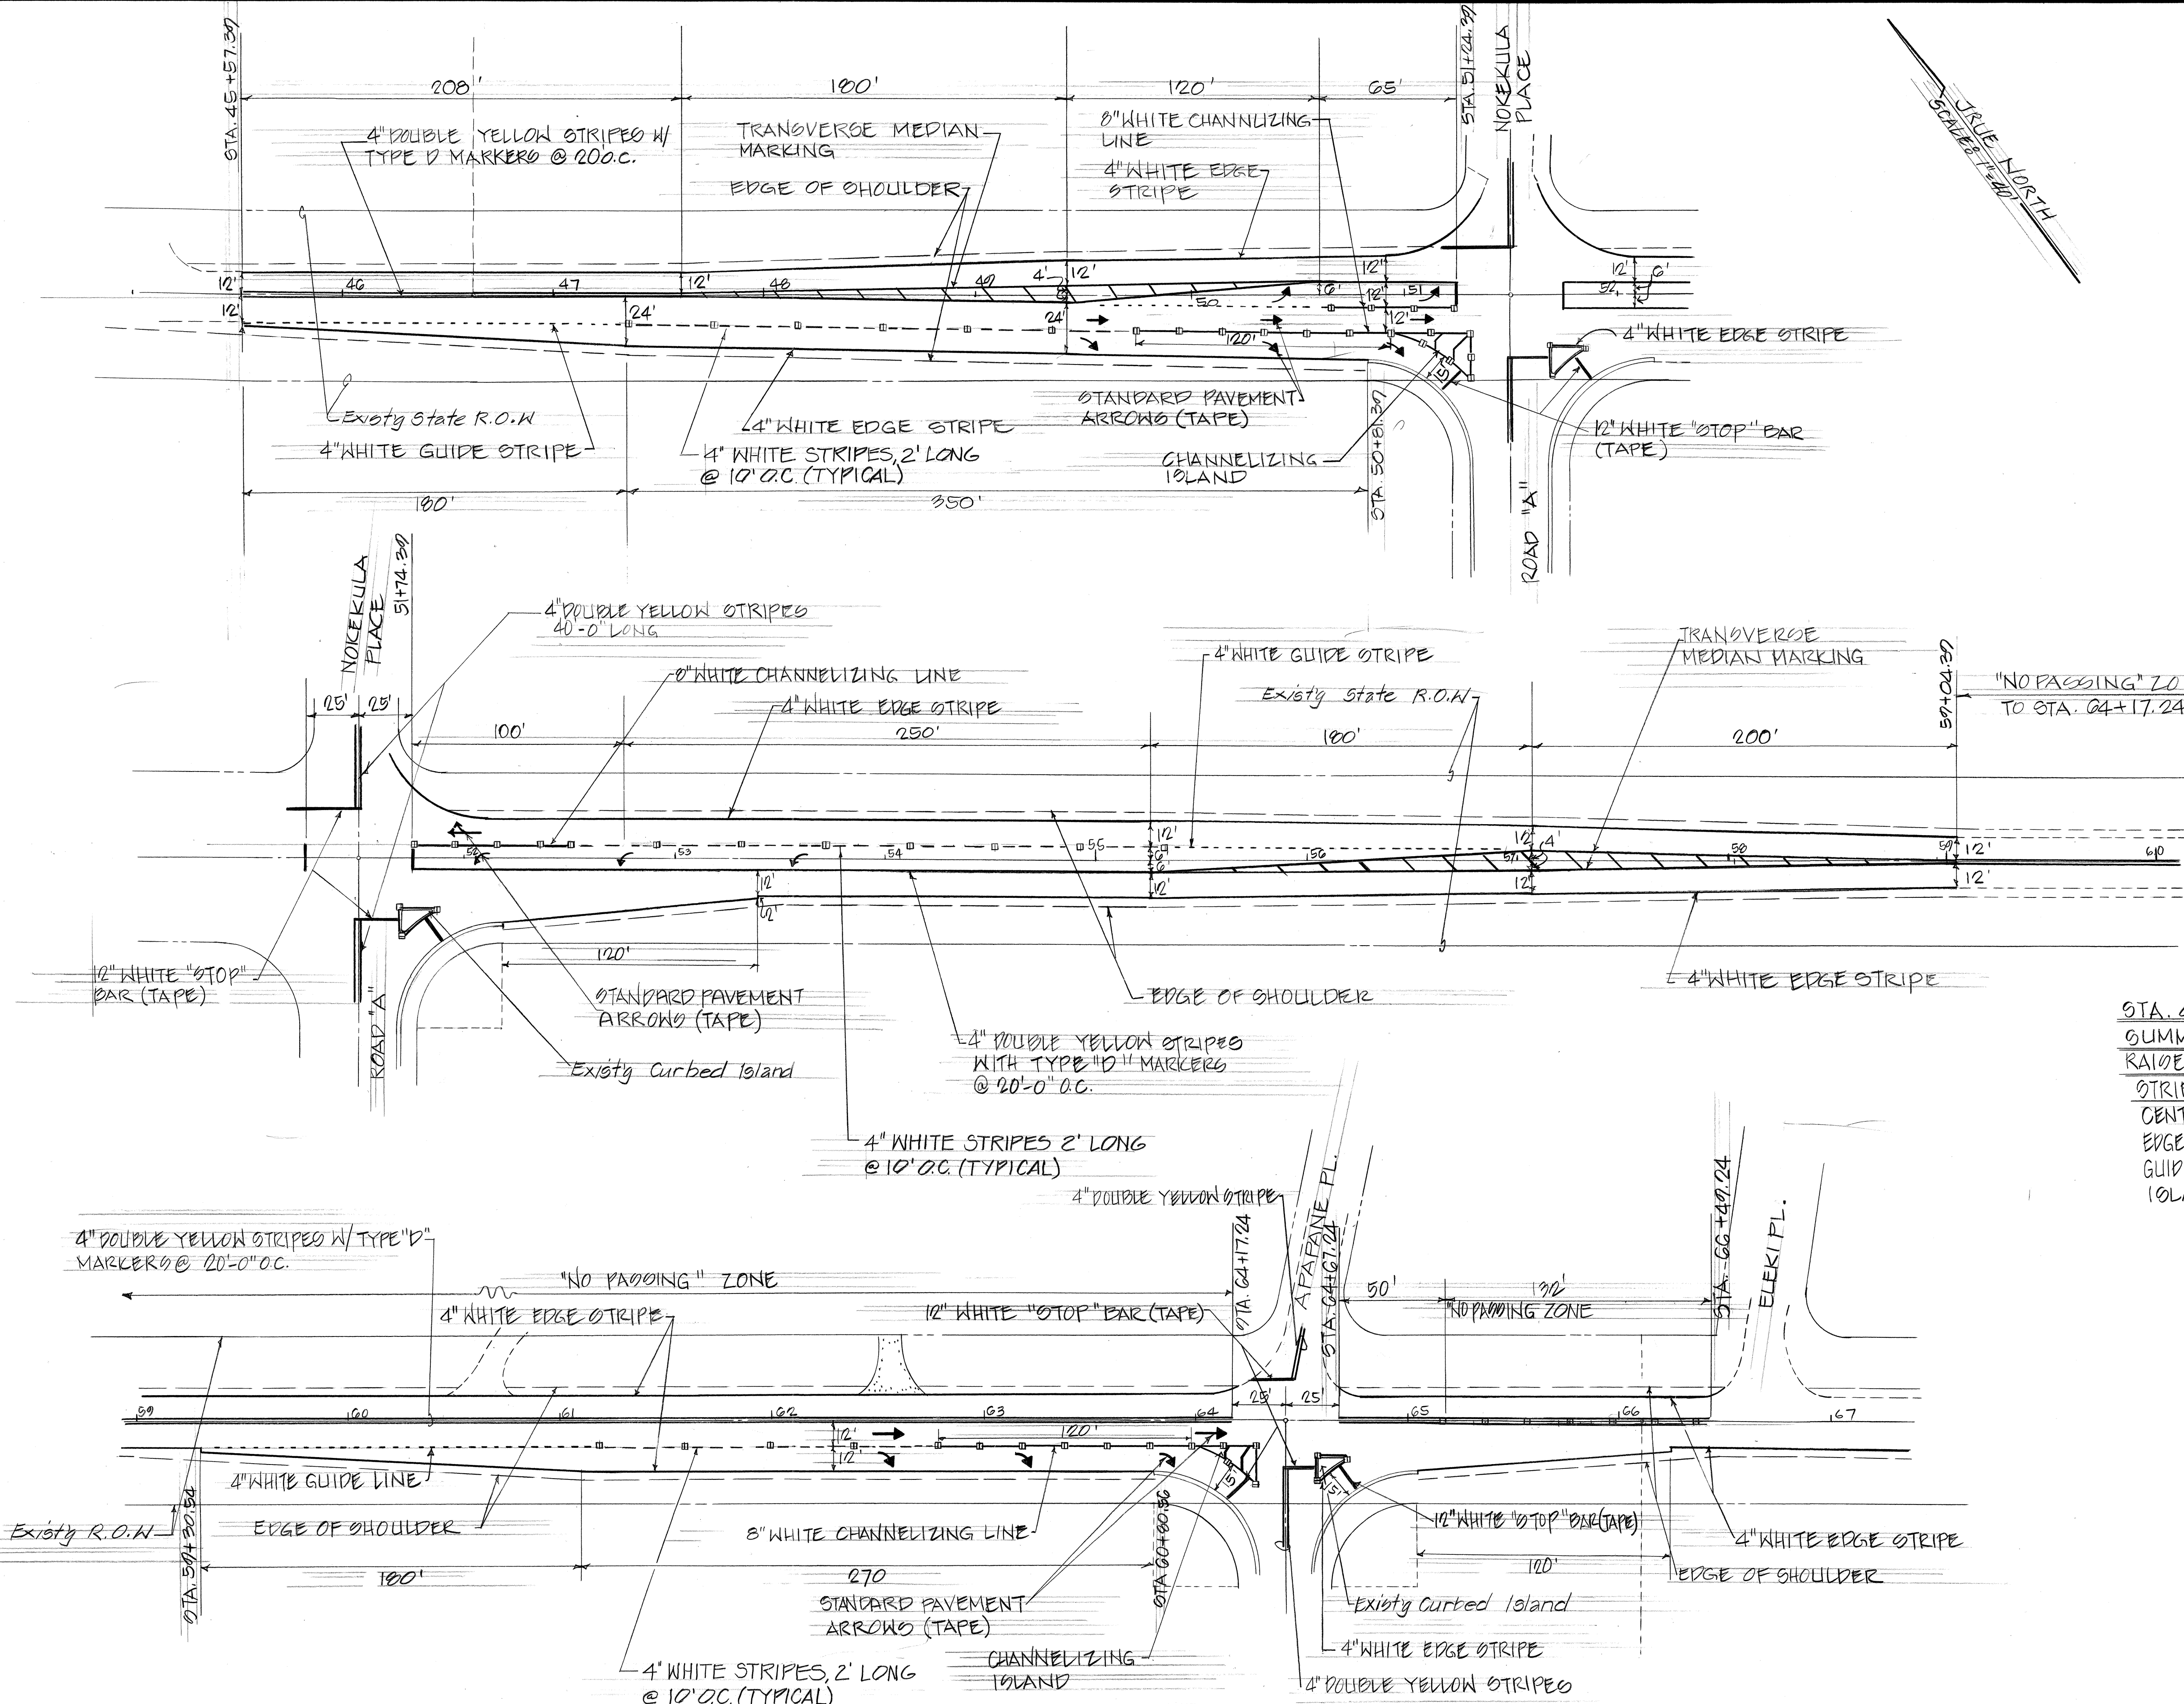

LEGEND:

- TYPE A
- TYPE C
- TYPE D
- TYPE H
- TYPE J

STA. 45+50 TO STA. 66+50	
SUMMARY - PAVEMENT STRIPING AND RAISED PAVEMENT MARKINGS	
STRIPING (PAINT)	PAVEMENT MARKERS
CENTERLINE = 1,652 L.F.	TYPE C = 75 56EA.
EDGE PAVEMENT = 4,000 L.F.	TYPE D = 100 73EA.
GUIDE LINES = 821 L.F.	TYPE H = 34 68EA.
ISLAND = 1,805 L.F.	

STATE OF HAWAII
DEPARTMENT OF TRANSPORTATION
LAND TRANSPORTATION FACILITIES DIVISION


STRIPING AND PAVEMENT MARKERS DETAILS
NAWILIWILI ROAD RESURFACING
PROJ. NO. 58A-01-88M

SCALE 1"=40.0' JAN 13, 1988

SHEET NO. 9 OF 10 SHEETS

SURVEY PLOTTED BY	DATE
DRAWN BY	
DESIGNED BY	
NOTED BY	
CHECKED BY	
ORIGINAL PLAN	
NOTE BOOK	
NO.	

FED. ROAD DIST. NO.	STATE	PROJ. NO.	FISCAL YEAR	SHEET NO.	TOTAL SHEETS
HAWAII	HAW.	51A-01-88M	1988	10	10

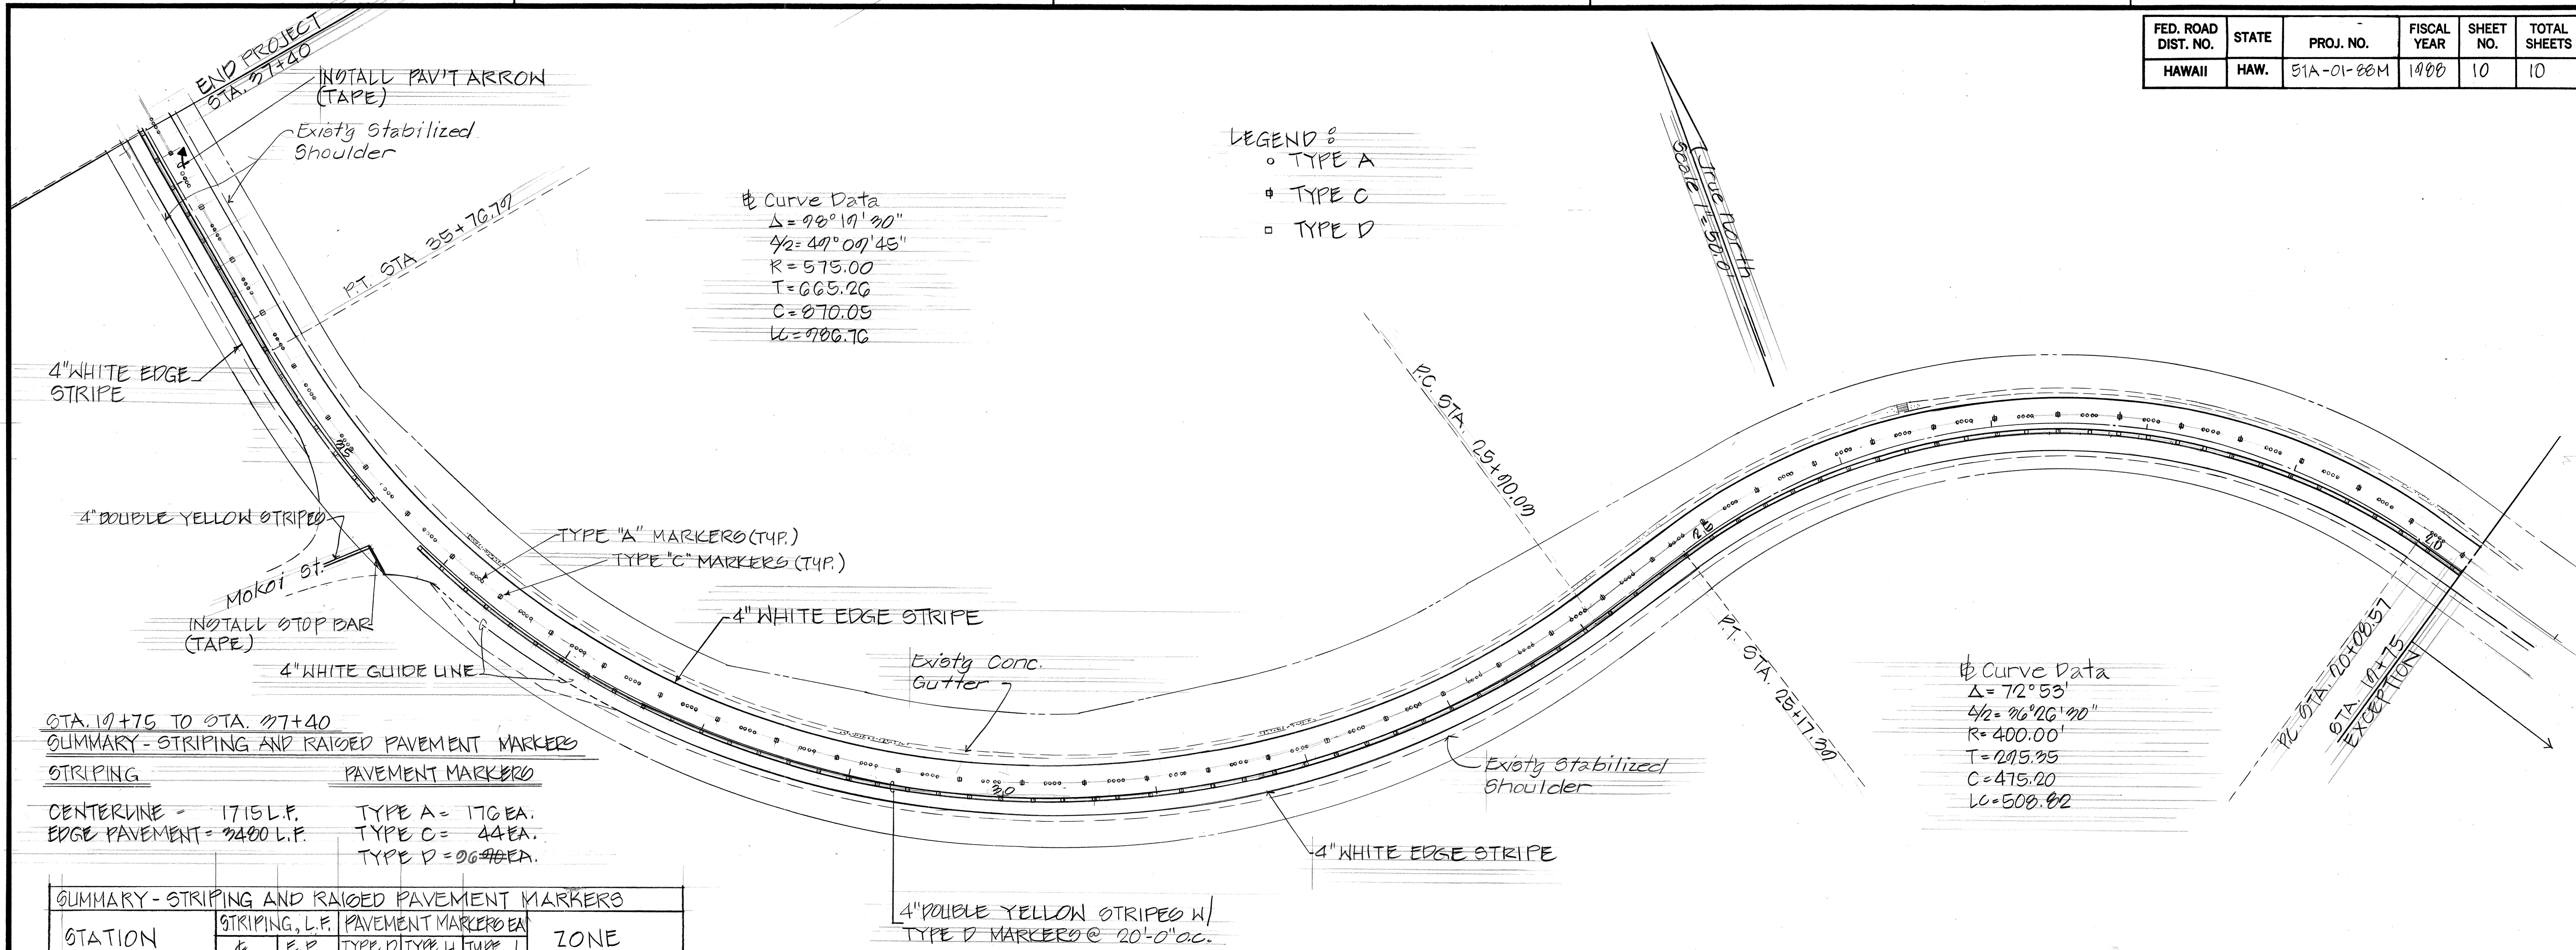

STA. 17+75 TO STA. 27+40
 SUMMARY - STRIPING AND RAISED PAVEMENT MARKERS
 STRIPING PAVEMENT MARKERS

CENTERLINE = 1715 L.F. TYPE A = 170 EA.
 EDGE PAVEMENT = 3480 L.F. TYPE C = 44 EA.
 TYPE D = 964 EA.

SUMMARY - STRIPING AND RAISED PAVEMENT MARKERS						
STATION	STRIPING, L.F.		PAVEMENT MARKERS EA			ZONE
	L	E.P.	TYPE D	TYPE H	TYPE J	
0+40 TO 2+00	240	480	13			NO PASS
2+00 TO 2+50		50	2			50' OPENING
2+50 TO 8+60	425	850	22			LALA RD
8+60 TO 9+00		40	2			NO PASS
9+00 TO 12+40	340	680	17			40' OPENING
12+40 TO 13+25	425	850	22			KALAPAKI ROAD
13+25 TO 17+75	EXCEPTION					NO PASS
17+75 TO 27+40	SEE ABOVE					
6+50 TO 6+50+40			31			NO PASS
TOTAL	1090	2270	61			

NOTE:
 FOR PAVEMENT MARKING NOTES SEE SHEET 3.

* EXCEPTION AREA STA. 12+40 TO 13+25
 TYPE H - 10 EA.
 TYPE C - 8 EA.

DATE	
SURVEY PLOTTED BY	
DRAWN BY	
DESIGNED BY	
QUANTITIES BY	
CHECKED BY	
ORIGINAL PLAN	
NOTE BOOK	
No.	

STATE OF HAWAII
DEPARTMENT OF TRANSPORTATION
LAND TRANSPORTATION FACILITIES DIVISION

STRIPING AND PAVEMENT
MARKERS DETAILS
RICE STREET RESURFACING
PROJ. NO. 51A-01-88M
STA. 17+75 TO STA. 27+40
SCALE AS SHOWN
JAN. 18, 1988

SHEET NO. 1 OF 1 SHEETS