



FED. ROAD DIST. NO. STATE PROJ. NO. FISCAL SHEET TOTAL YEAR NO. SHEETS

HAWAII HAW. 58A-01-88M 1988 I 10

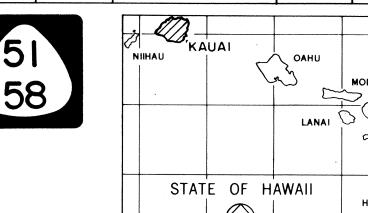

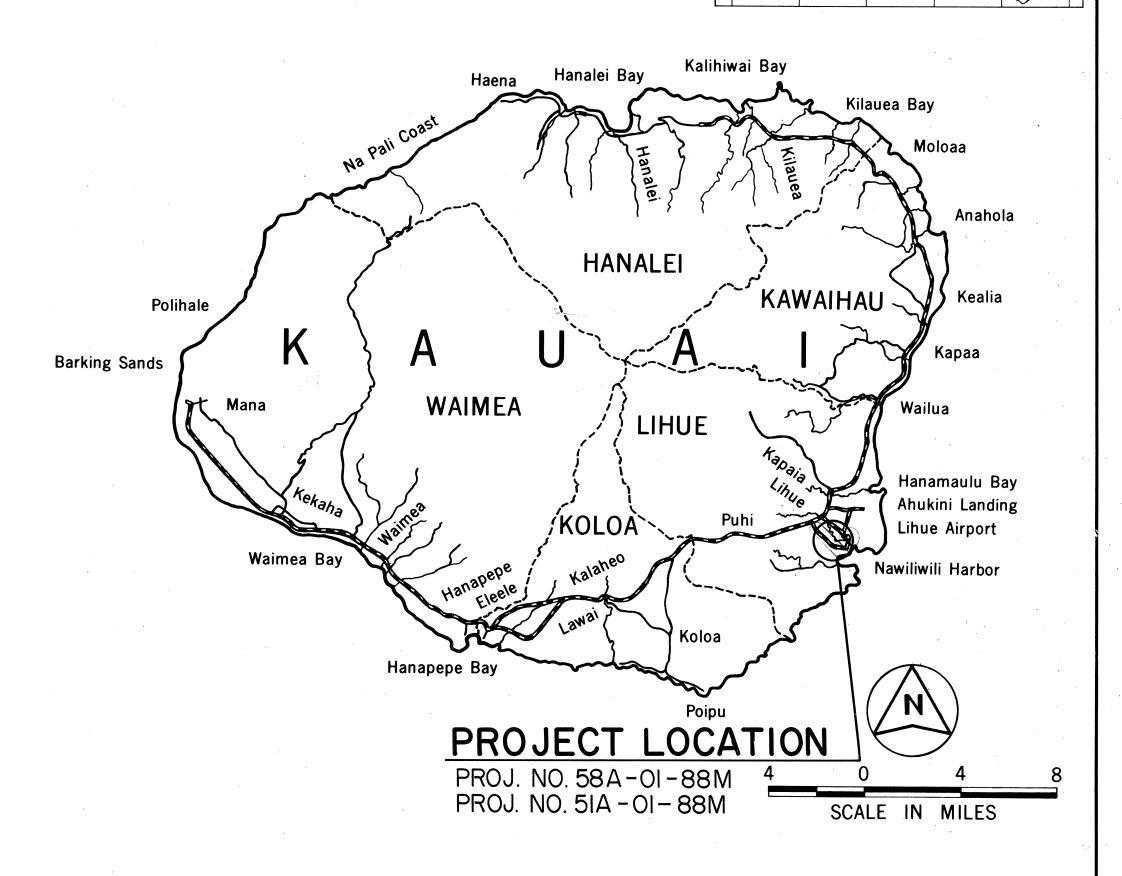

FEDERAL AID PROJECTS PREVIOUSLY CONSTRUCTED

OR UNDER CONSTRUCTION

CHANGES MADE DURING CONSTRUCTION HAVE BEEN INCORPORATED ON THESE PLANS EXCEPT CHANGES IN THE ORIGINAL THEORETICAL QUANTITIES, FOR ACTUAL QUANTITIES, REFER TO PROJECT LEDGER AND/OR COMPUTATION BOOK.

Donyl-4. Macda 11/2/88
RESIDENT ENGINEER DATE

DEPARTMENT OF TRANSPORTATION
STATE OF HAWAII

APPROVED:

LINE OF TRANSPORTATION

DATE

DEPARTMENT OF TRANSPORTATION

DATE

9-01-0-00