



FED. ROAD DIST. NO.	STATE	FED. AID PROJ. NO.	FISCAL YEAR	SHEET NO.	TOTAL SHEETS
HAWAII	HAW.	STP-0700(38)	1998	4	29

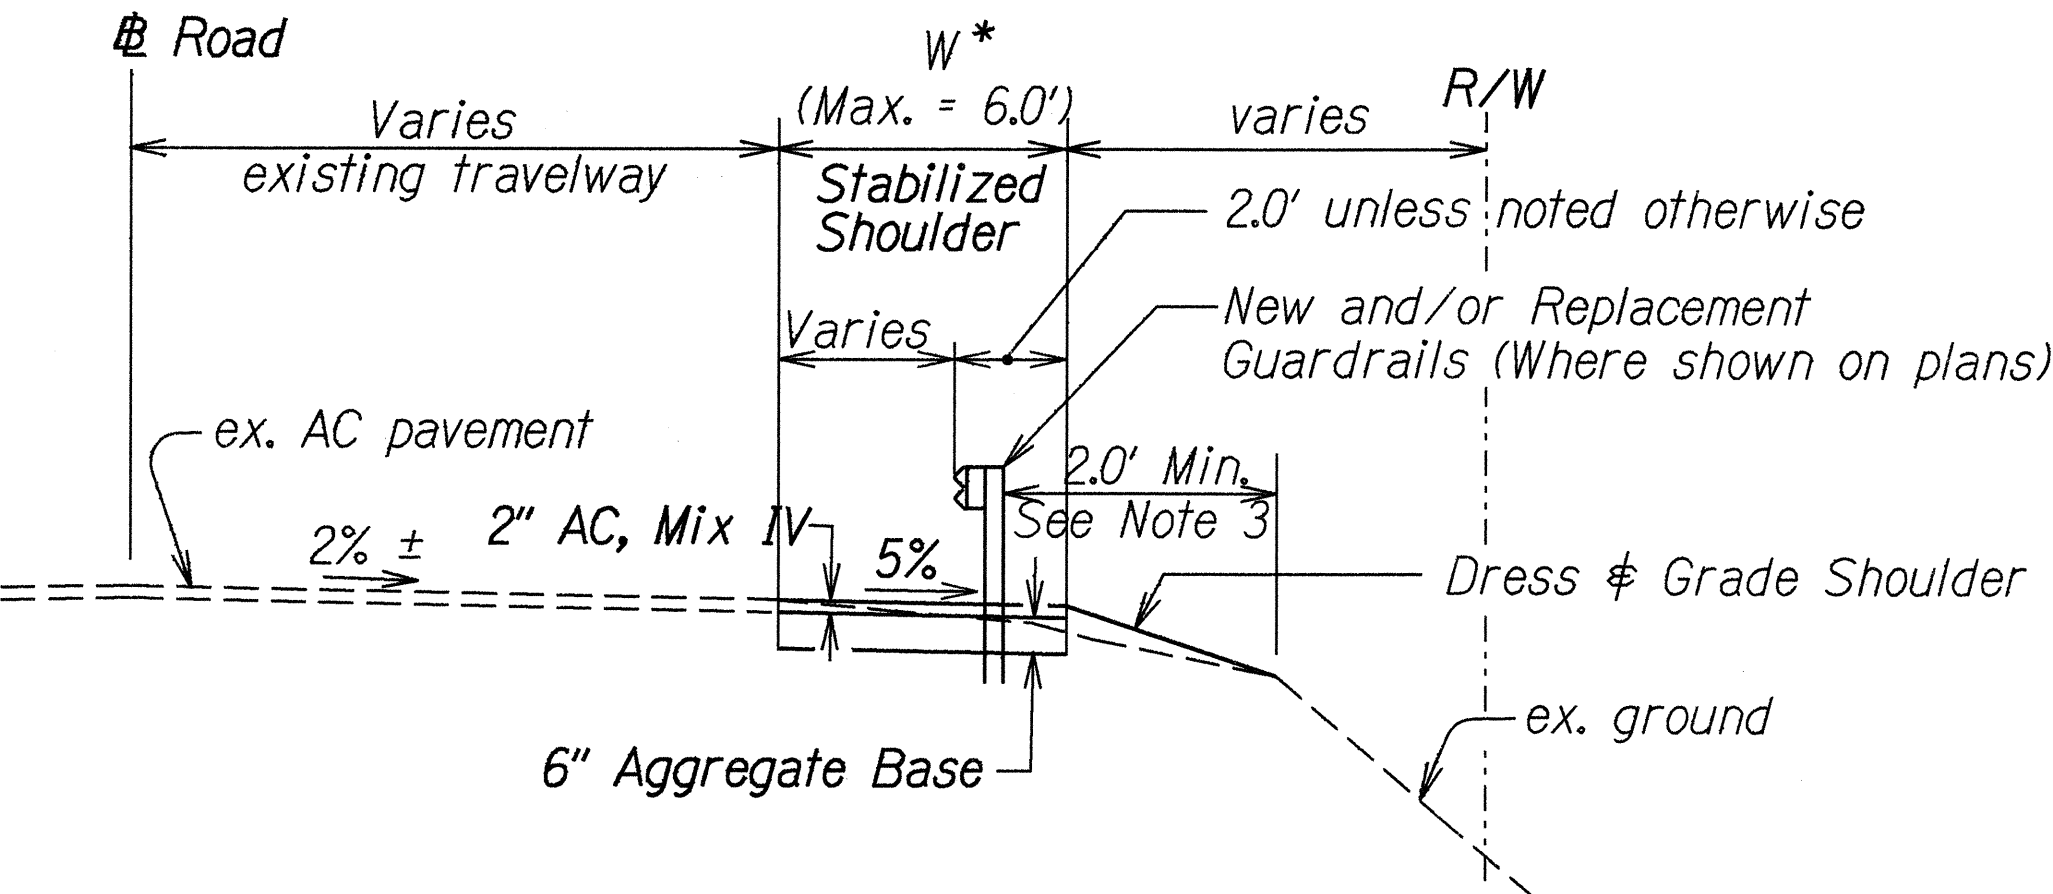

TYPICAL SECTION AT GUARDRAILS

Not To Scale

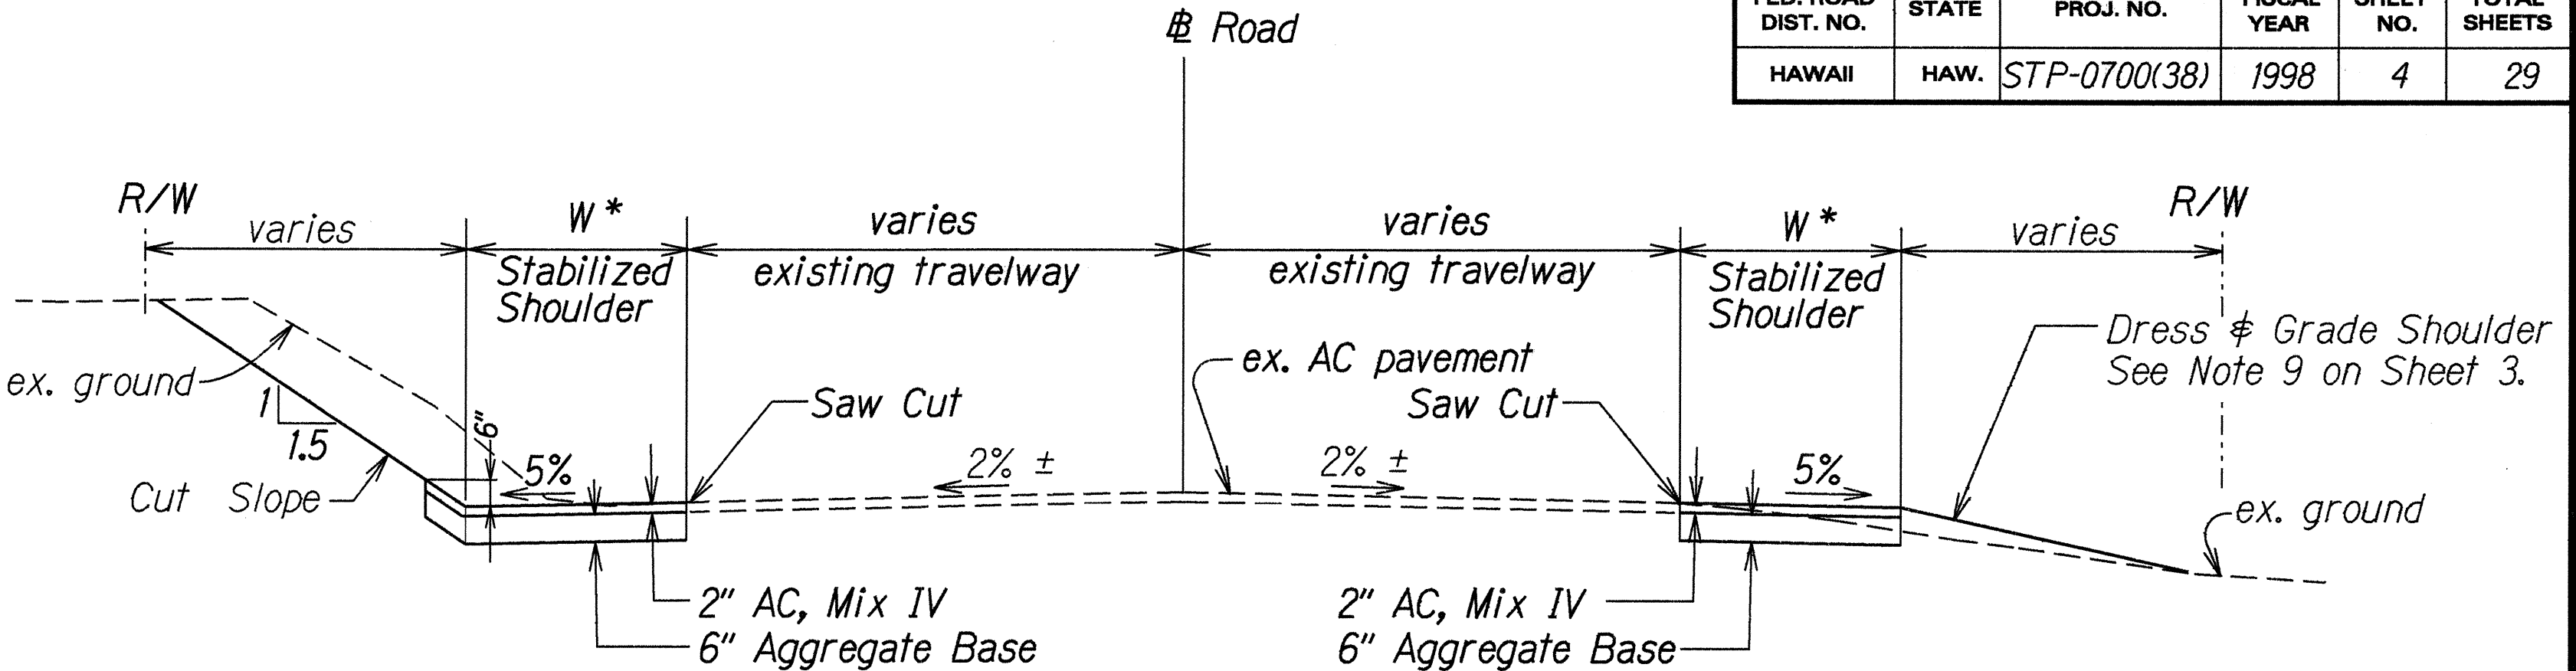


Stabilized Shoulder Improvements
Typical Cut Section

Stabilized Shoulder Improvements
Typical Fill Section

TYPICAL SHOULDER IMPROVEMENTS SECTION


Not To Scale

4
6,7,9,10,11,12,13,14,16,17,18

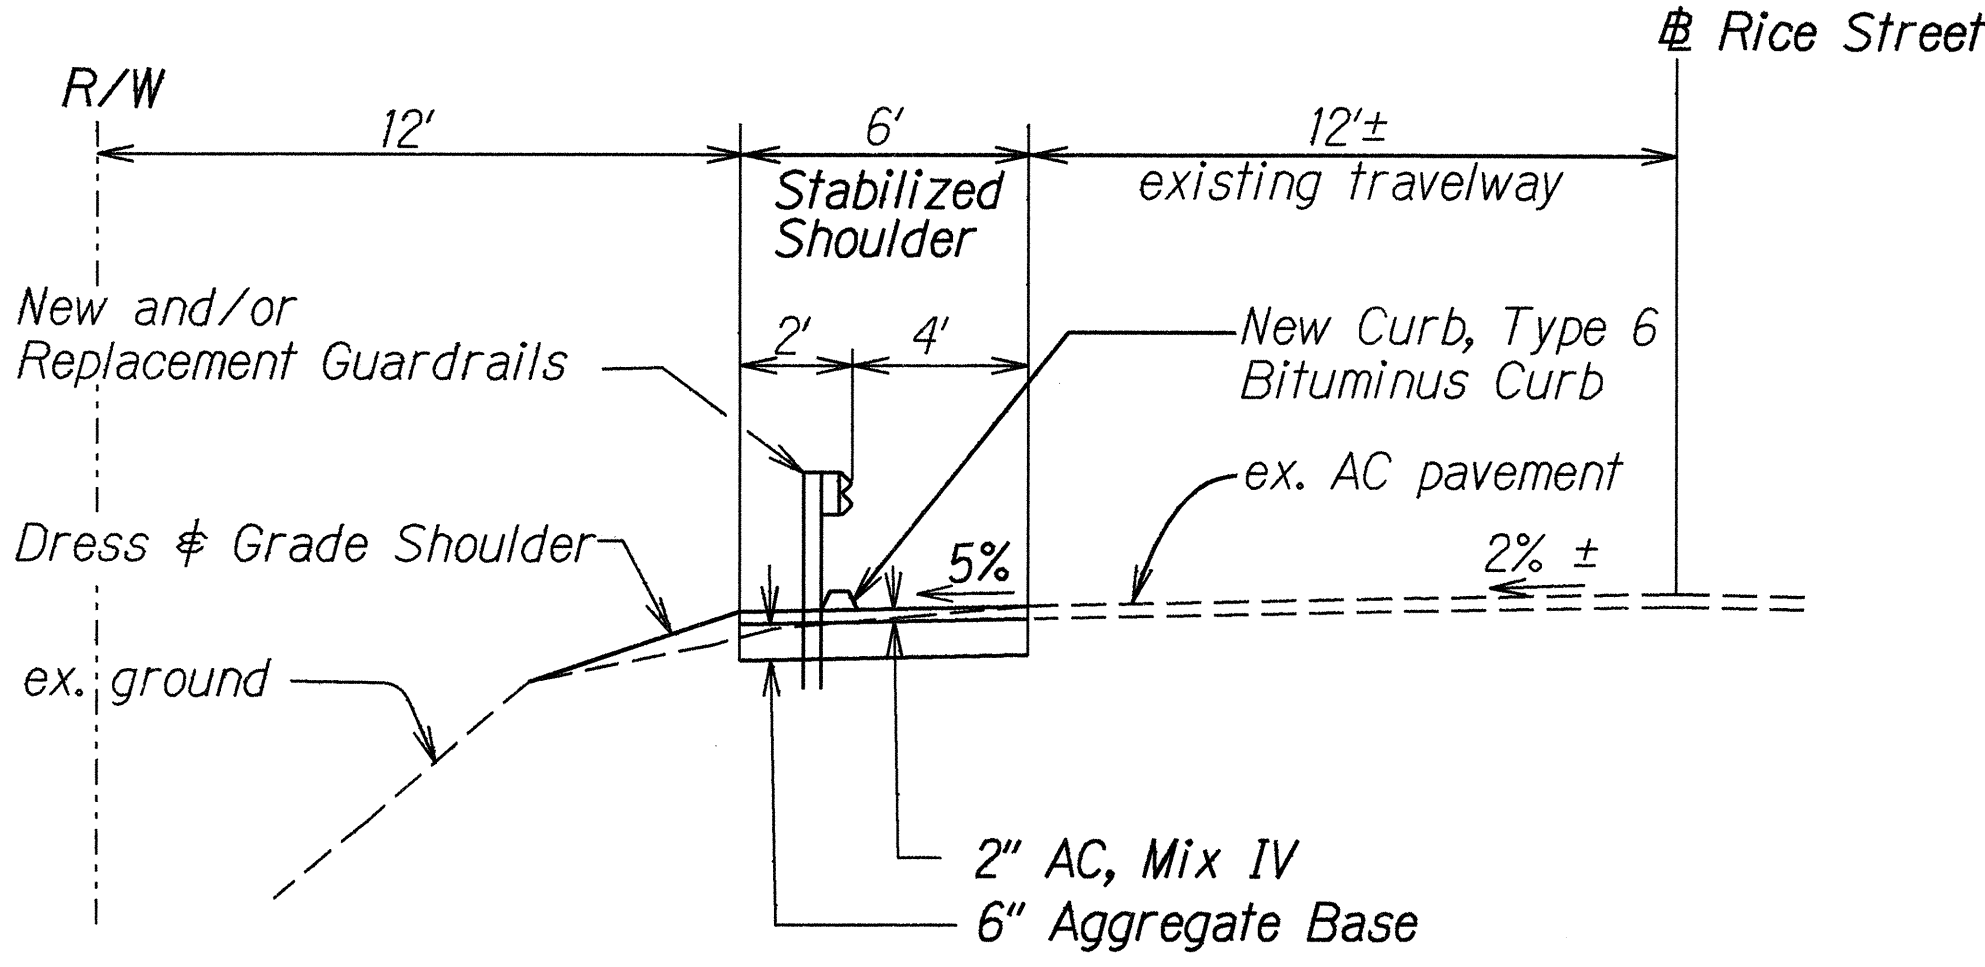

TYPICAL SECTION AT GUARDRAILS W/ CURB
RICE STREET 17+60 TO 26+40

Not To Scale

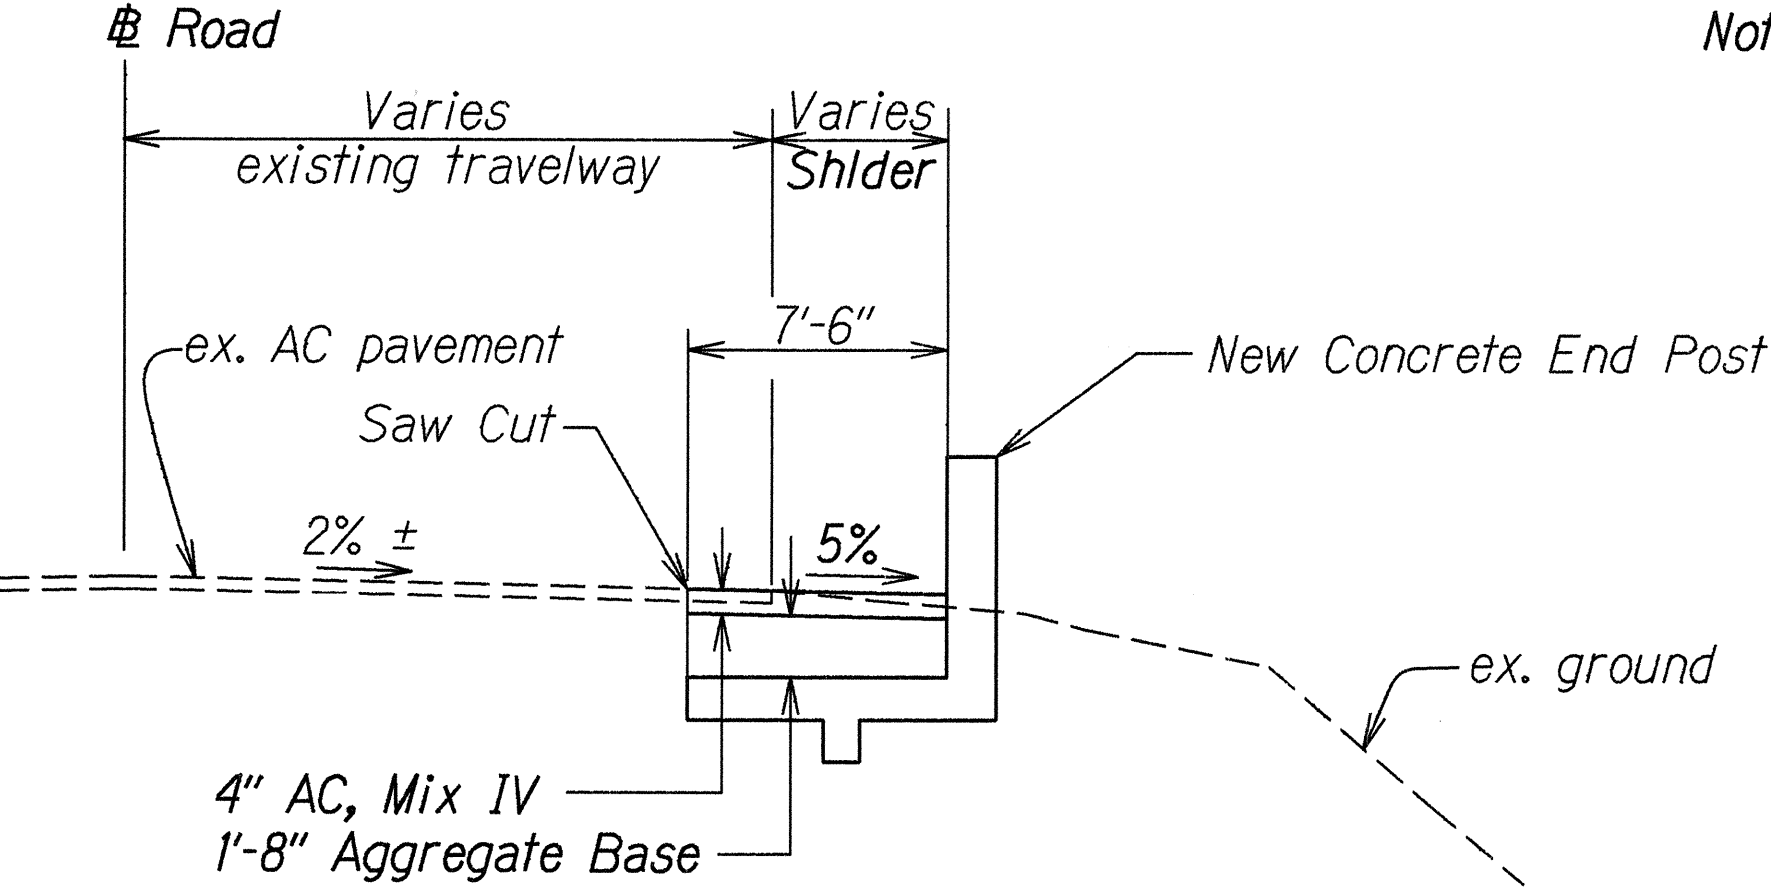

TYPICAL SECTION AT CONCRETE END POSTS


Not To Scale

LEGEND FOR AS-BUILT POSTINGS	
	Squiggly line for as-built deletion
	Double line for as-built deletion
Roadway	Text for as-built posting

NOTES:


1. See Sheet 27 For Shoulder Widths (W), Shoulder Work Summary & Guardrail Work Summary
2. Shoulder improvement section is typical for Kuhio Hwy., Rice St. & Kuamoo Rd. unless detailed otherwise on this sheet.
3. Use 8' long posts if less than 2' from back of post to top of slope.

ORIGINAL PLAN	DATE	11-16-97
SURVEY PLOTTED BY	DATE	11-16-97
DRAWN BY	DATE	11-16-97
CHECKED BY	DATE	11-16-97
NOTED BY	DATE	11-16-97
QUANTITIES BY	DATE	11-16-97
CHECKED BY	DATE	11-16-97

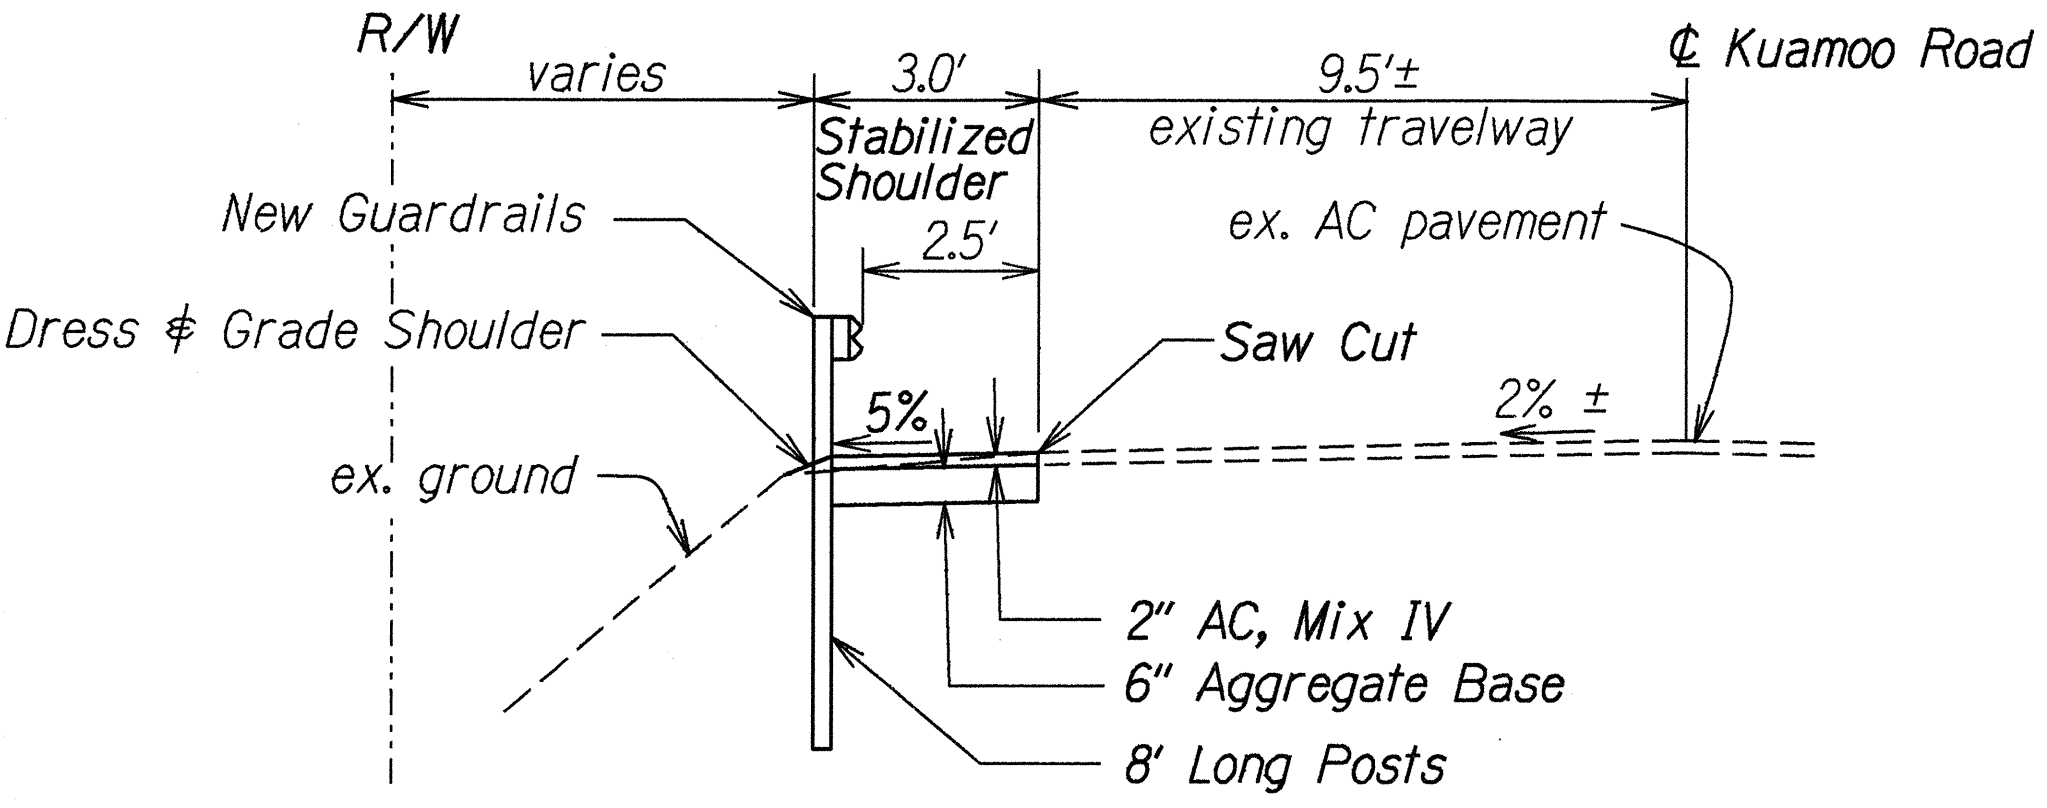

TYPICAL SECTION
KUAMOO ROAD 60+80 TO 67+00

Not To Scale

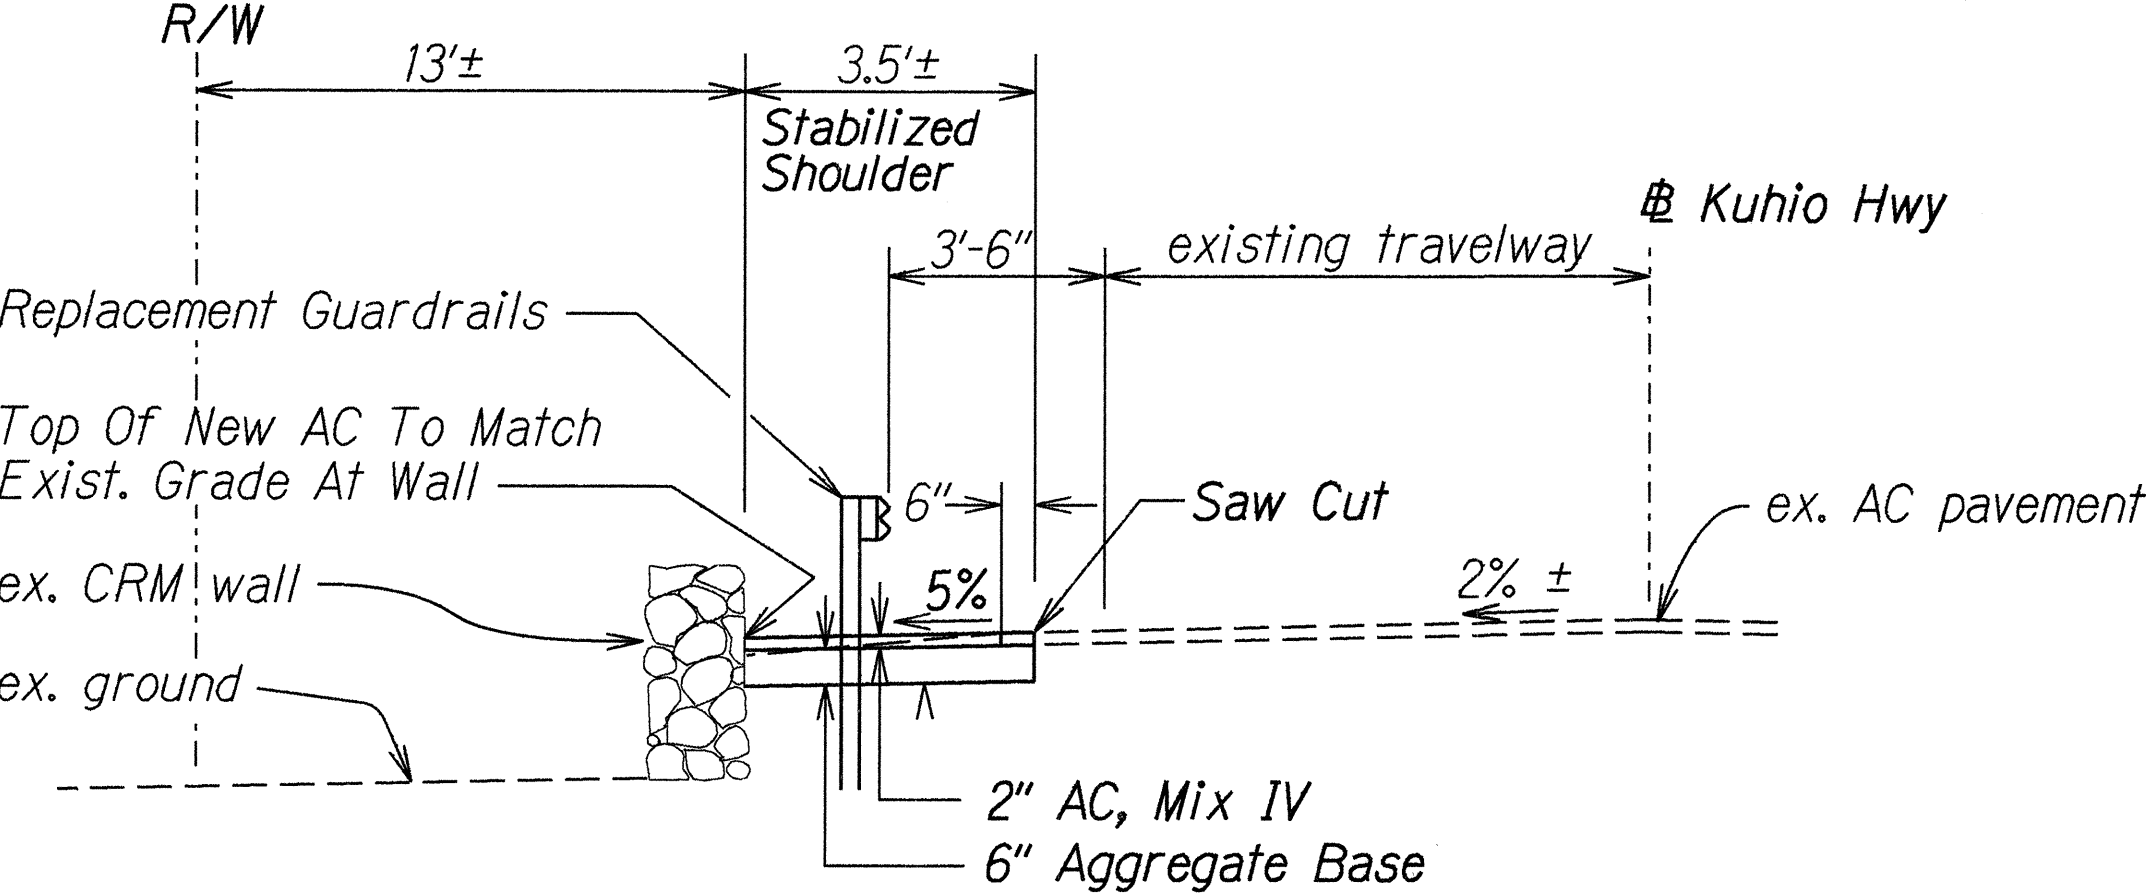

TYPICAL SECTION
KUHIO HWY 140+70 TO 144+05

Not To Scale

STATE OF HAWAII DEPARTMENT OF TRANSPORTATION HIGHWAYS DIVISION	
TYPICAL SECTIONS	
RICE STREET, KUHIO HIGHWAY AND KUAMOO ROAD	
GUARDRAIL AND SHOULDER IMPROVEMENTS AT VARIOUS LOCATIONS	
FEDERAL AID PROJECT NO. STP-0700(38)	
Scale: As Shown	Date: Sept, 1996
SHEET No. 1 OF 1 SHEETS	