




FED. ROAD DIST. NO.	STATE	FED. AID PROJ. NO.	FISCAL YEAR	SHEET NO.	TOTAL SHEETS
HAWAII	HAW.	STP-0700 (43)	1998	137	141

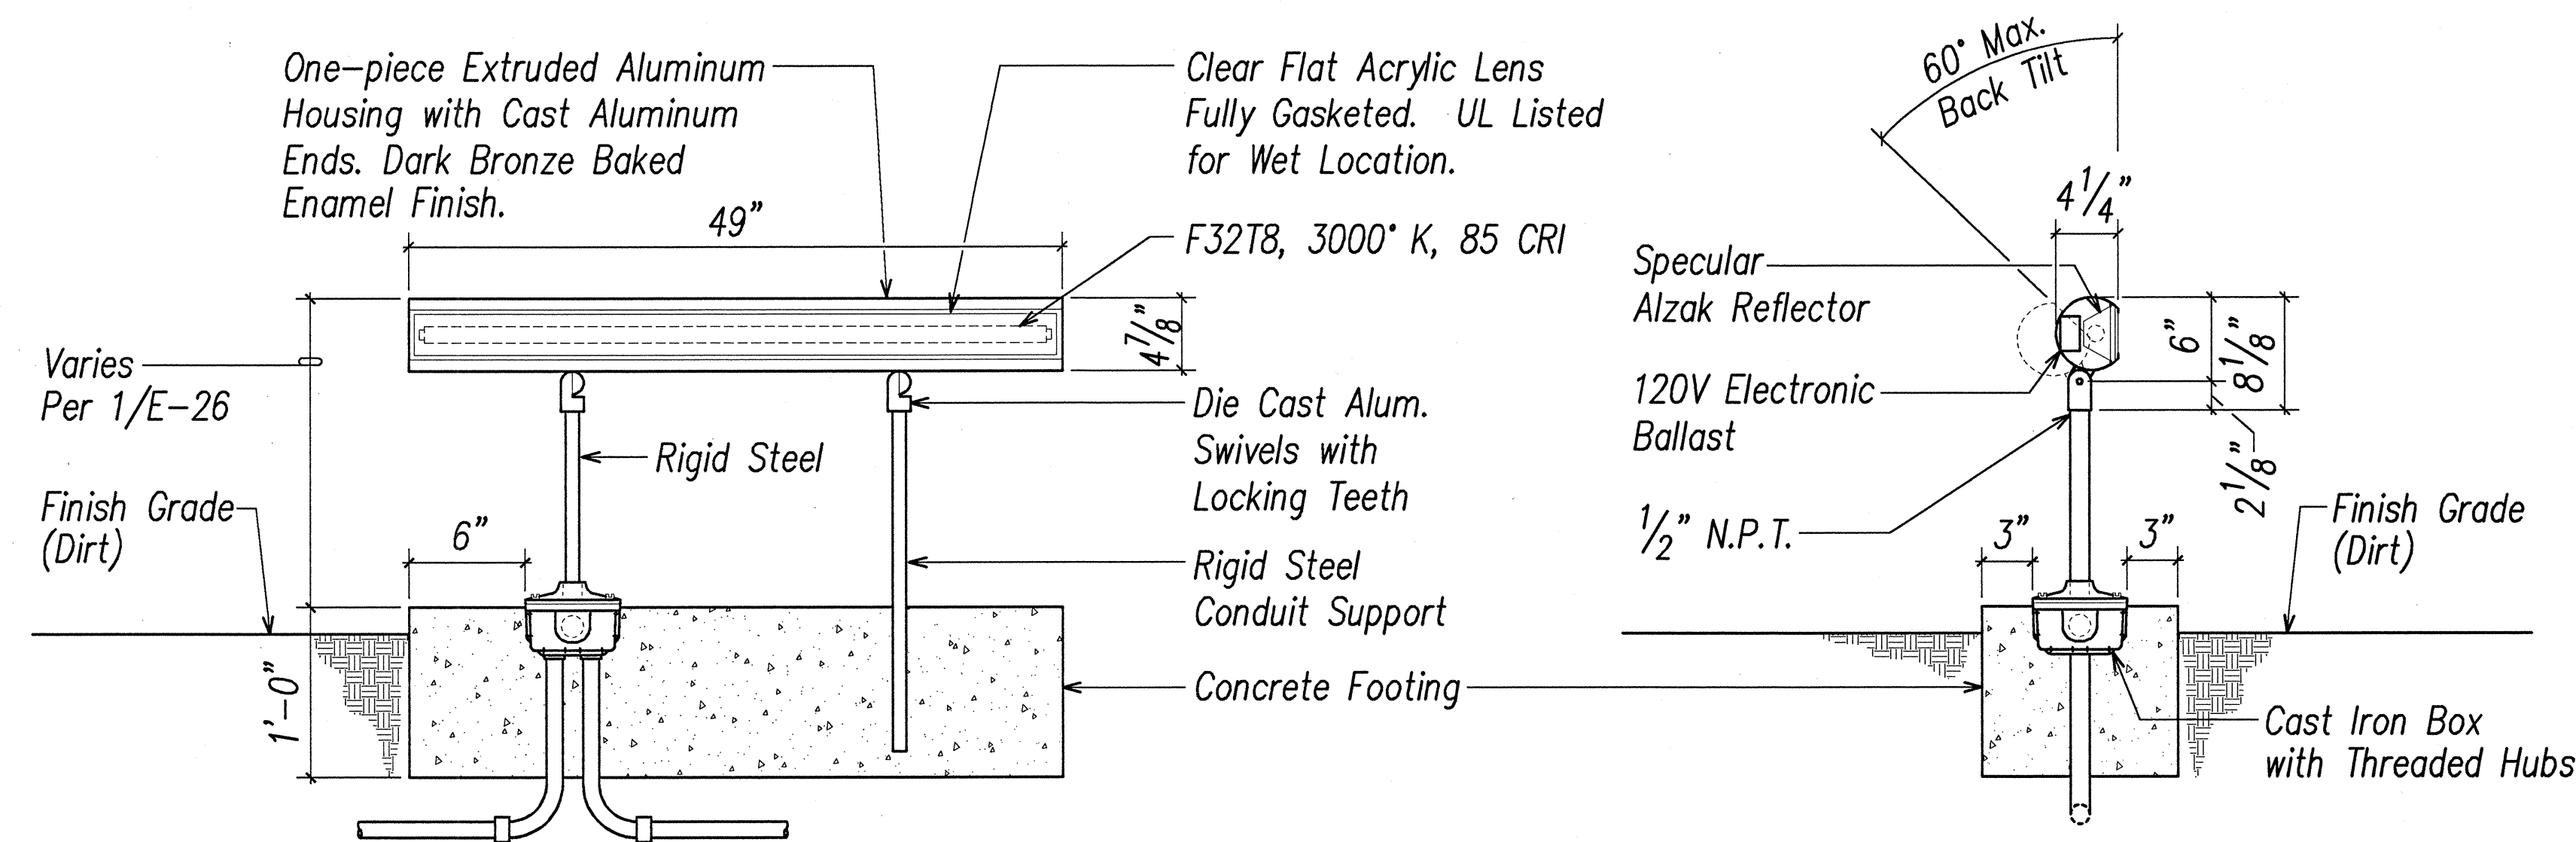

Type "A"

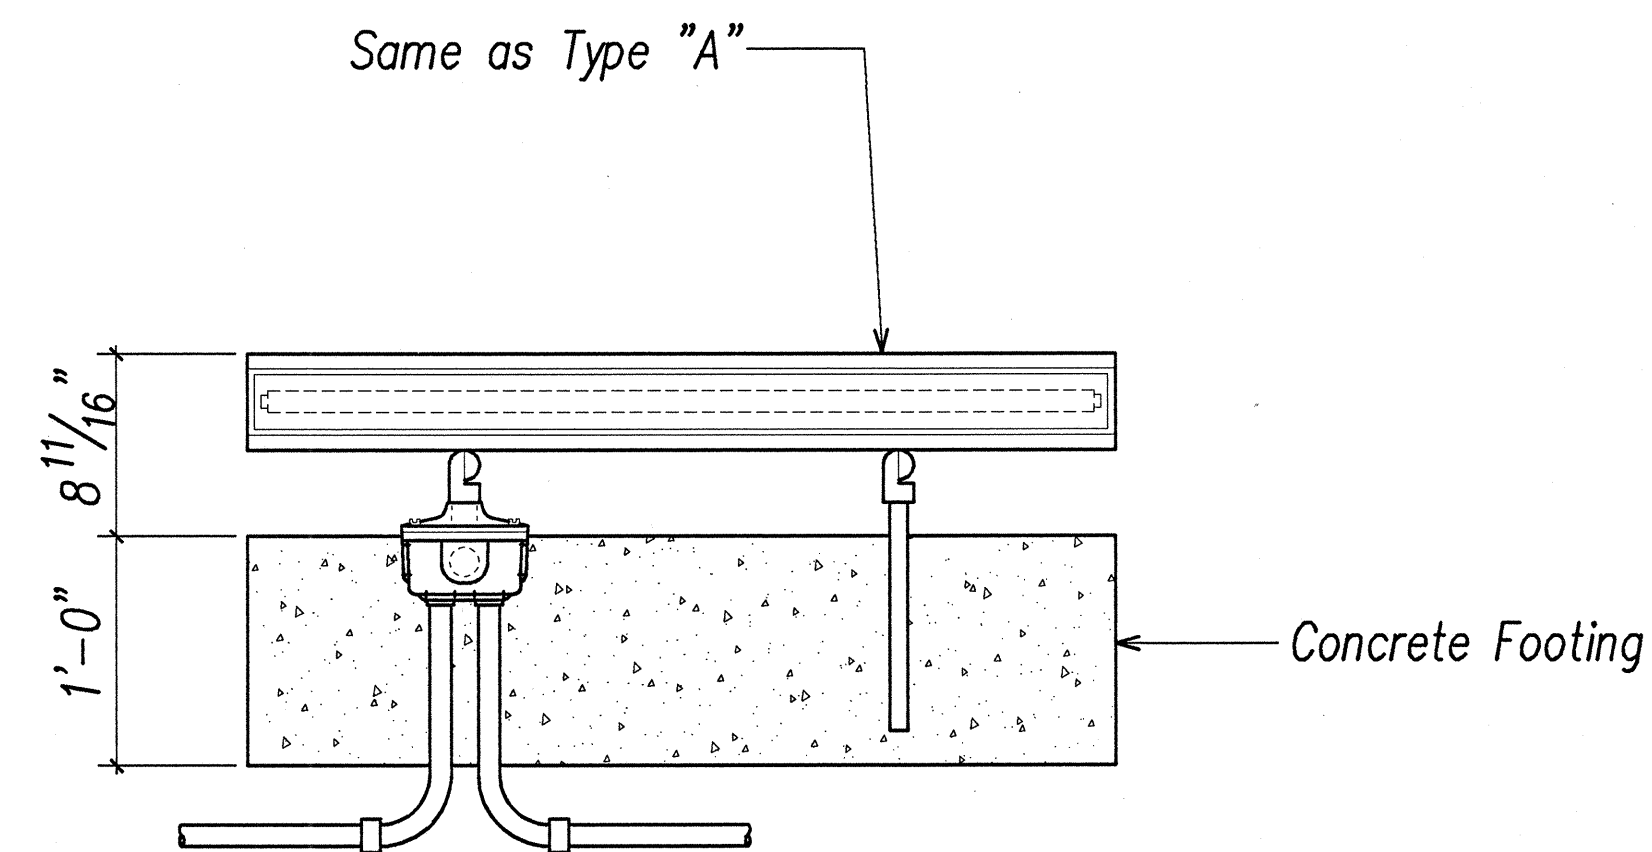


Type "C"

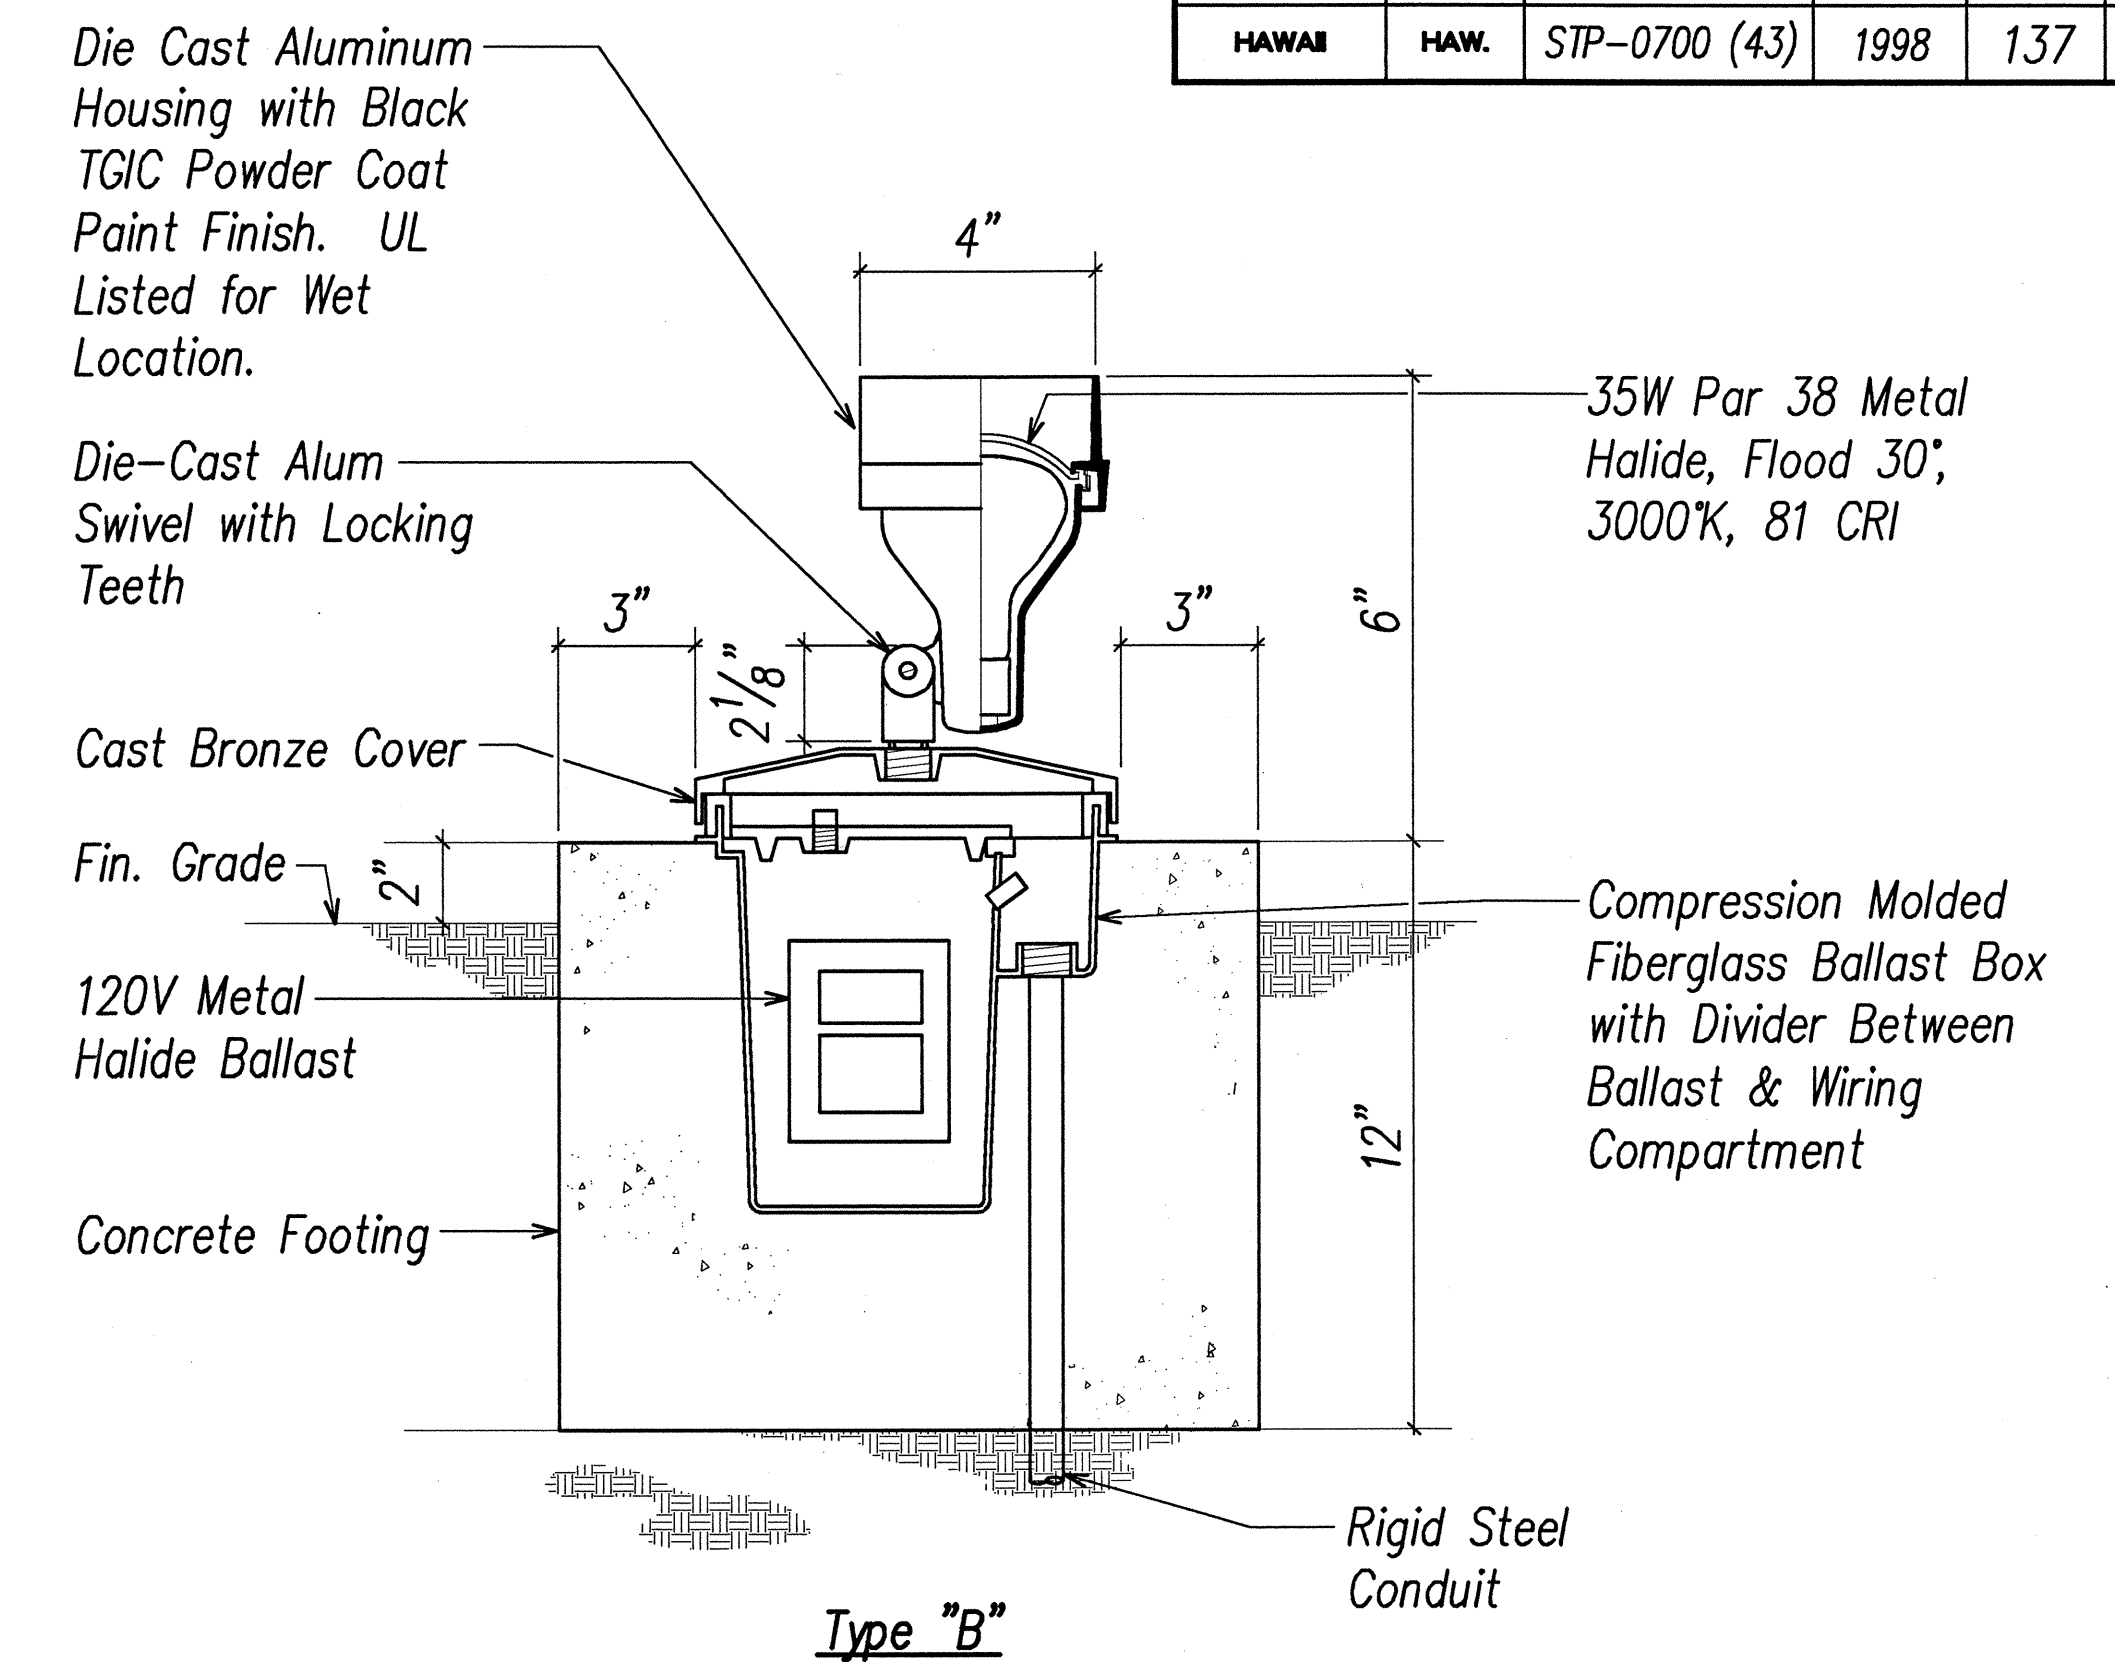


Type "B"

LIGHTING FIXTURES
Not to Scale

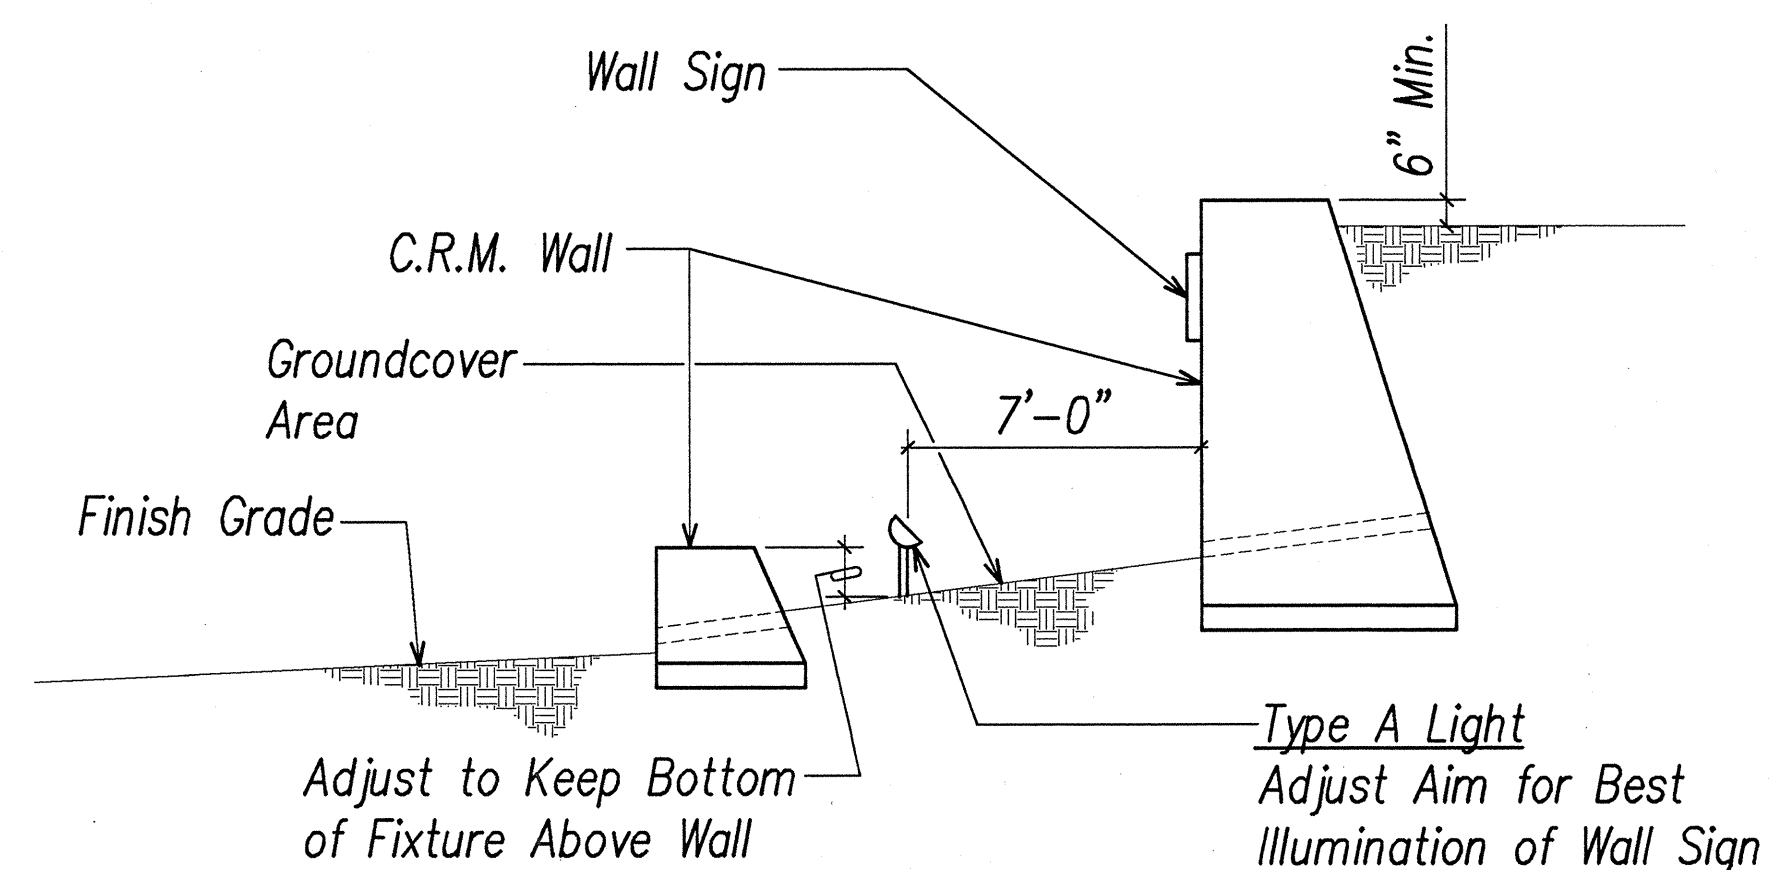

1 TYPE "A" LIGHT INSTALLATION
E-26 Not to Scale

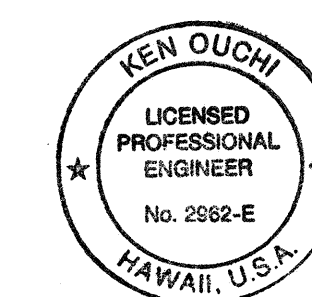

K. Ouchi
THIS WORK WAS PREPARED BY
ME OR UNDER MY SUPERVISION.

STATE OF HAWAII
DEPARTMENT OF TRANSPORTATION
HIGHWAYS DIVISION
LANDSCAPE LIGHTS

LIHUE GATEWAY LANDSCAPE
BEAUTIFICATION PROJECT

Scale: AS NOTED Date: OCTOBER 1998
SHEET No. E-26 OF 30 SHEETS