
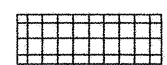
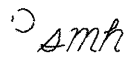
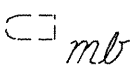
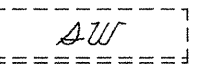
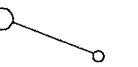
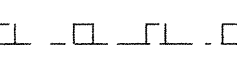
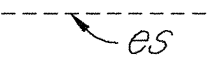
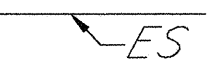
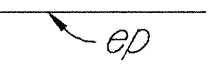
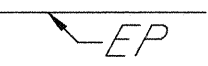
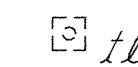
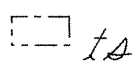
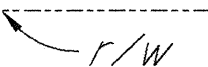
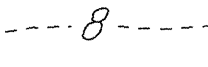
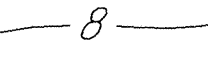
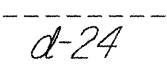
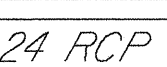
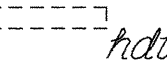


FED. ROAD DIST. NO.	STATE	PROJ. NO.	FISCAL YEAR	SHEET NO.	TOTAL SHEETS
HAWAII	HAW.	STP-0700(43)	1998	4	141

LEGEND

	Reconstruction Areas		Existing Sewer Line
	Cold Planing Areas		Existing Sewer Manhole
	Resurfacing Limits		Adjusted Sewer MH Frame/Cover
	Existing Joint Pole		Existing Sewer Cleanout
	Existing Power Pole		Existing Mailbox
	Existing Guy Pole		Existing Sidewalk
	Existing Electrical Manhole		Existing Highway Lighting Standard
	Existing Electrical Pullbox		Existing Traffic Sign
	Adjusted Electrical Pullbox Frame/Cover		Existing Flashing Light Signal
	Existing Telephone Pole		Existing Guard Rail
	Existing Telephone Manhole		Existing Chain Link Fence
	Existing Telephone Pullbox		Existing Edge Shoulder
	Adjusted Telephone Pullbox Frame/Cover		New Edge Shoulder
	Existing TV Cable Pullbox		Existing Edge Pavement
	Existing Water Meter		New Edge Pavement
	Adjusted Water MH Frame/Cover		Existing A.C. Curb
	Existing Water Valve Box		Existing Traffic Signal Pole
	Adjusted Water Valve Box		Existing Traffic Signal Pullbox
	Existing Fire Hydrant		Adjusted Traffic Signal Pullbox
	Existing Water Line		Existing Highway Right of Way
	Adjusted Subdrain Cleanout		Existing Contour
	Existing Grated Drain Inlet		Finish Contour
	Existing Catch Basin		Finish Grade Elevation
	Existing Storm Drain Manhole		
	Adjusted Storm Drain MH Frame/Cover		
	Existing Drain Line		
	New Drain Line		
	Existing Headwall		
	Existing Swale		

SURVEY PLOTTED BY	DATE
DRAWN BY	DATE
DESIGNED BY	DATE
QUANTITIES BY	DATE
CHECKED BY	DATE
ORIGINAL PLAN	
NOTE BOOK	
No.	

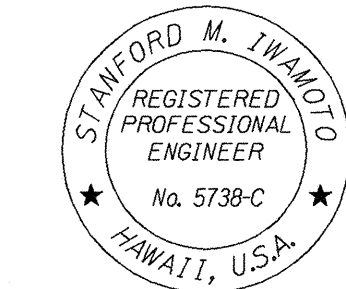

THIS WORK WAS PREPARED BY ME
OR UNDER MY SUPERVISION

[Signature]
Signature

STATE OF HAWAII
DEPARTMENT OF TRANSPORTATION
HIGHWAYS DIVISION

LEGEND

LIHUE GATEWAY LANDSCAPE
BEAUTIFICATION PROJECT

Scale: N.T.S.
Date: July 31, 1998

SHEET No. C - 3 OF 10 SHEETS