


FED. ROAD DIST. NO.	STATE	PROJ. NO.	FISCAL YEAR	SHEET NO.	TOTAL SHEETS
HAWAII	HAW.	STP-0700(43)	1998	5	141



SURVEY PLOTTED BY	DATE
DRAWN BY	DATE
TRACED BY	DATE
DESIGNED BY	DATE
CHECKED BY	DATE
ORIGINAL PLAN	
NOTE BOOK	
No.	

mass-1.dgn

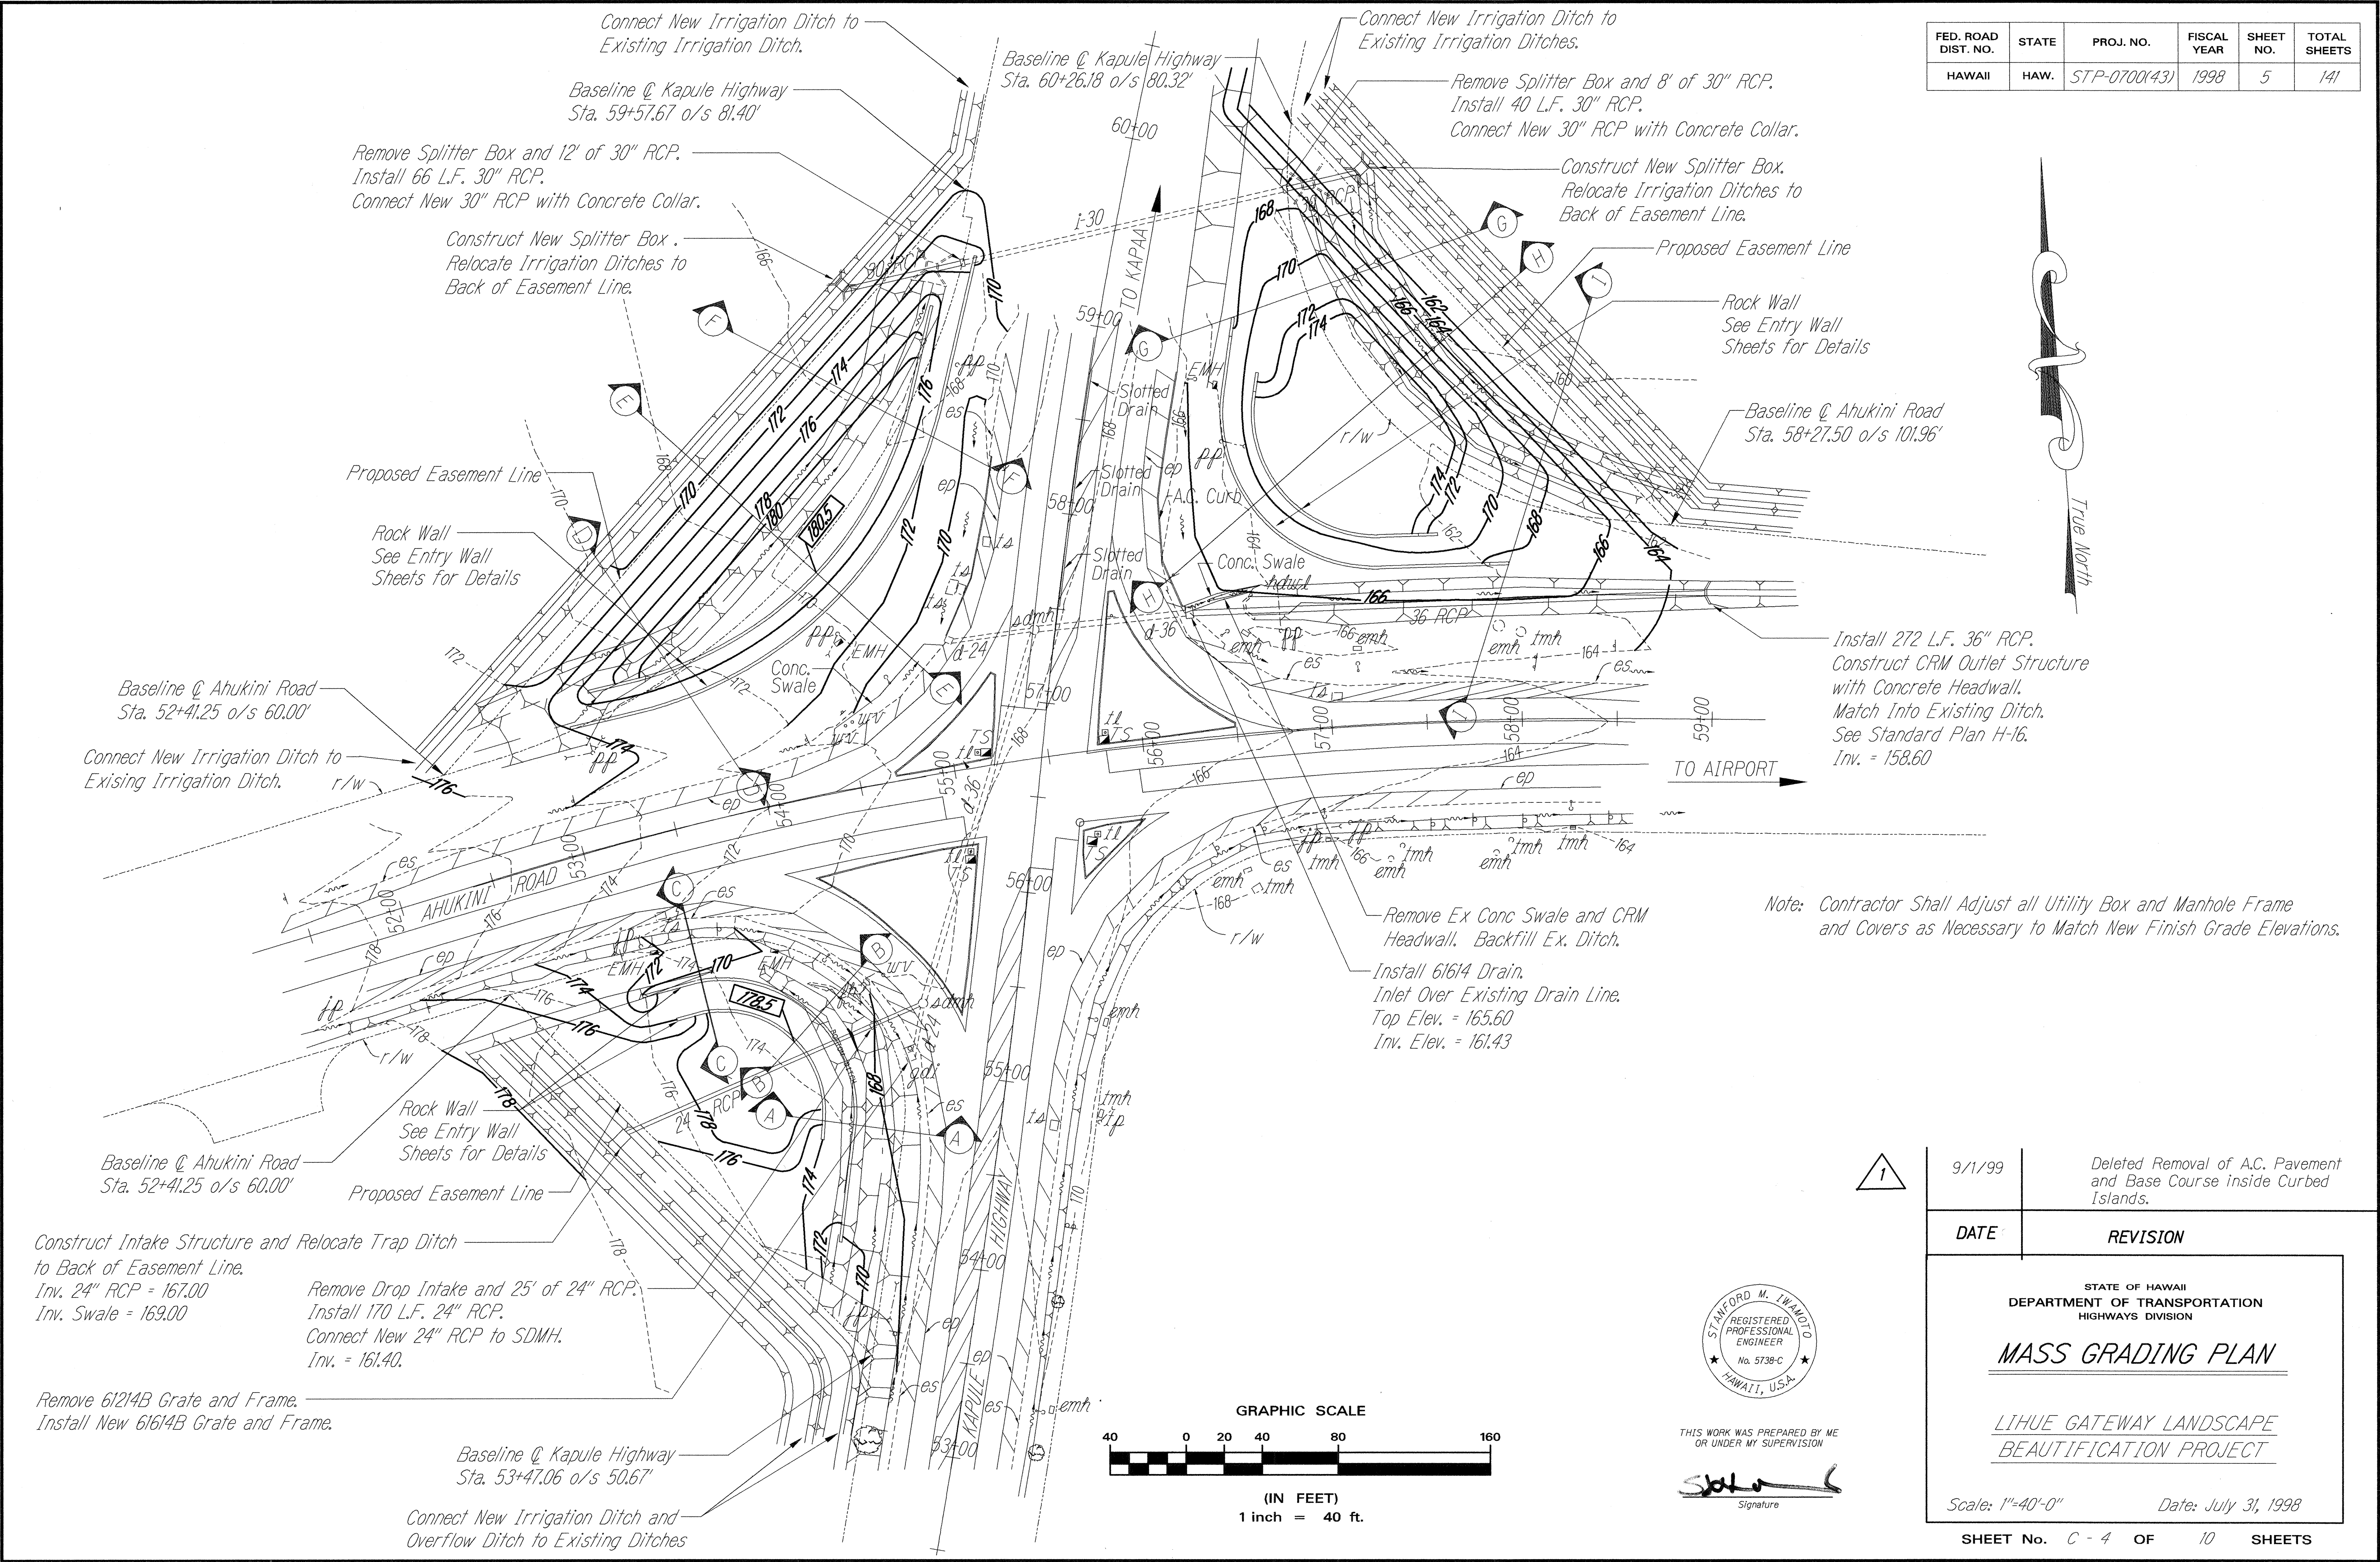