STATE OF HAWAII

DEPARTMENT OF TRANSPORTATION


HIGHWAYS DIVISION HONOLULU, HAWAII

PLANS FOR

FED. ROAD DIST. NO. STATE FED. AID PROJ. NO. FISCAL SHEET NO. SHEETS HAWAII HAW. STP-0700(40) 1998 1 13






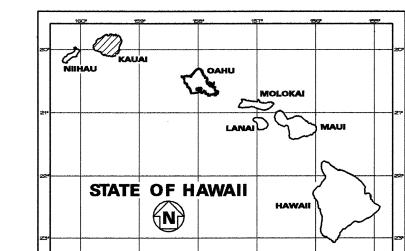


KAPULE HIGHWAY AND KUHIO HIGHWAY

GUARDRAIL AND SHOULDER IMPROVEMENTS AT VARIOUS LOCATIONS

FEDERAL AID PROJECT NO. STP-0700(40)

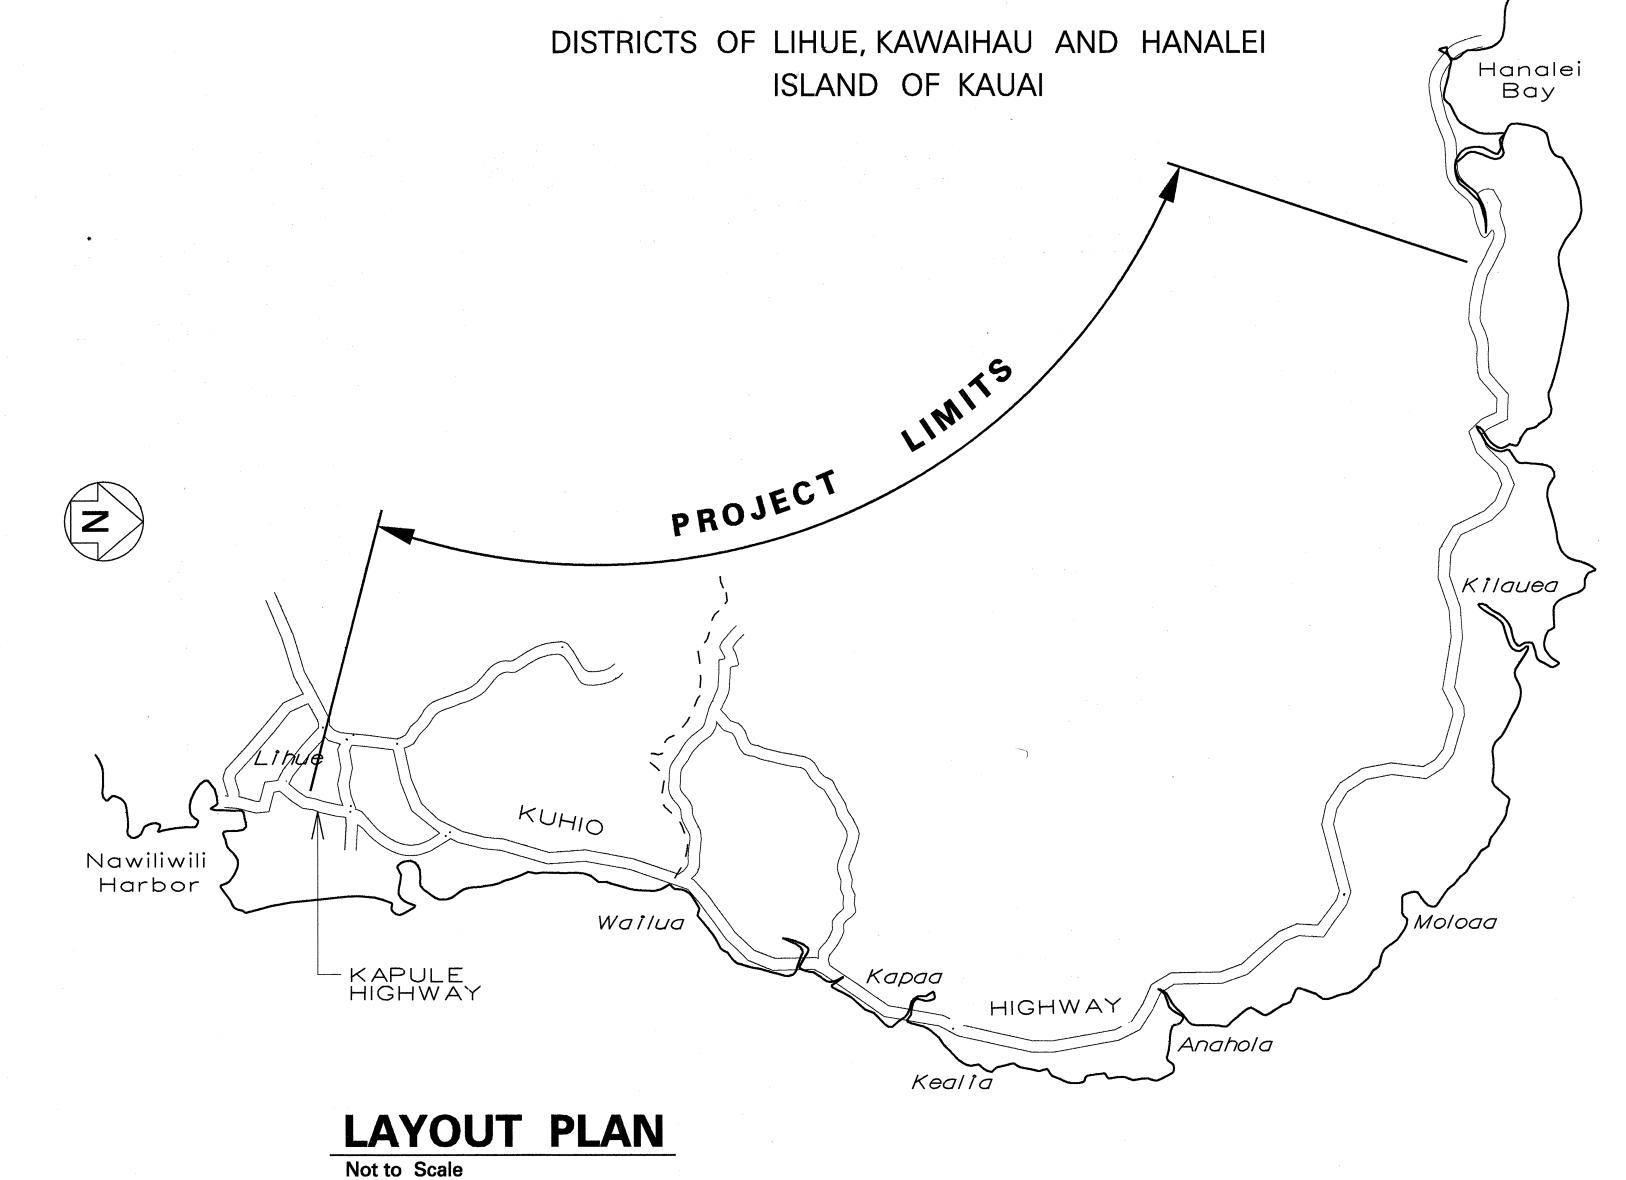

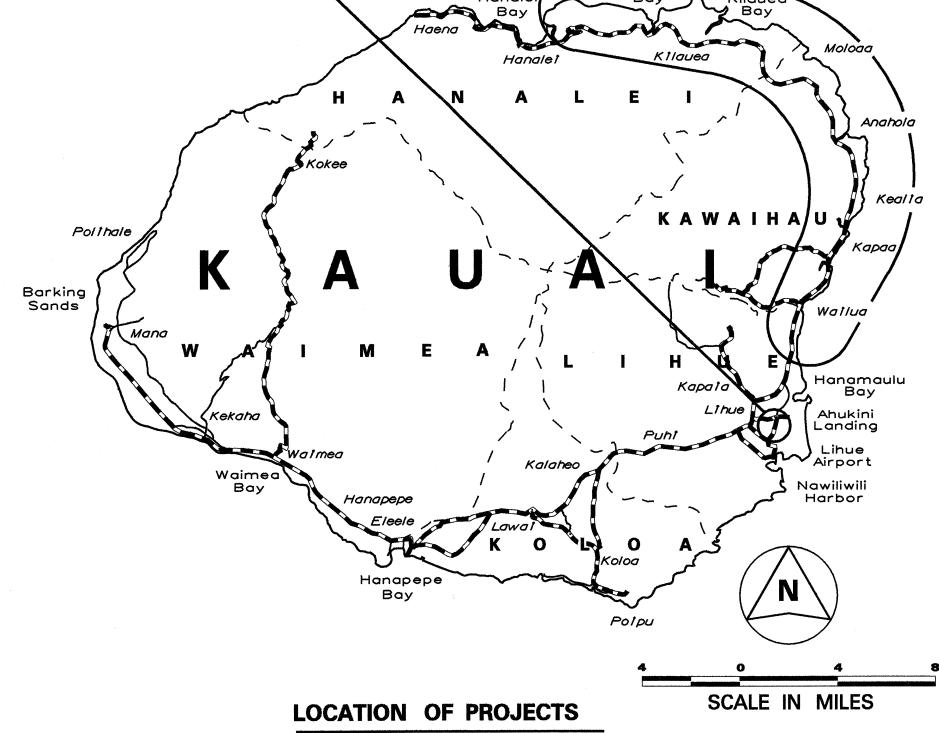

FEDERAL AID PROJECTS PREVIOUSLY CONSTRUCTED OR UNDER CONSTRUCTION

ACTUAL QUANTITIES, REFER TO PROJECT LEDGER
AND/OR COMPUTATION BOOK.

LOCATIONS OF PROJECT

8/10/2000

KAPULE HIGHWAY - MILE POST 1.2 KUHIO HIGHWAY - MILE POST 4.0 TO 28.0

KAPULE HIGHWAY AT HANAMAULU SCREENLINE DESIGN DESIGNATION

KUHIO HIGHWAY AT WAILUA SCREENLINE DESIGN DESIGNATION

ADT (1998)	30,910
ADT (2008)	.39,560
DHV	. 3,165
D	. 55/45
Т	. 2.0 %
T ₂₄	. 3.5
Κ	8.0

	DEPARTMENT OF TRANSPORTATION STATE OF HAWAII APPROVED:		
	tages Sayarhich	120/98	
	DIR. OF TRANSPORTATION	DATE	

12-10-98

login: george

ckmstsht.dgn log

-