


INDEX TO DRAWINGS	
SHEET NO	DESCRIPTION
1	TITLE SHEET
2	TYPICAL SECTIONS & GENERAL NOTES
3-6	PLANS
7-14	MISC. & STANDARD DETAILS

Jan. 1971 Date
548-7490 Phone-Loc
Ronald Tsuzuki PS&E By
Kauai District Designed By


STATE OF HAWAII
DEPARTMENT OF TRANSPORTATION
HIGHWAYS DIVISION
"AS BUILT"
PLANS FOR
KAUAI BELT ROAD
RECONSTRUCTION-KALIHUWAI TO PRINCEVILLE
PROJECT NO. 56D-01-71
KAUAI BELT ROAD
RECONSTRUCTION-PRINCEVILLE TO HANAIEI
PROJECT NO. 56D-02-71
KAUAI BELT ROAD
RECONSTRUCTION-LUMAHAI TO WAINIHA POWER HOUSE ROAD
PROJECT NO. 56D-03-71

DISTRICT OF HANAIEI
ISLAND OF KAUAI

DIST. NO.	STATE	PROJ. NO.	FISCAL YEAR	SHEET NO.	TOTAL SHEETS
HAWAII	HAW.	56D-01-71 56D-02-71 56D-03-71	1971	1	14

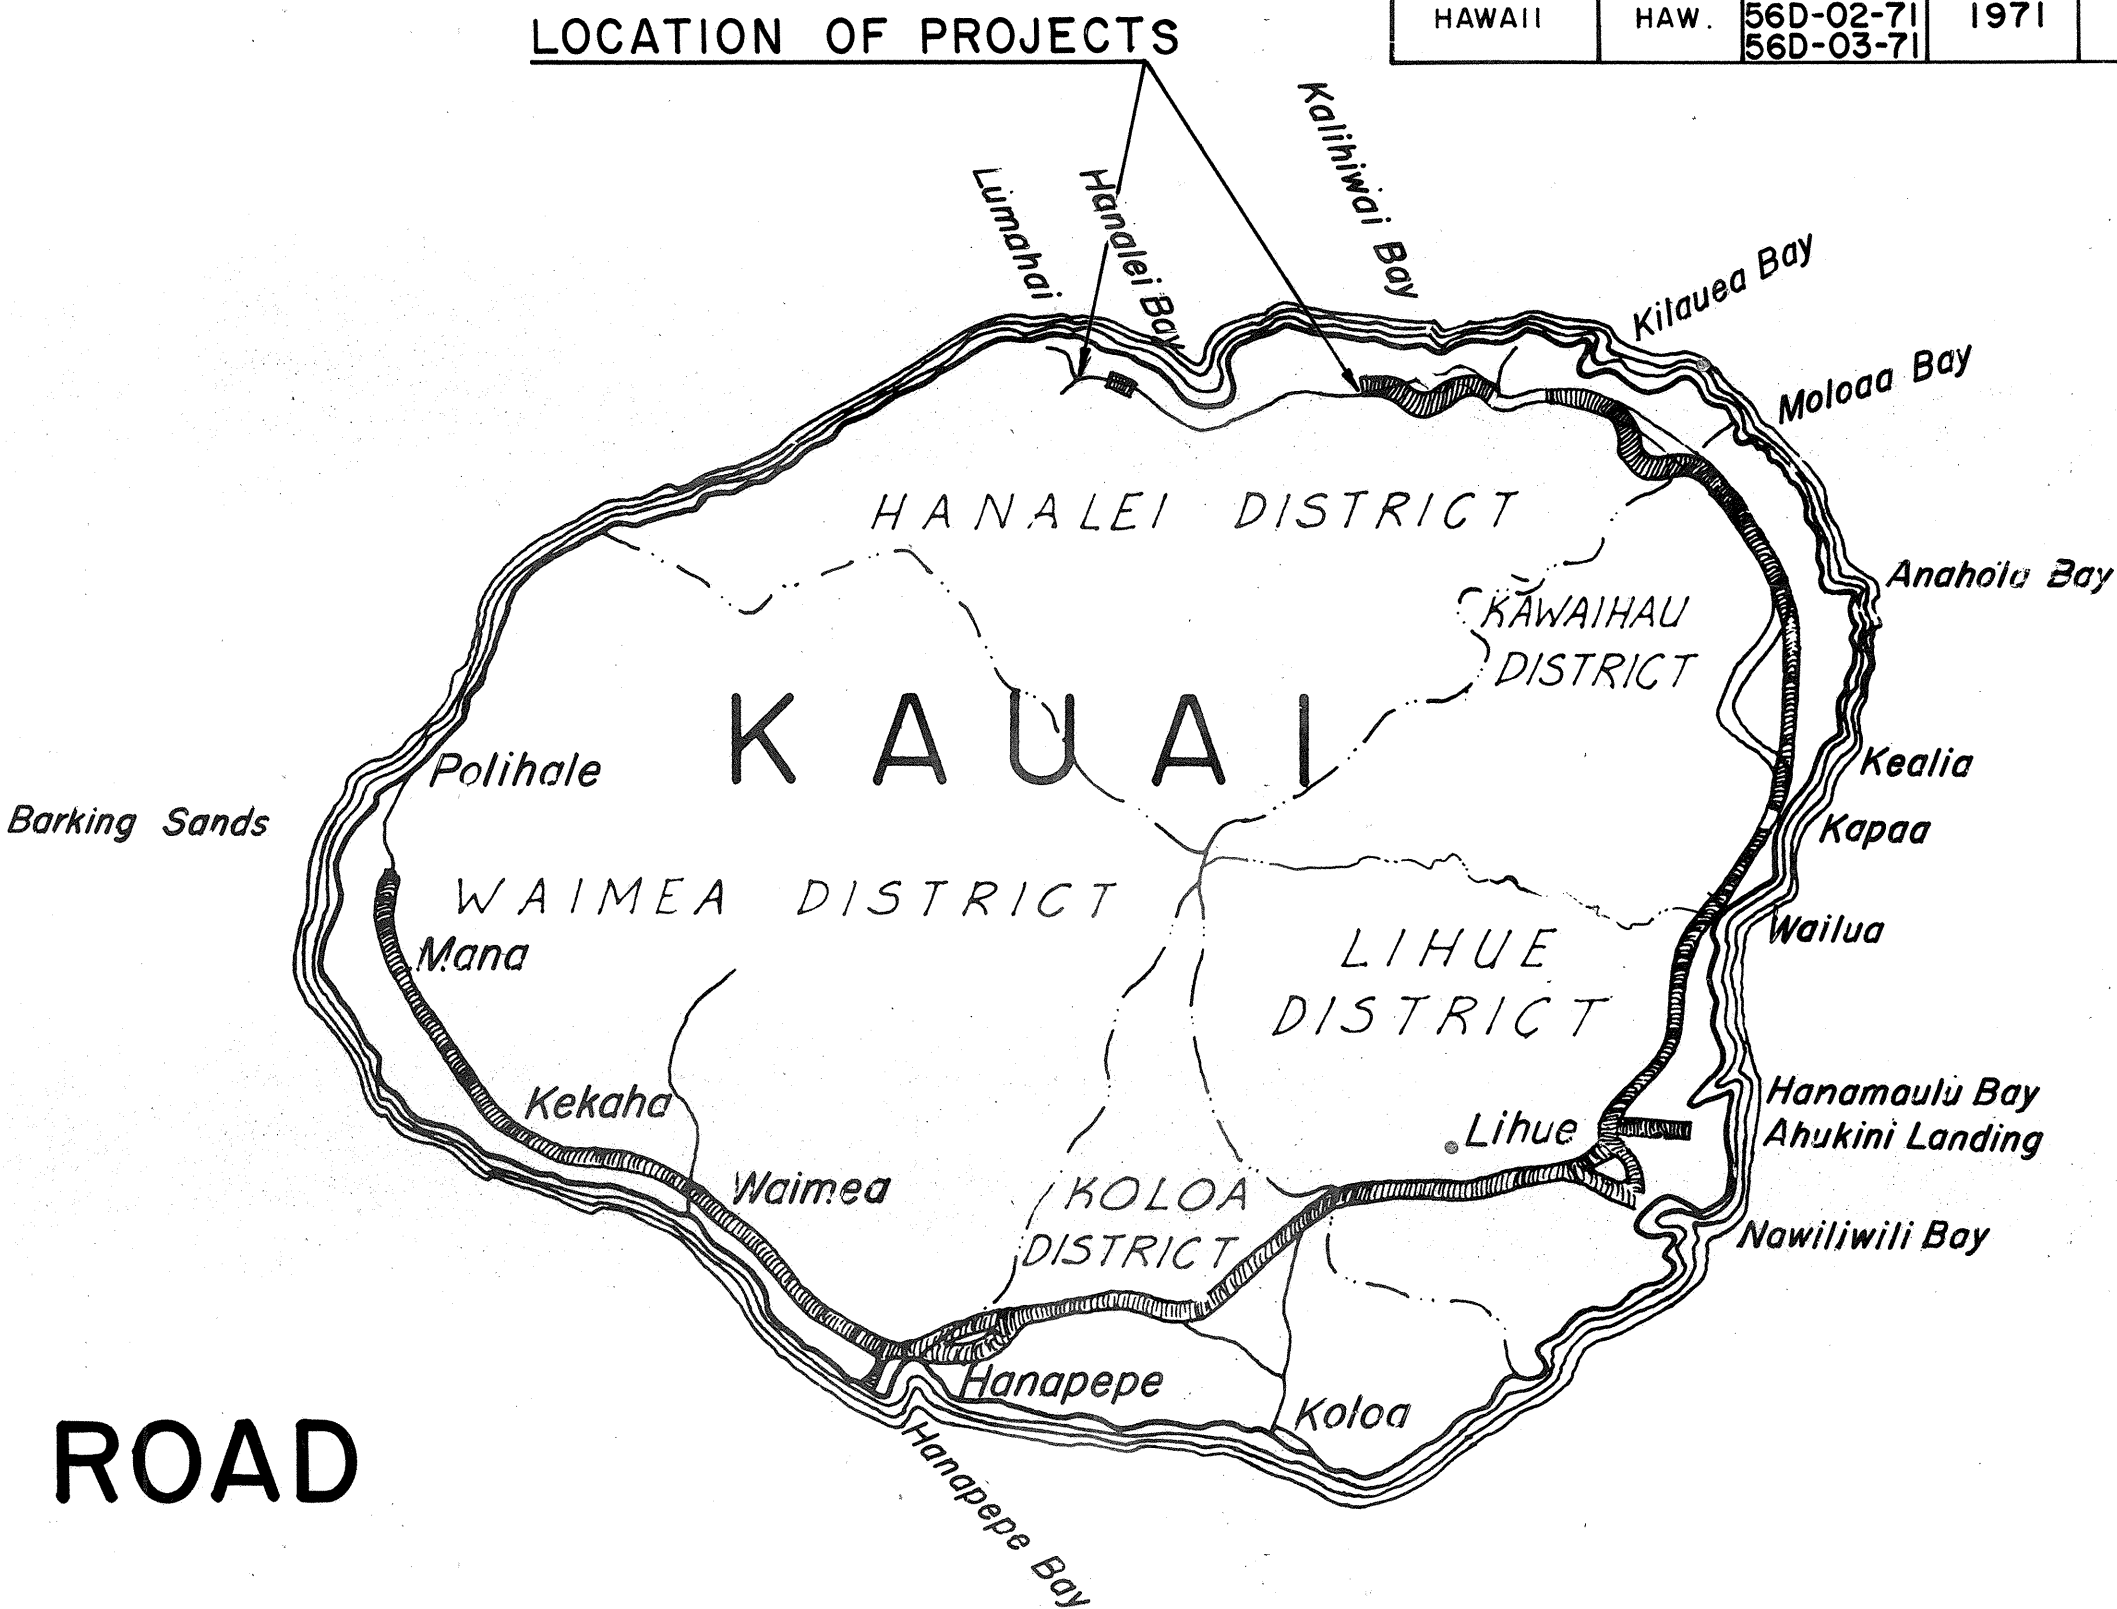

FEDERAL AID PROJECTS PREVIOUSLY CONSTRUCTED OR UNDER CONSTRUCTION

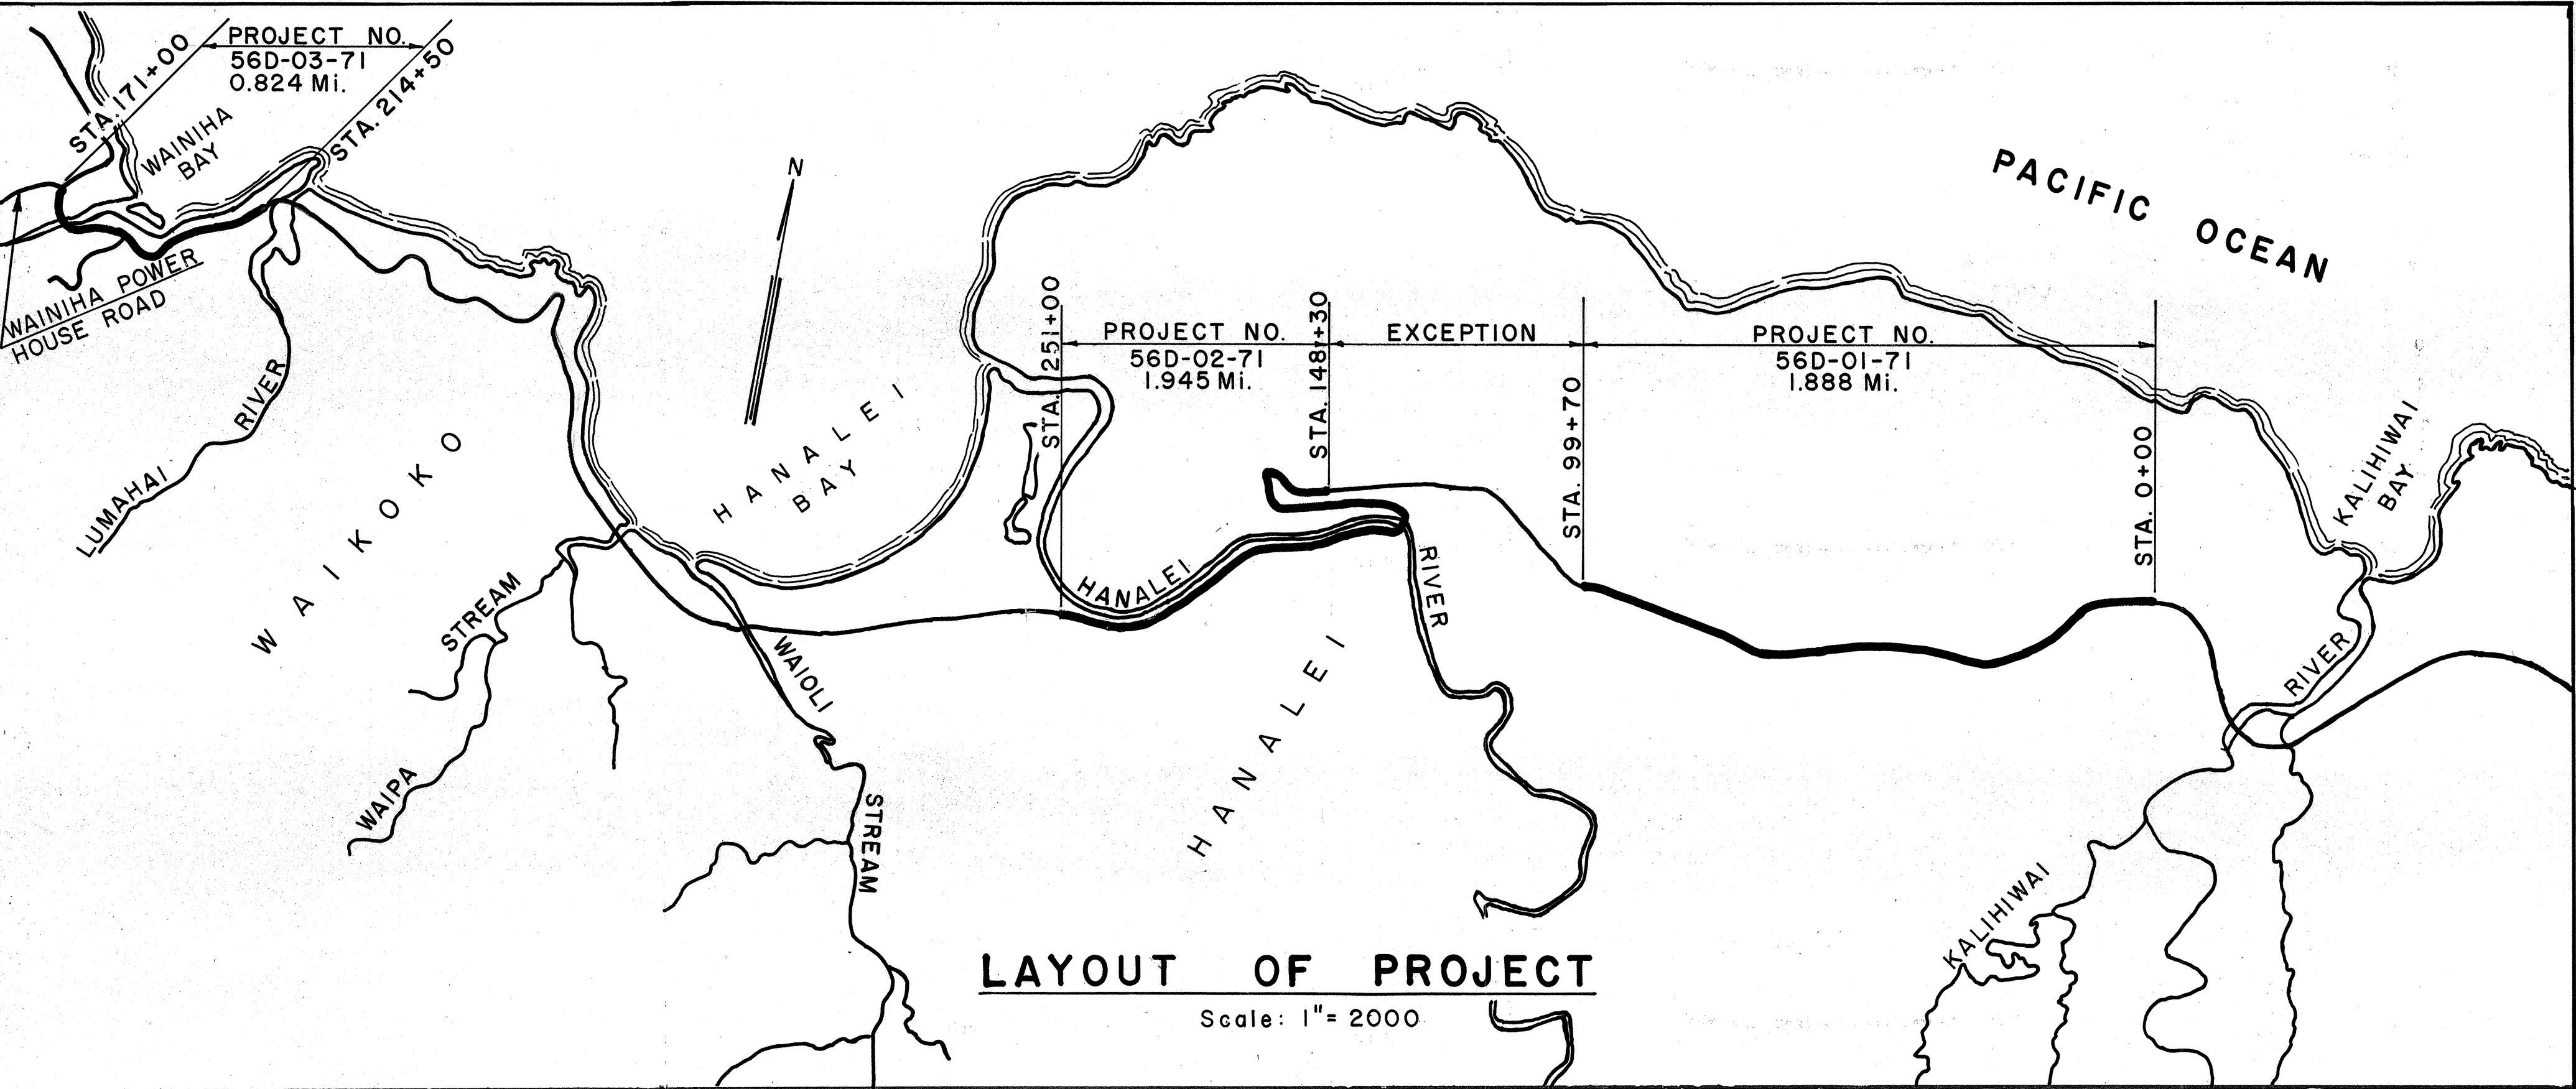

ALL CHANGES MADE DURING CONSTRUCTION HAVE BEEN INCORPORATED ON THESE PLANS IN RED EXCEPT CHANGES IN THE ORIGINAL THEORETICAL QUANTITIES. FOR ACTUAL QUANTITIES, REFER TO PROJECT LEDGER AND/OR COMPUTATION BOOK.

Donald Nagamine
RESIDENT ENGINEER

6-1-81
DATE

DEPARTMENT OF TRANSPORTATION
STATE OF HAWAII

APPROVED:

G. Avery Shigley

1/25/71

for DIR. OF TRANSPORTATION

DATE