

DIST. NO.	STATE	PROJ. NO.	FISCAL YEAR	SHEET NO.	TOTAL SHEETS
HAWAII	HAW.	56A-02-7E	1975	26	31

Exc = 0
Emb = 0

Exc = 16.7
Emb = 0

C = 18
F = 0

C = 0
F = 0

Exc = 0
Emb = 0

Exc = 25.0
Emb = 0

Exc = 0
Emb = 0

C = 0
F = 0

Exc = 0
Emb = 0

Exc = 16.7
Emb = 0

Exc = 2.8
Emb = 0

C = 3
F = 0

Exc = 0
Emb = 0

Exc = 25.0
Emb = 0

Exc = 0.3
Emb = 0

C = 7
F = 0

Exc = 0
Emb = 0

Exc = 17.6
Emb = 0

Exc = 14.8
Emb = 0


C = 9
F = 0

Exc = 8.3
Emb = 0

C = 0
F = 0

AHUKINI ROAD



DIST. NO.	STATE	PROJ. NO.	FISCAL YEAR	SHEET NO.	TOTAL SHEETS
HAWAII	HAW.	56A-02-72	1975	27	31

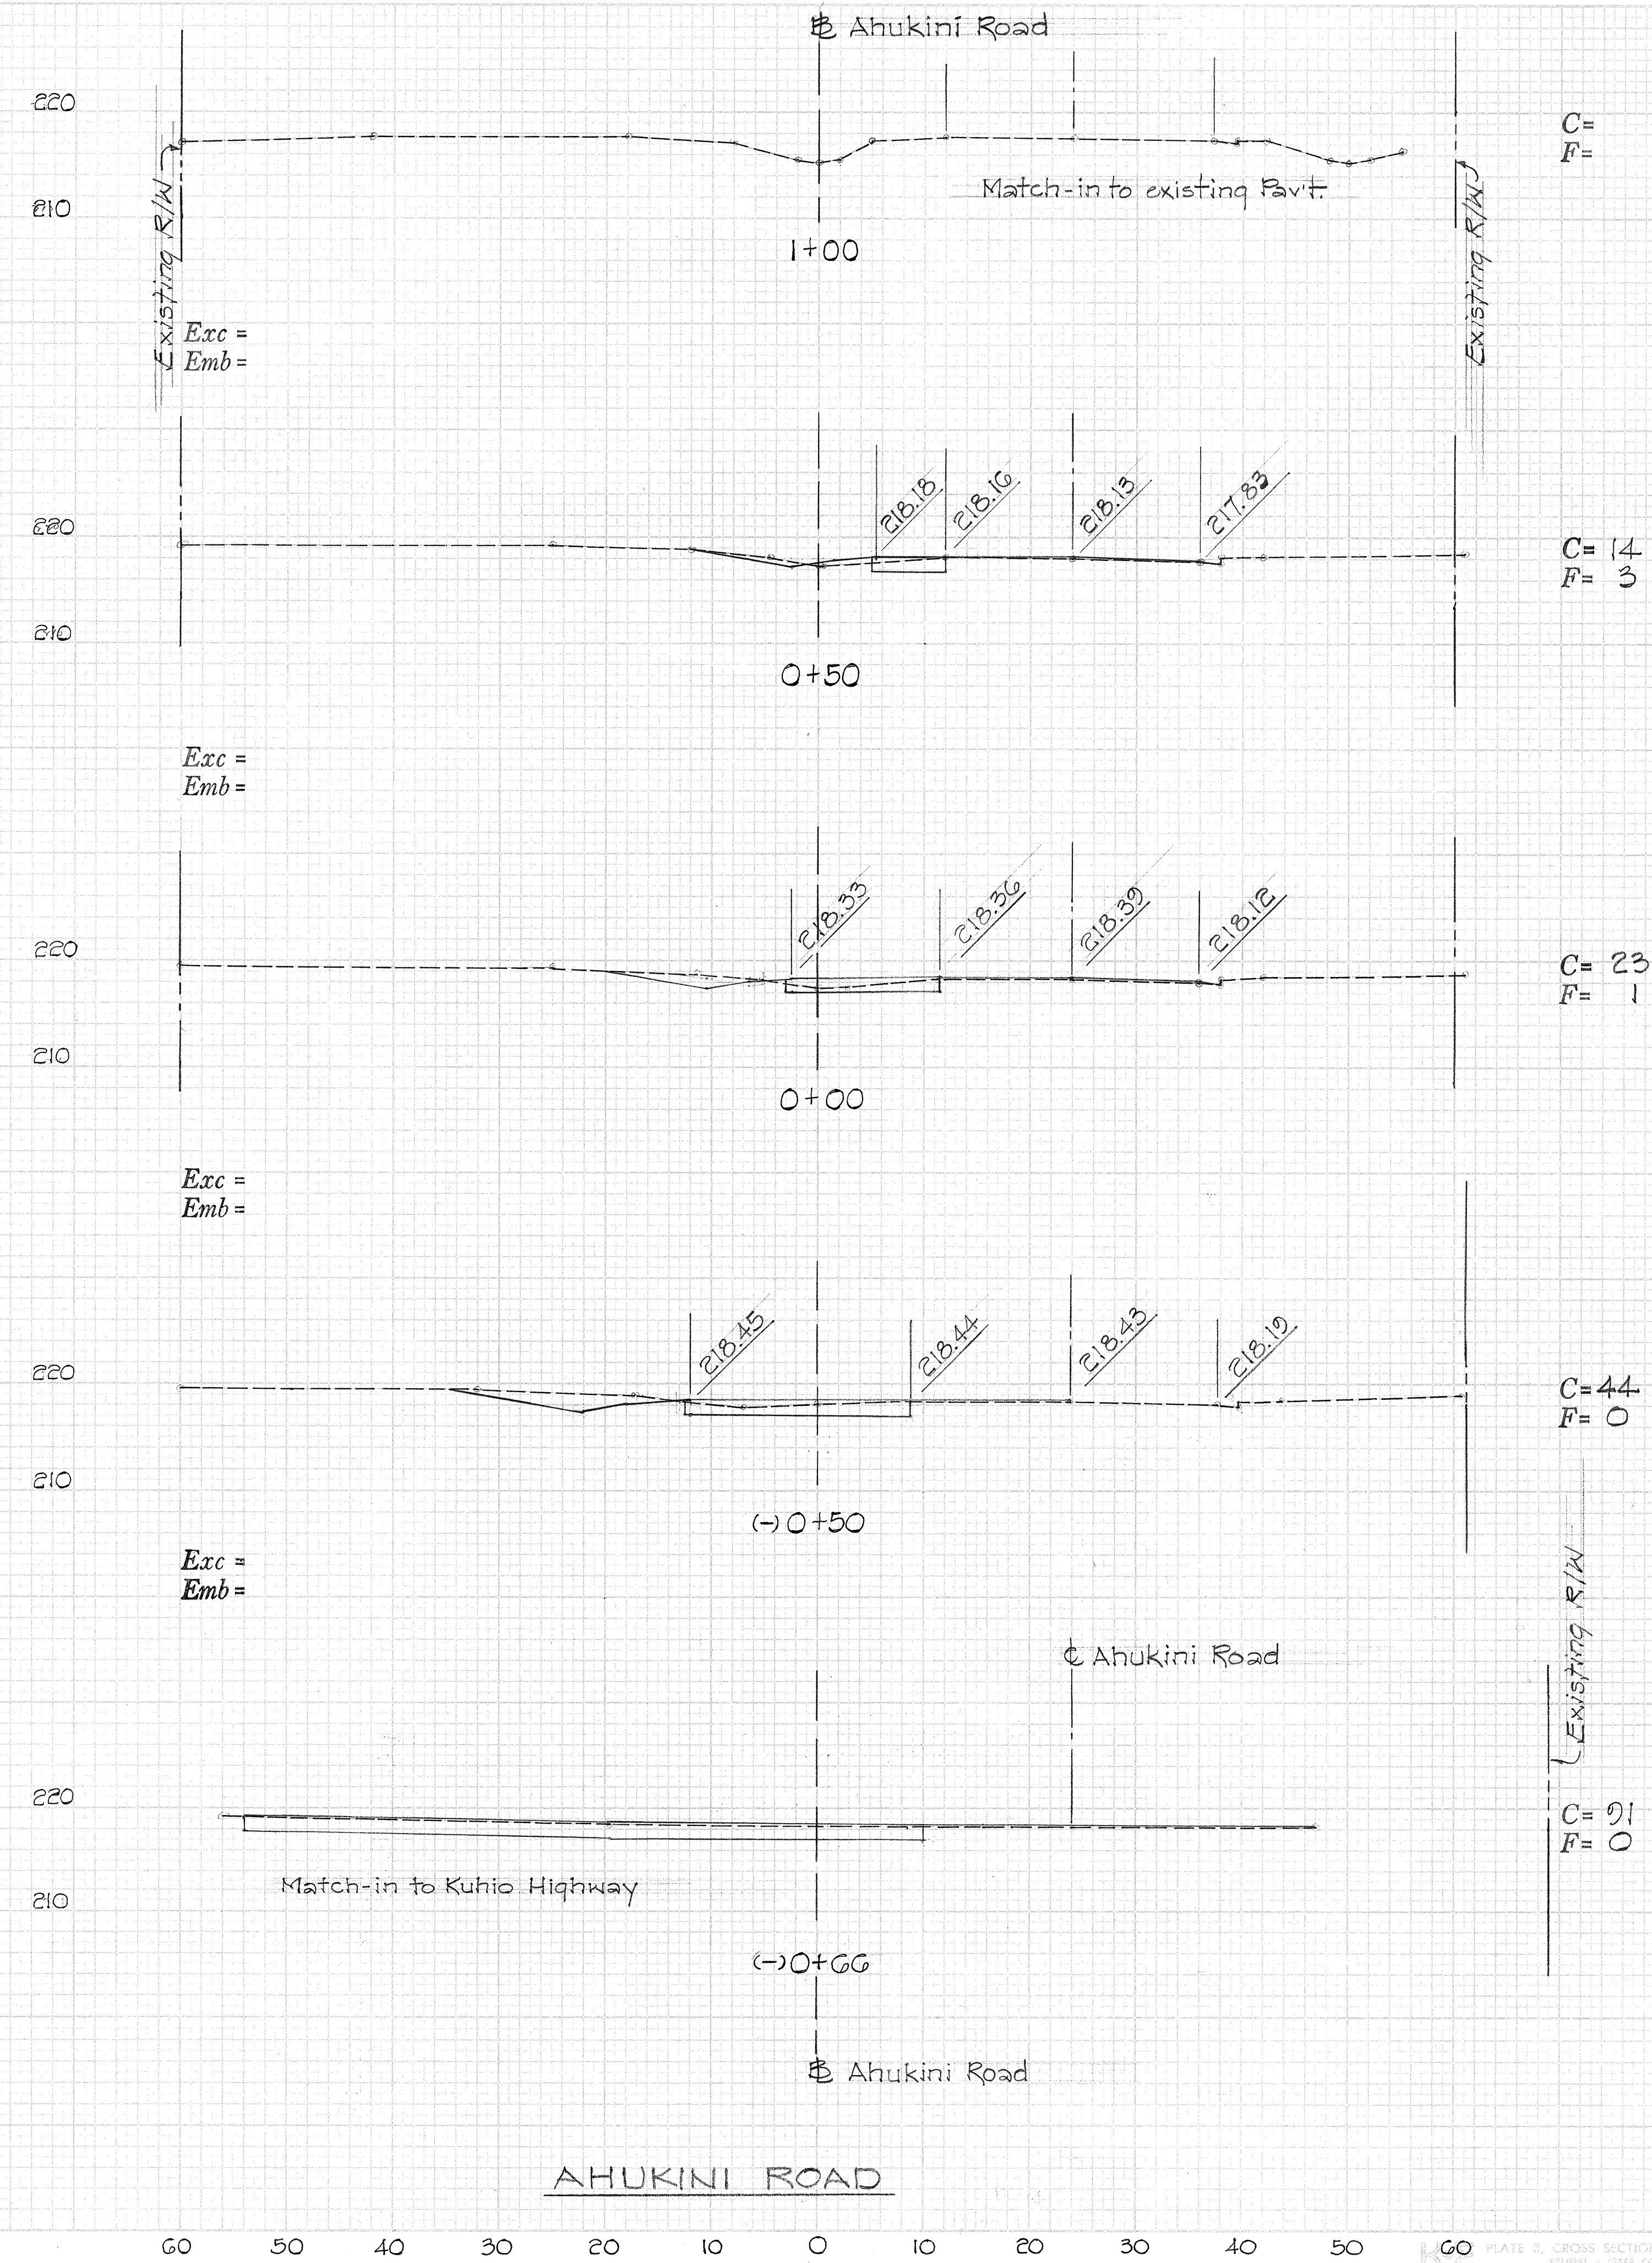

DIST. NO.	STATE	PROJ. NO.	FISCAL YEAR	SHEET NO.	TOTAL SHEETS
HAWAII	HAW.	56A-02-72	1975	28	31

DATE	BY	FINAL SURVEY	NO. 1
		NO. 2	
		NO. 3	
		NO. 4	
		NO. 5	
		NO. 6	
		NO. 7	
		NO. 8	
		NO. 9	
		NO. 10	
















DATE	BY	ORIGINAL SURVEY	NO. 1
		NO. 2	
		NO. 3	
		NO. 4	
		NO. 5	
		NO. 6	
		NO. 7	
		NO. 8	
		NO. 9	
		NO. 10	

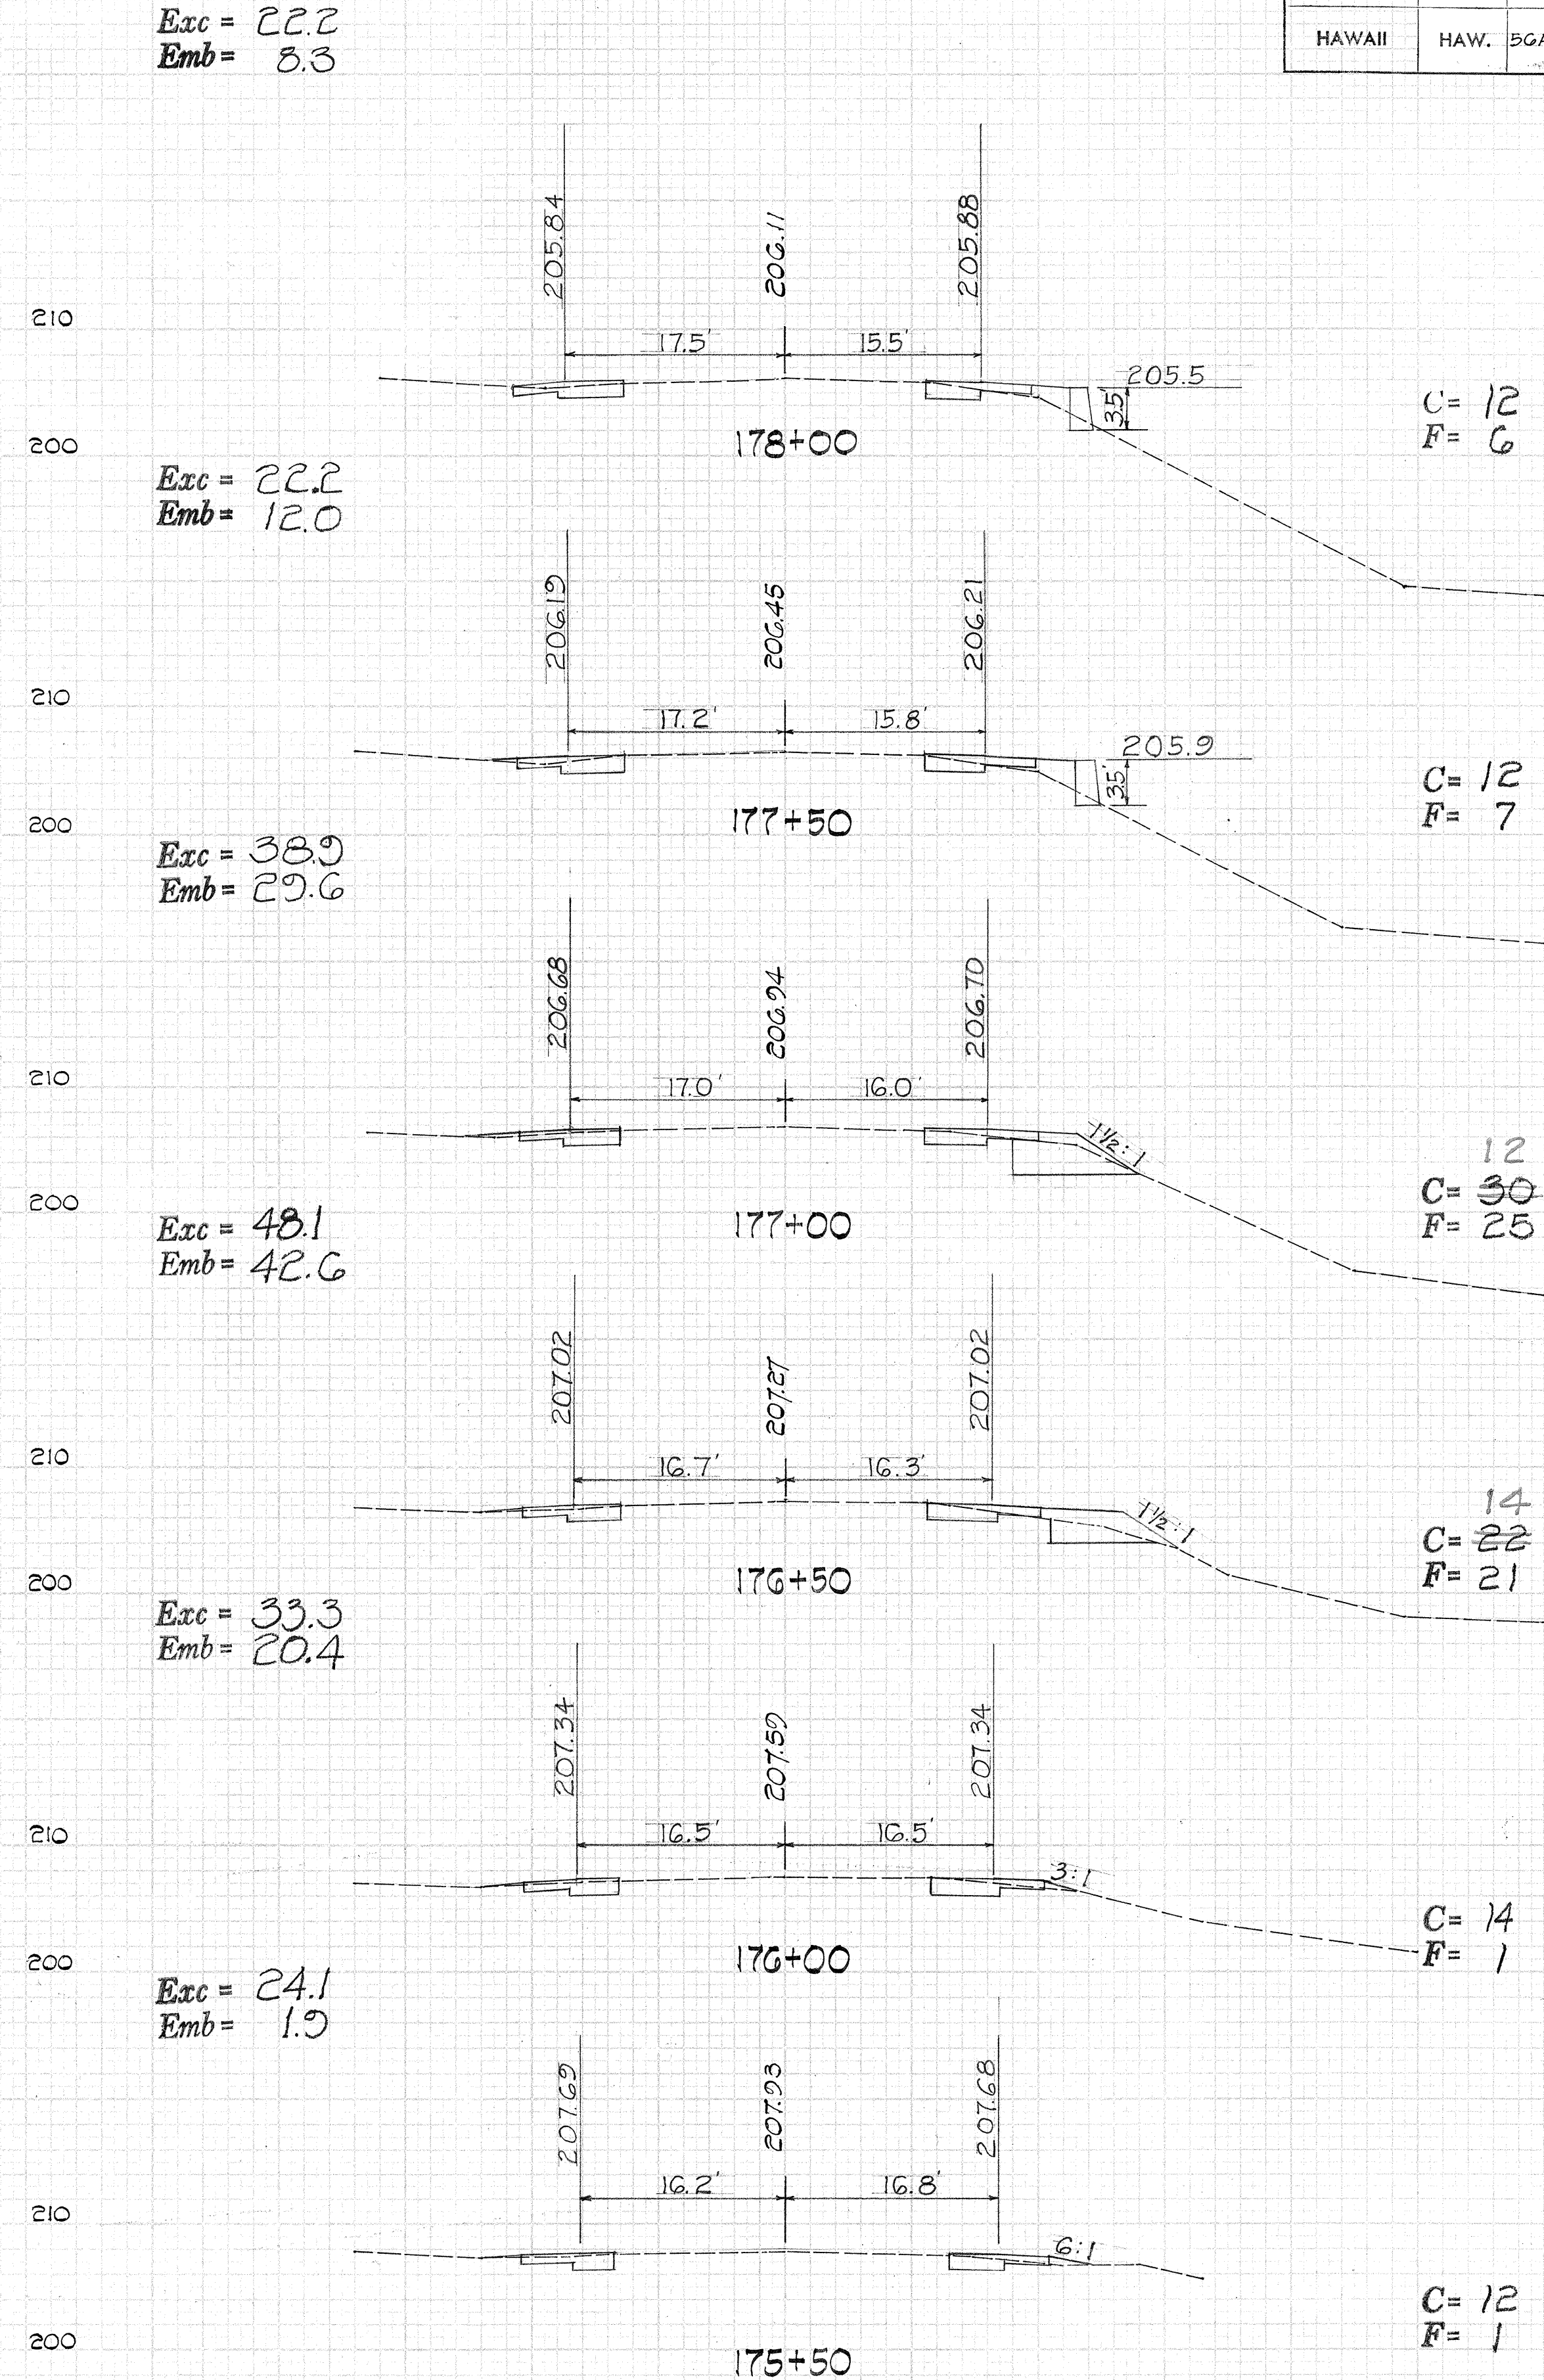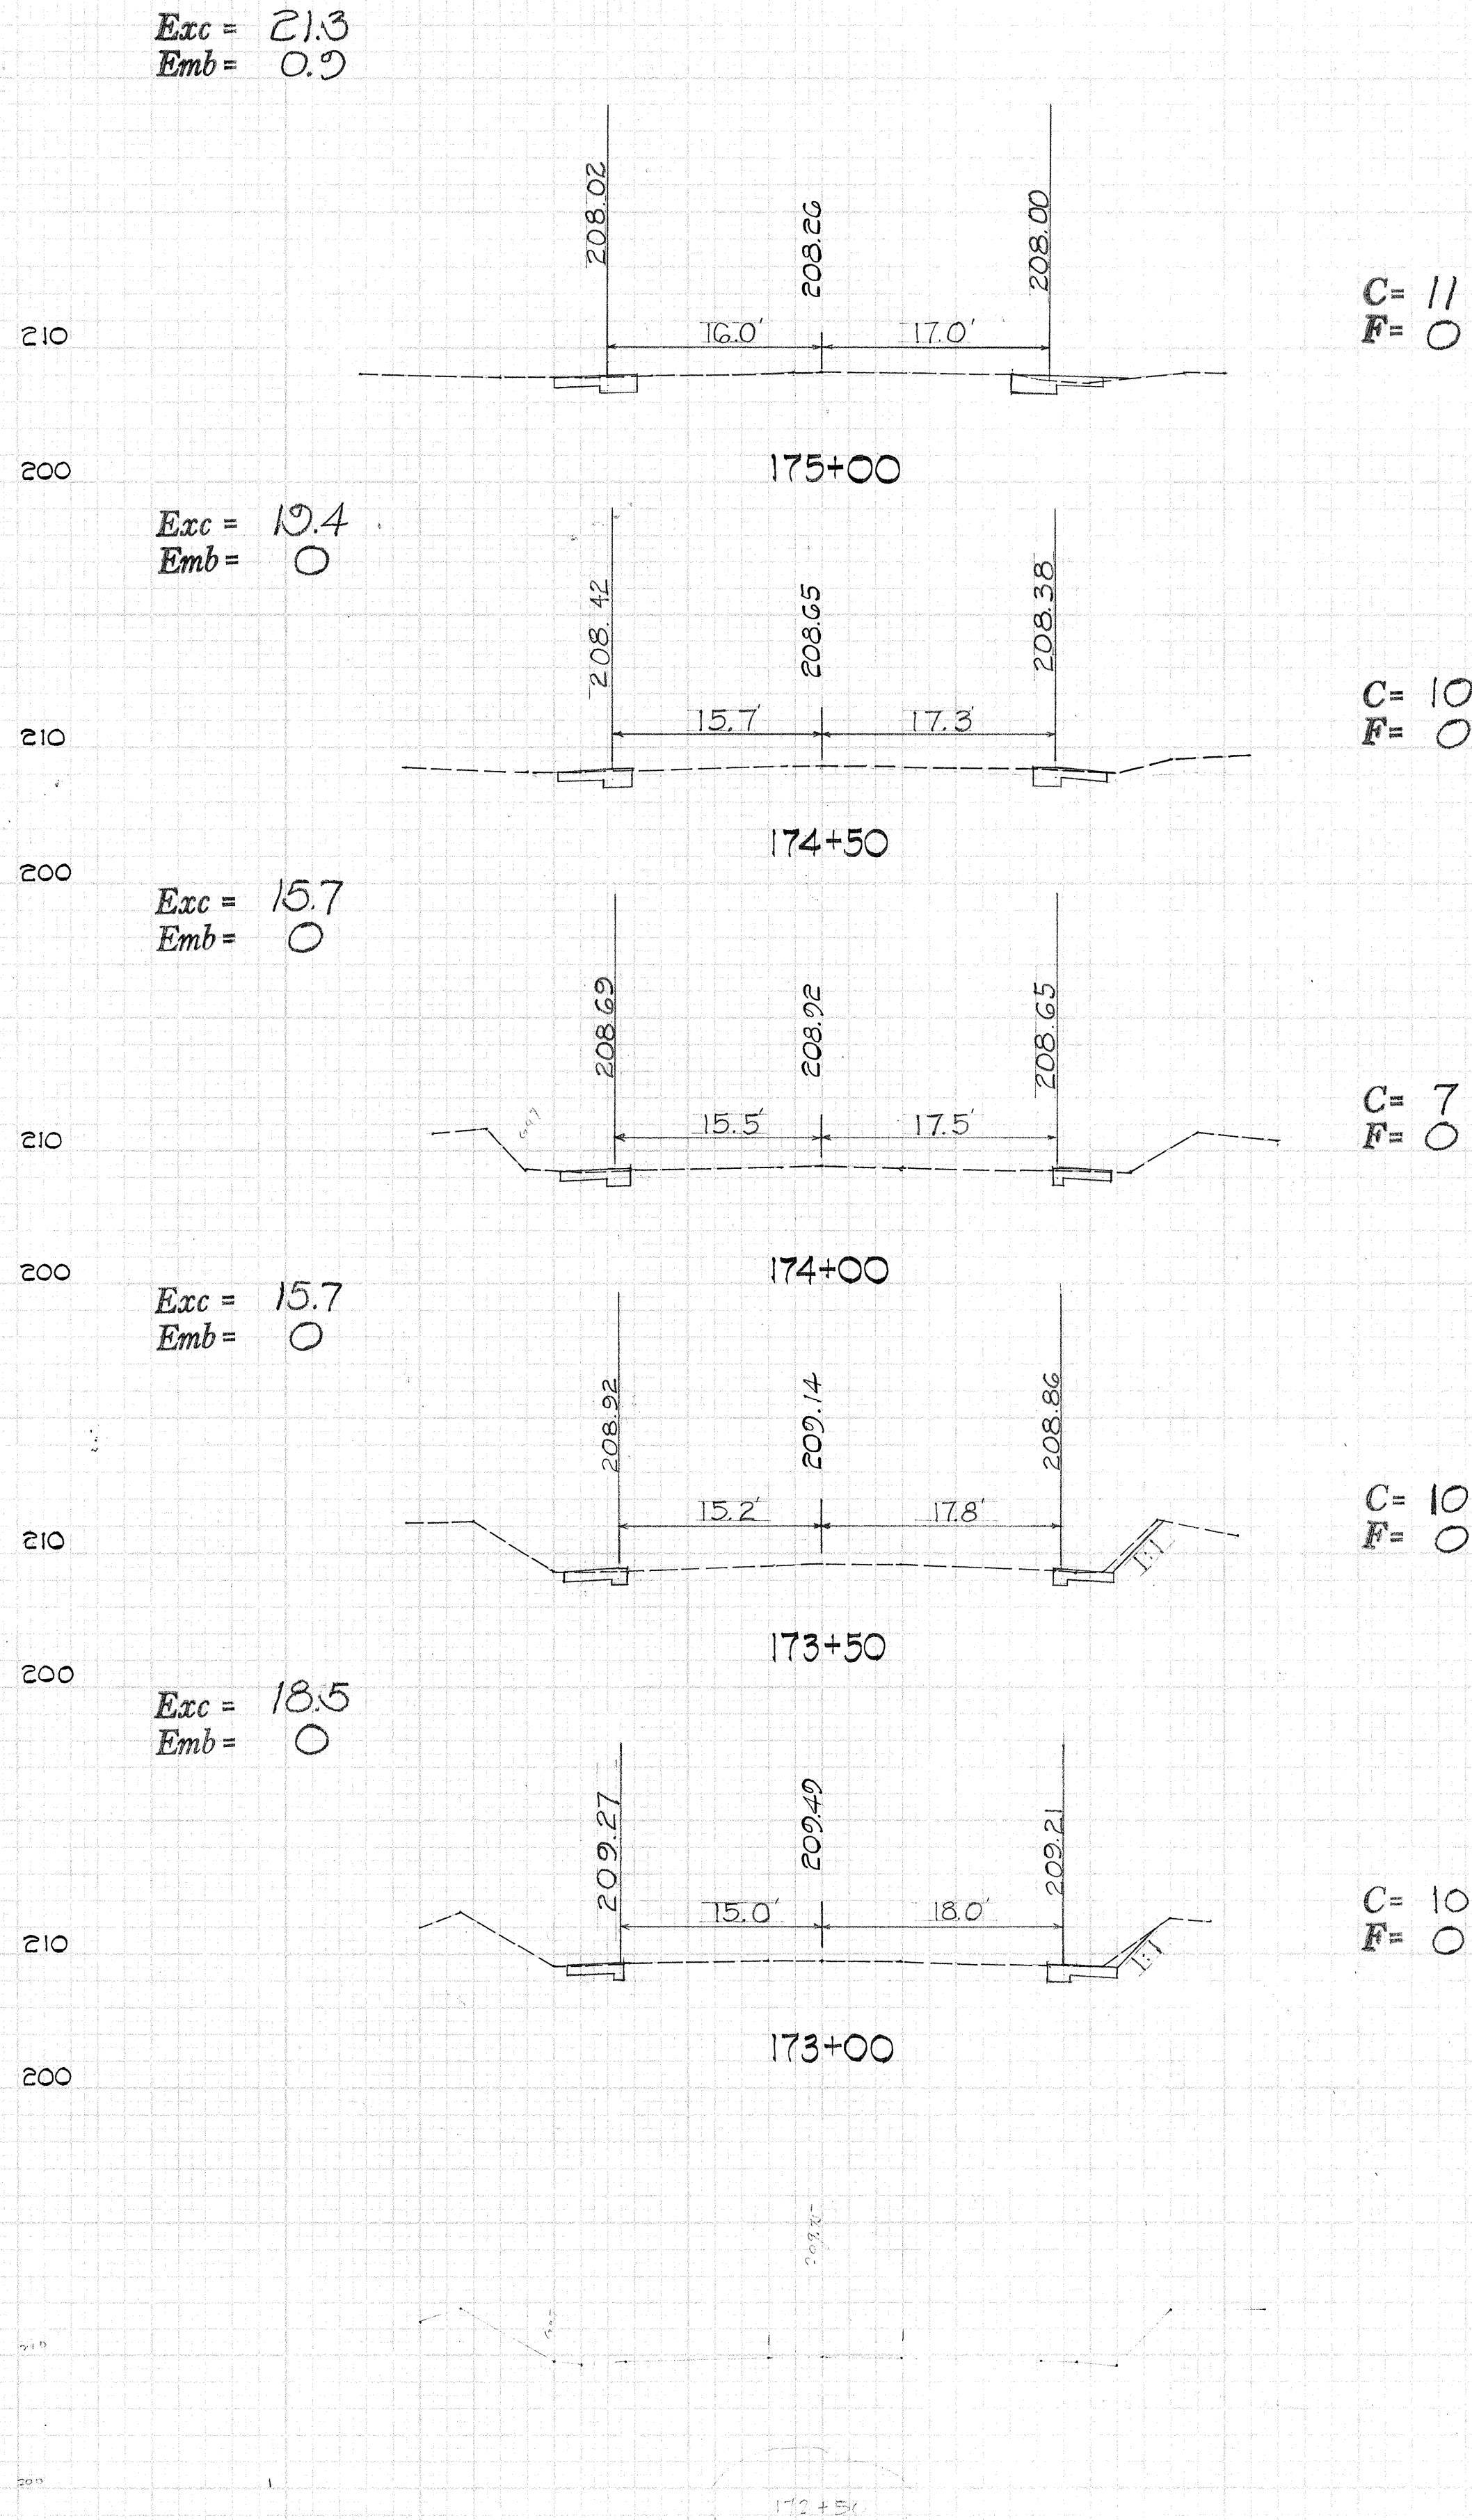

LAUKONA STREET


48 7055 CROSS SECTION

28

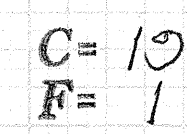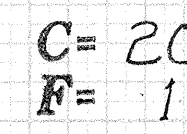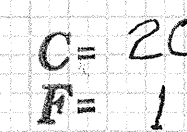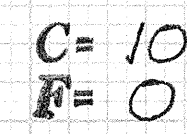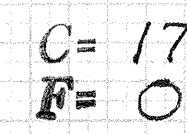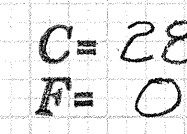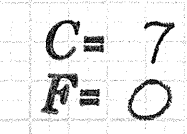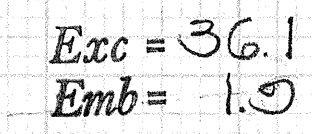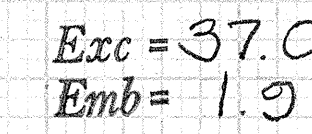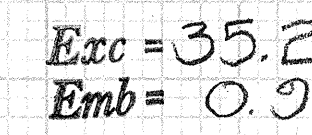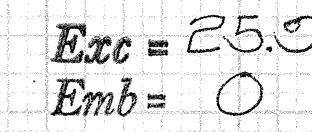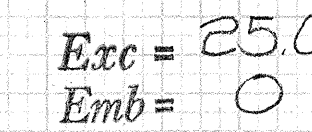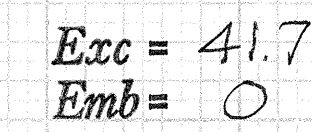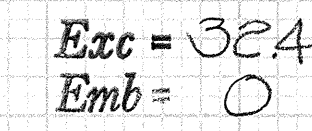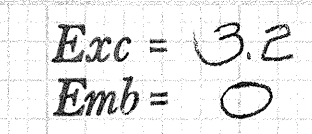

LAUKONA STREET



DIST. NO.	STATE	PROJ. NO.	FISCAL YEAR	SHEET NO.	TOTAL SHEETS
HAWAII	HAW.	56A-02-72	1975	30	31

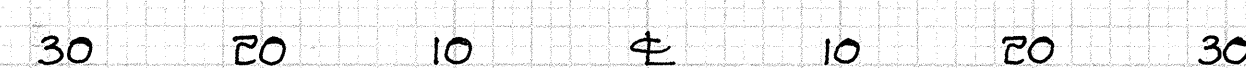

DATE	BY	SURVEYED	BY
		NOTE BOOK	NO.
		TEMPLATE	AREAS CHECKED

DATE	BY	SURVEYED	BY
		NOTE BOOK	NO.
		TEMPLATE	AREAS CHECKED

DIST. NO.	STATE	PROJ. NO.	FISCAL YEAR	SHEET NO.	TOTAL SHEETS
HAWAII	HAW.	56A-02-7B	1975	31	31

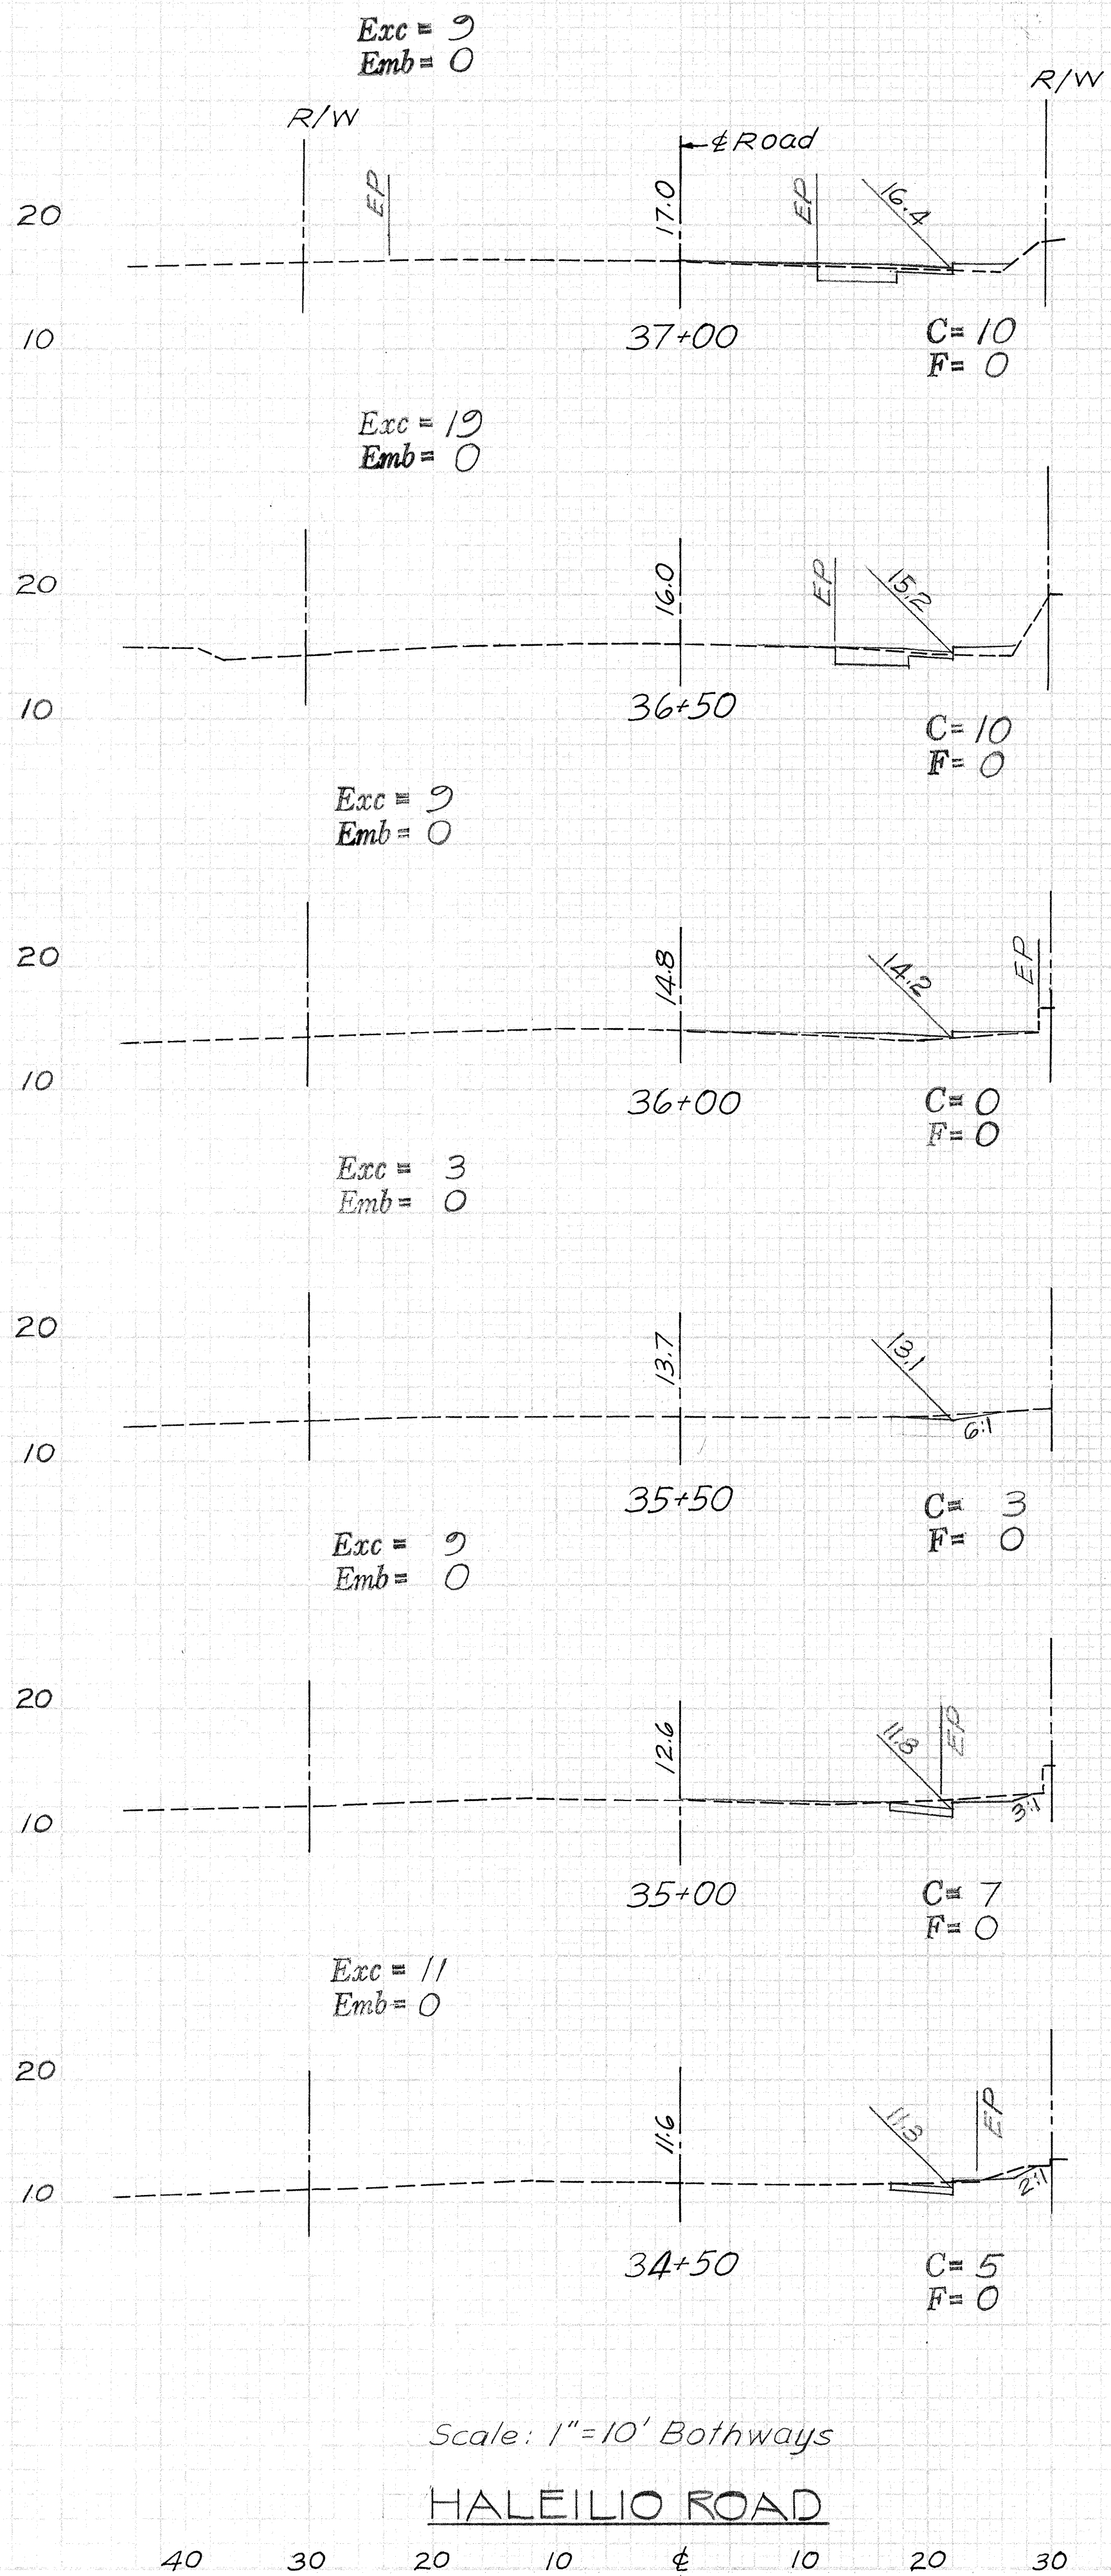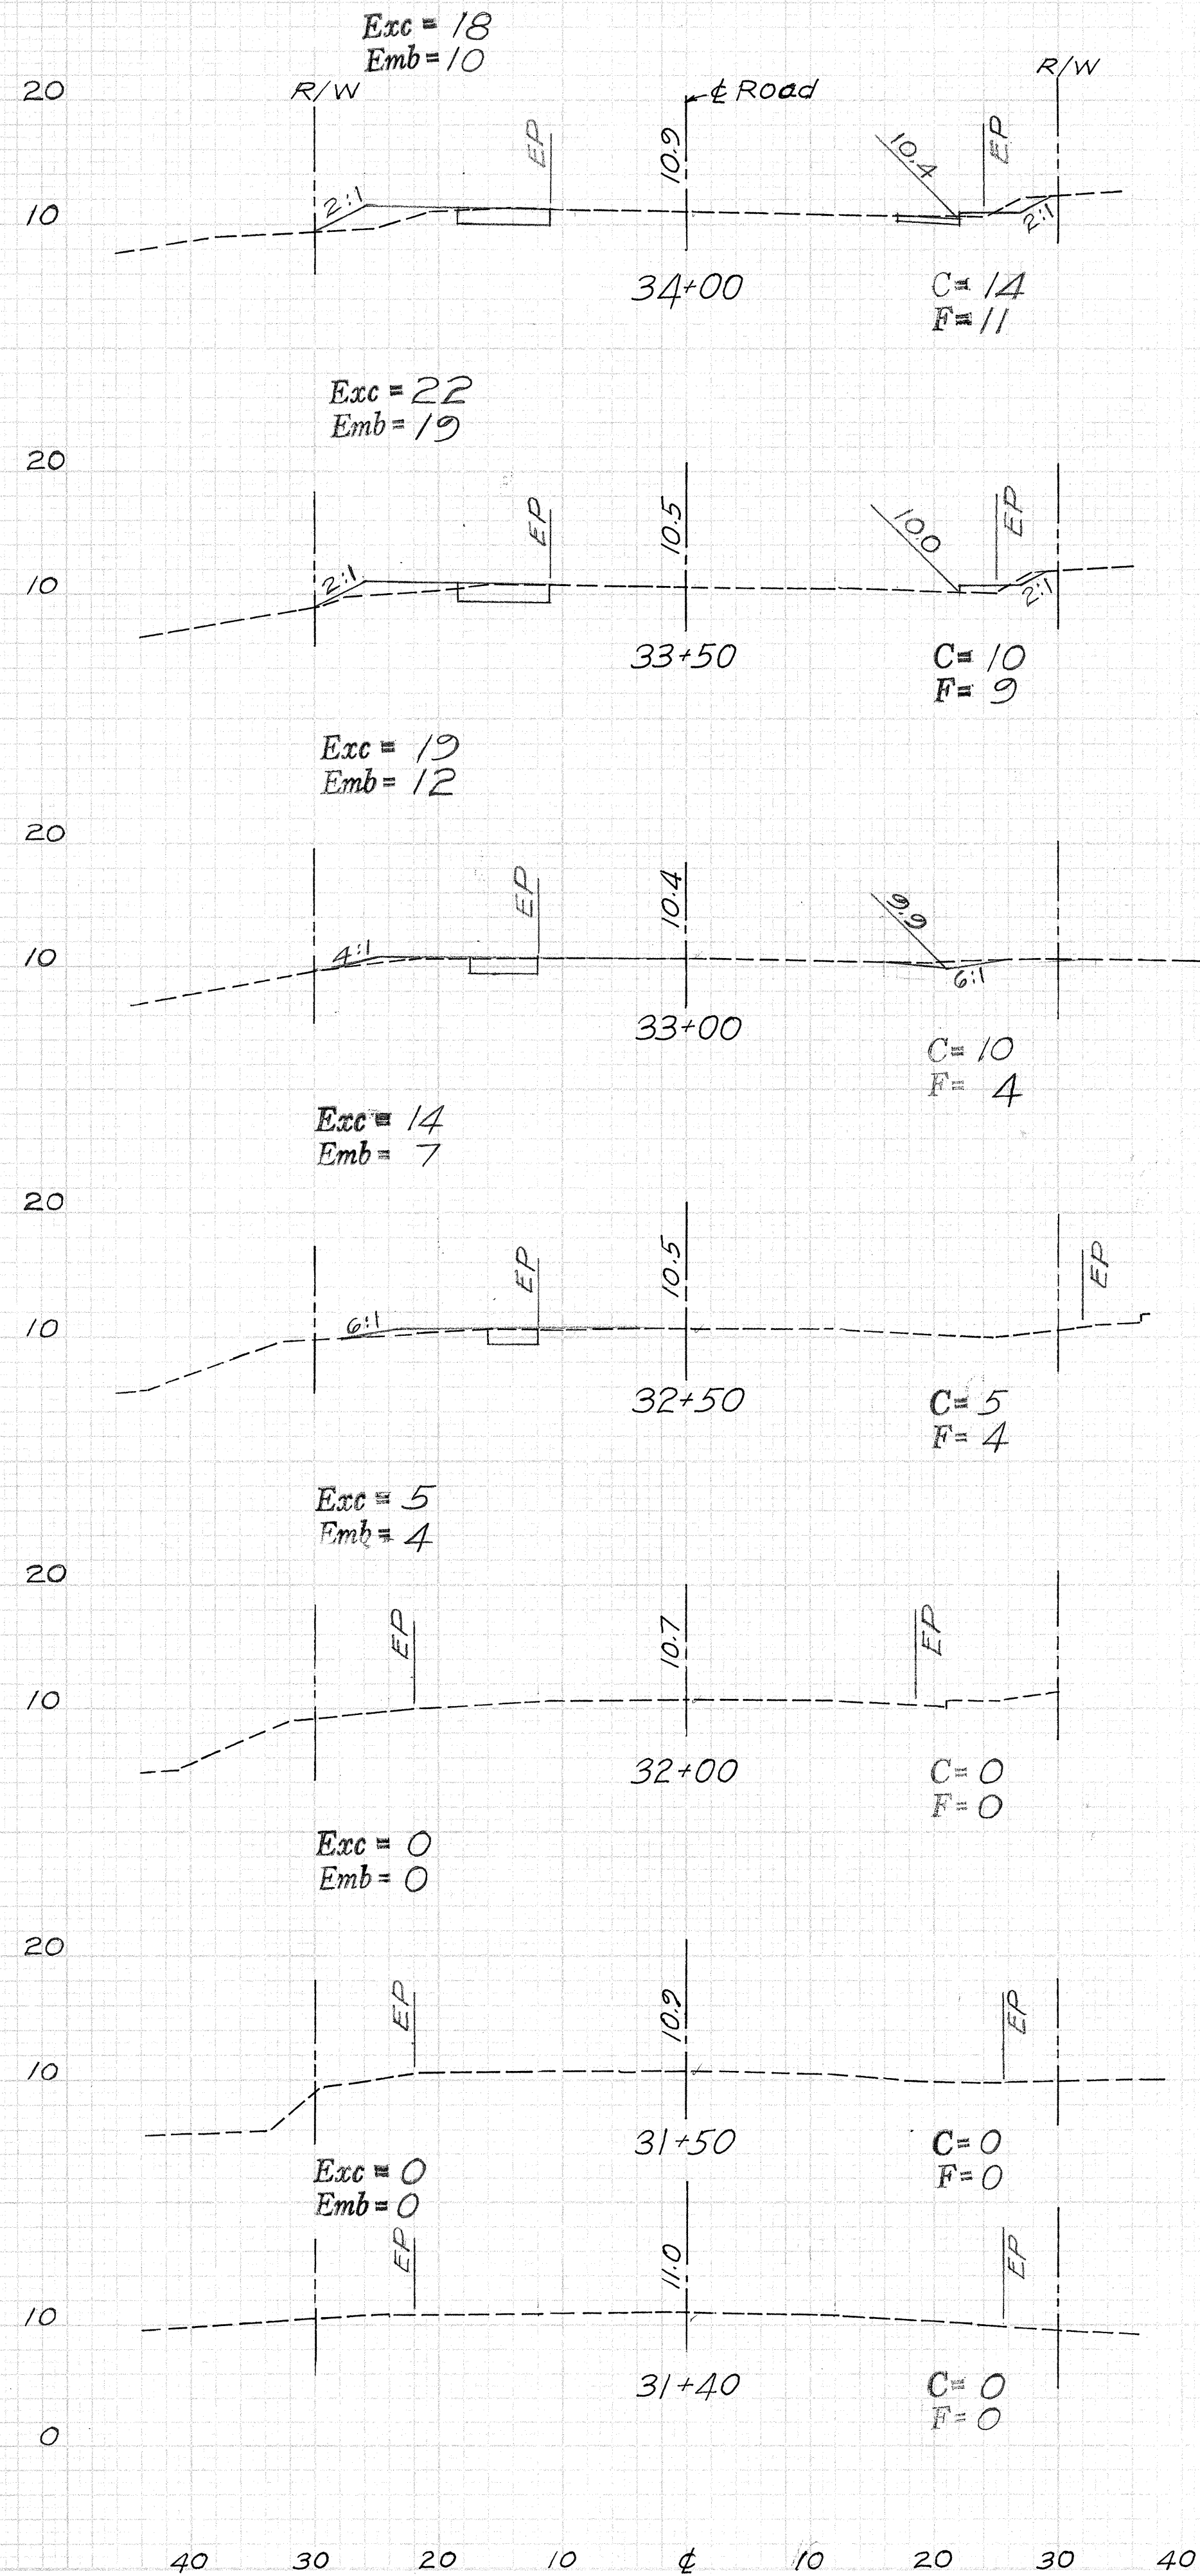

Scale: 1"=10' Bothways
HALELIU ROAD

