	UDEV TO DRAWINGS
11	NDEX TO DRAWINGS
SHEET NO.	DESCRIPTION
1	TITLE SHEET
2	GENERAL NOTES & SUMMARY
	OF QUANTITIES
3	STANDARD DETAIL



STATE OF HAWAII

DEPARTMENT OF TRANSPORTATION LAND TRANSPORTATION FACILITIES DIVISION


> "AS-BUILT" PLANS FOR


PAVEMENT MARKING AT VARIOUS LOCATIONS, KAUAI FEDERAL AID PROJECT NO. PMS-0700(10)

> DISTRICTS OF WAIMEA & HANALEI ISLAND OF KAUAI


> > LAYOUT OF PROJECTS


SCALE: I" = I Mile

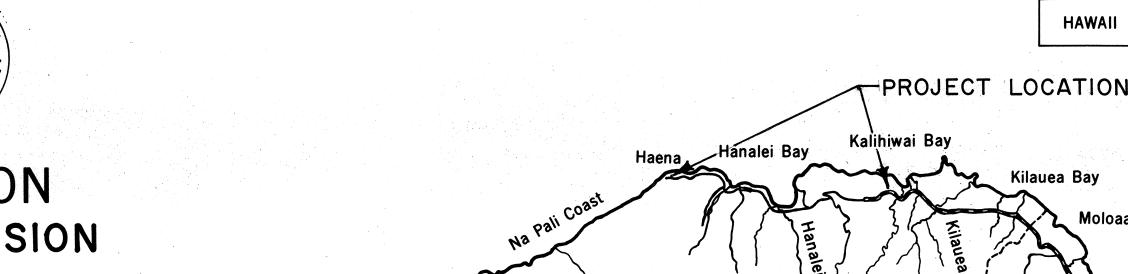

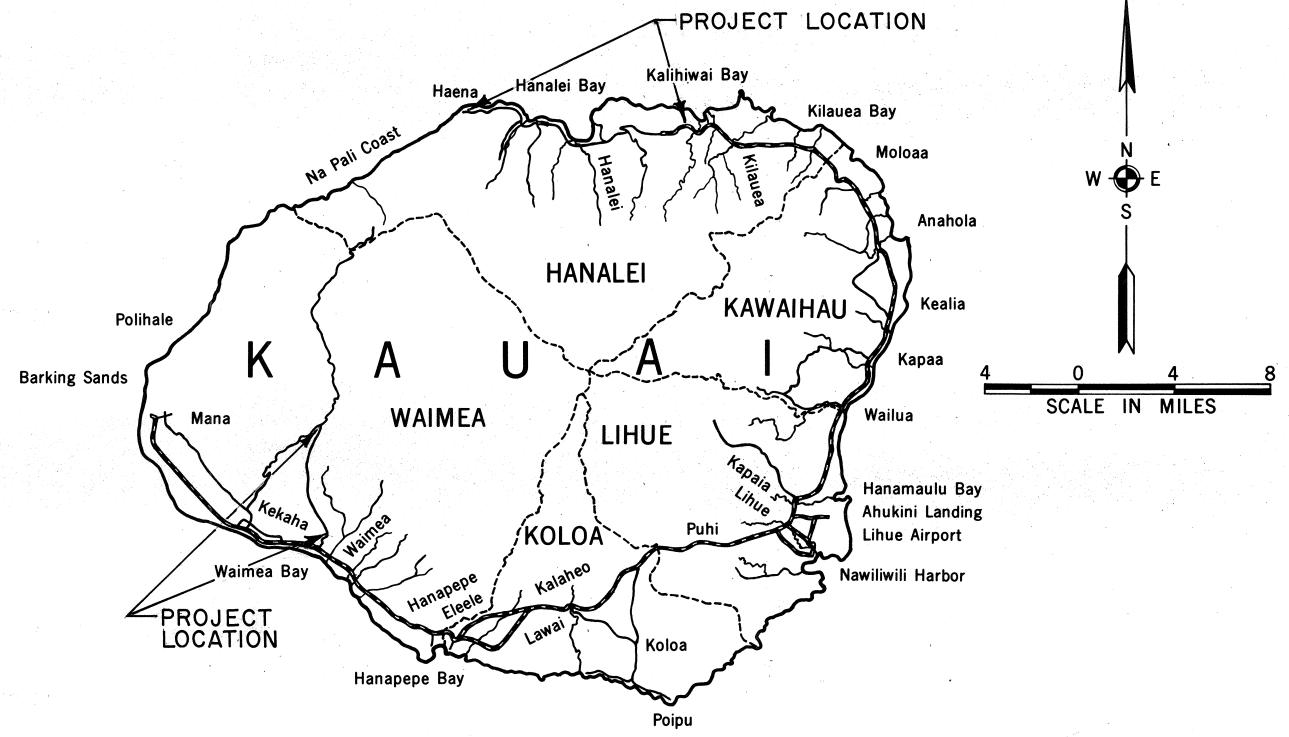

OR UNDER CONSTRUCTION

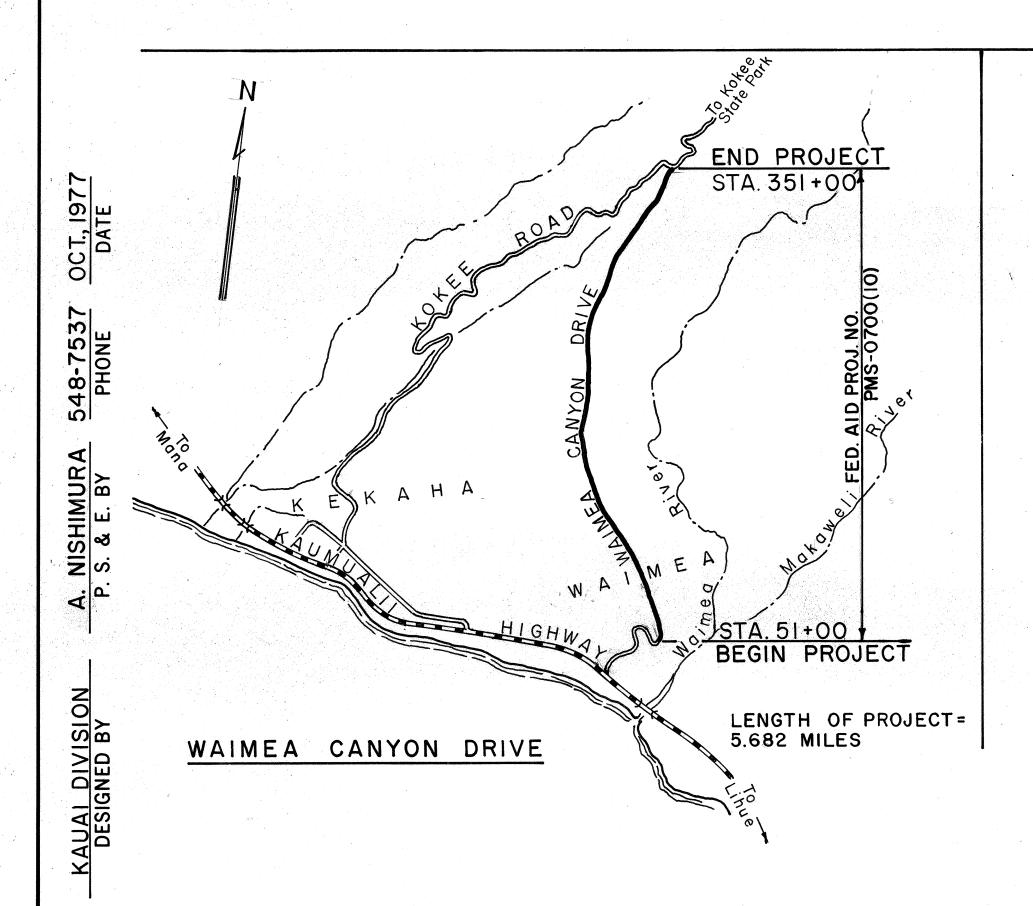

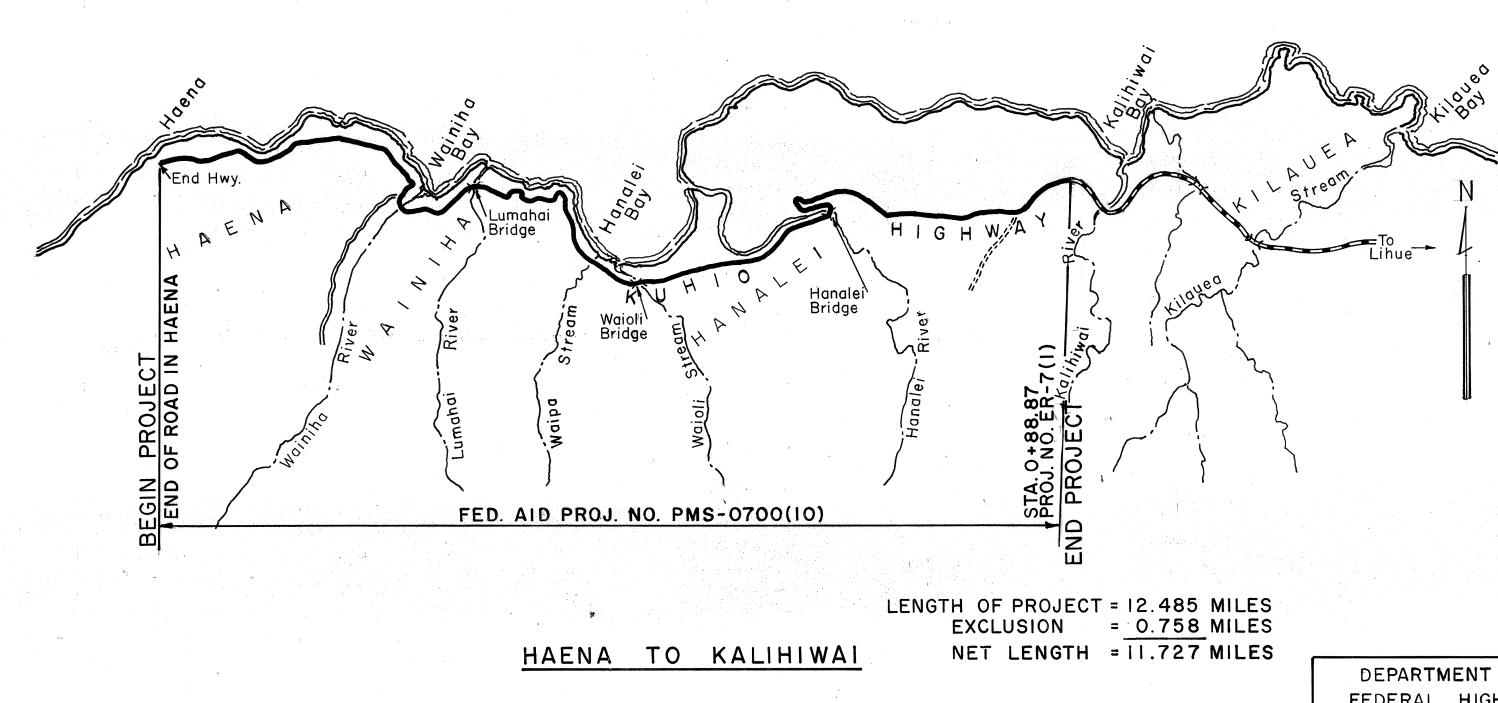

ALL CHANGES MADE DURING CONSTRUCTION AND CHECKED BY

RESIDENT ENGINEER

FED. AID FISCAL SHEET TOTAL PROJ. NO. YEAR NO. SHEETS

DEPARTMENT OF TRANSPORTATION	DEPARTMENT OF TRANSPORTATI
FEDERAL HIGHWAY ADMINISTRATION	STATE OF HAWAII
APPROVED:	APPROVED:
Lalph Decama 11/29/77	PHigashionna 121
DIVISION ADMINISTRATOR DATE	OF TRANSPORTATION