49	INDEX TO DRAWINGS			
SHEET NO.	DESCRIPTION			
	TITLE SHEET			
2	TYPICAL SECTIONS AND NOTES			
3-4	ROADWAY GEOMETRICS STRIPING AND SIGNING PLAN TRAFFIC SIGNAL PLAN CROSS SECTIONS WATER AND DRAINAGE DETAILS			
5-6				
7-8				
9-10				
11				
12	DRAINAGE & DESTINATION SIGN DETAILS			
13	HAWAIIAN TELEPHONE CO. FACILITIES			
14	MISCELLANEOUS DETAILS			
15-16	TYPICAL DETAILS OF WHEELCHAIR RAMPS			
17-37	STANDARD DETAILS			
	,			



STATE OF HAWAII



TRANSPORTATION DEPARTMENT OF

HIGHWAYS DIVISION HONOLULU, HAWAII

"AS-BUILT"


PLANS FOR


AHUKINI ROAD AND KUHIO HIGHWAY IMPROVEMENTS


FEDERAL AID PROJECT NO. RSG - 0570(2)

DISTRICT OF LIHUE ISLAND OF KAUAI



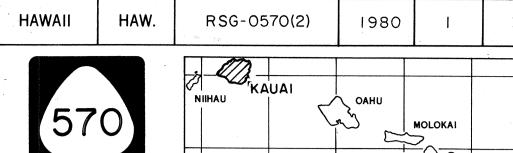

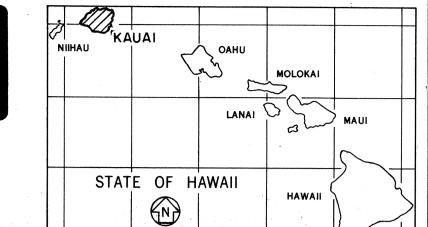

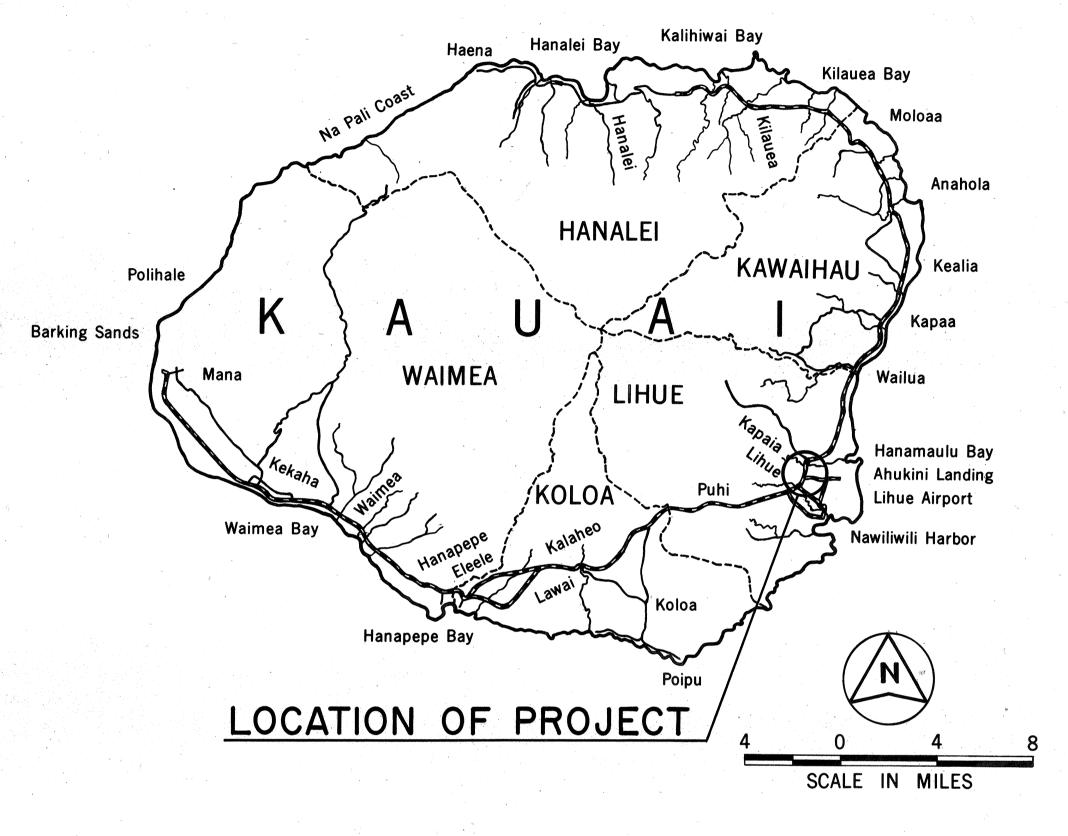

FED. ROAD DIST. NO.

FEDERAL AID PROJECTS PREVIOUSLY CONSTRUCTED OR UNDER CONSTRUCTION

MAY 6, 1980 DATE	END PROJECT STA. 129 + 00	
548-6932 PHONE	DDO 15CT 1 OCATION	
JAMES SUGIHARA P. S. & E. BY	BEGIN PROJECT STA. 108 + 26 Wilcox Sch Lihue Park	
AUSTIN, TSUTSUMI, & ASSOC., INC. ENGINEERS SURVEYORS . HAWAII GUAM DESIGNED BY	LENGTH OF PROJECT-0.393 MILE LAYOUT PLAN 2000 0 2000 4000 6000	
	SCALE IN FEET	

ALL CHANGES MADE DURING CONSTRUCTION HAVE BEEN INCORPORATED ON THESE PLANS IN RED EXCEPT CHANGES IN THE ORIGINAL THEORETICAL QUANTITIES. FOR ACTUAL QUANTITIES, REFER TO PROJECT LEDGER AND/OR COMPUTATION BOOK.

Donald Magamine RESIDENT ENGINEER

4-12-82 DATE

	DESIGN CLASSIFICATION		
	ADT (1979) ADT (1999)	25,100 22,900	
	DHV D T	70/30 6.0 %	
	^T 24 V	5.0% 25 MPH	
•		·	

	DEPARTMENT OF TRANSPORTATION					
	STATE OF HAWA					
	APPROVED:					
	James R. Canas DIR. OF TRANSPORTATION	5/12/80				
0	DIR. OF TRANSPORTATION	DATE				

100-039-8