ė	
INDEX TO DRAWINGS	
SHEET NO.	DESCRIPTION
1	TITLE SHEET
2	GENERAL NOTES & SUMMAR
i de la companya de l	OF QUANTITIES
3-4	STANDARD DETAILS
•	
·	



STATE OF HAWAII

DEPARTMENT OF TRANSPORTATION

HIGHWAYS DIVISION HONOLULU, HAWAII


PLANS FOR

## PAVEMENT MARKING AT VARIOUS LOCATIONS, KAUAI PHASE II


FEDERAL AID PROJECT NO. PMS-0700(20) DISTRICTS OF WAIMEA & HANALEI ISLAND OF KAUAI


LAYOUT OF PROJECTS

SCALE: I" = I Mile

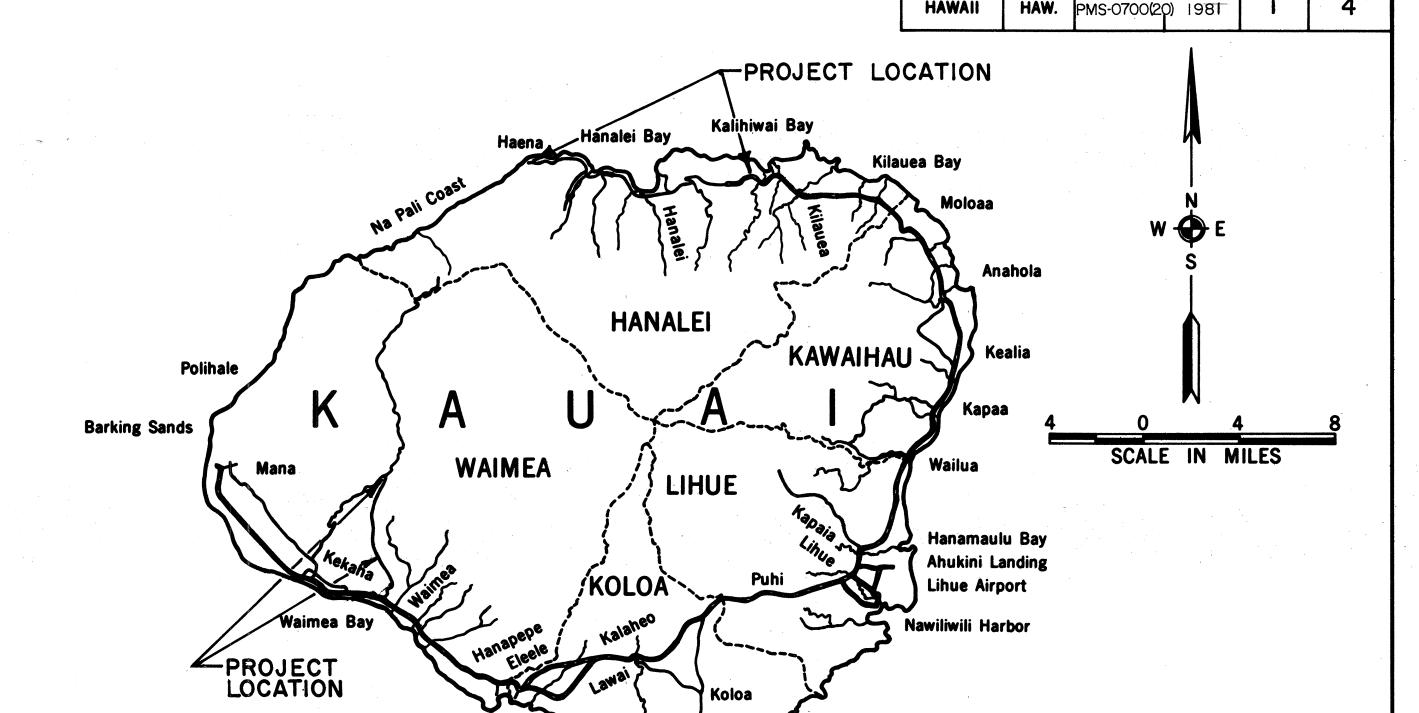

OR UNDER CONSTRUCTION

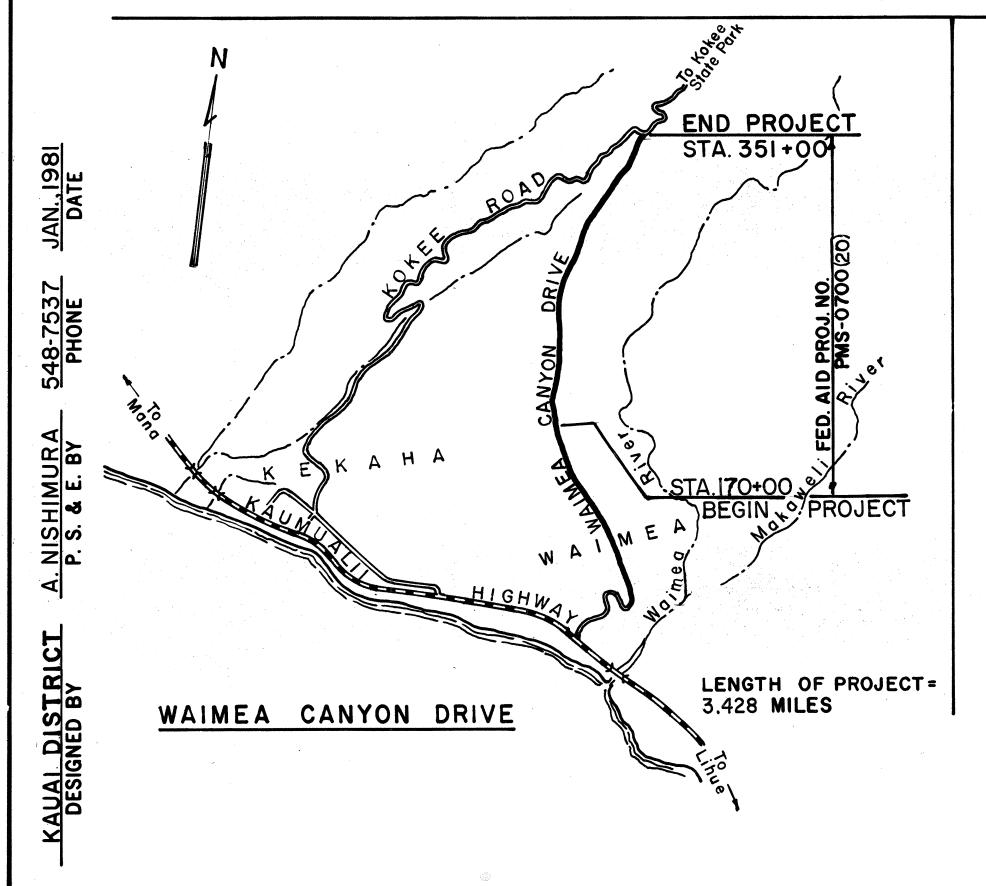

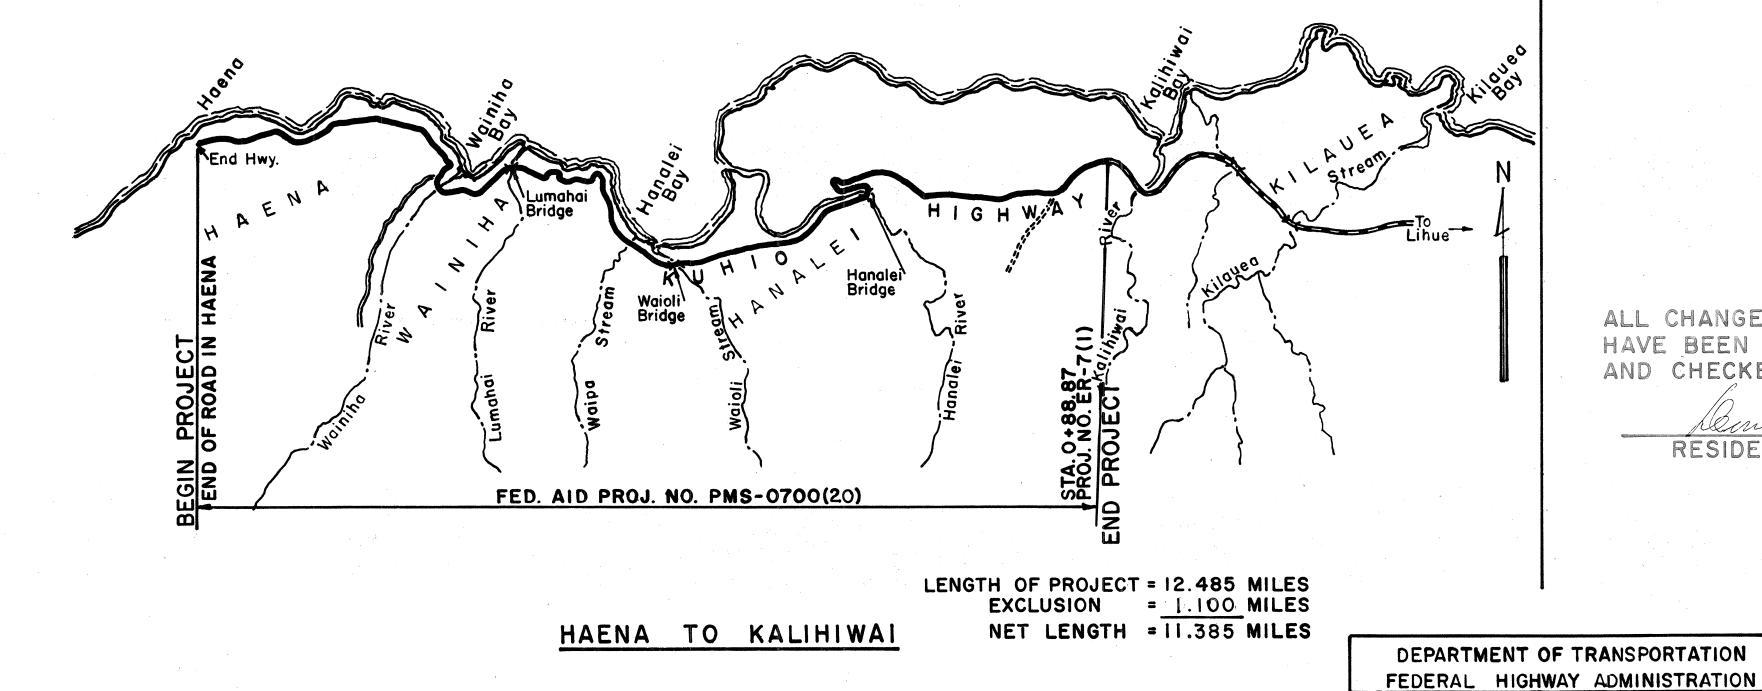

ALL CHANGES MADE DURING CONSTRUCTION HAVE BEEN NOTED IN RED ON THESE TRACINGS AND CHECKED BY 1-28-82 RESIDENT ENGINEER DATE

**APPROVED:** 

2.26.81

DATE

DIVISION ADMINISTRATOR

DEPARTMENT OF TRANSPORTATION

STATE OF HAWAII.

FED. AID FISCAL SHEET PROJ. NO. YEAR NO.