|           | INDEX TO DRAWINGS    |
|-----------|----------------------|
| SHEET NO. | DESCRIPTION          |
|           | TITLE SHEET          |
| 2         | LEGEND AND NOTES     |
| 3         | TRAFFIC CONTROL PLAN |
| 4-5       | TRAFFIC SIGNAL PLAN  |
| 6-15      | STANDARD DETAILS     |
|           |                      |
|           |                      |
|           |                      |
|           |                      |



STATE OF HAWAII



## DEPARTMENT OF TRANSPORTATION

HIGHWAYS DIVISION
HONOLULU, HAWAII

'AS BUILT'
PLANS FOR


KUAMOO ROAD, TRAFFIC SIGNALS AT KUHIO HIGHWAY FEDERAL AID PROJECT NO. RSG - 0580(3)


DISTRICT OF KAWAIHAU

AND

KUHIO HIGHWAY, TRAFFIC SIGNALS AT LAUKONA STREET FEDERAL AID PROJECT NO. DP-056-1(30)

DISTRICT OF LIHUE ISLAND OF KAUAI

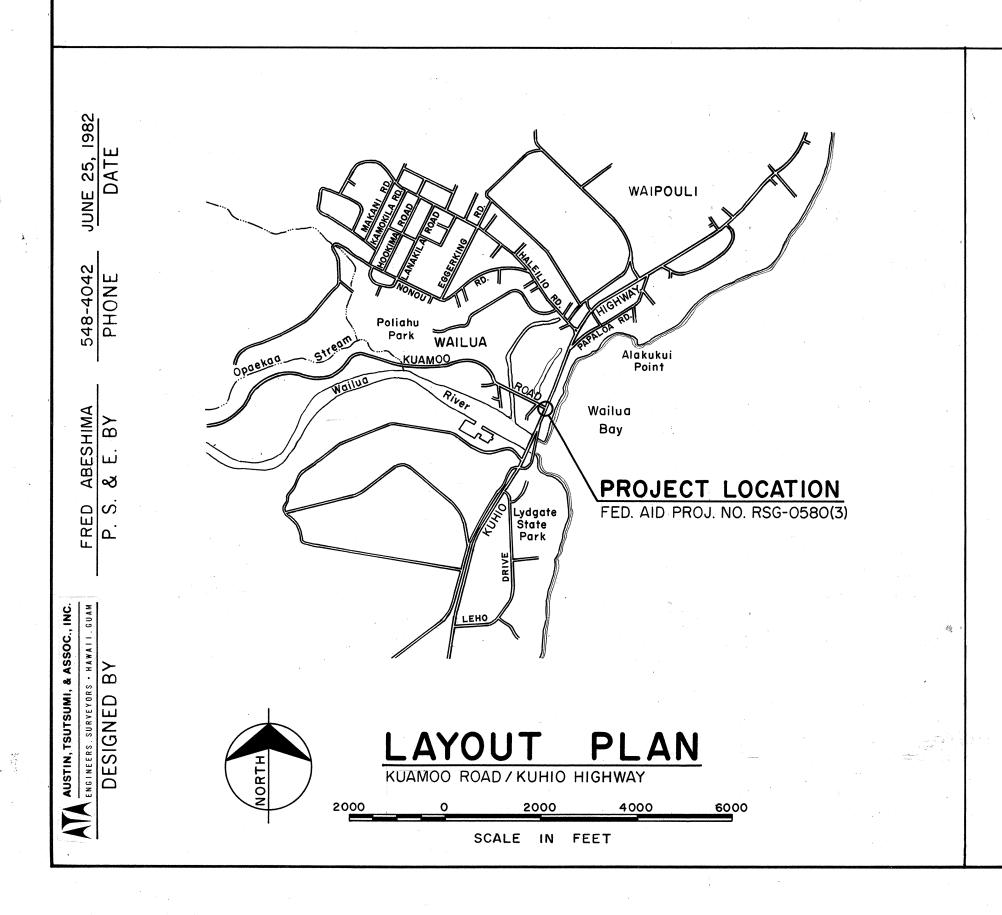

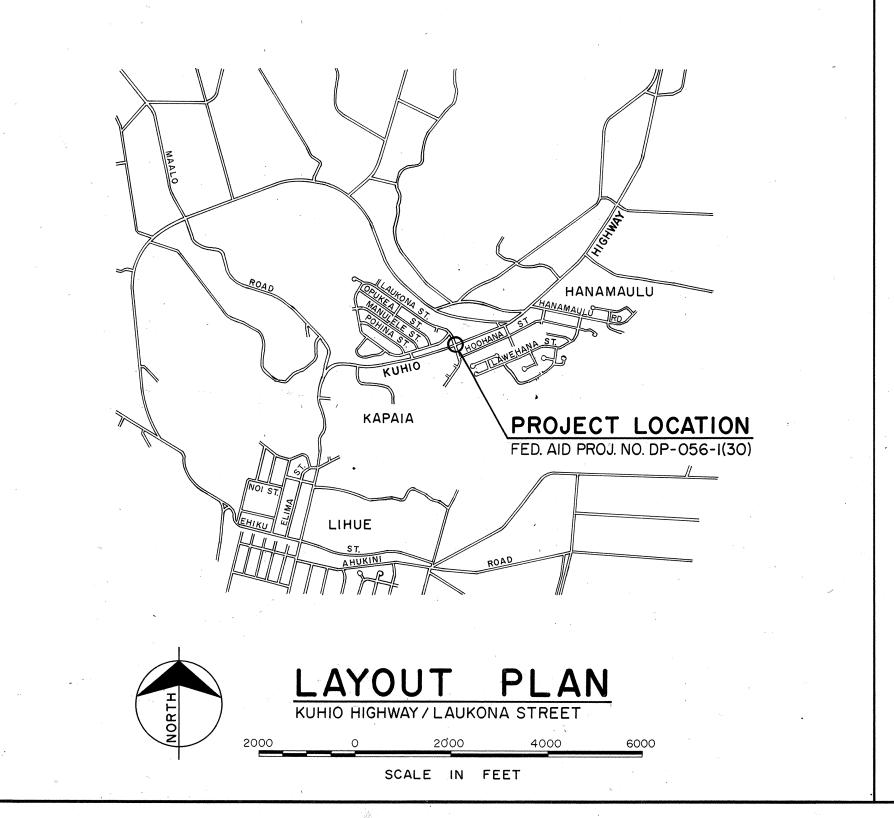


FED. ROAD DIST. NO.


HAWAII

HAW.

FED. AID
PROJ. NO.

FISCAL SHEET
YEAR
NO.
SHEET
S

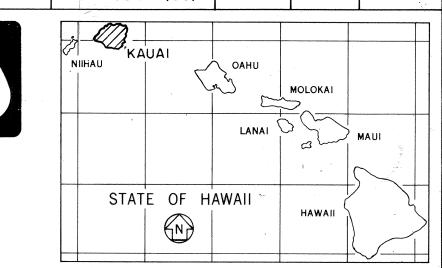

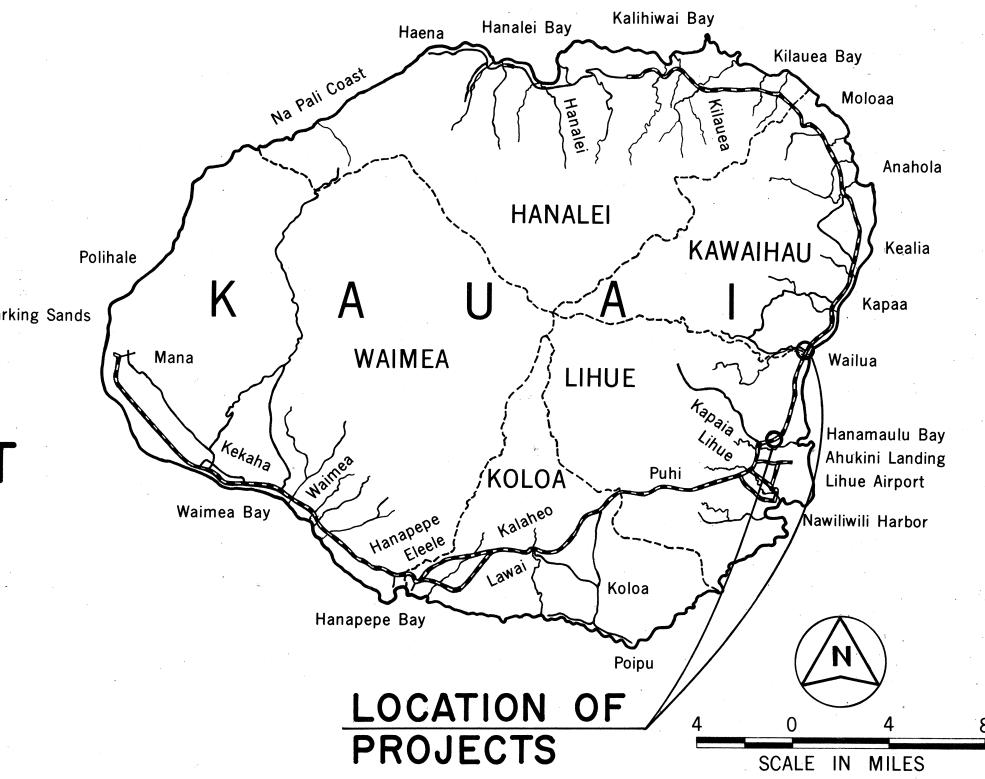

FEDERAL AID PROJECTS PREVIOUSLY CONSTRUCTED
OR UNDER CONSTRUCTION

CHANGES MADE DURING CONSTRUCTION HAVE BEEN INCORPORATED ON THESE PLANS EXCEPT CHANGES IN THE ORIGINAL THEORETICAL QUANTITIES. FOR ACTUAL QUANTITIES, REFER TO PROJECT LEDGER AND/OR COMPUTATION BOOK.

Donald Magamine
RESIDENT ENGINEER

4-9-84 DATE

|   | DEPARTMENT OF TRANSPORTATION |            |  |
|---|------------------------------|------------|--|
|   | STATE OF HAWAII              |            |  |
|   | APPROVED:                    |            |  |
| r |                              | Tuly 12,82 |  |
|   | DIR. OF TRANSPORTATION       | DATE       |  |
|   |                              |            |  |