


FED. ROAD DIST. NO.	STATE	FED. AID PROJ. NO.	FISCAL YEAR	SHEET NO.	TOTAL SHEETS
HAWAII	HAW.	FR-0700(22)	1983	3	17


GENERAL NOTES:

- Scope of work for this project are as follows:
 - Section 1 - Anahola to Aliomanu
Resurfacing, reconstructing, constructing guard rail connections and concrete ramps at Anahola Stream Bridge, installing guard rails, placing pavement markers and striping of pavement.
 - Section 2 - Wainiha to Lumahai
Resurfacing, reconstructing, placing pavement markers and striping of pavement. Resurfacing of pavement will not be required on section noted "EXCEPTION" (Lumahai Bridge and approaches - 1,975 L.F.), however, placing pavement markers and striping will be required.
- The exact limits of reconstruction of weakened pavement area will be determined in the field by the Engineer.
- All potholes, cracks and wheel ruts shall be filled and compacted with a layer of Asphalt Concrete Pavement Mix No. I prior to resurfacing. This work will be paid for under Asphalt Concrete Pavement Mix No. I .
- Existing raised pavement markers shall be removed from the entire area to be resurfaced by such method that will cause the least possible damage to the pavement. This work will not be measured for payment but will be considered incidental to various contract items.
- Longitudinal transitions from the new pavement overlay to the existing pavement at the beginning and end of each section to be resurfaced and at bridge structures shall be effected with a taper rate of 25 feet per one inch of pavement thickness.
- The Contractor shall be held liable for any damages incurred to existing utility facilities as a result of his operations. All damaged portions shall be repaired and/or replaced in accordance with the Standards and Specifications of the State and/or the affected Utility Company.
- Provide smooth riding transition at beginning and end of resurfacing, at bridge structures and at all driveways and sideroad connections.
- Maximum allowable gross loads on existing bridges are as follows:

Hanalei Bridge	= 12 Tons
Waipa Bridge	= 8 Tons
Wainiha Bridge	= 8 Tons
Waioli Bridge	= 10 Tons
Waikoko Bridge	= 8 Tons

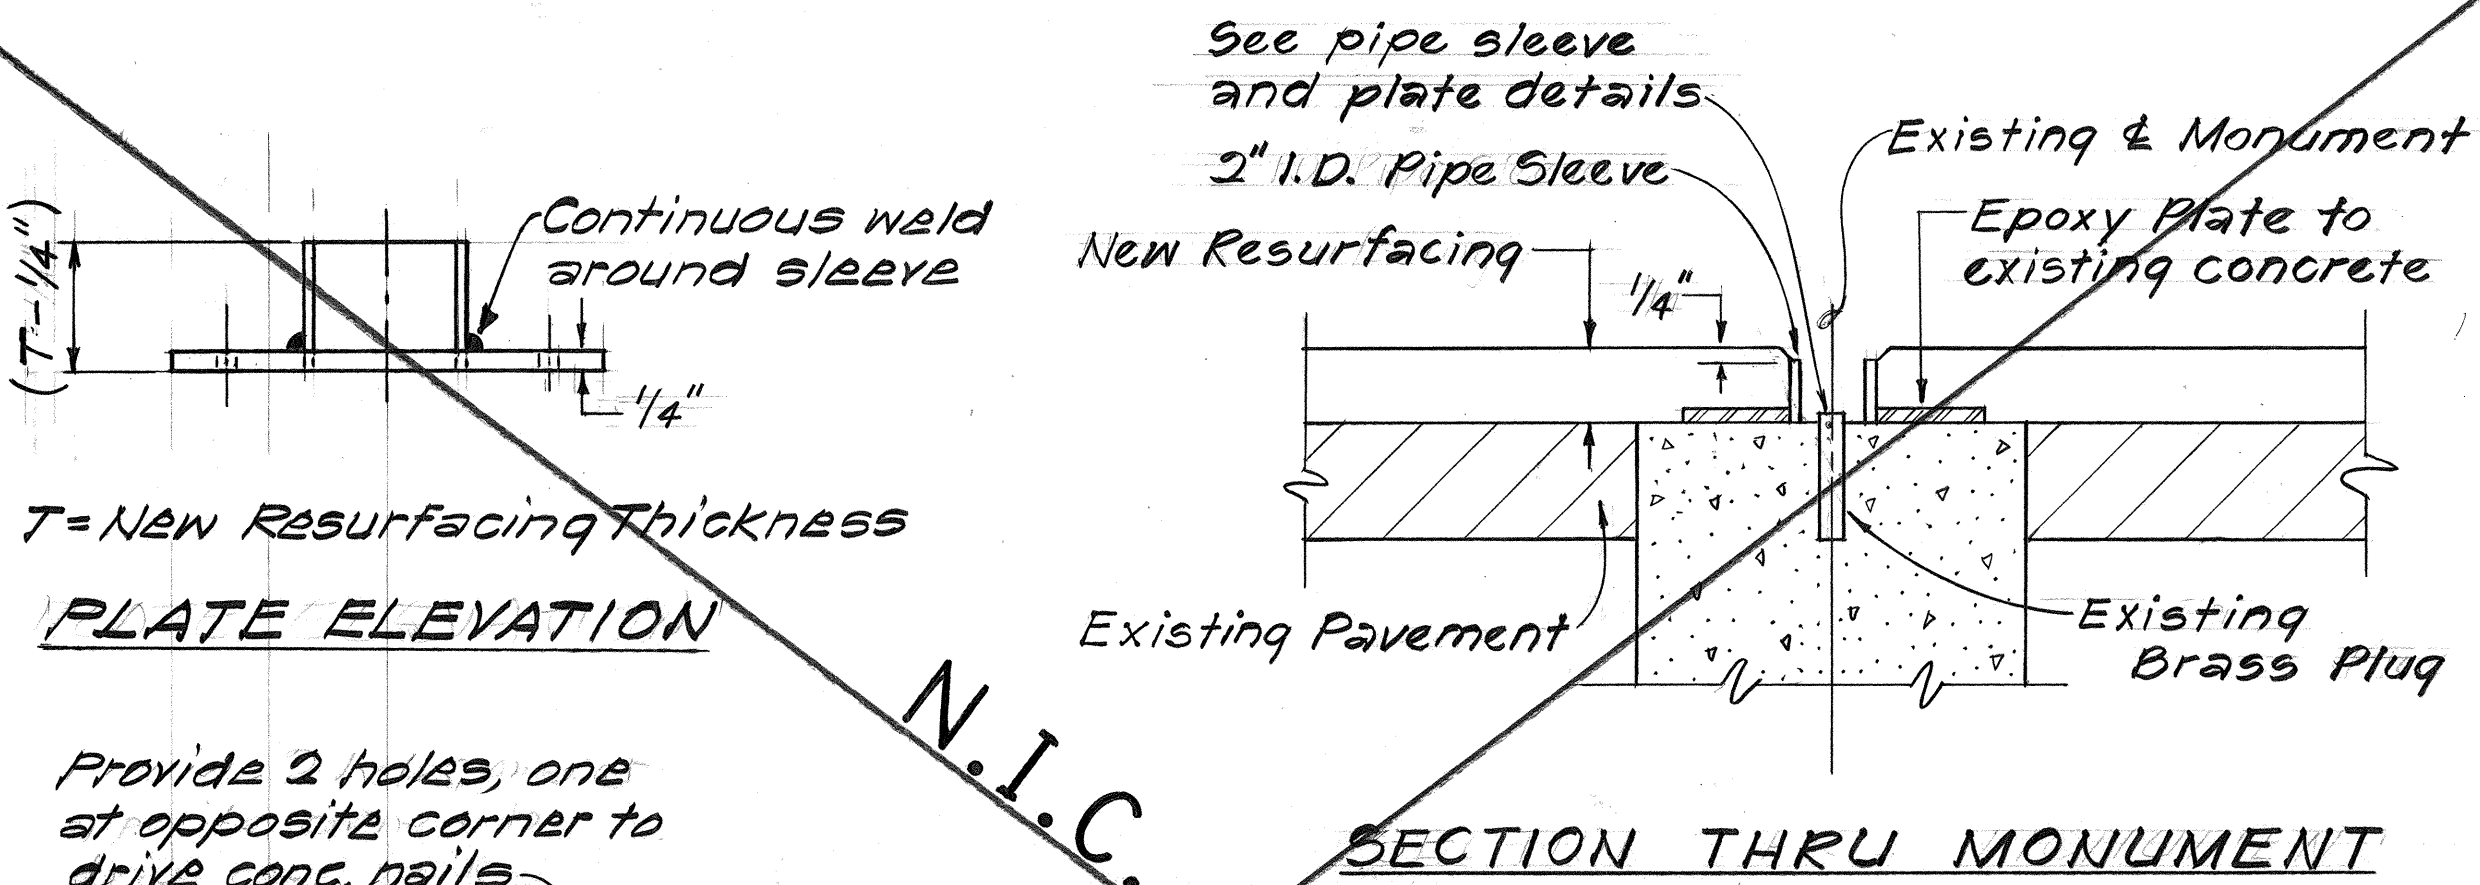

DETAILS FOR PRESERVING CENTERLINE MONUMENT
Not to Scale

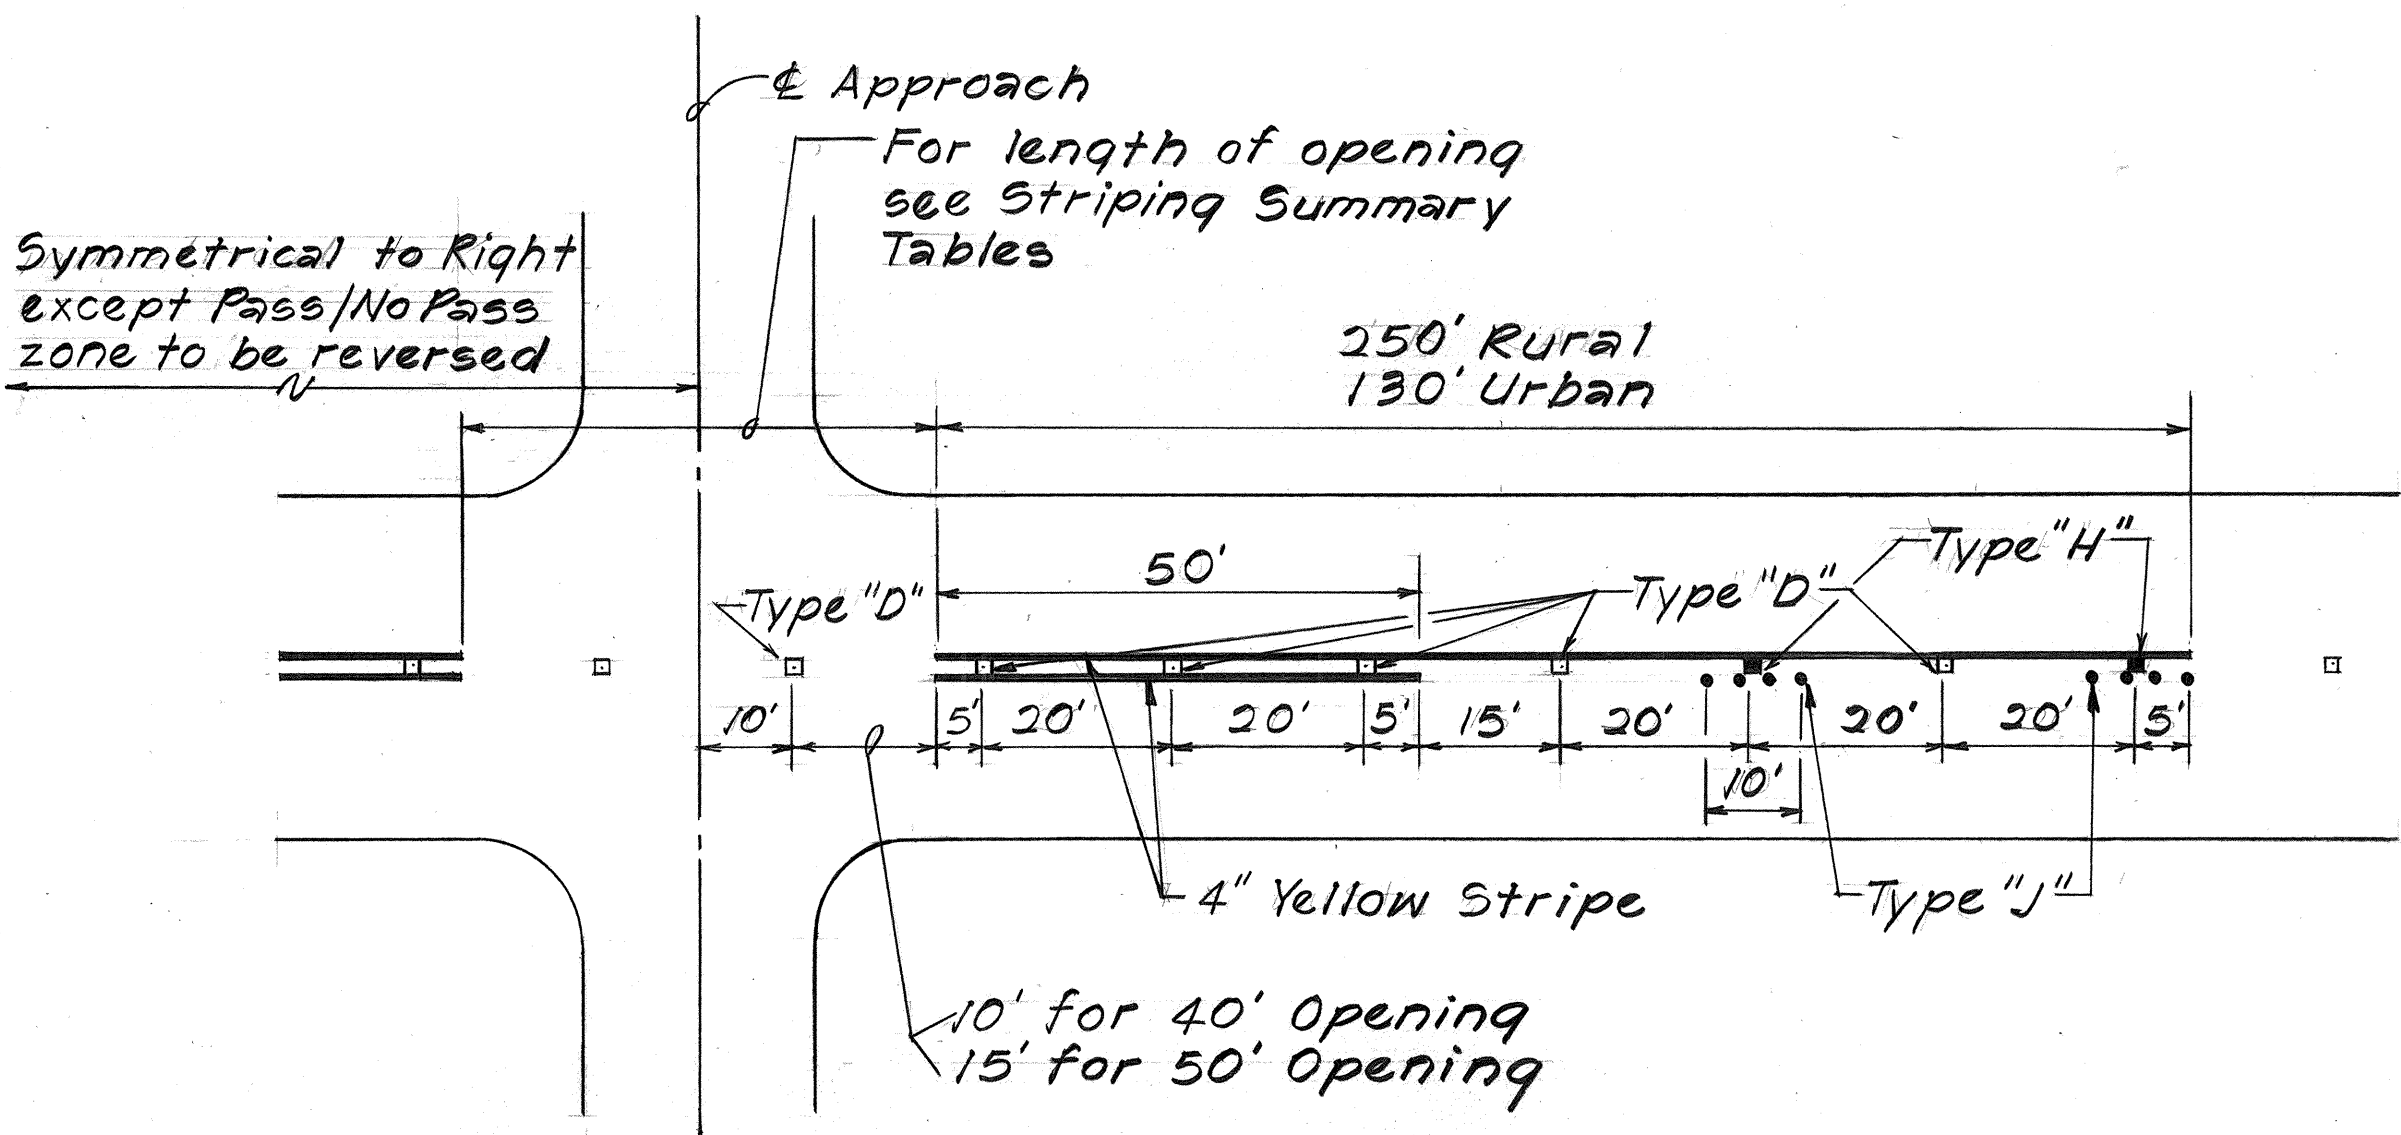

DETAILS-RAISED PAVEMENT MARKERS & STRIPING AT INTERSECTIONS
Not to Scale

STATE OF HAWAII
DEPARTMENT OF TRANSPORTATION
HIGHWAYS DIVISION

GENERAL NOTES & MISC. DETAIL

HWY. RESURF. AT VARIOUS LOCATIONS ON KAUAI

F.A. PROJ. NO. FR-0700(22)

Scale: As Shown Date: Mar., 1983