


FED. ROAD DIST. NO.	STATE	FED. AID PROJ. NO.	FISCAL YEAR	SHEET NO.	TOTAL SHEETS
HAWAII	HAW.	PR-0700(22)	1983	8	17

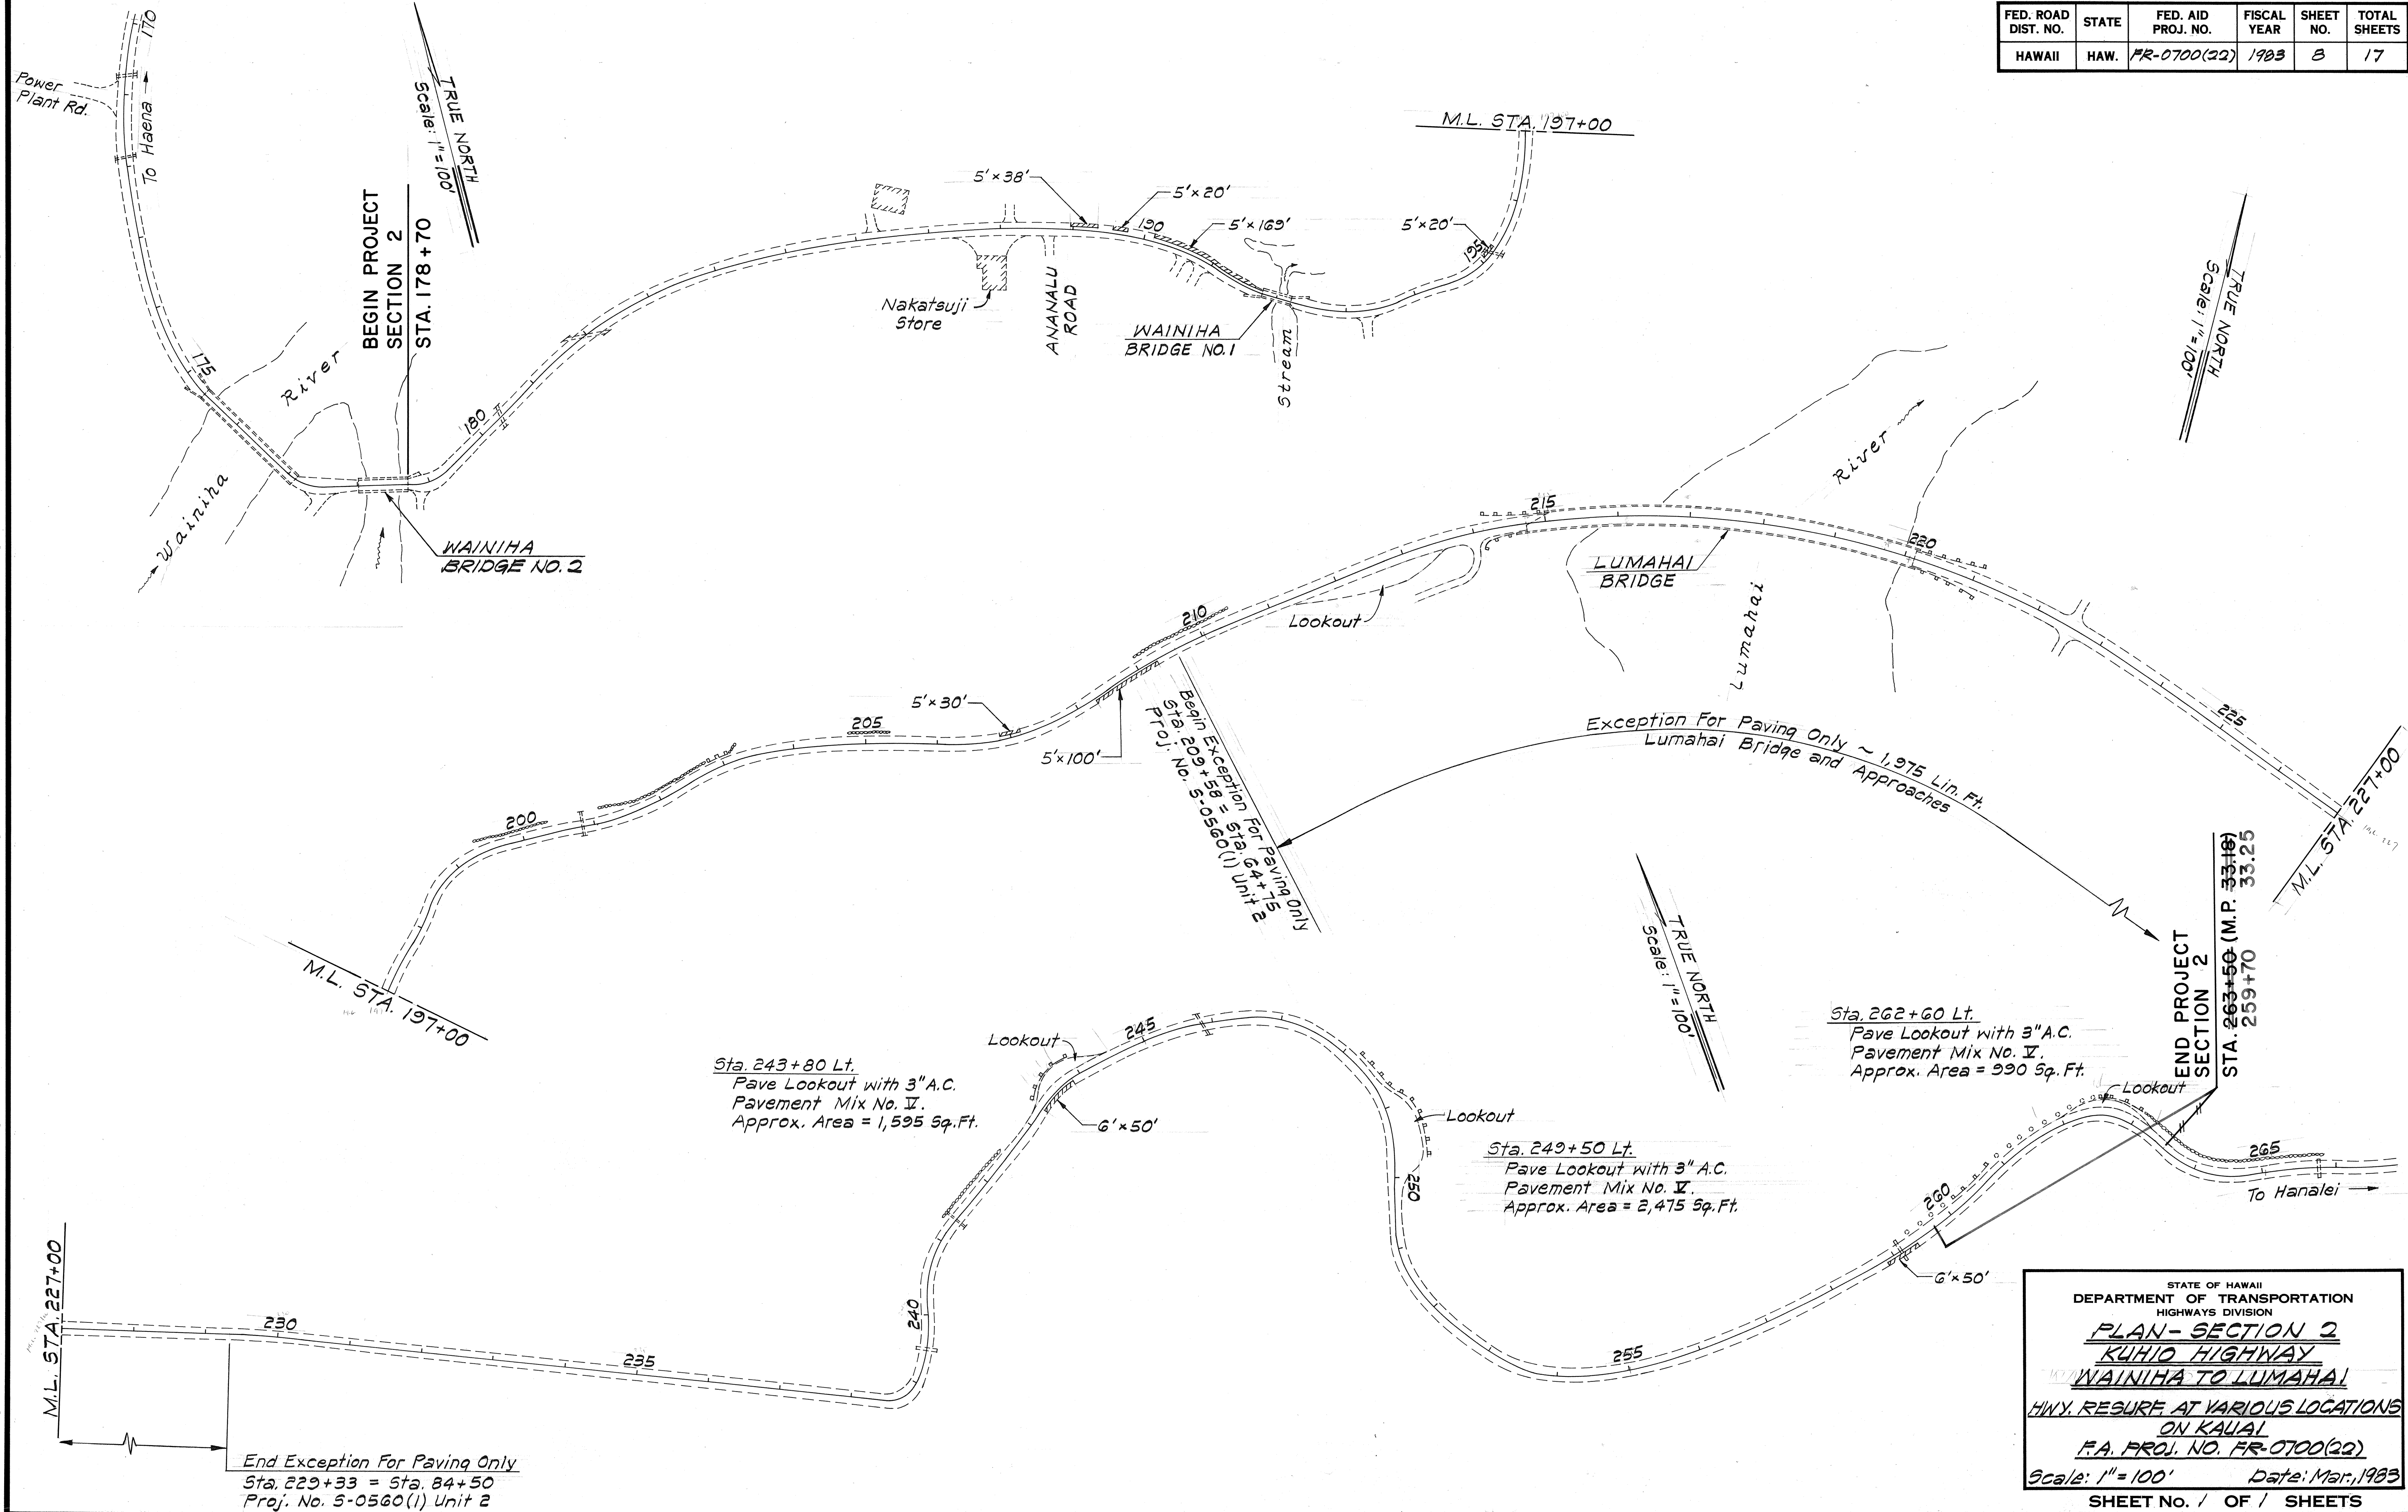

ORIGINAL PLAN	SURVEY PLOTTED BY	DATE
NOTE BOOK	DRAWN BY	
	DESIGNED BY	
	CHECKED BY	

STATE OF HAWAII
DEPARTMENT OF TRANSPORTATION
HIGHWAYS DIVISION

PLAN - SECTION 2
KUHIO HIGHWAY
WAINIHA TO LUMAHAI

HWY. RESURF. AT VARIOUS LOCATIONS
ON KAUAI

F.A. PROJ. NO. PR-0700(22)

Scale: 1" = 100' Date: Mar., 1983

SHEET NO. 1 OF 1 SHEETS