


FED. ROAD DIST. NO.	STATE	PROJ. NO.	FISCAL YEAR	SHEET NO.	TOTAL SHEETS
HAWAII	HAW.	HWY-K-03-88M HWY-K-01-88M	1988	3	8

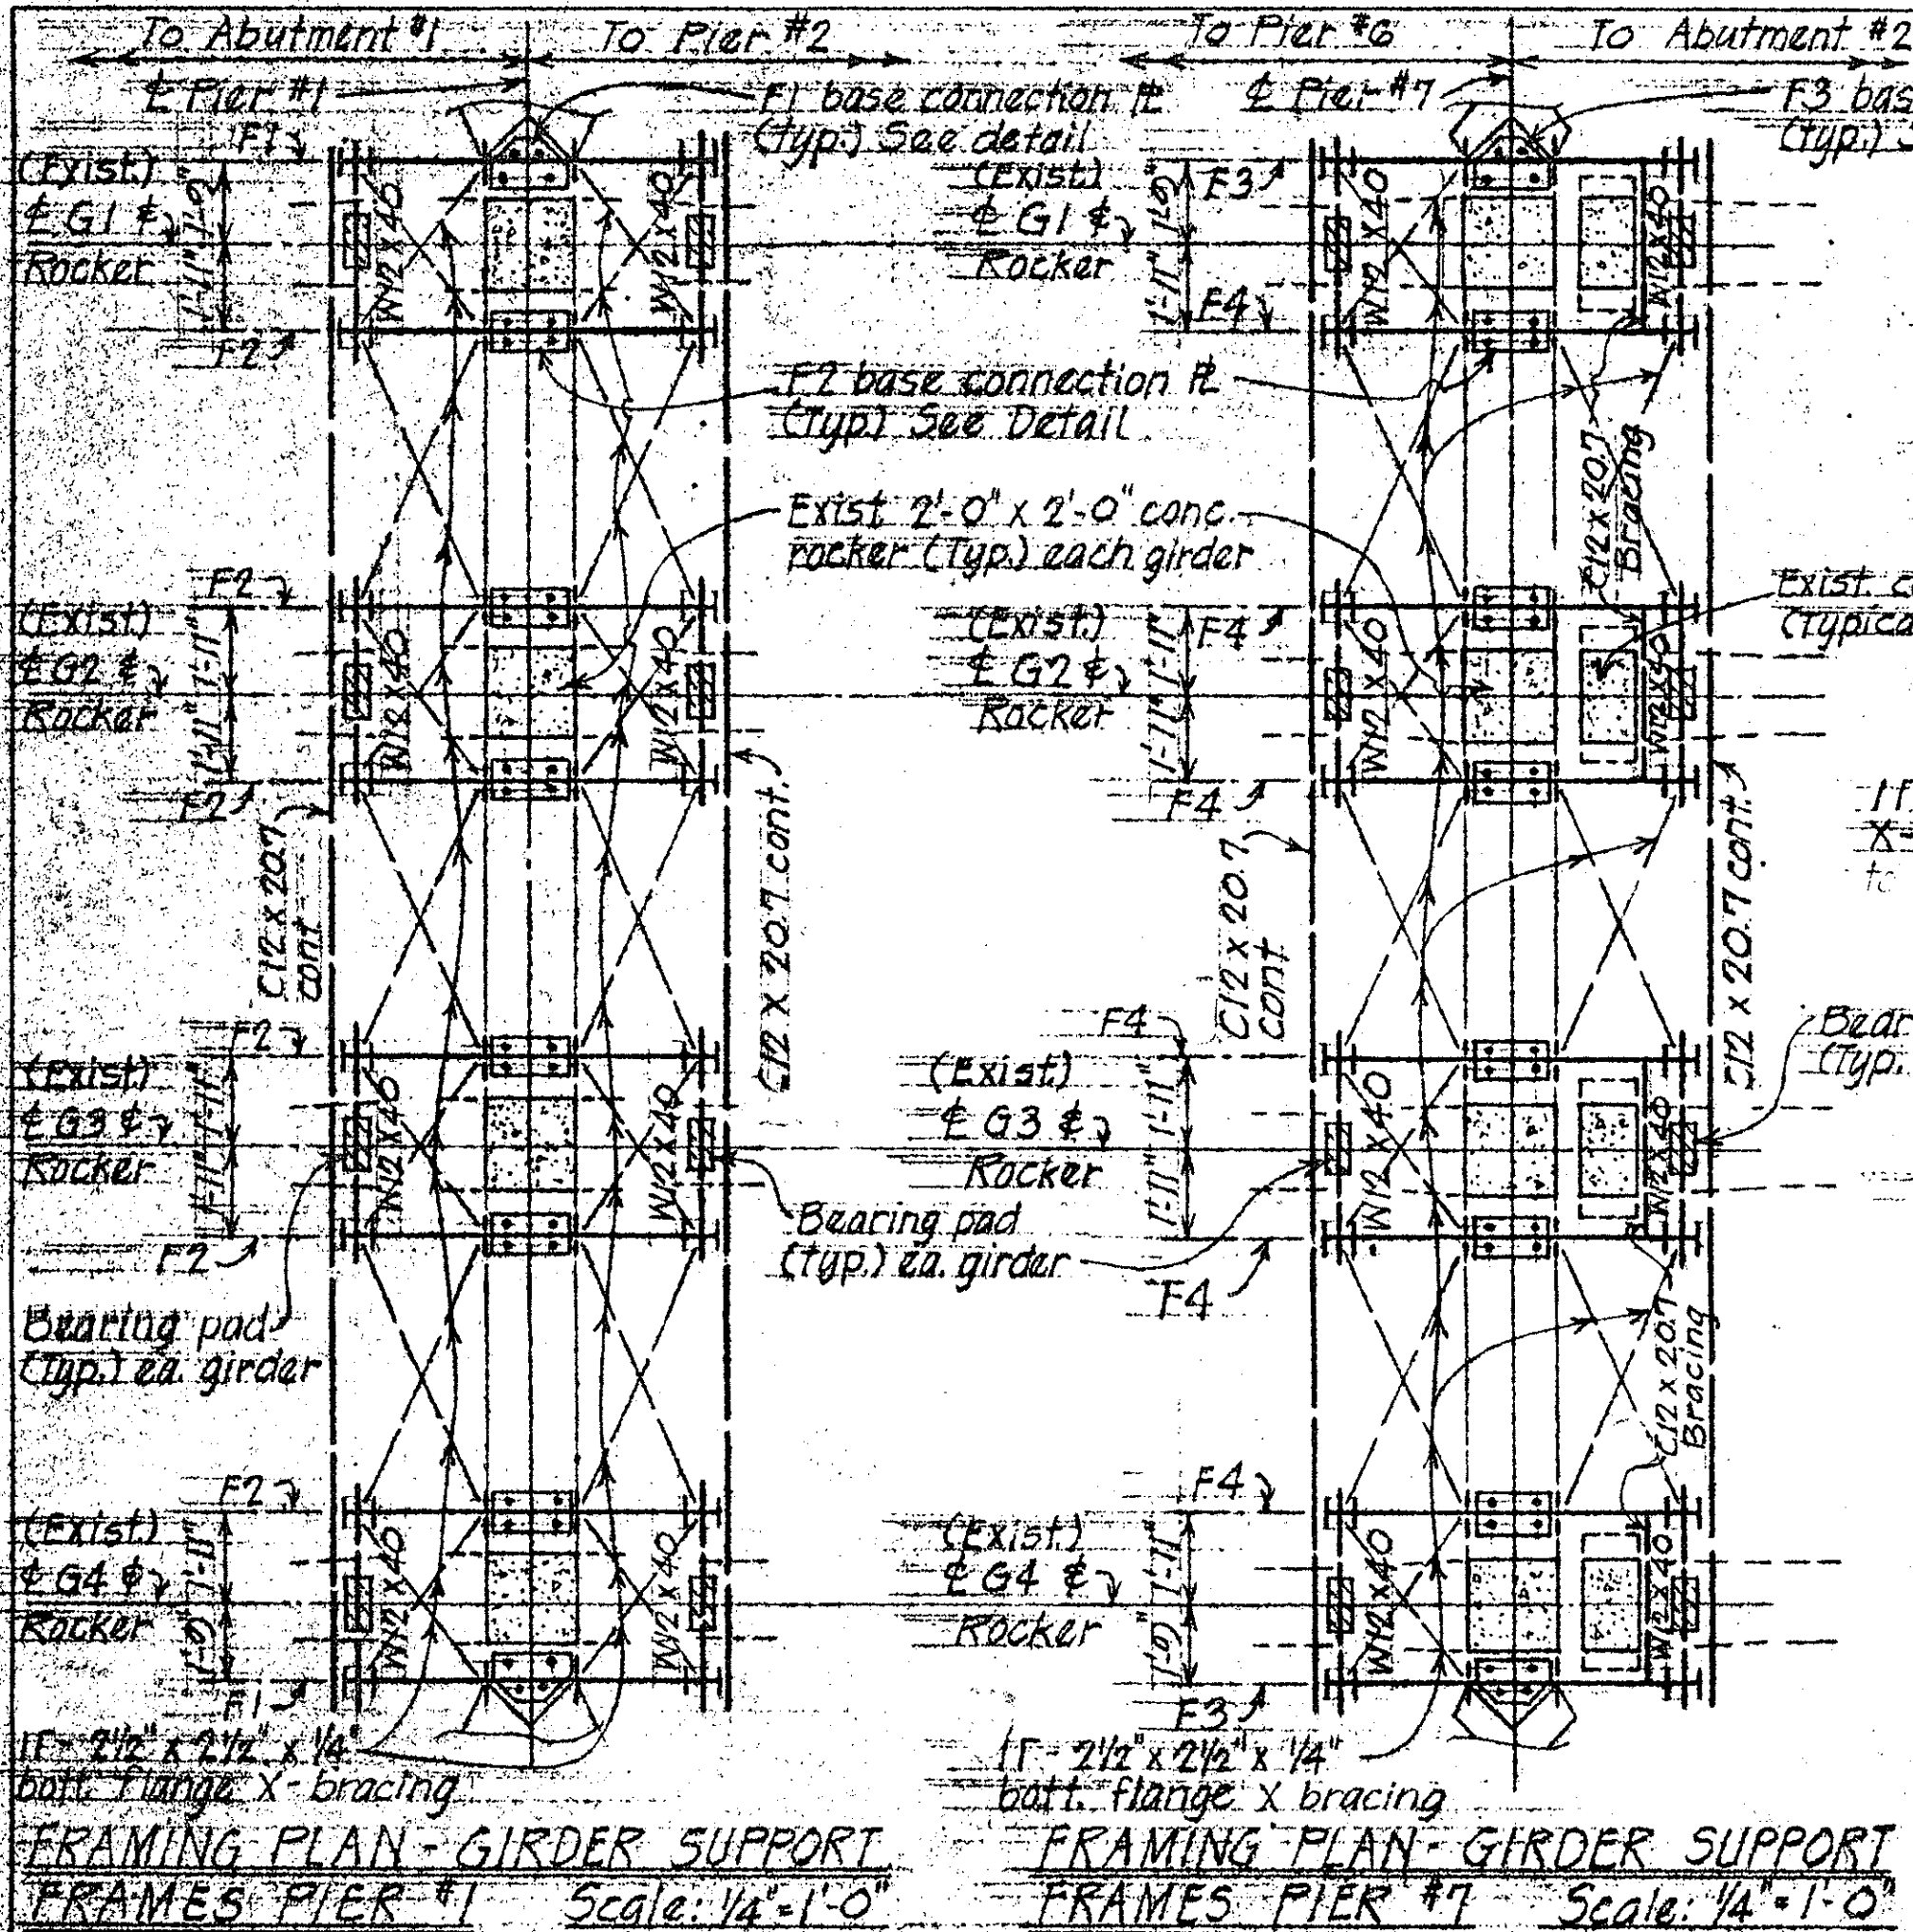

PART REFLECTED PLAN - TYPICAL BOTTOM CHORD X-BRACING DETAILS

Note: Refer to Framing Plan for location
Scale: 3/4" = 1'-0"

STATE OF HAWAII
DEPARTMENT OF TRANSPORTATION
ROADWAY DIVISION

WAILUA BRIDGE, PREPARATION & PAINTING OF STEEL SUPPORTS
FRAMING PLAN & DETAILS

PROJ. NO. HWY-K-03-88M
AS SHOWN APRIL 1988

SHEET NO. 2 OF 4 SHEETS