
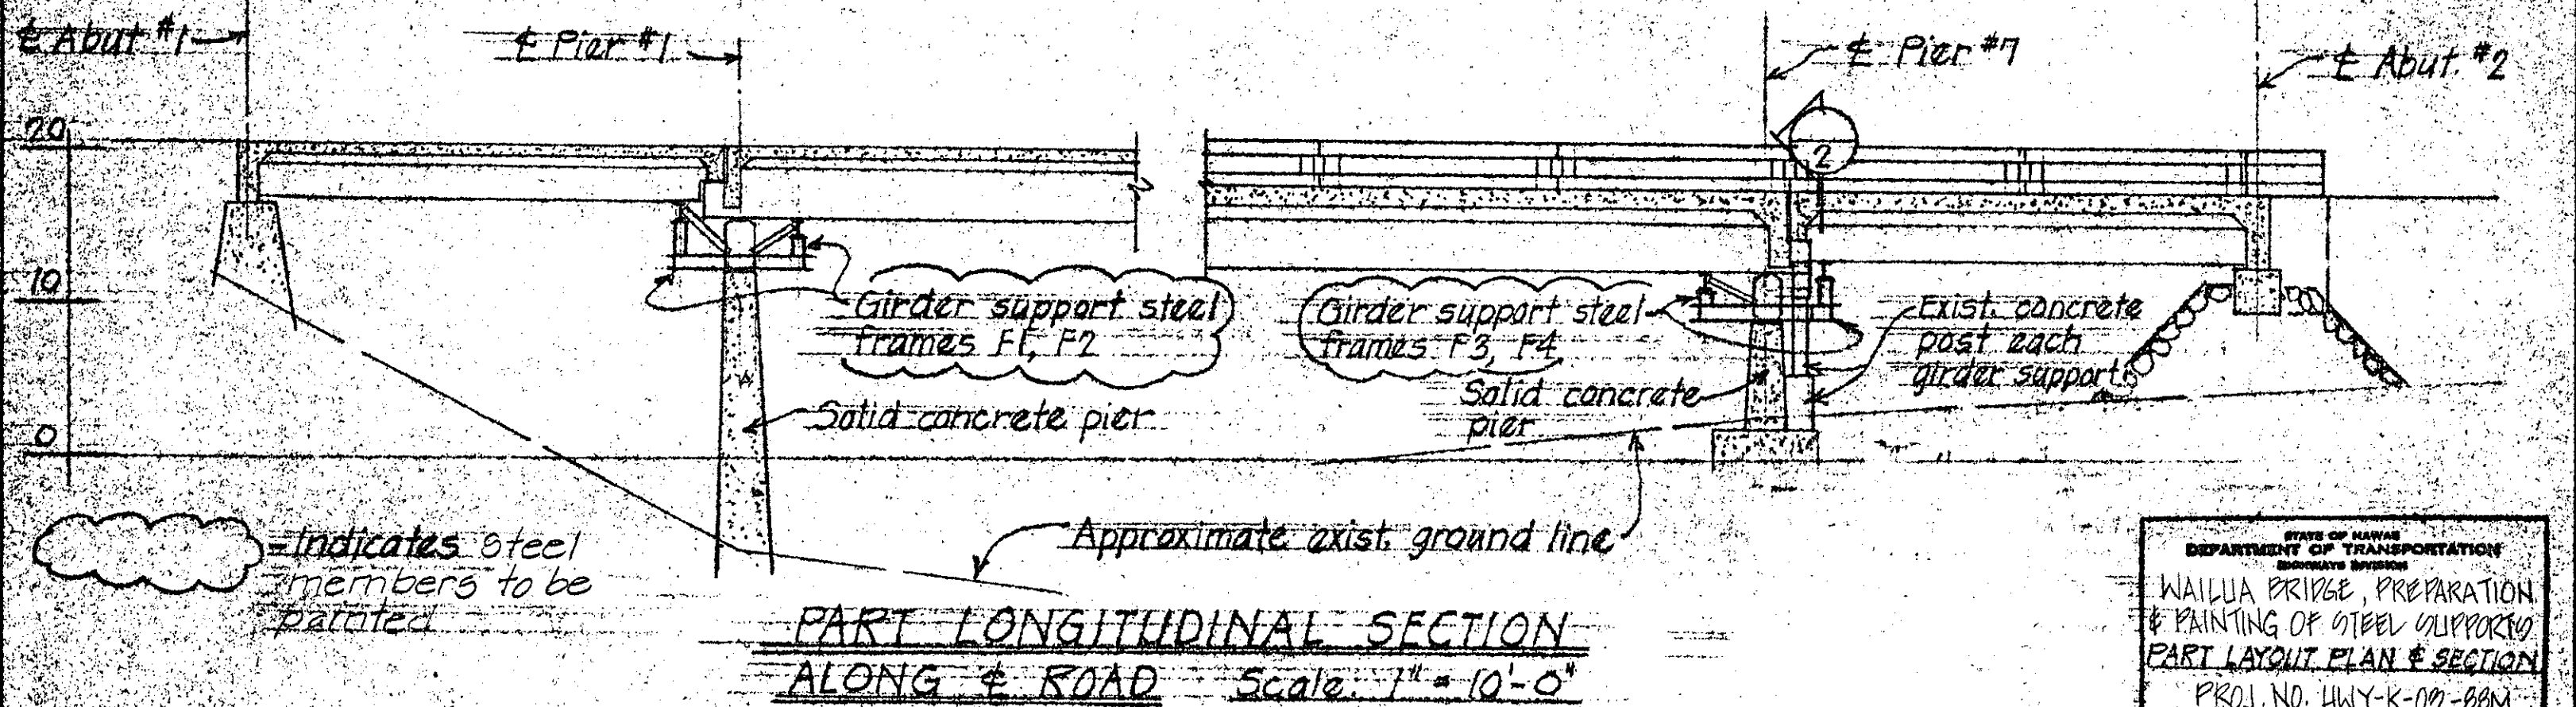


FED. ROAD DIST. NO.	STATE	PROJ. NO.	FISCAL YEAR	SHEET NO.	TOTAL SHEETS
HAWAII	HAW.	HWY-K-03-88M HWY-K-01-88M	1988	2	8

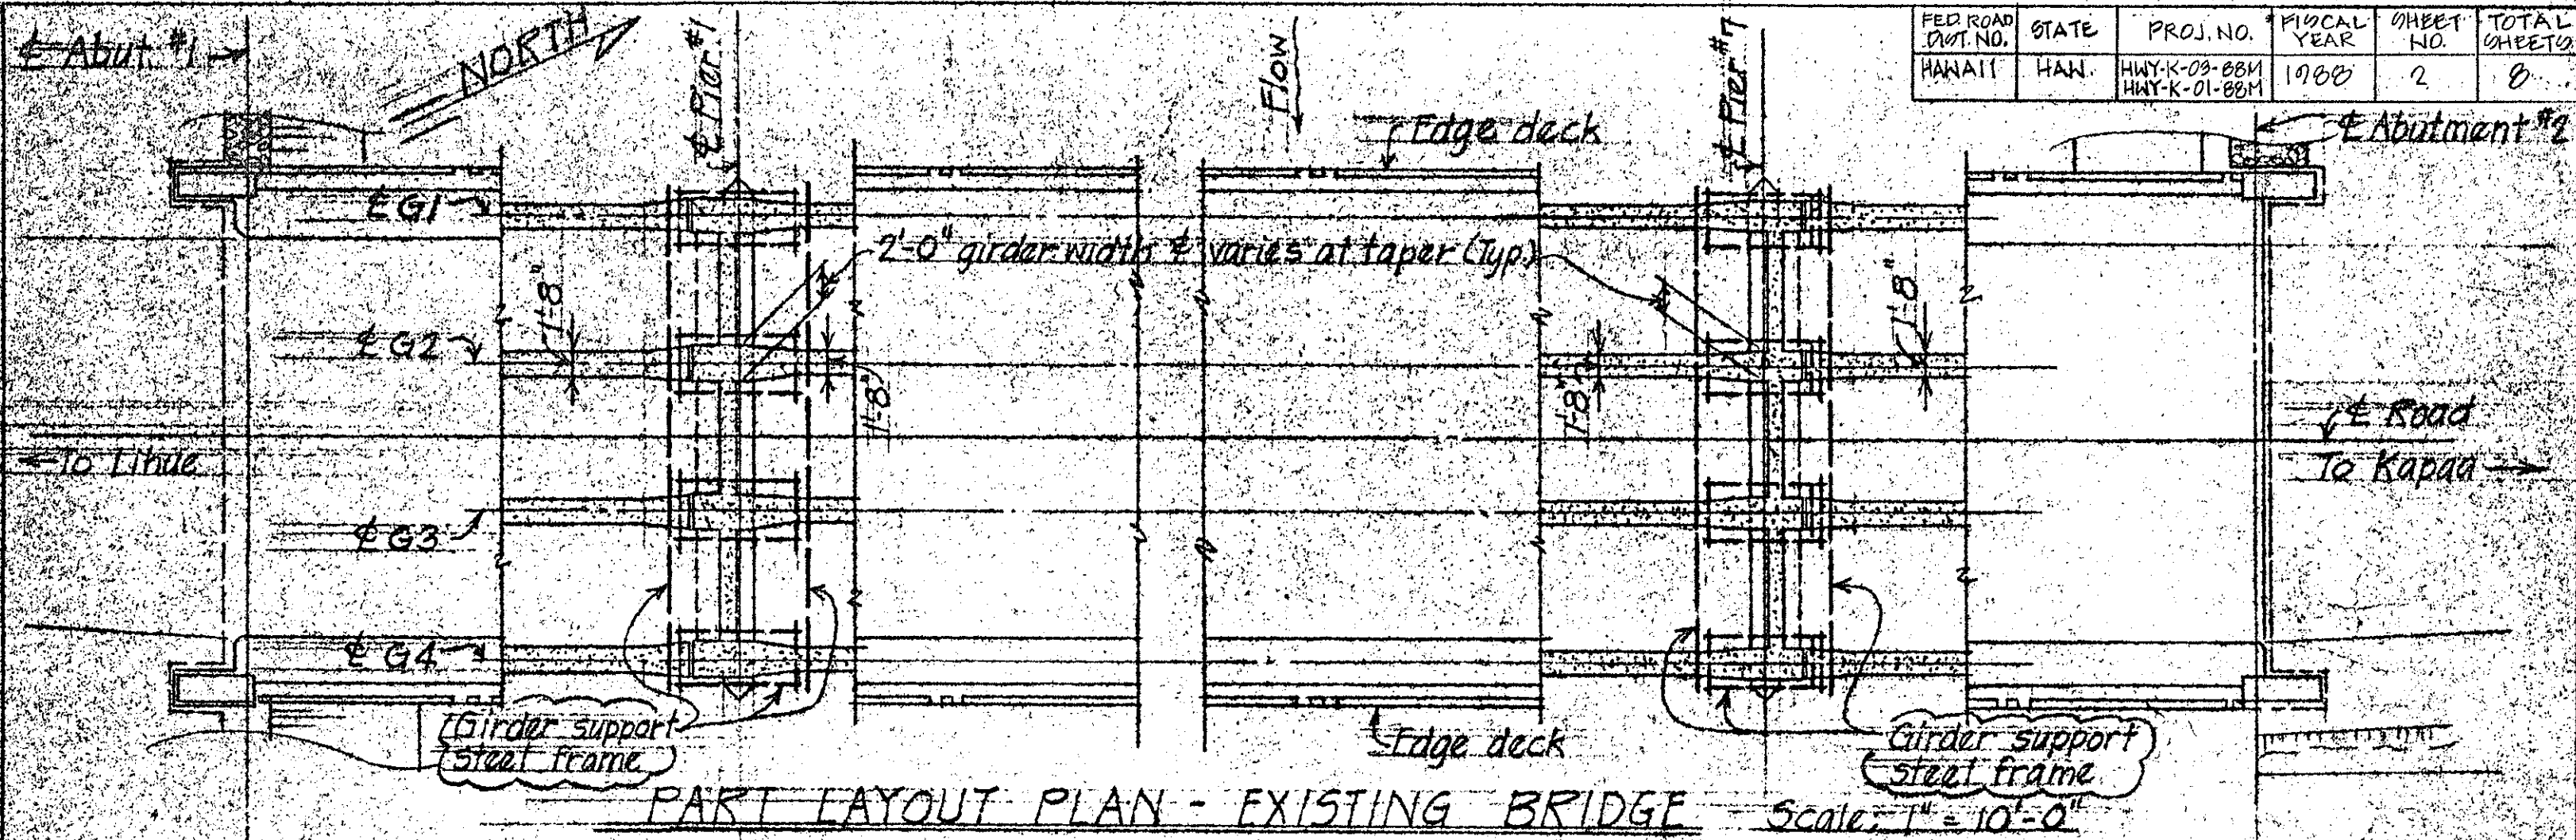

STATE OF HAWAII
DEPARTMENT OF TRANSPORTATION
BROOKLYN DIVISION

WAILUA BRIDGE, PREPARATION
& PAINTING OF STEEL SUPPORTS
PART LAYOUT PLAN & SECTION

PROJ. NO. HWY-K-03-88M
AS SHOWN APRIL 1988

SHEET No. 1 OF 4 SHEETS